


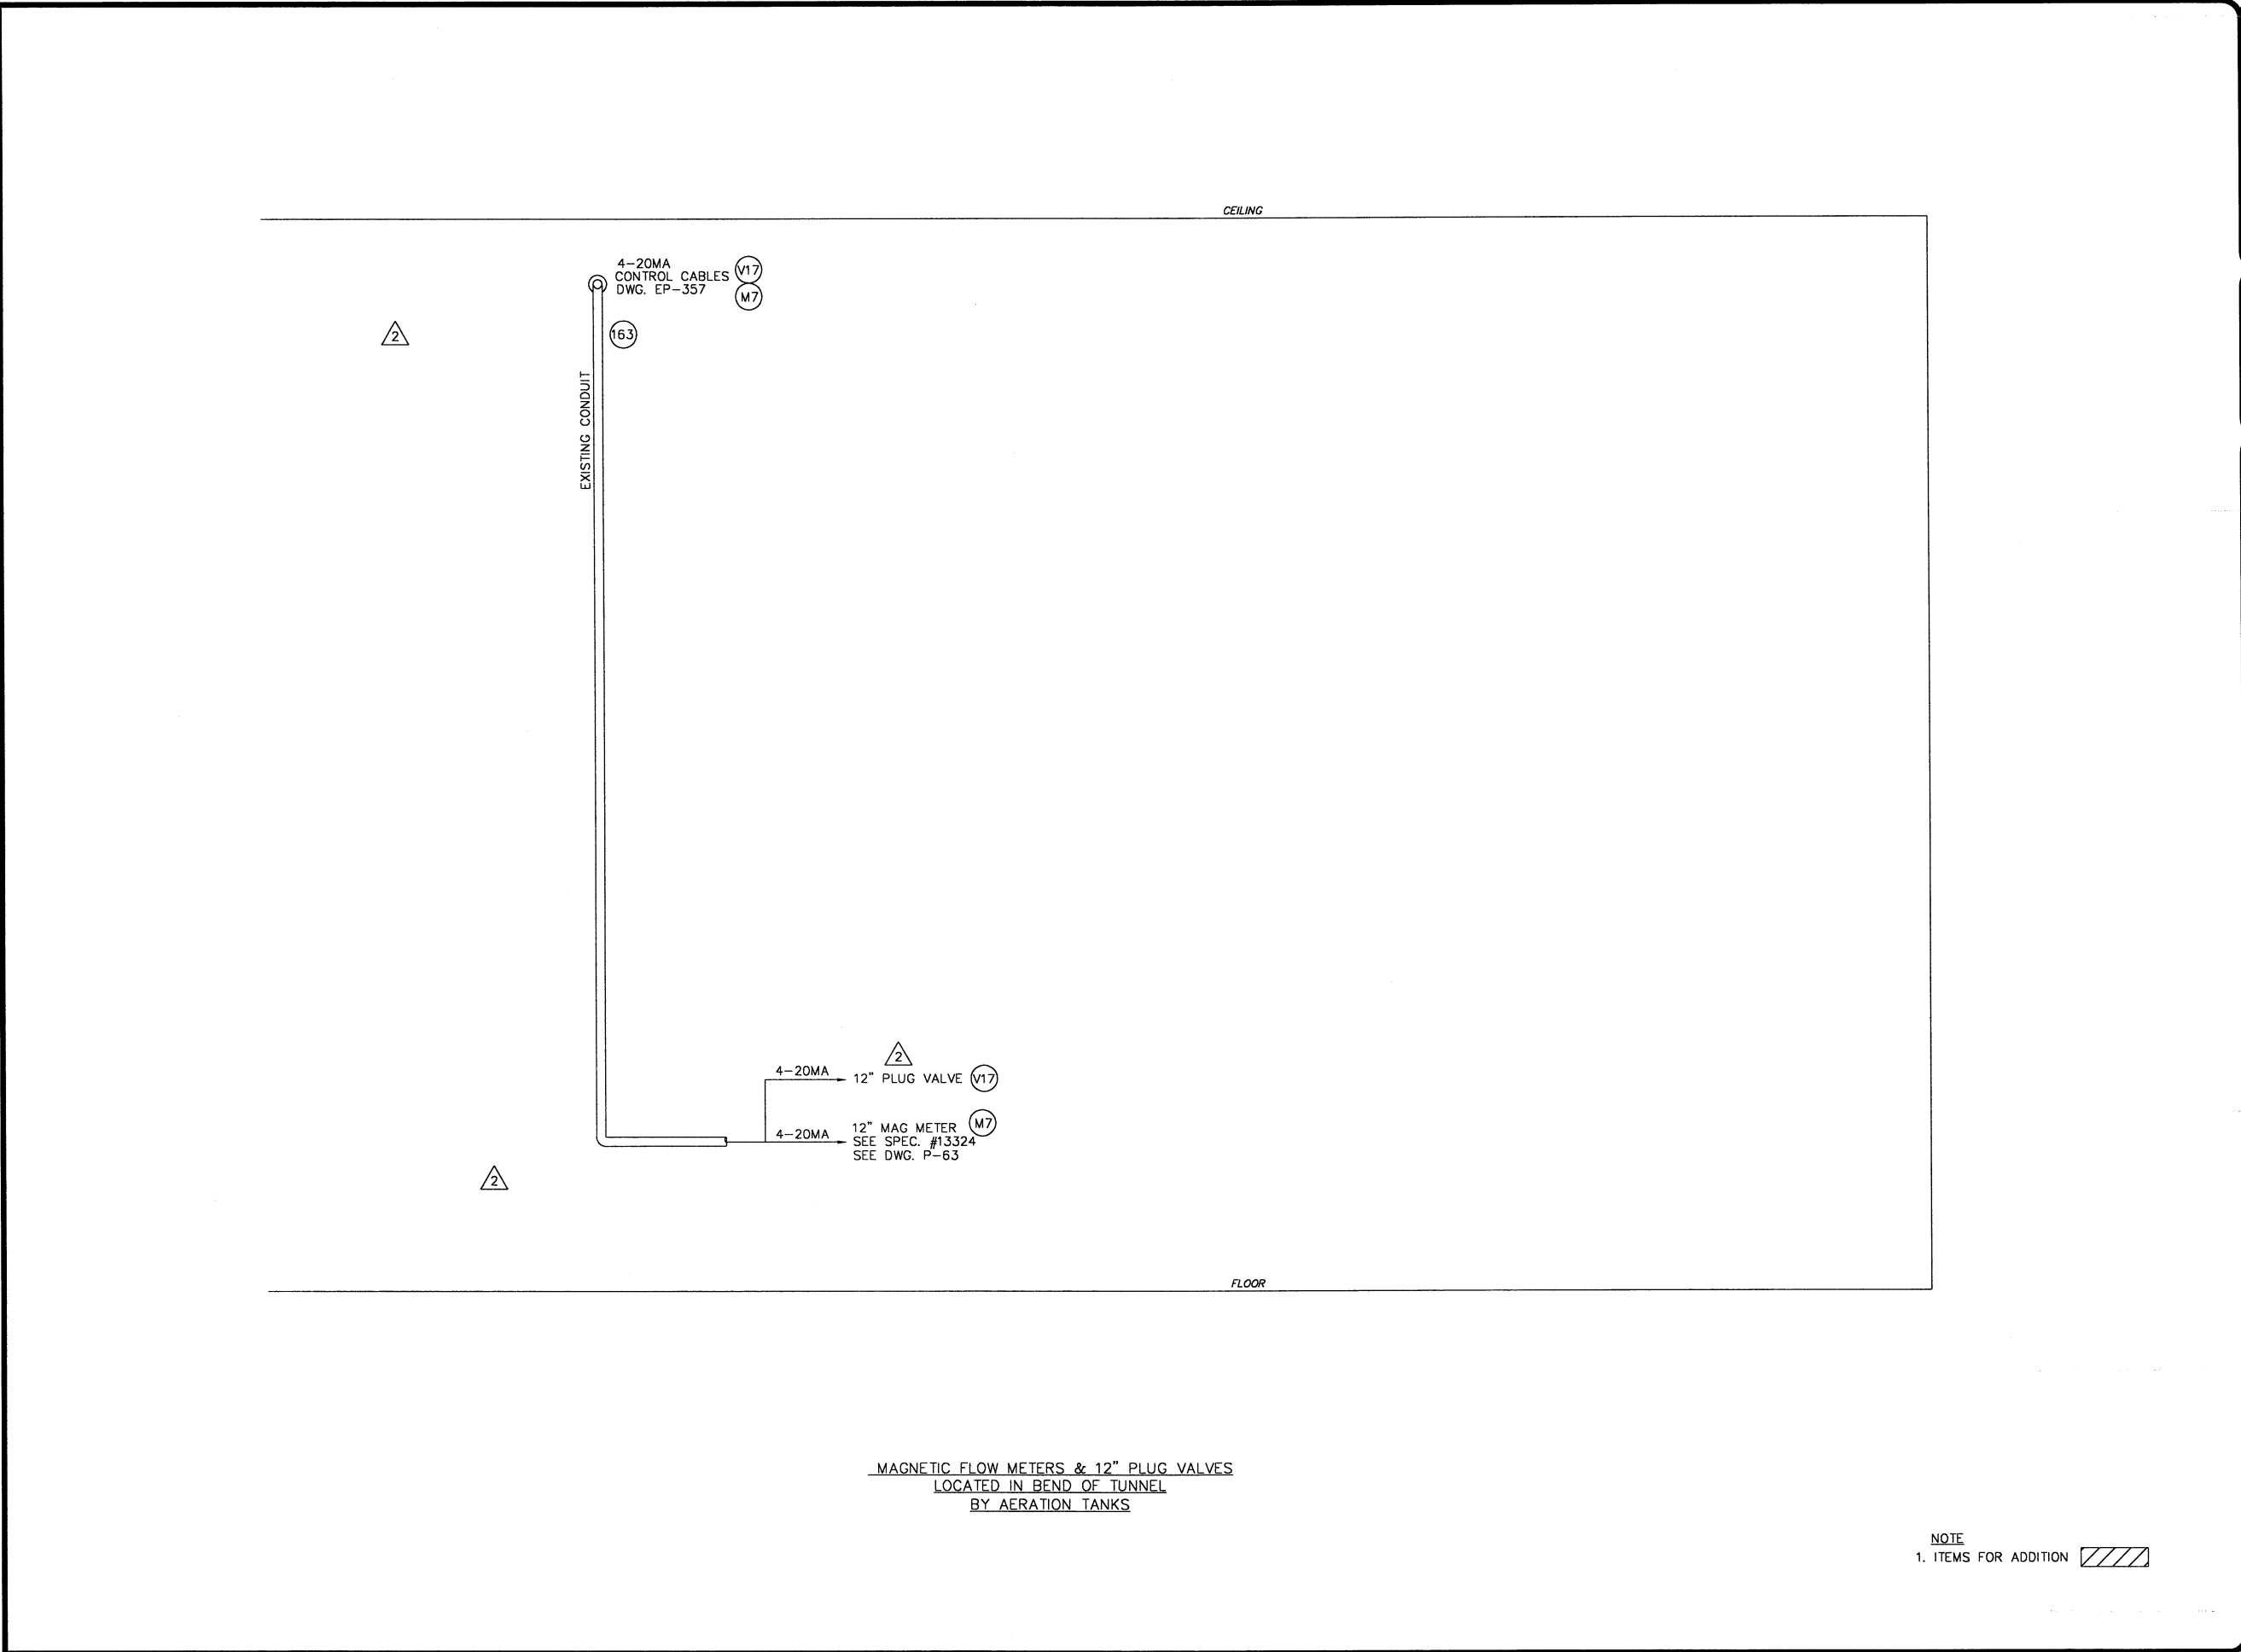

MAGNETIC FLOW METERS & 12" PLUG VALVES
LOCATED IN BEND OF TUNNEL
BY AERATION TANKS

NOTE
1. ITEMS FOR ADDITION 



DESIGNED BY				REVISIONS			
NO.	DESCRIPTIONS	DATE	BY	NO.	DESCRIPTIONS	DATE	BY
1	REMOVED AC CABLE #162	1/16/03	BY				

ENVIRONMENTAL, INC.
ENGINEERS IN WATER AND EARTH SCIENCES
UNIONTOWN, OHIO



CITY OF MASSILLON, OHIO
WWTP UPGRADE 2000
TR. "D2", MAGNETIC FLOW METER & 12" PLUG VALVE #1
IN TUNNEL UNDER AERATION TANKS

JOB NO. E9031
DATE 04/10/01
SCALE 1 1/2" = 12"
SHEET EP350-1