
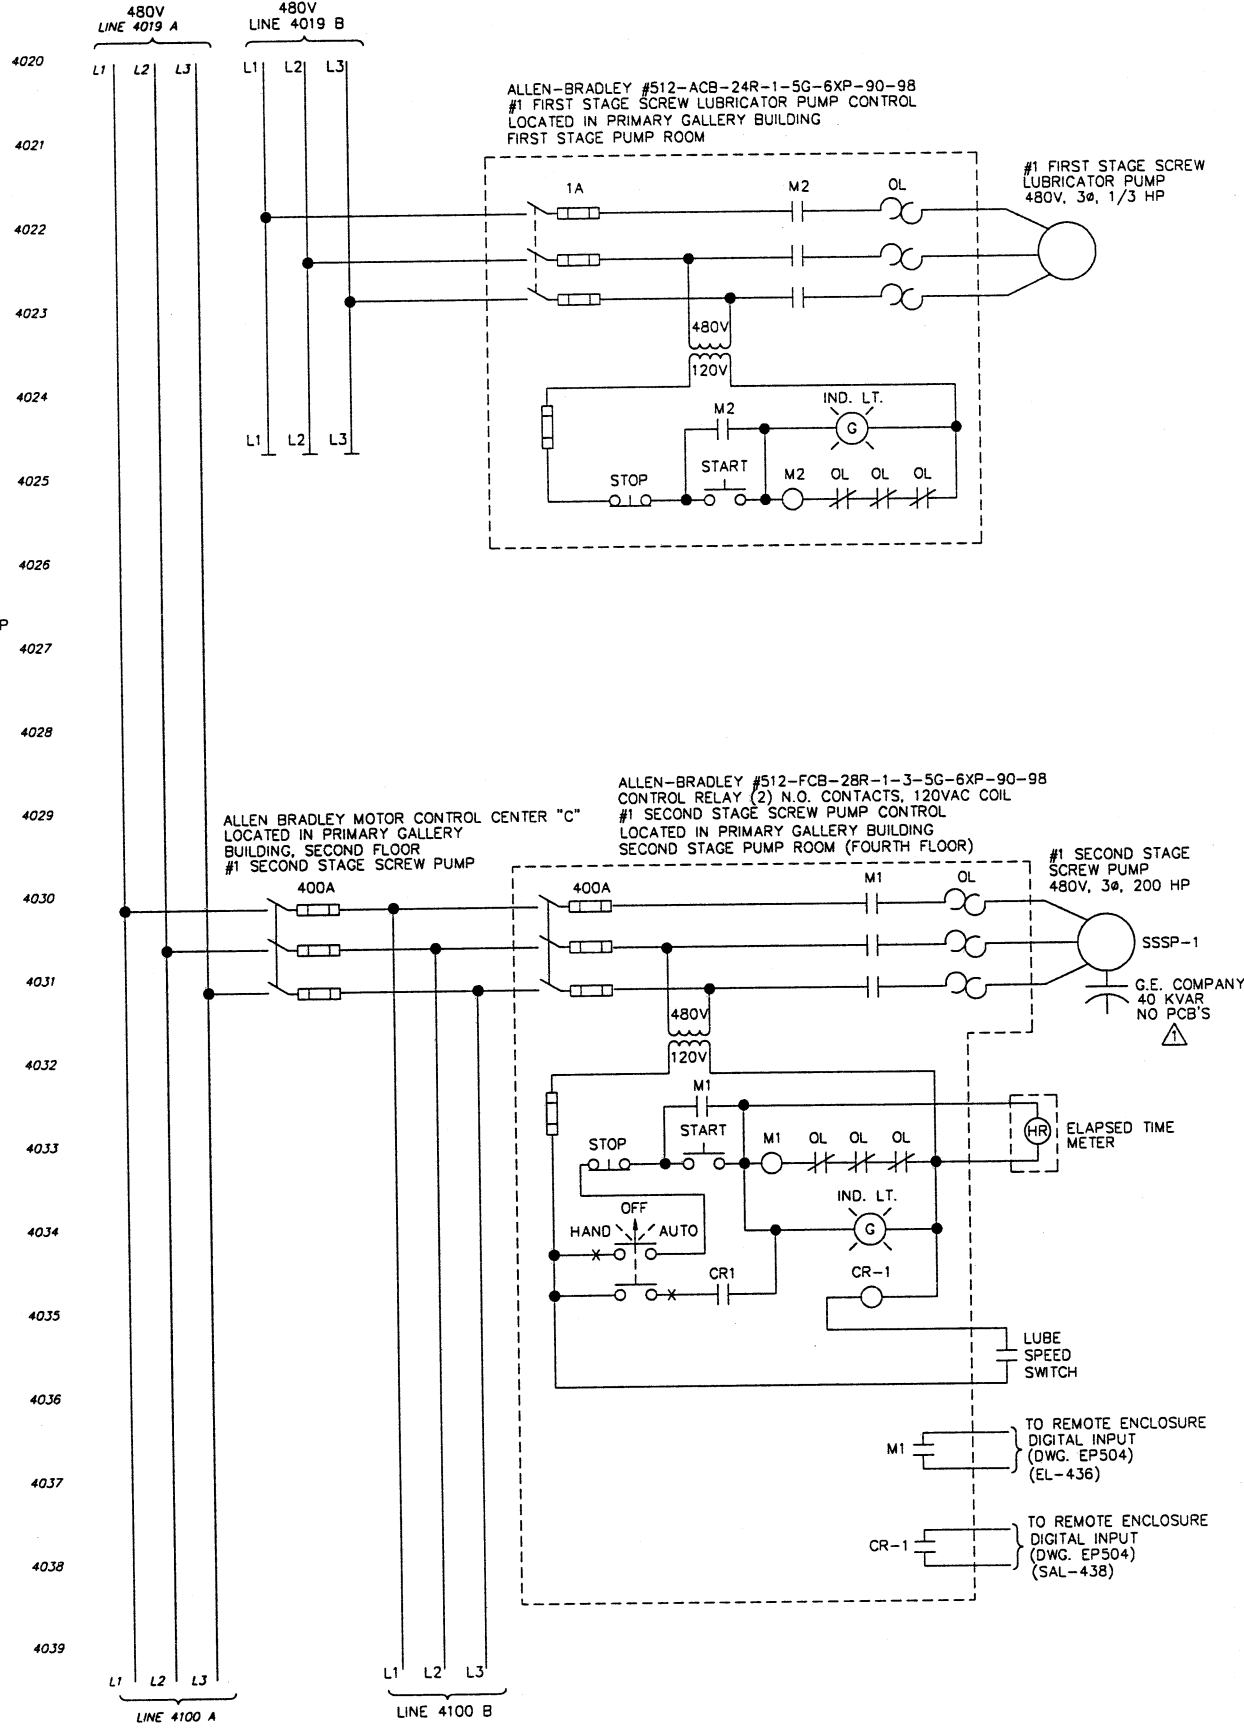


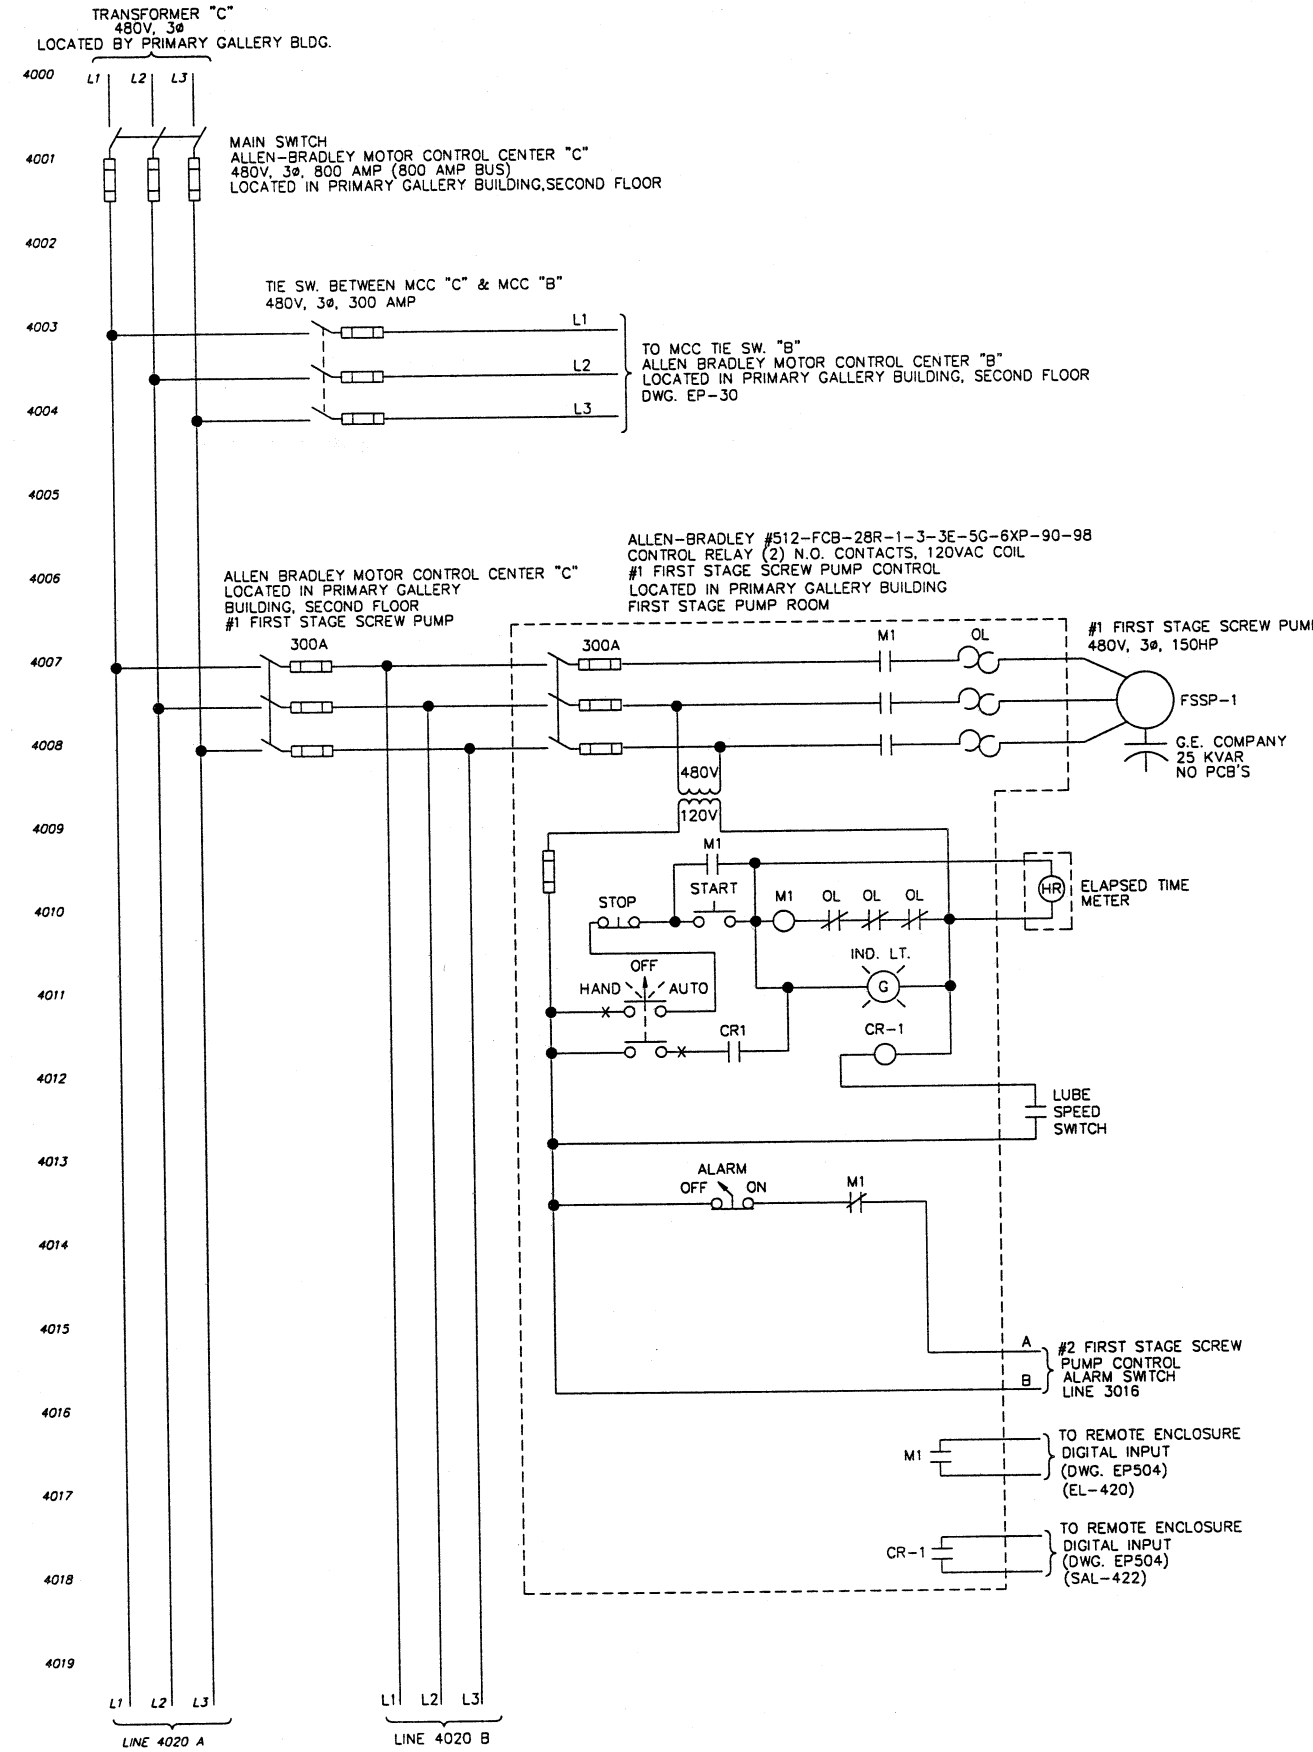

SEI/PT TECHNOLOGIES, INC.
MASSILLON, OHIO
#5674

DESIGNED BY
STI/TSS

DRAWN BY
STI/TSS

CHECKED BY
STI/TSS

APPROVED BY
STI/RJL

NO.	REVISIONS	DATE	BY	APP'D
1	REVISED AS PER CONSTRUCTION	4/1/00	TSS	

ENVIRONMENTAL, INC.
ENGINEERS IN WATER AND EARTH SCIENCES
UNIONTOWN, OHIO

CITY OF MASSILLON, OHIO
WWTP UPGRADE 2000
TRANSFORMER "C", MCC-C
SCREW PUMPS SCHEMATIC DIAGRAM

JOB NO.
E9031

DATE
2/16/01

SCALE
N/A

SHEET
EP40

9031SCHE40.DWG