


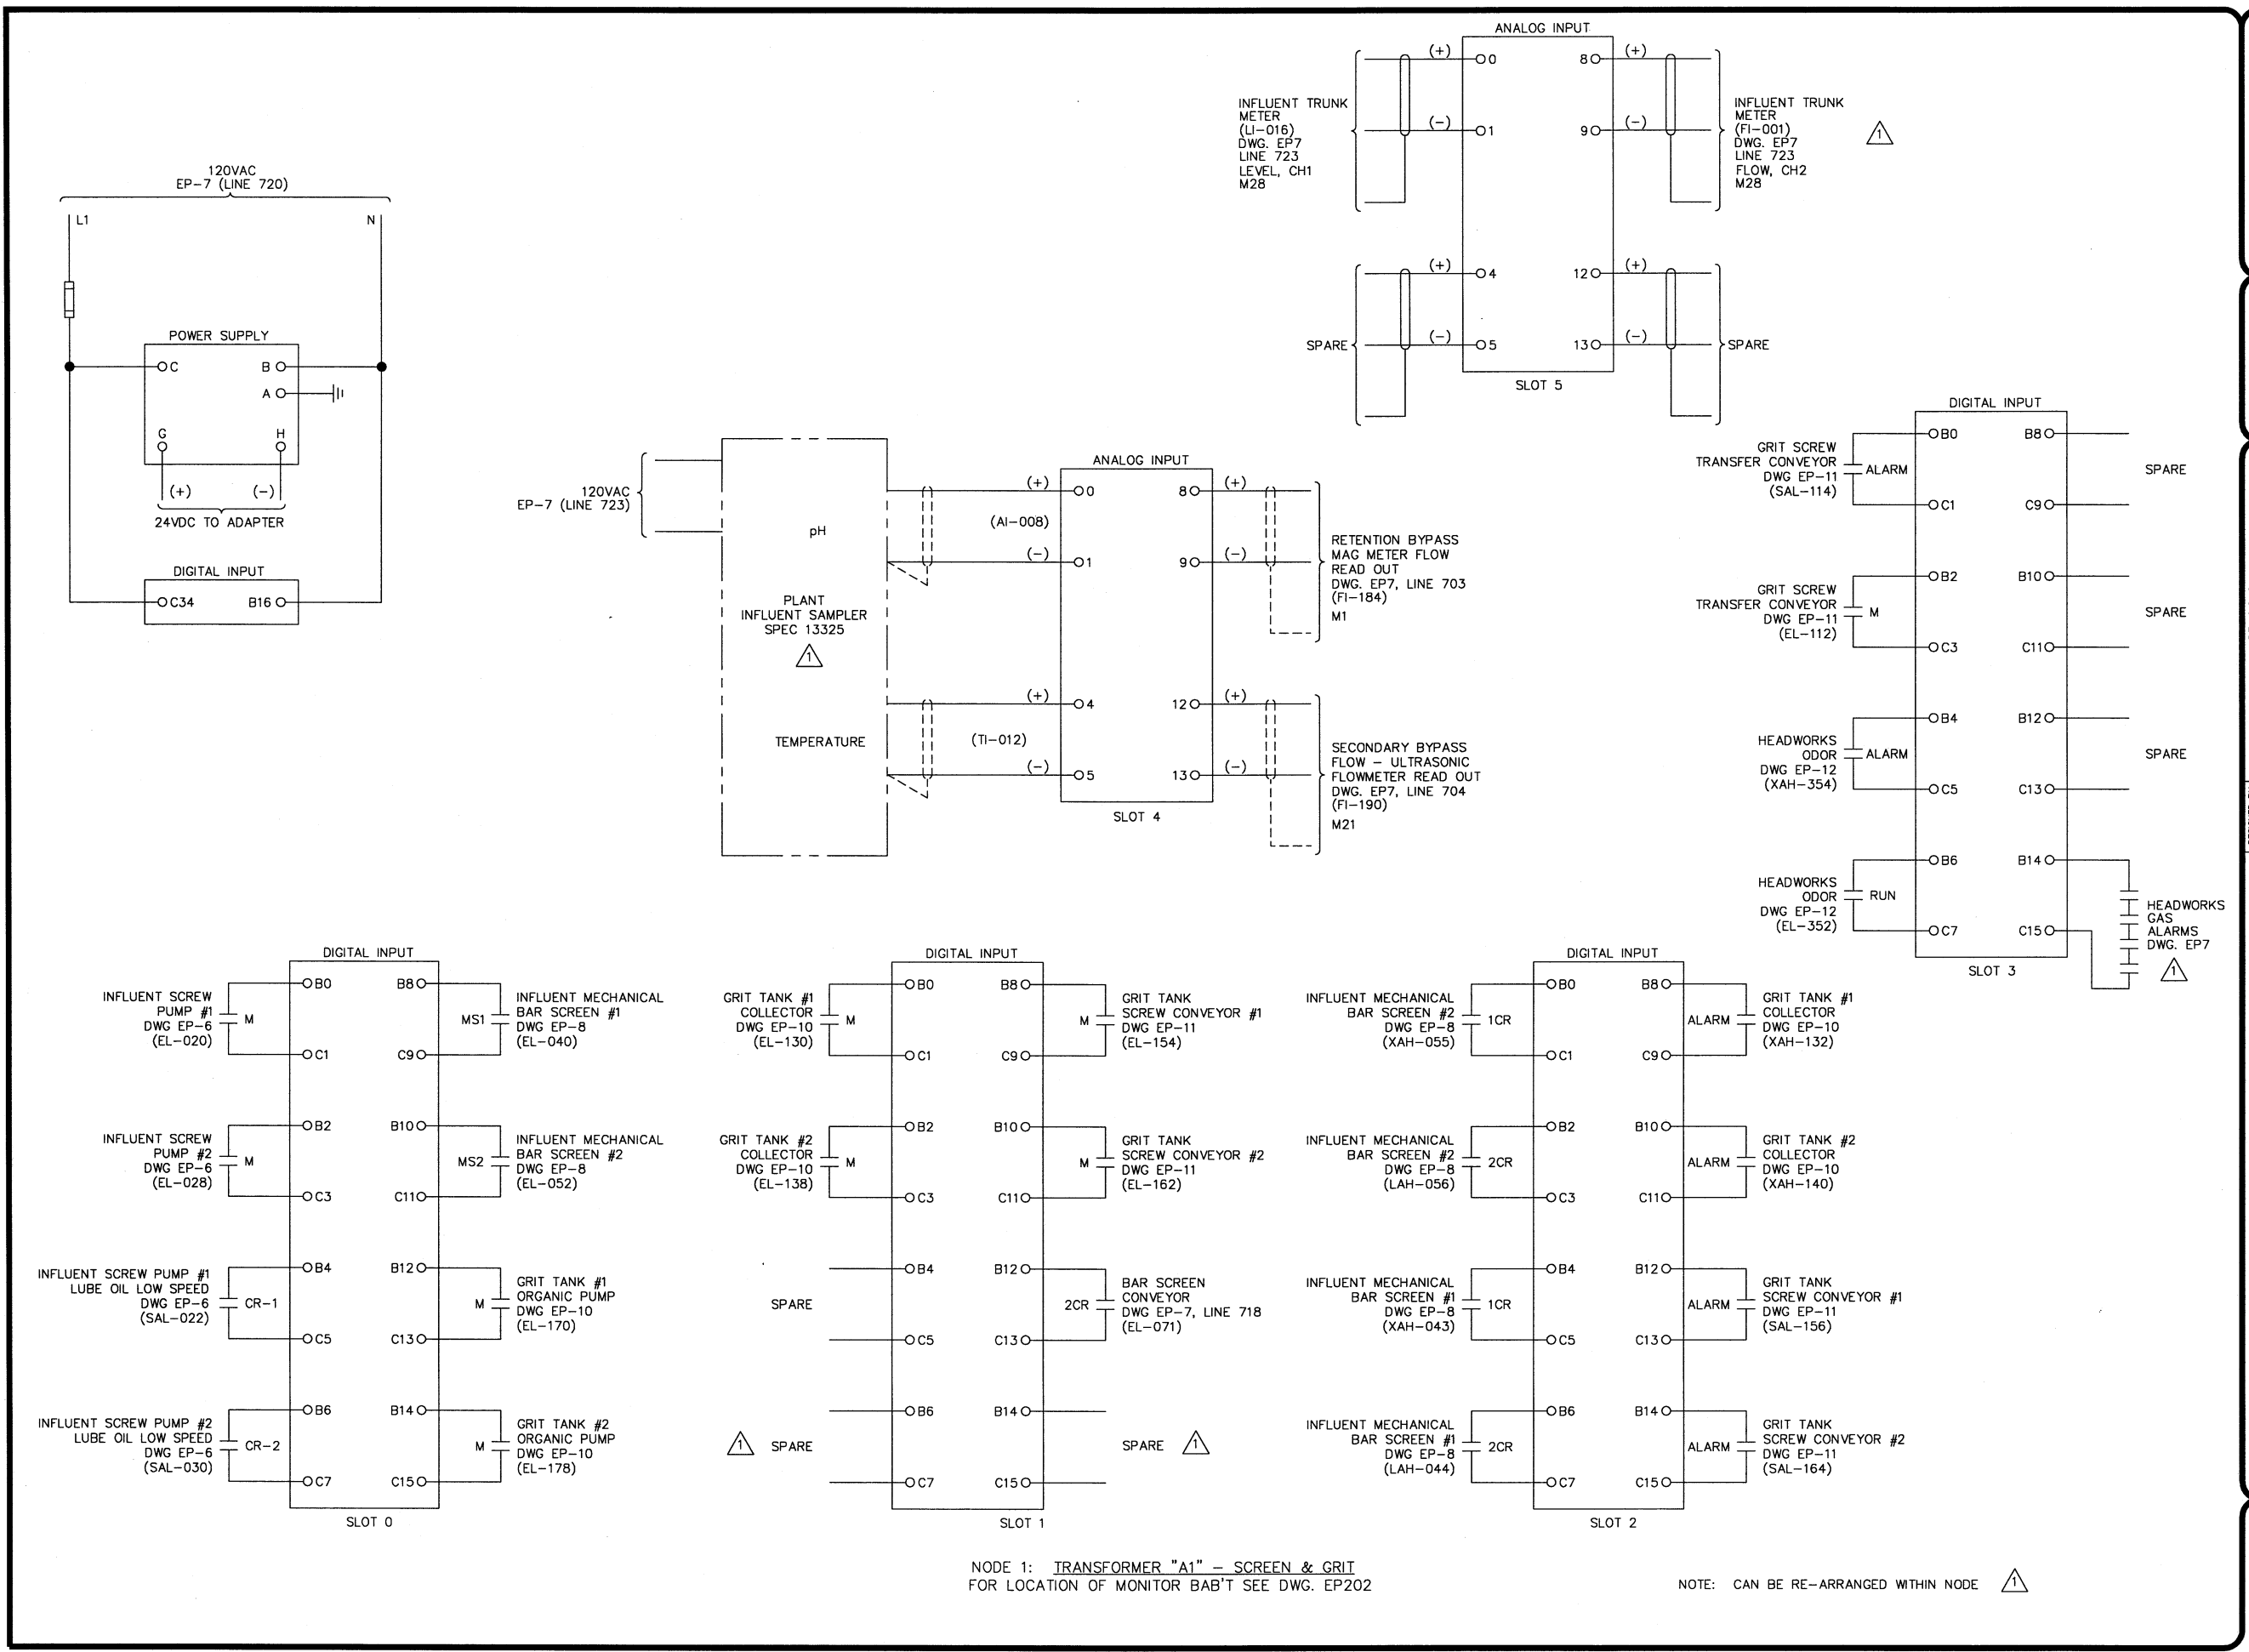

SURRETTE TECHNOLOGIES, INC.
MASSILLON, OHIO
44860-3674

DESIGNED BY		DRAWN BY		CHECKED BY		APPROVED BY	
STI/R/L	STI/R/L	STI/RRR	STI/R/L	STI/R/L	STI/R/L	STI/R/L	STI/R/L

REVISIONS	
NO.	DESCRIPTIONS
1	12-31-01

ENVIRONMENTAL, INC.
ENGINEERS IN WATER AND EARTH SCIENCES
UNIONTOWN, OHIO

CITY OF MASSILLON, OHIO
WWTP UPGRADE 2000
MONITORING SYSTEM - I/O DIAGRAM - NODE 1
TRANSFORMER "A1" - SCREEN & GRIT

JOB NO.
9031

DATE
6/1/01

SCALE
N/A

SHEET
EP502-1