



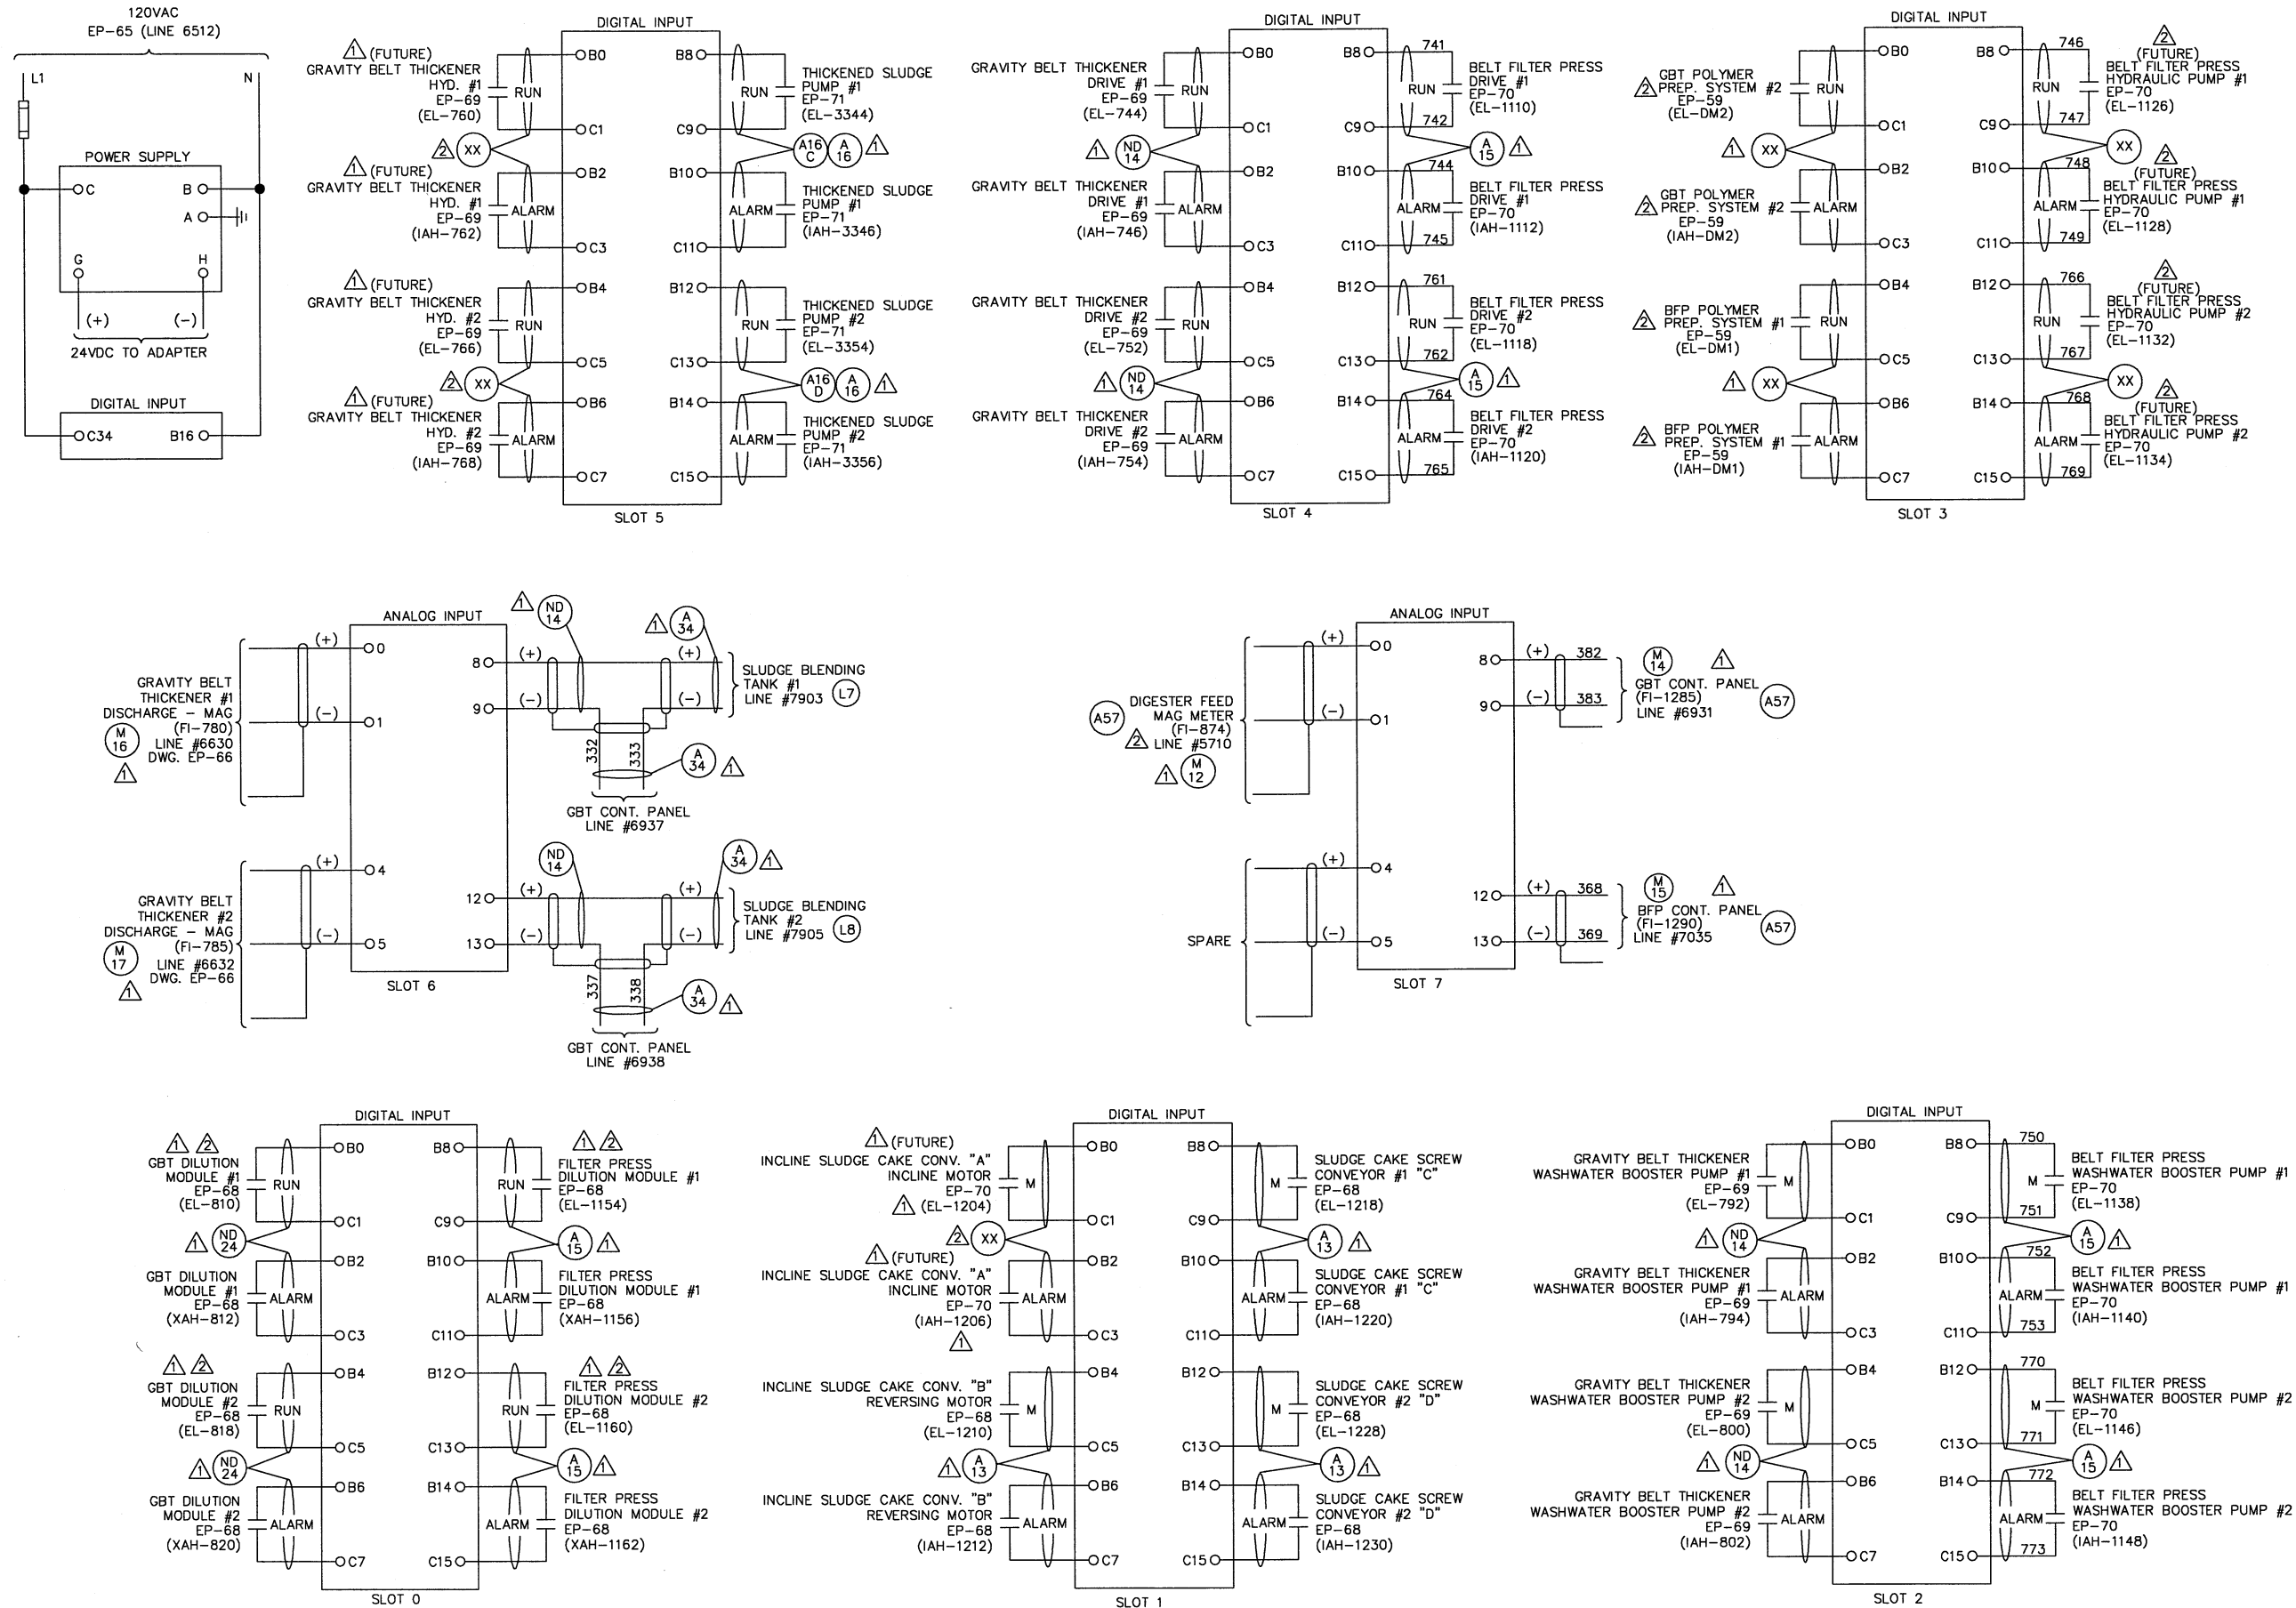

NODE 5: TRANSFORMER "D1" - SOLIDS HANDLING UNIT #2

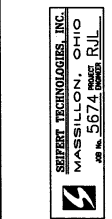

DESIGNED BY	DATE	BY	APPROVED
STI/R/L	7/24/00	TSS	R/L
DRAWN BY	7/24/00	TSS	R/L
CHECKED BY	7/24/00	TSS	R/L
APPROVED BY			

ENVIRONMENTAL, INC.
ENGINEERS IN WATER AND EARTH SCIENCES
UNIONTOWN, OHIO

CITY OF MASSILLON, OHIO
WWTP UPGRADE 2000
MONITORING SYSTEM - I/O DIAGRAM - NODE 5
TRANSFORMER "D1" - SOLIDS HANDLING UNIT #2

JOB NO.	E9031
DATE	6-1-01
SCALE	N/A
SHEET	EP506-2