

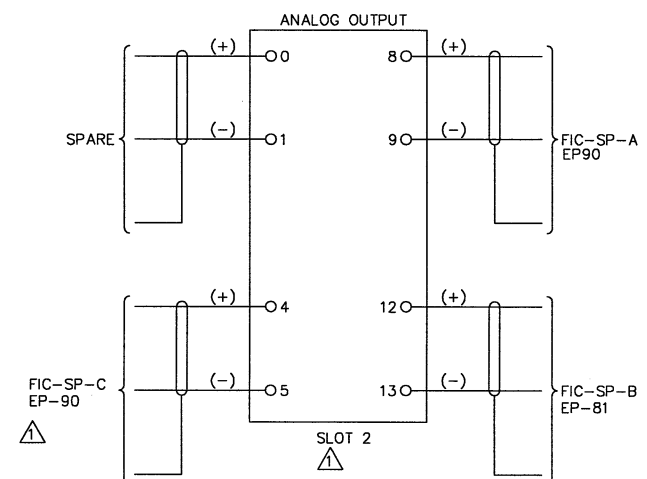
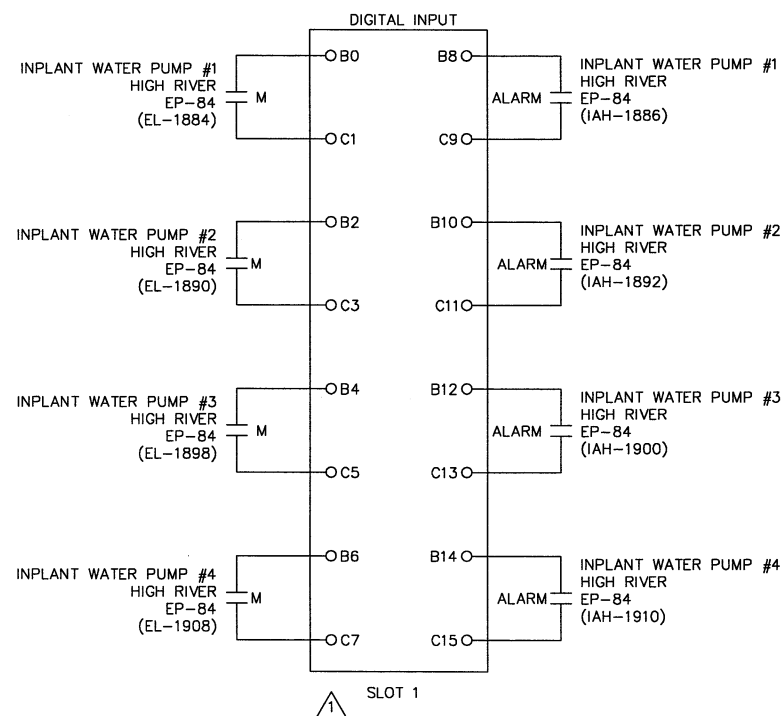
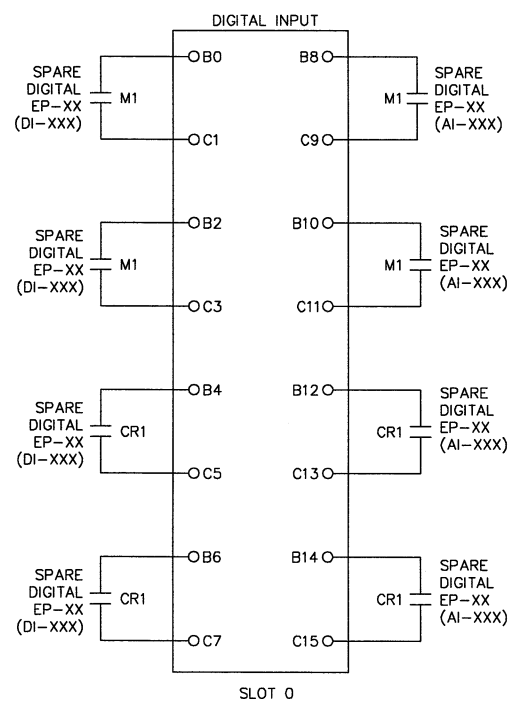
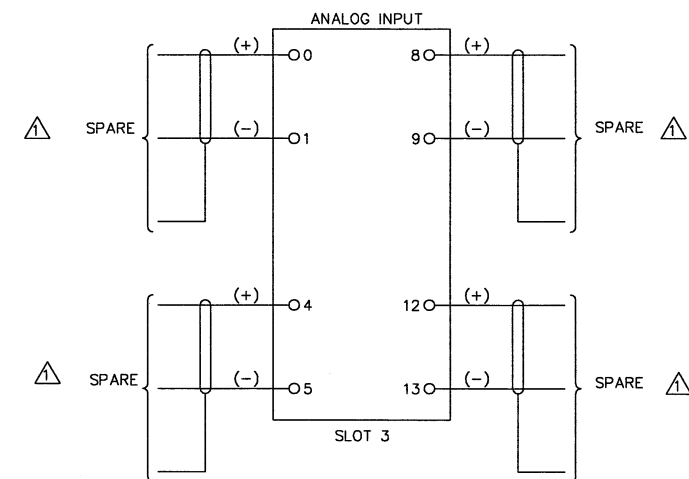
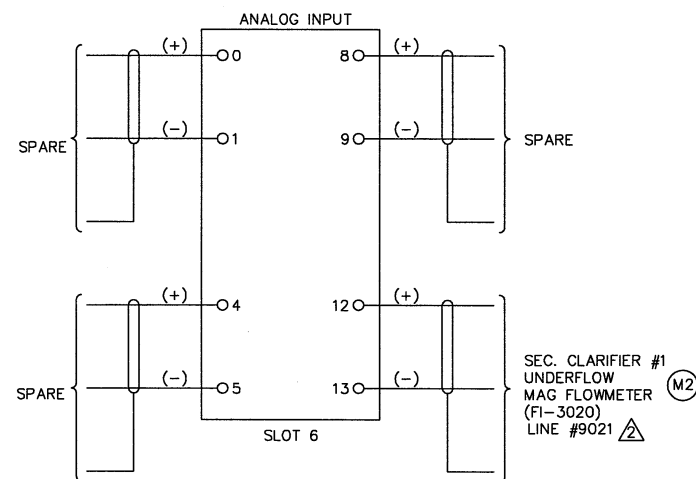
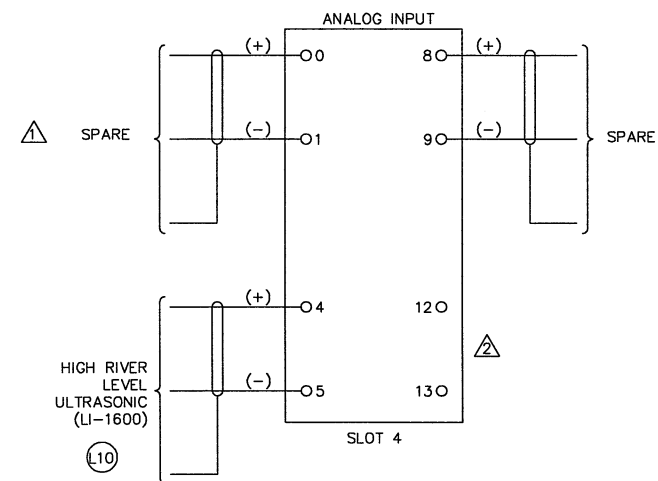


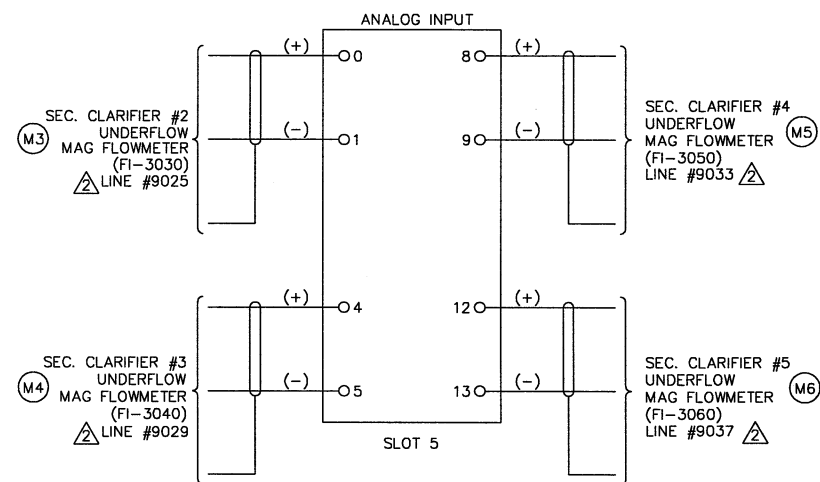


MAIN RACK: TRANSFORMER "D2" - SEC. CLARIFIERS & PLANT EFFLUENT

NOTE: CAN BE RE-ARRANGED WITHIN NODE

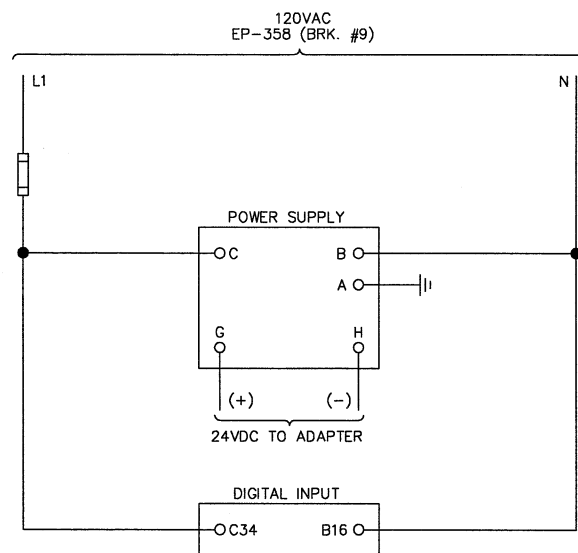

DESIGNED BY	NO.	DESCRIPTIONS	DATE	BY	APP'D
STI/R/L	1	UPDATED I/O	1/03	R/L	R/L
STI/R/L	2	REVISED LABELS	7/00/01	TSS	R/L
CHECKED BY					
STI/R/L					
APPROVED BY					
STI/R/L					

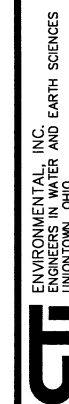

CITY OF MASSILLON, OHIO
WWTP UPGRADE 2000
MONITORING SYSTEM - I/O DIAGRAM - MAIN RACK
TRANSFORMER "D2" SEC. CLARIFIERS & PLANT EFFLUENT

JOB NO.	9031
DATE	6/6/01
SCALE	N/A
SHEET	EP513-2