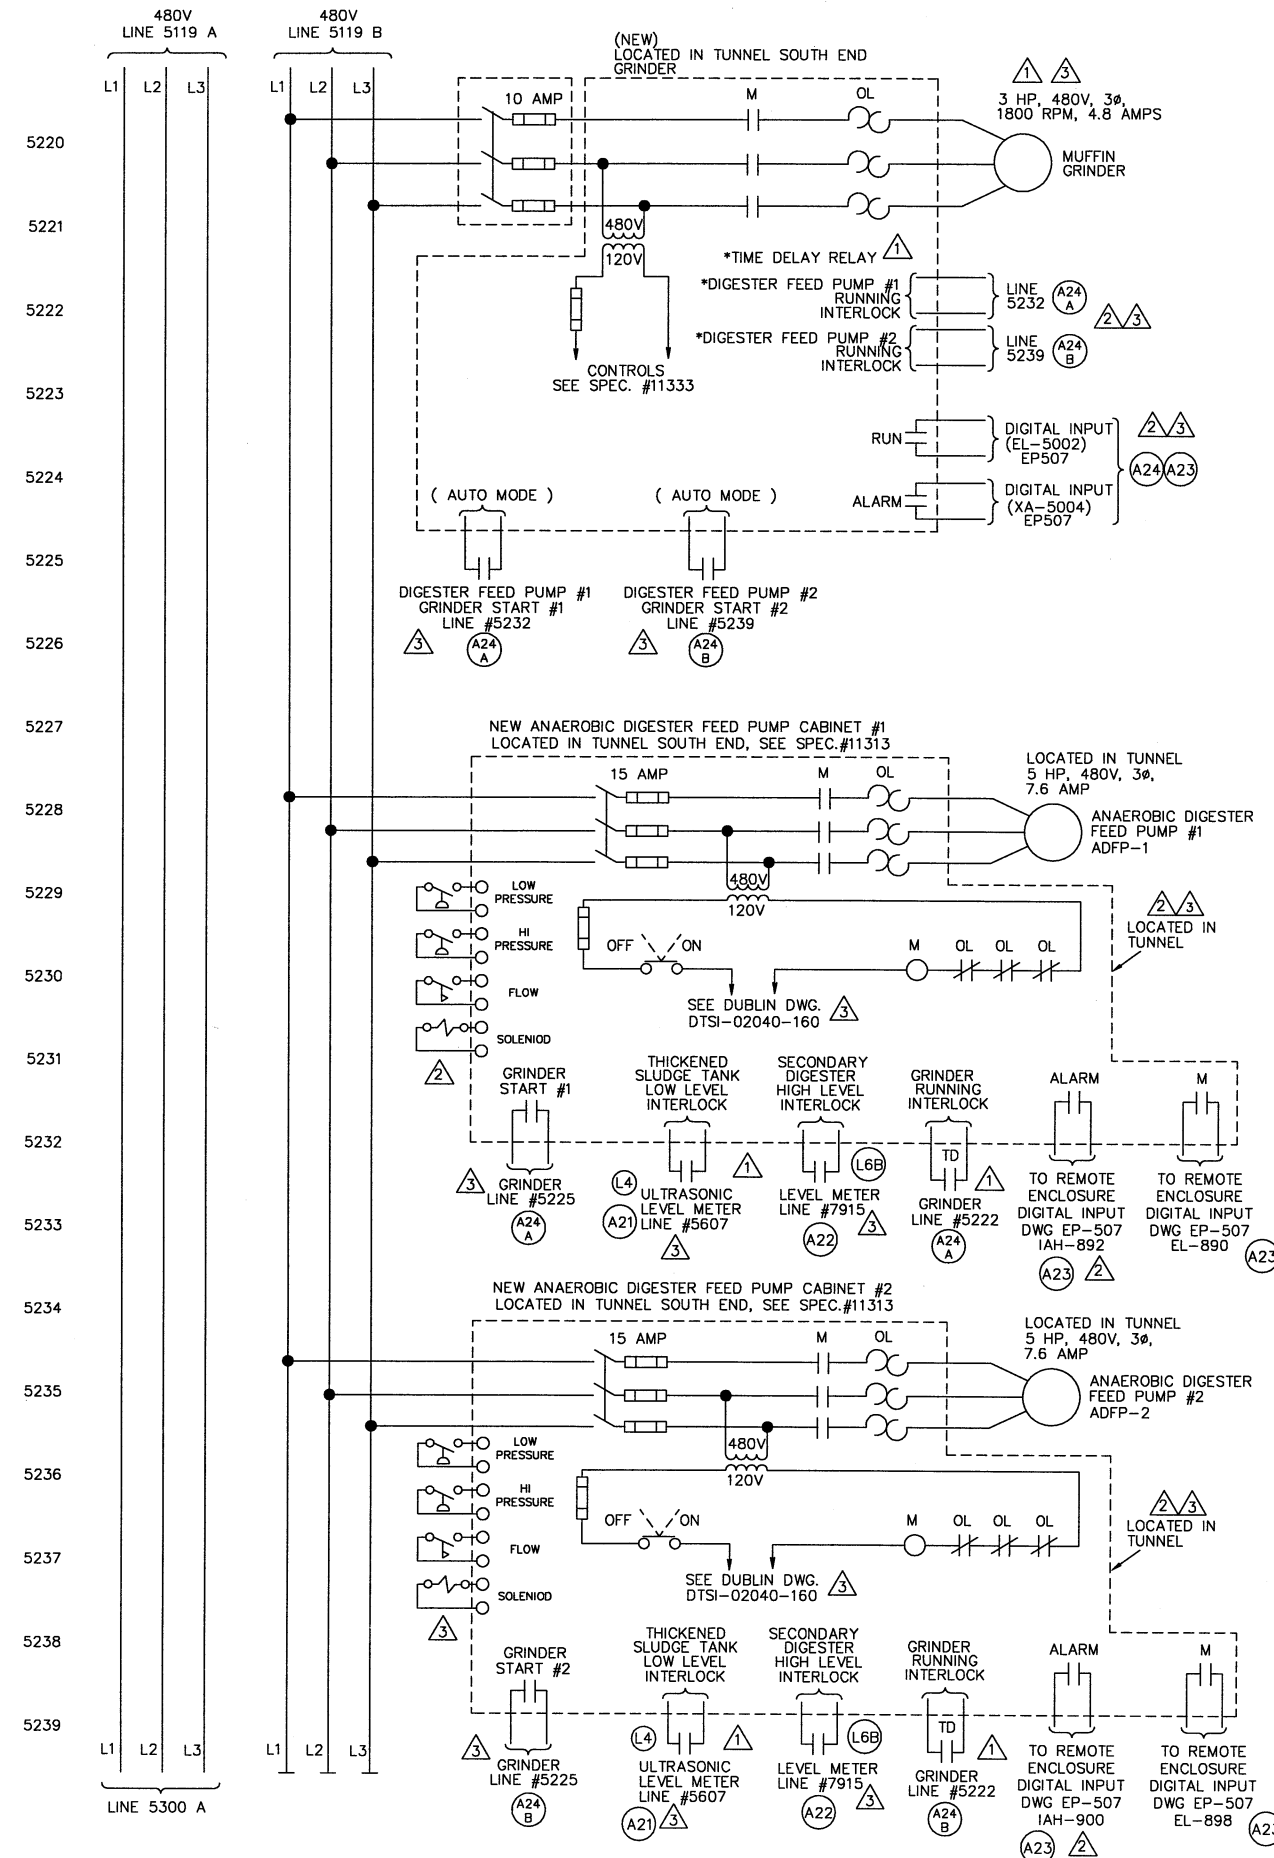
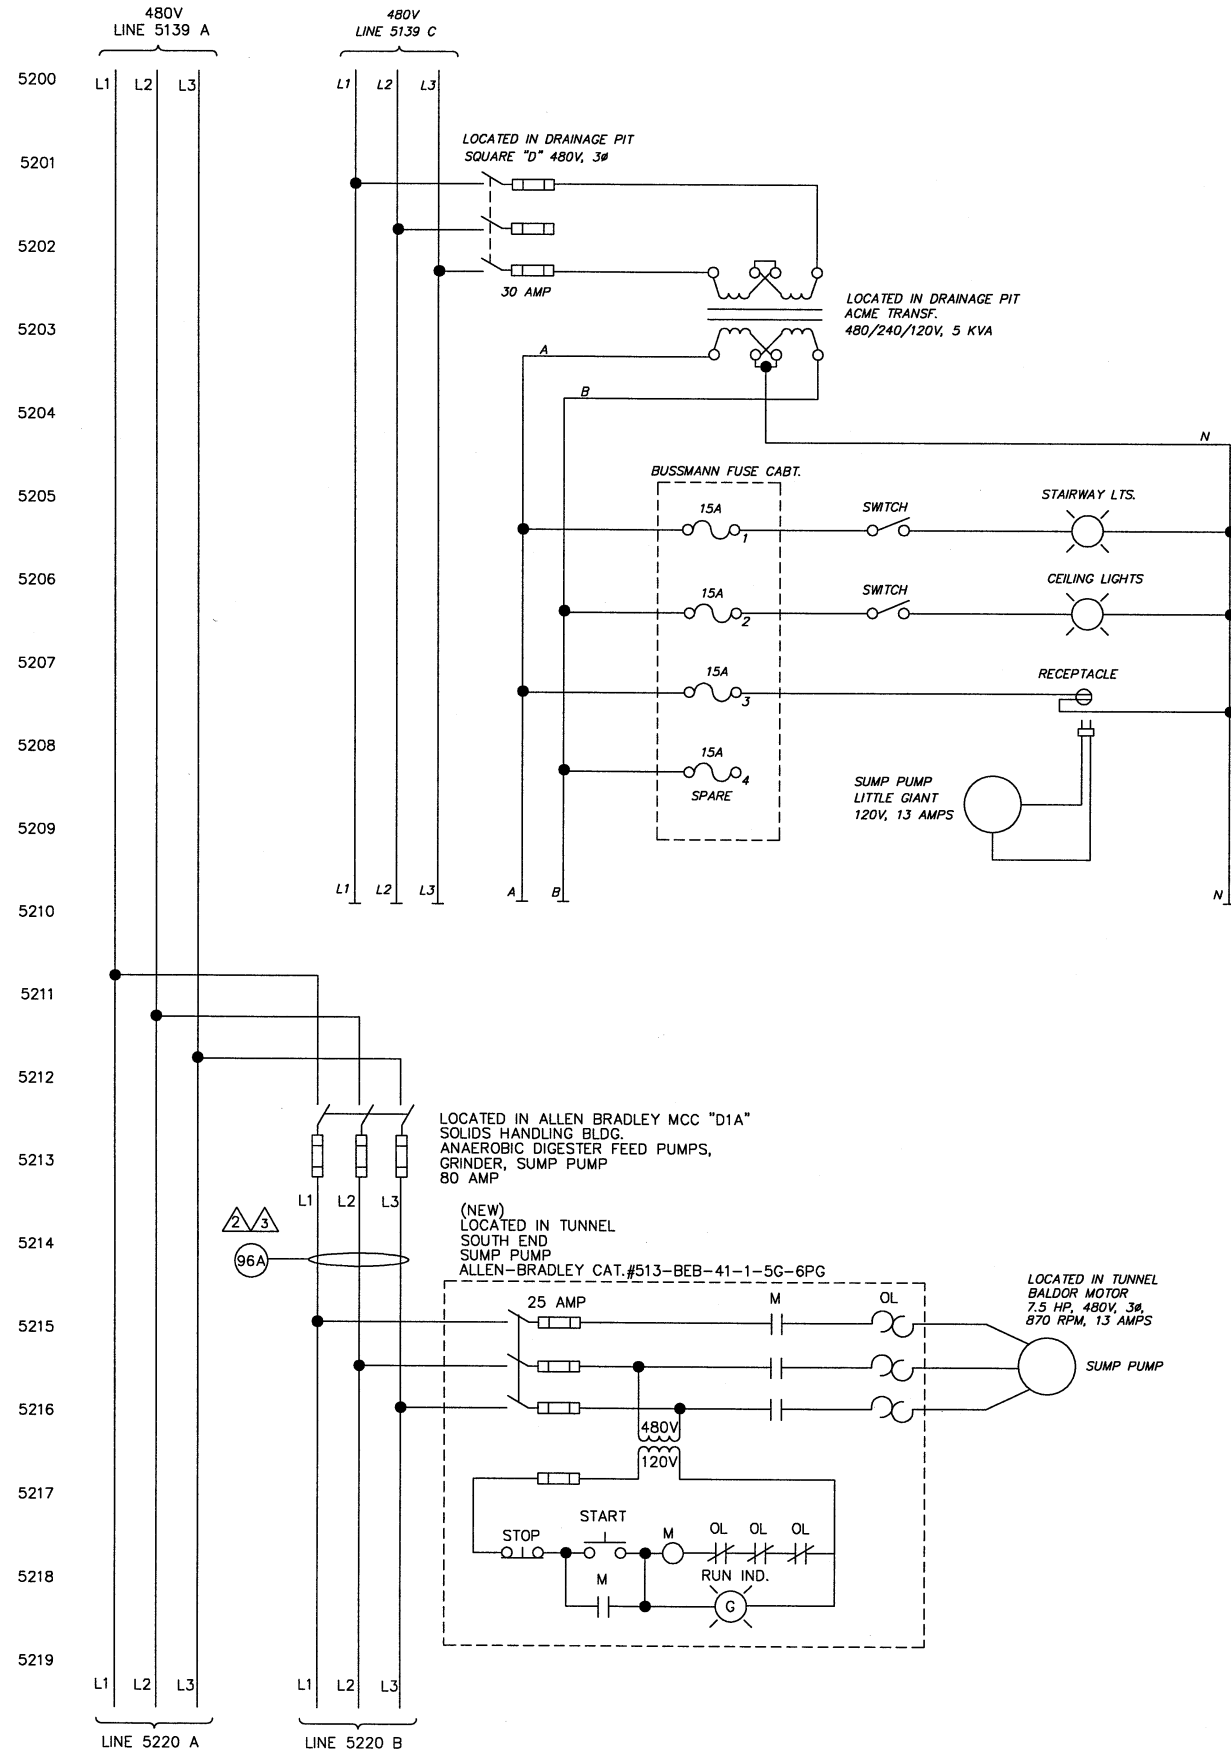


NO.	DESCRIPTIONS	DATE	BY	APP'D
1	ADDED GRINDER INTERLOCK	1/13/01	TSS	R.L.
2	ADDED INTERCONNECTIONS	1/13/01	LOVE	R.L.
3	REVISED FOR CONSTRUCTION	7/20/01	TSS	R.L.

DESIGNED BY
STI/TSS

DRAWN BY
STI/TSS

CHECKED BY
STI/TSS

APPROVED BY
STI/R.L.

ENVIRONMENTAL, INC.
ENGINEERS IN WATER AND EARTH SCIENCES
UNIONTOWN, OHIO

CITY OF MASSILLON, OHIO
WWTP UPGRADE 2000
TRANSFORMER "D1", MCC-D1A
DIGESTER FEED PUMPS, SUMP PUMP, & GRINDER SCHEMATIC

JOB NO. E9031
DATE 2/16/01
SCALE N/A
SHEET EP52-3