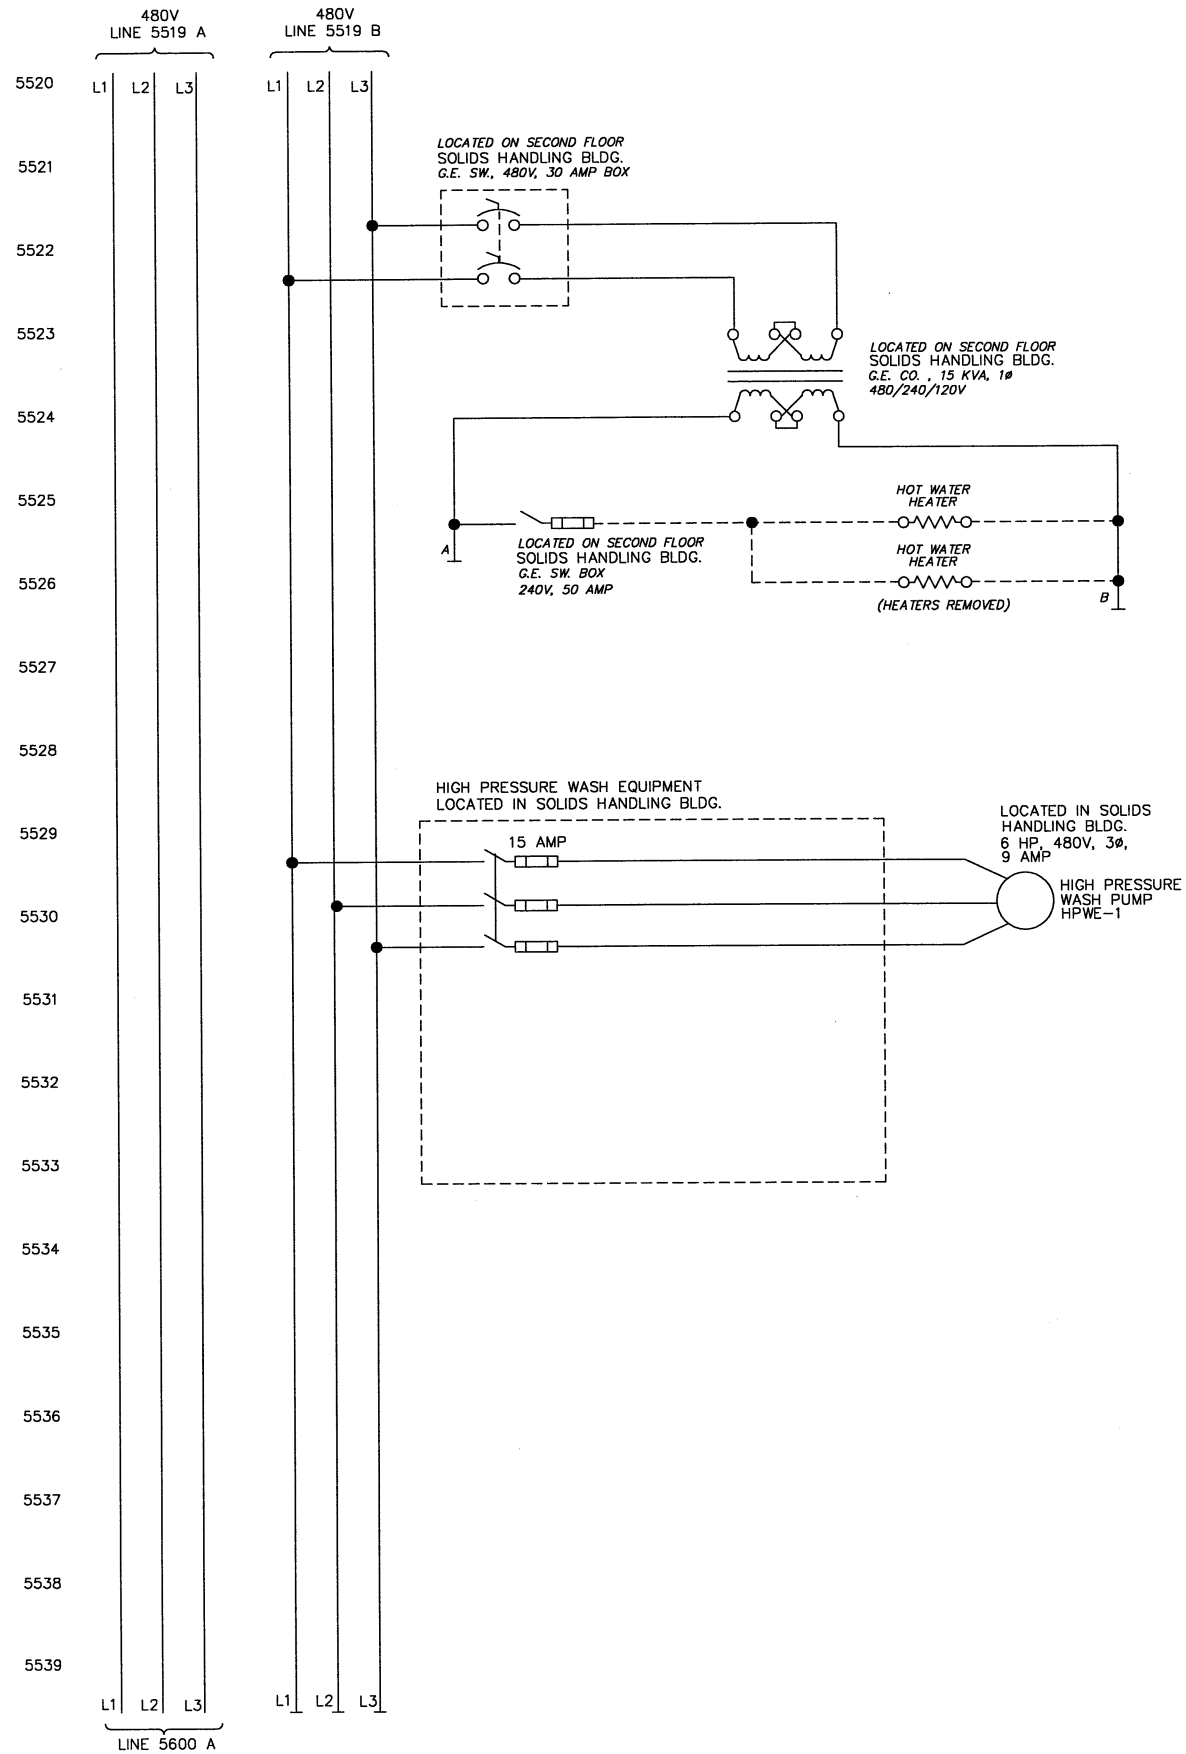
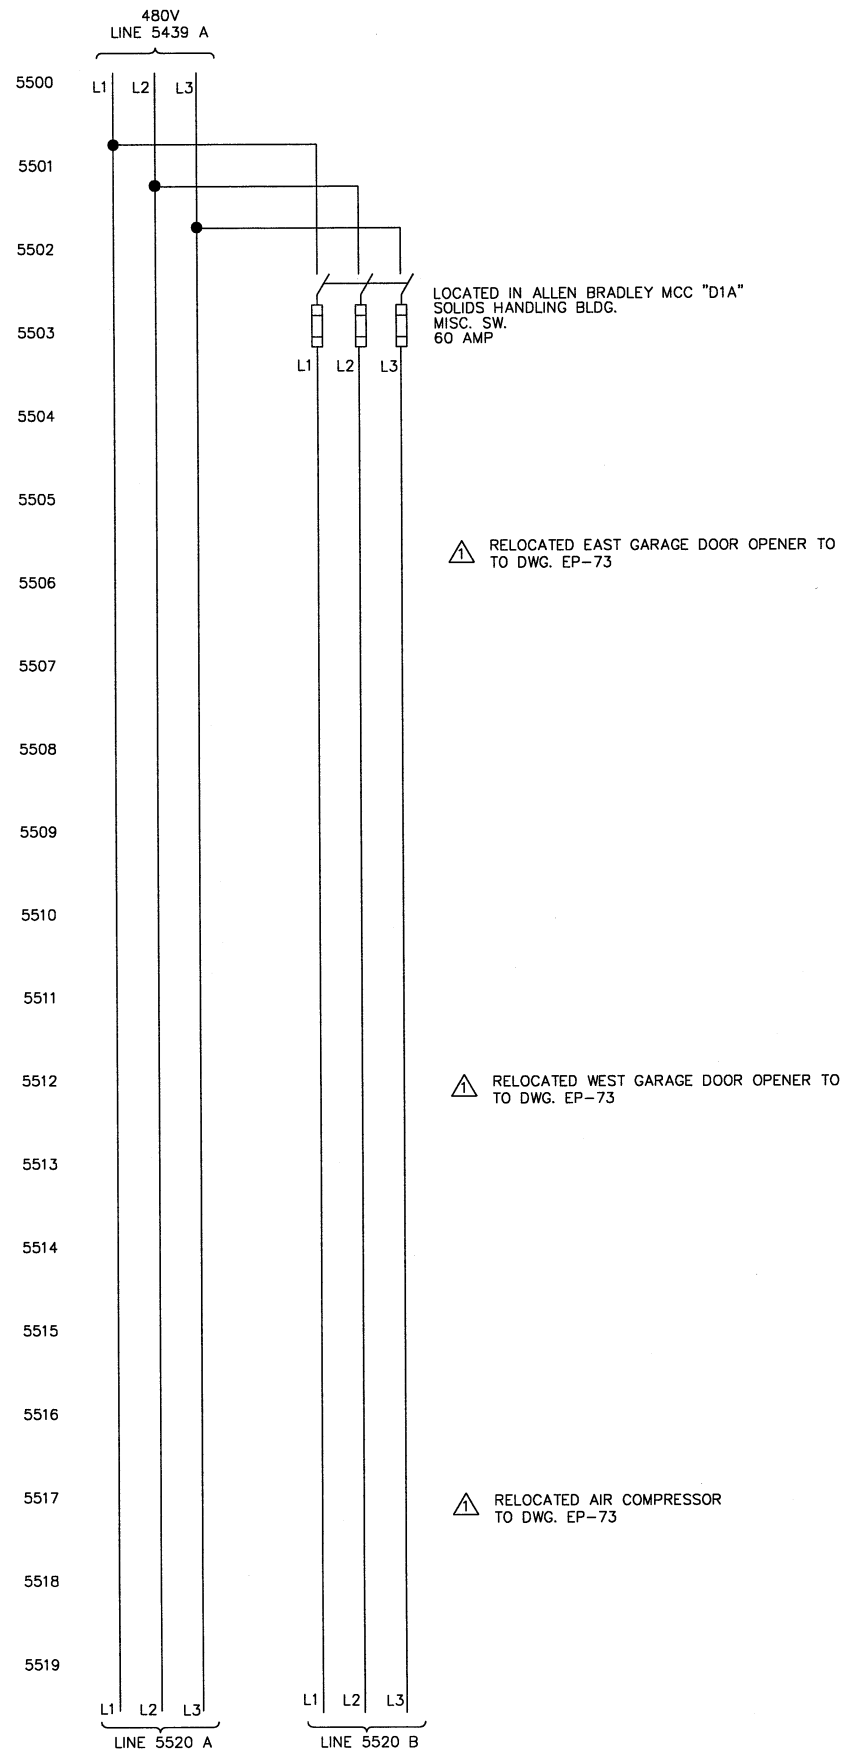


NO.	REVISIONS	DESCRIPTIONS	DATE	BY	APP'D
1		REVISED AFTER CONSTRUCTION	7/20/03	TSS	R/L
DESIGNED BY STI/TSS					
DRAWN BY STI/RRR					
CHECKED BY STI/TSS					
APPROVED BY STI/R/L					
ENVIRONMENTAL, INC. ENGINEERS, ARCHITECTS AND EARTH SCIENCES UNIONTOWN, OHIO					
CITY OF MASSILLON, OHIO WWTP UPGRADE 2000 TRANSFORMER "D1", MCC-D1A GARAGE DOORS, AIR COMP, & WASH PUMP SCHEMATIC DIAGRAM					

JOB NO. E9031
DATE 2/16/01
SCALE N/A
SHEET EP55-1