
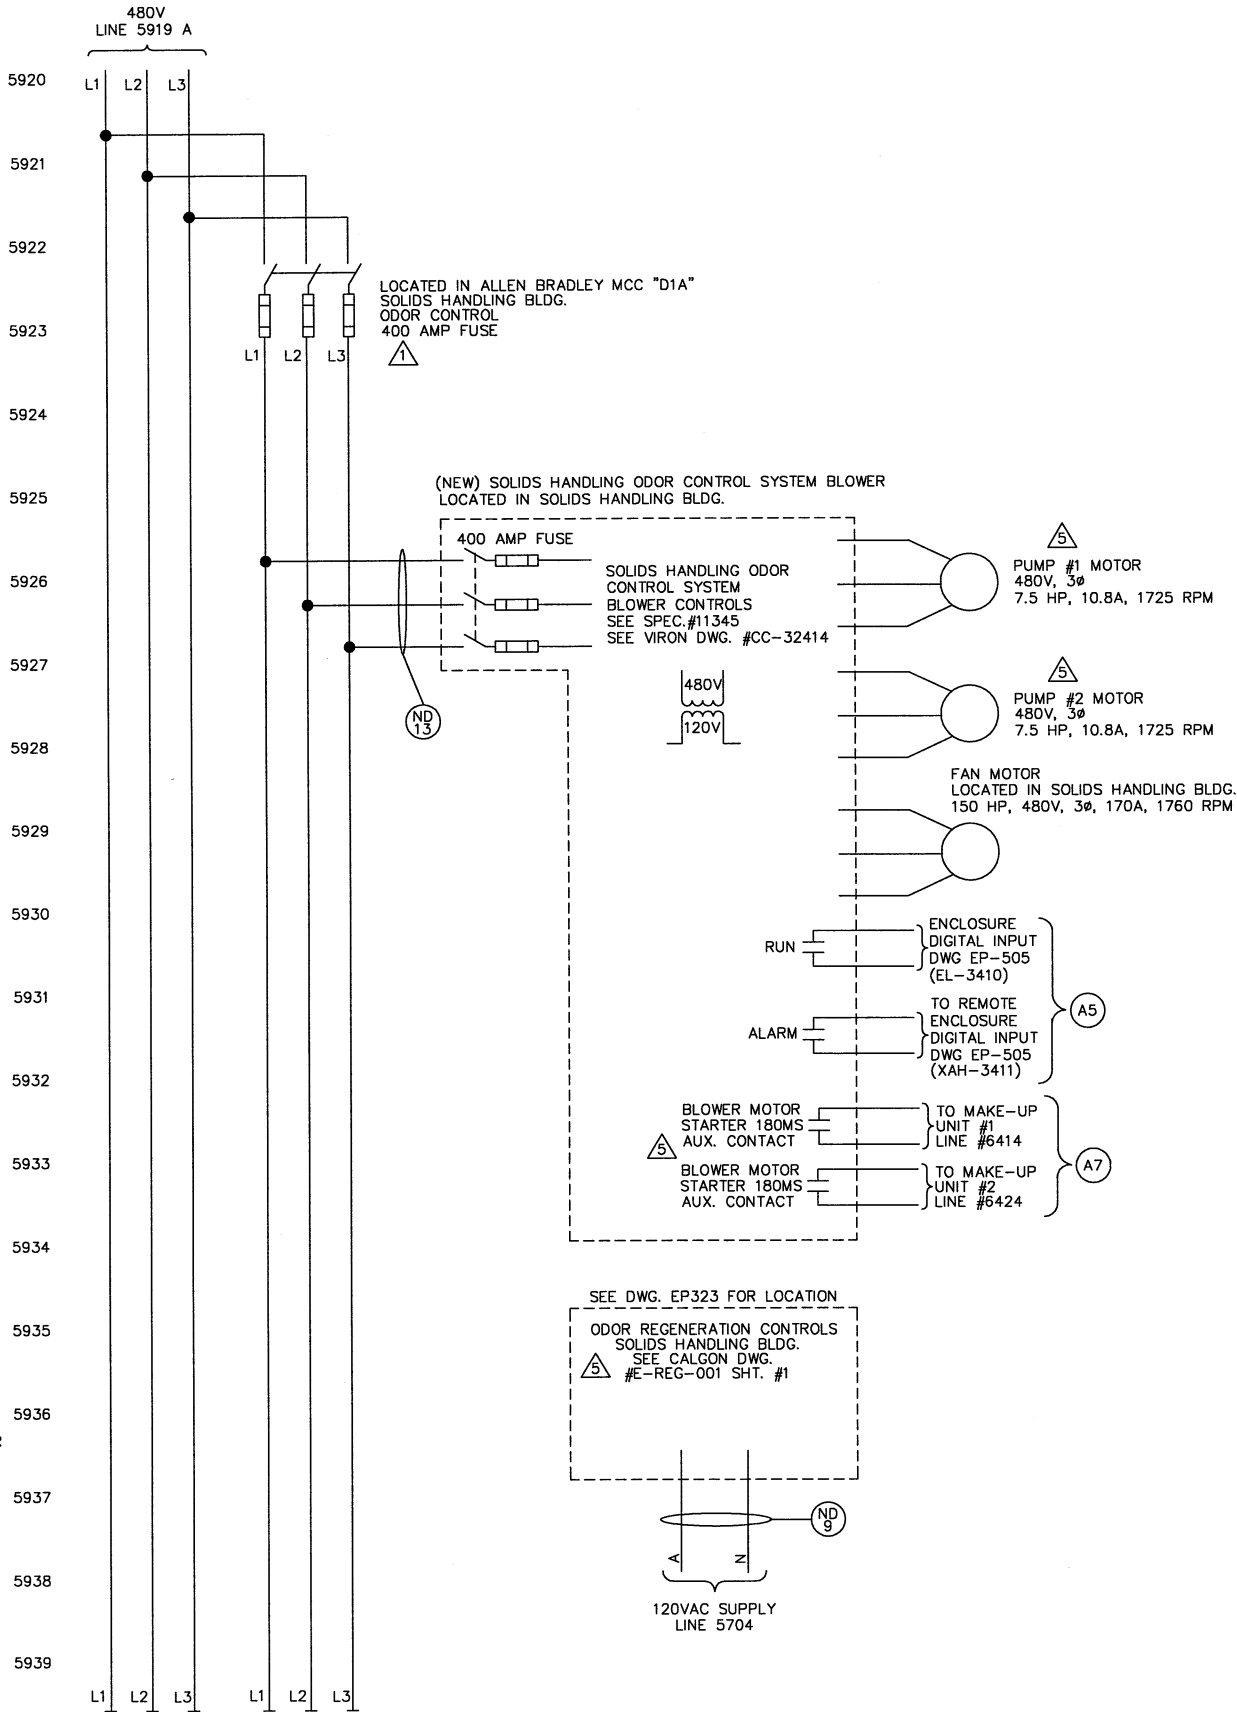


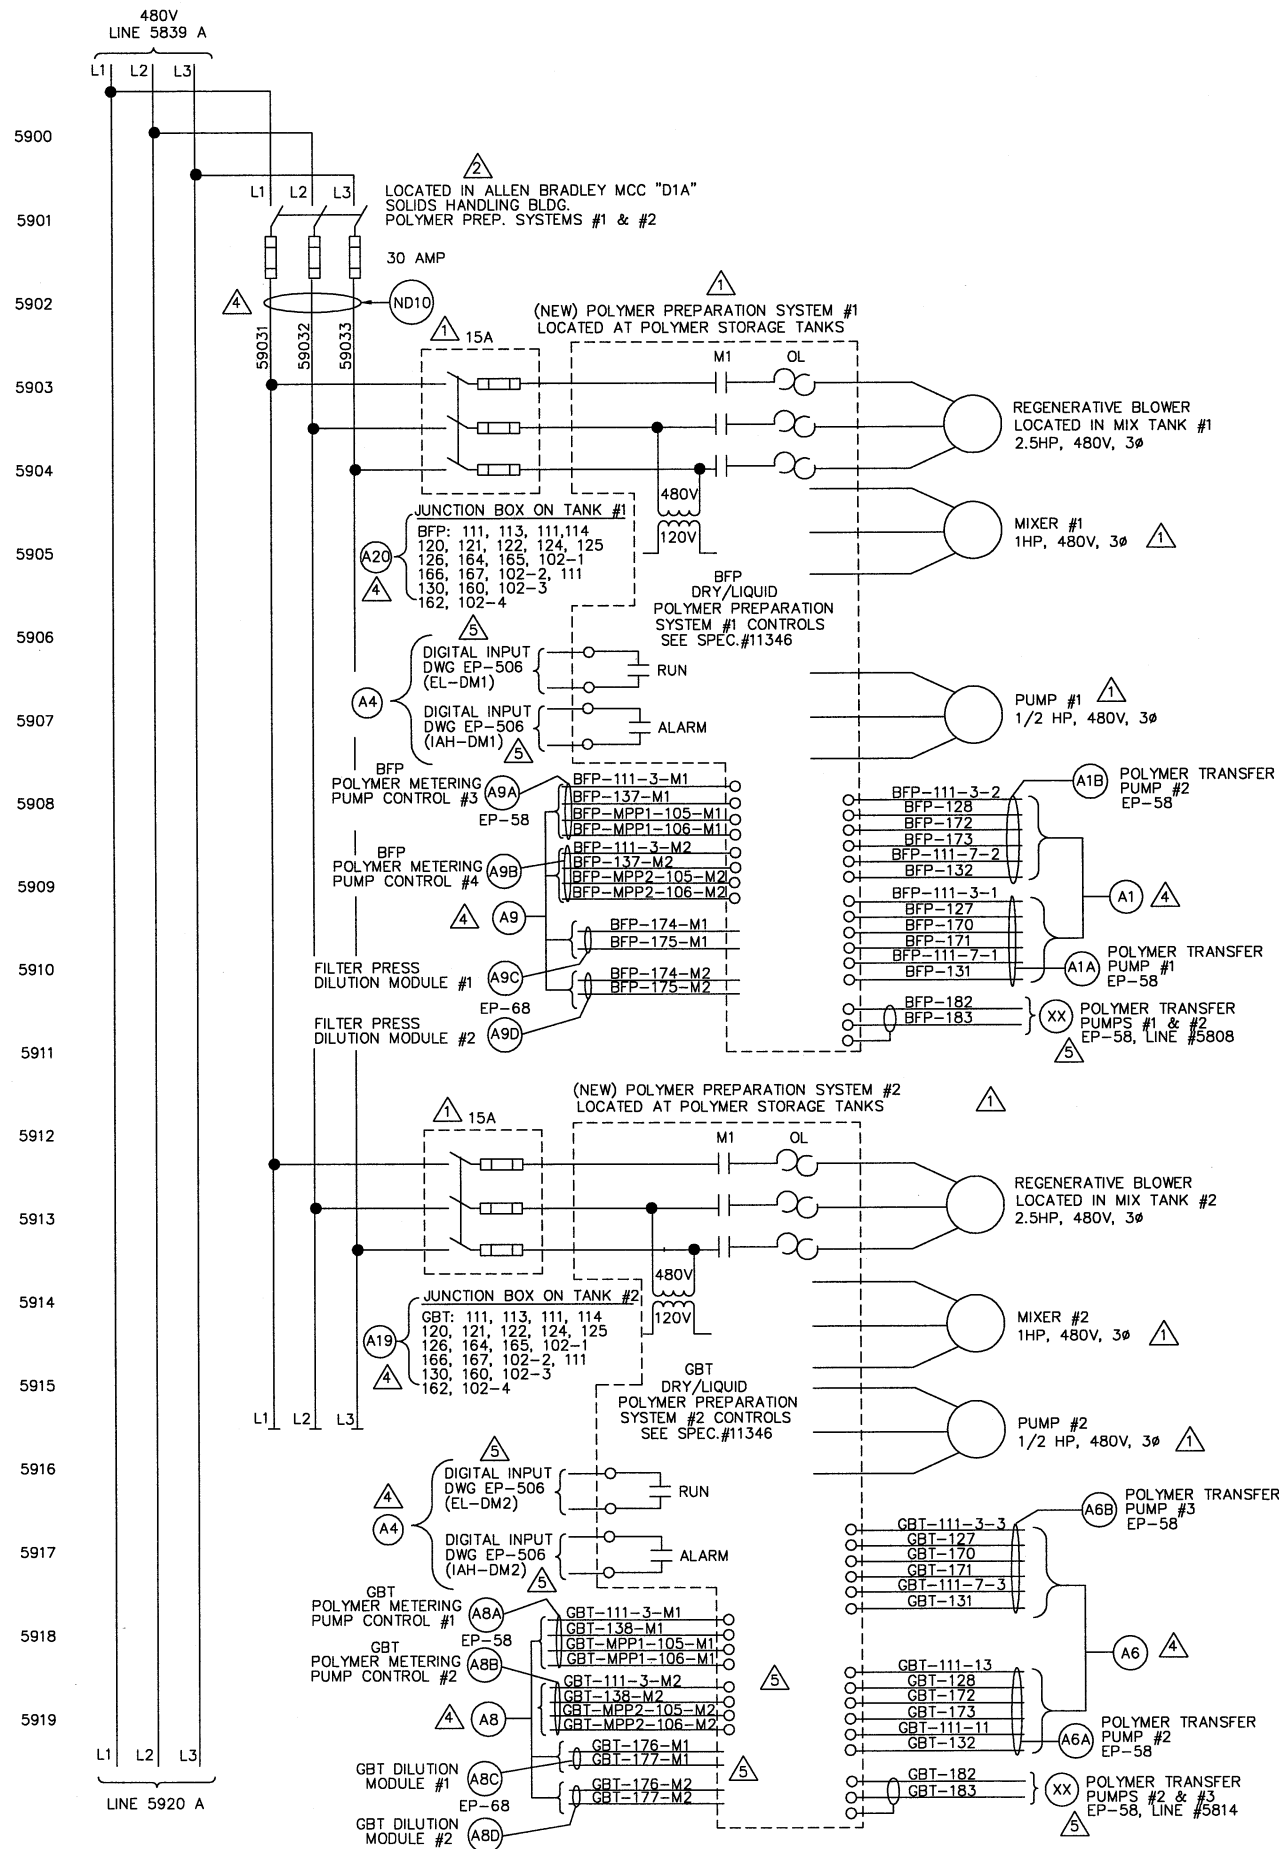

SEIERT TECHNOLOGIES, INC.
MASSILLON, OHIO
5674

DESIGNED BY	NO.	DATE	BY	APPROVED
STI/TSS	1	7/1/04	TSS	R/L
STI/TSS	2	7/1/04	TSS	R/L
STI/TSS	3	7/1/04	TSS	R/L
STI/TSS	4	7/1/04	TSS	R/L
STI/TSS	5	7/1/04	TSS	R/L

ENVIRONMENTAL, INC.
MASSILLON, OHIO
WWTU UPGRADE 2000
TRANSFORMER "D1", MCC-D1A
BLOWER MOTORS SCHEMATIC DIAGRAM

JOB NO.	E9031
DATE	01/05/01
SCALE	N/A
SHEET	EP59-5

9031SCHE59.DWG