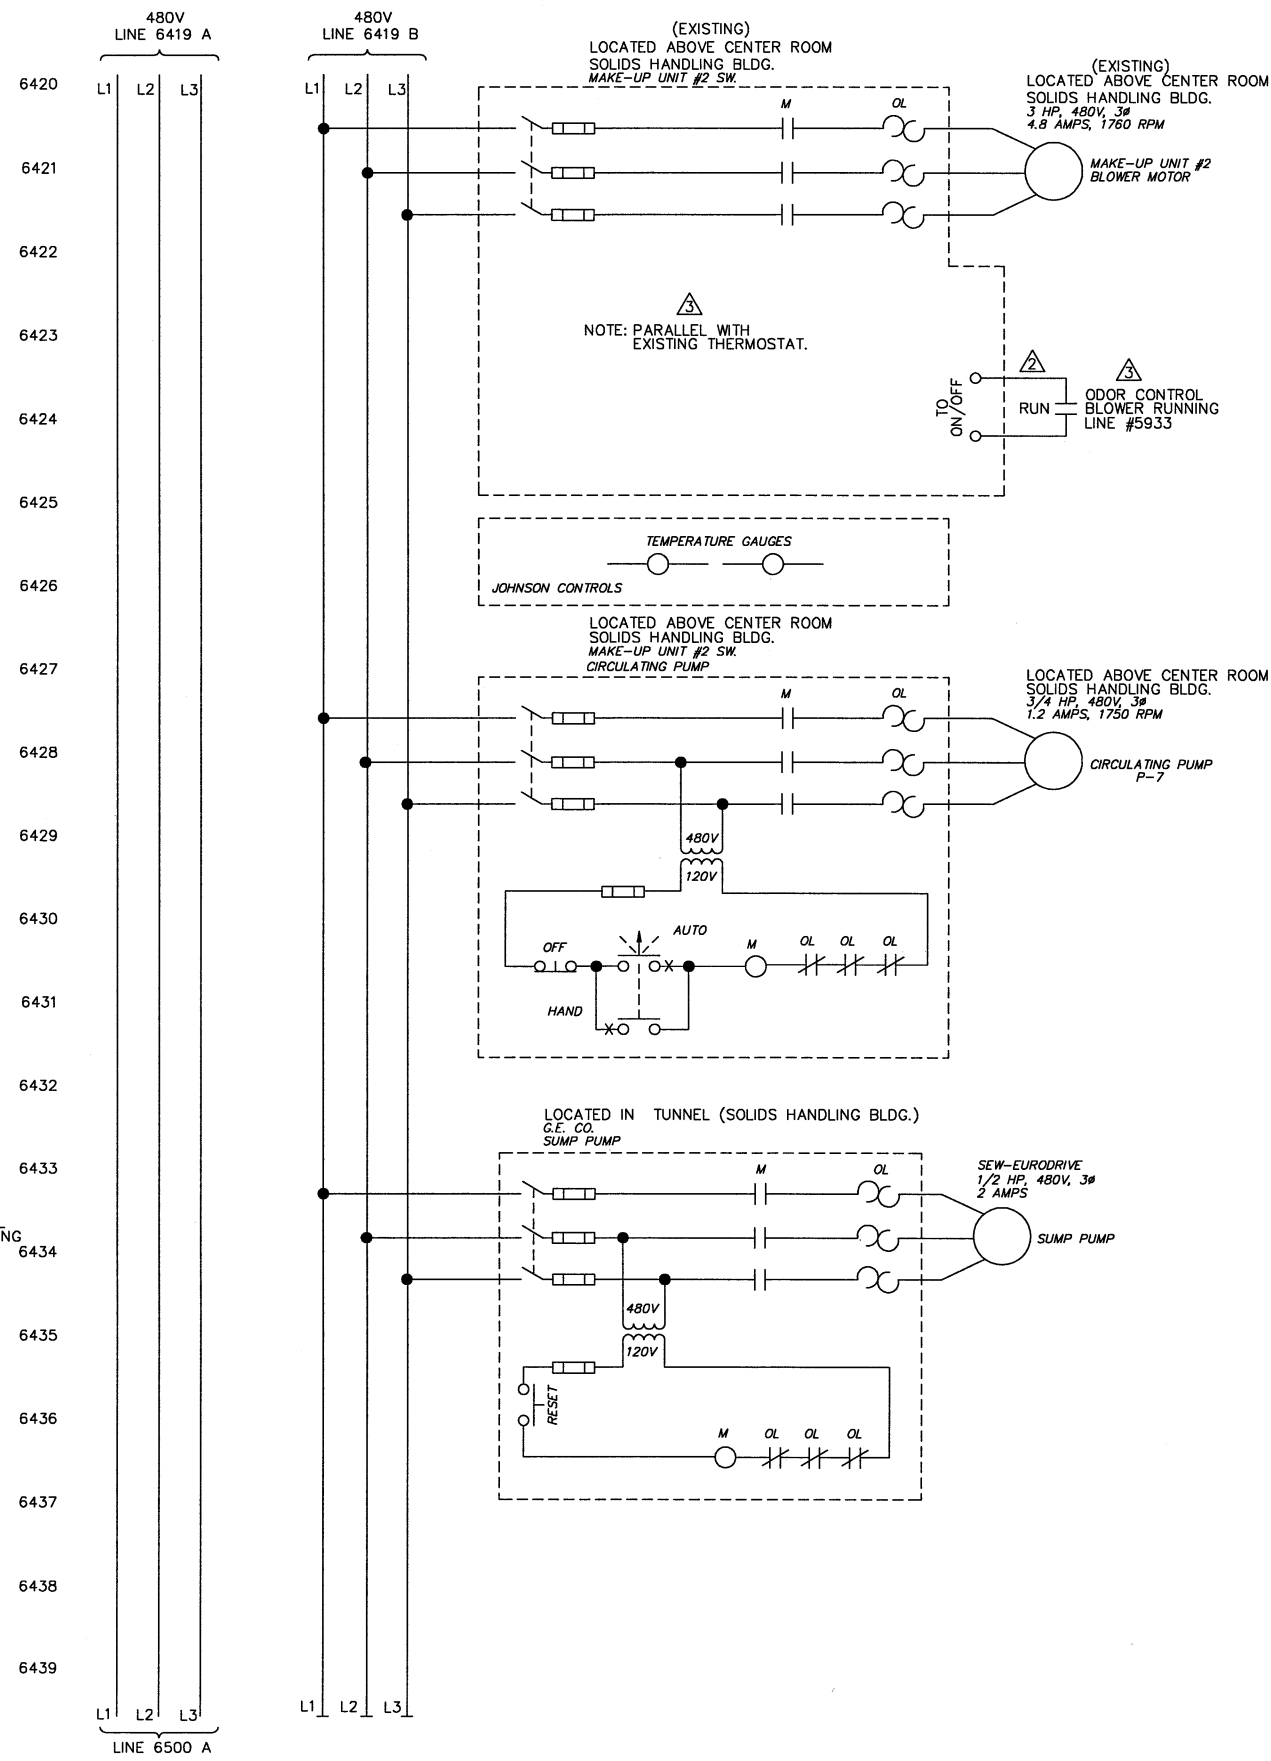
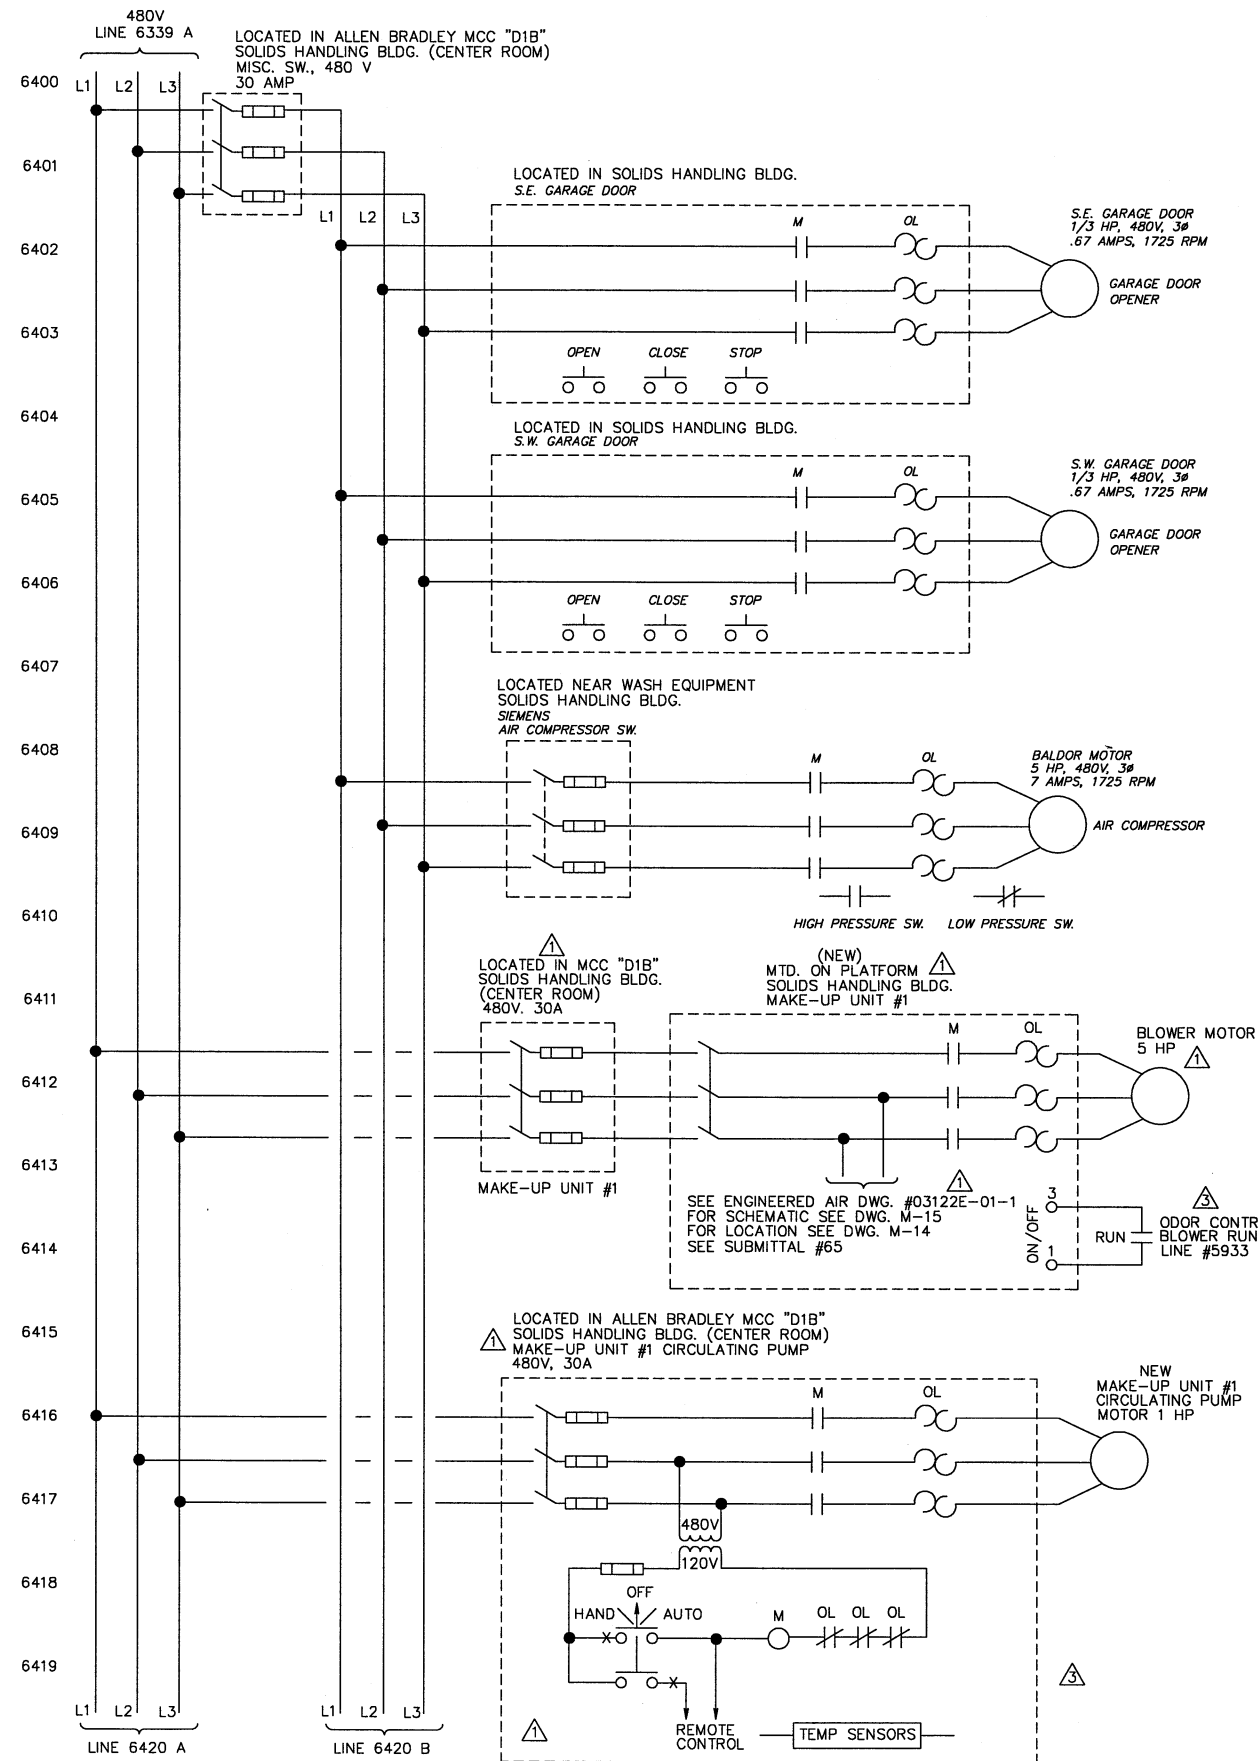


NO.	DESCRIPTIONS	DATE	BY	APP'D
1	REVISED PER NEW CONSTRUCTION	11/03/00	TSS	R/L
2	ADDED ODOR CONTROL INTERLOCK	11/13/00	TSS	R/L
3	REVISED FOR CONSTRUCTION	7/08/03	TSS	R/L

DESIGNED BY STI/TSS
DRAWN BY STI/TSS
CHECKED BY STI/TSS
APPROVED BY STI/R/L

ENVIRONMENTAL, INC.
ENGINEERS IN WATER AND EARTH SCIENCES
UNIONTOWN, OHIO

CITY OF MASSILLON, OHIO
WWTP UPGRADE 2000
TRANSFORMER "D1", MCC-D1B
GARAGE DOORS, BLOWERS, & SUMP PUMP SCHEMATIC DIAGRAM

JOB NO. E9031
DATE 3/1/01
SCALE N/A
SHEET EP64-3