


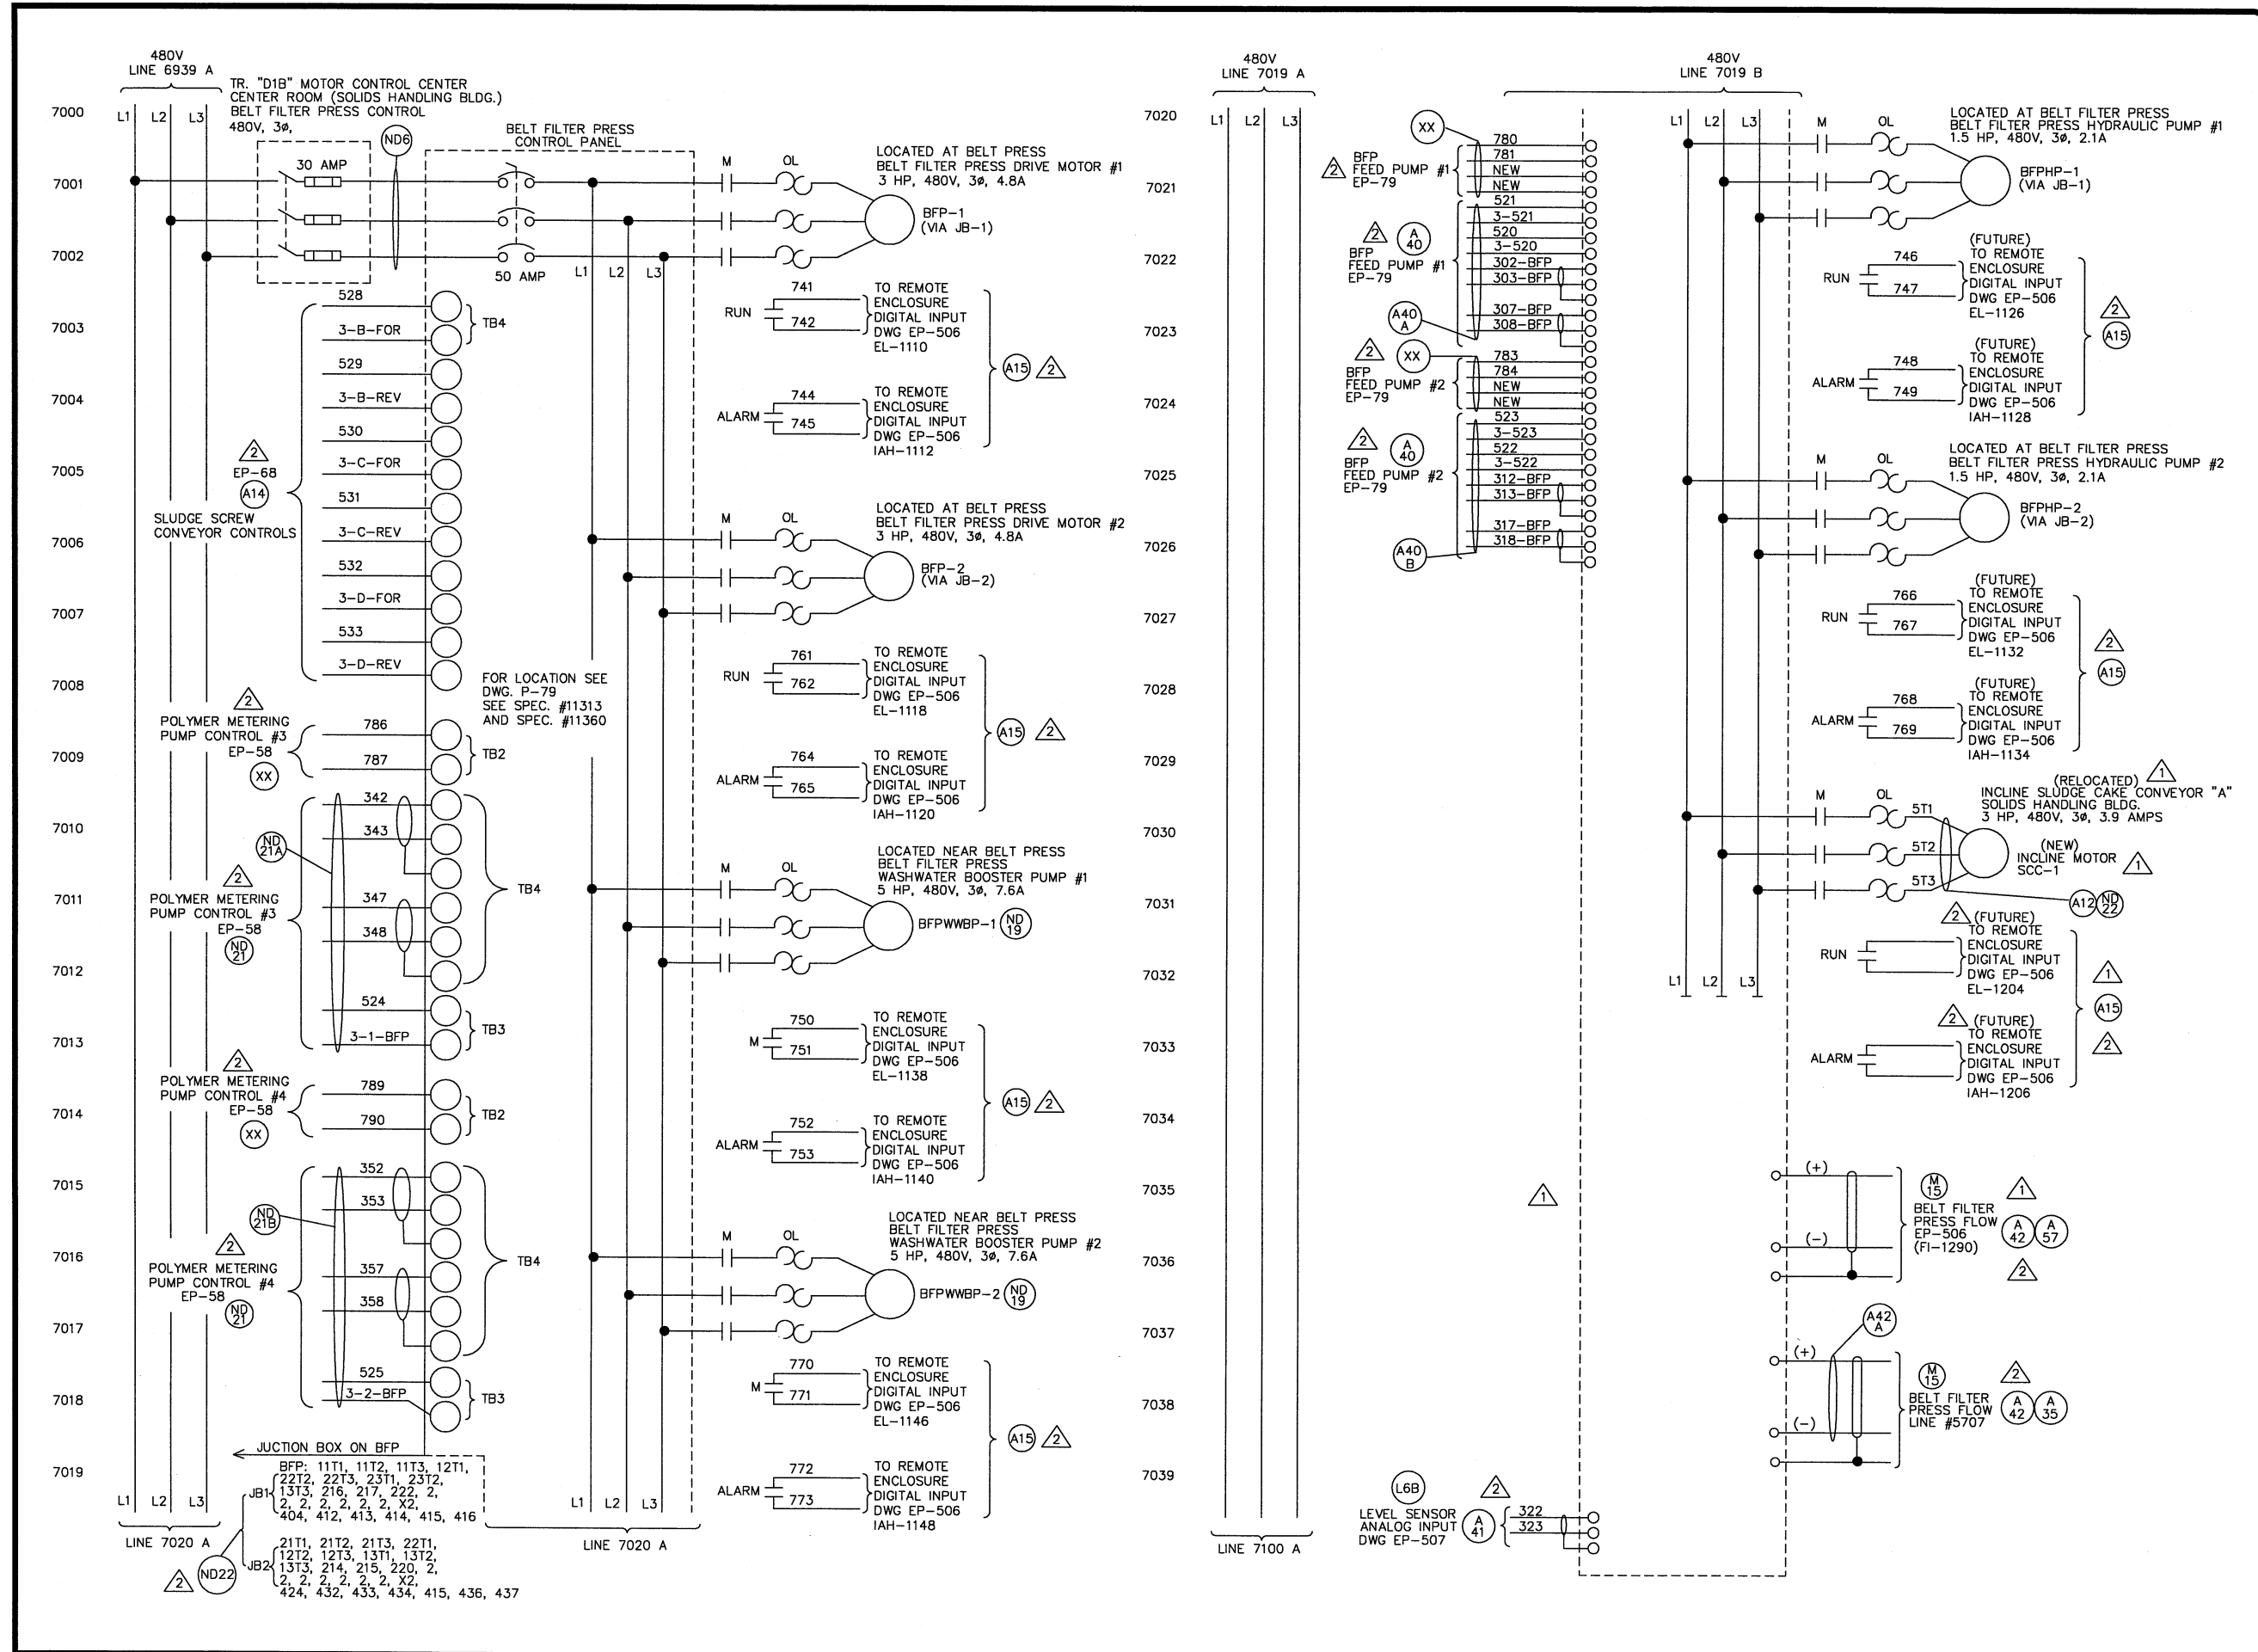

SEI TECHNOLOGIES, INC.
MASSILLON, OHIO
35674 RUL

REVISIONS		DESIGNED BY	DATE	BY	APP'D
NO.	DESCRIPTIONS	STI/TSS	REVISED AS PER CONSTRUCTION	TSS	R/L
1	ADDED INTERCONNECTIONS	STI/TSS	7/27/01	TSS	R/L
2	ADDED INTERCONNECTIONS	STI/TSS			

ENVIRONMENTAL, INC.
ENGINEERS IN WATER AND EARTH SCIENCES
UNIONTOWN, OHIO

CITY OF MASSILLON, OHIO
WWTP UPGRADE 2000
TRANSFORMER "D1", MCC-D1B
BELT FILTER PRESS CONTROL SCHEMATIC DIAGRAM

JOB NO.
E9031
DATE
3/1/01
SCALE
N/A
SHEET
EP70-2

9031SCHE70.DWG