



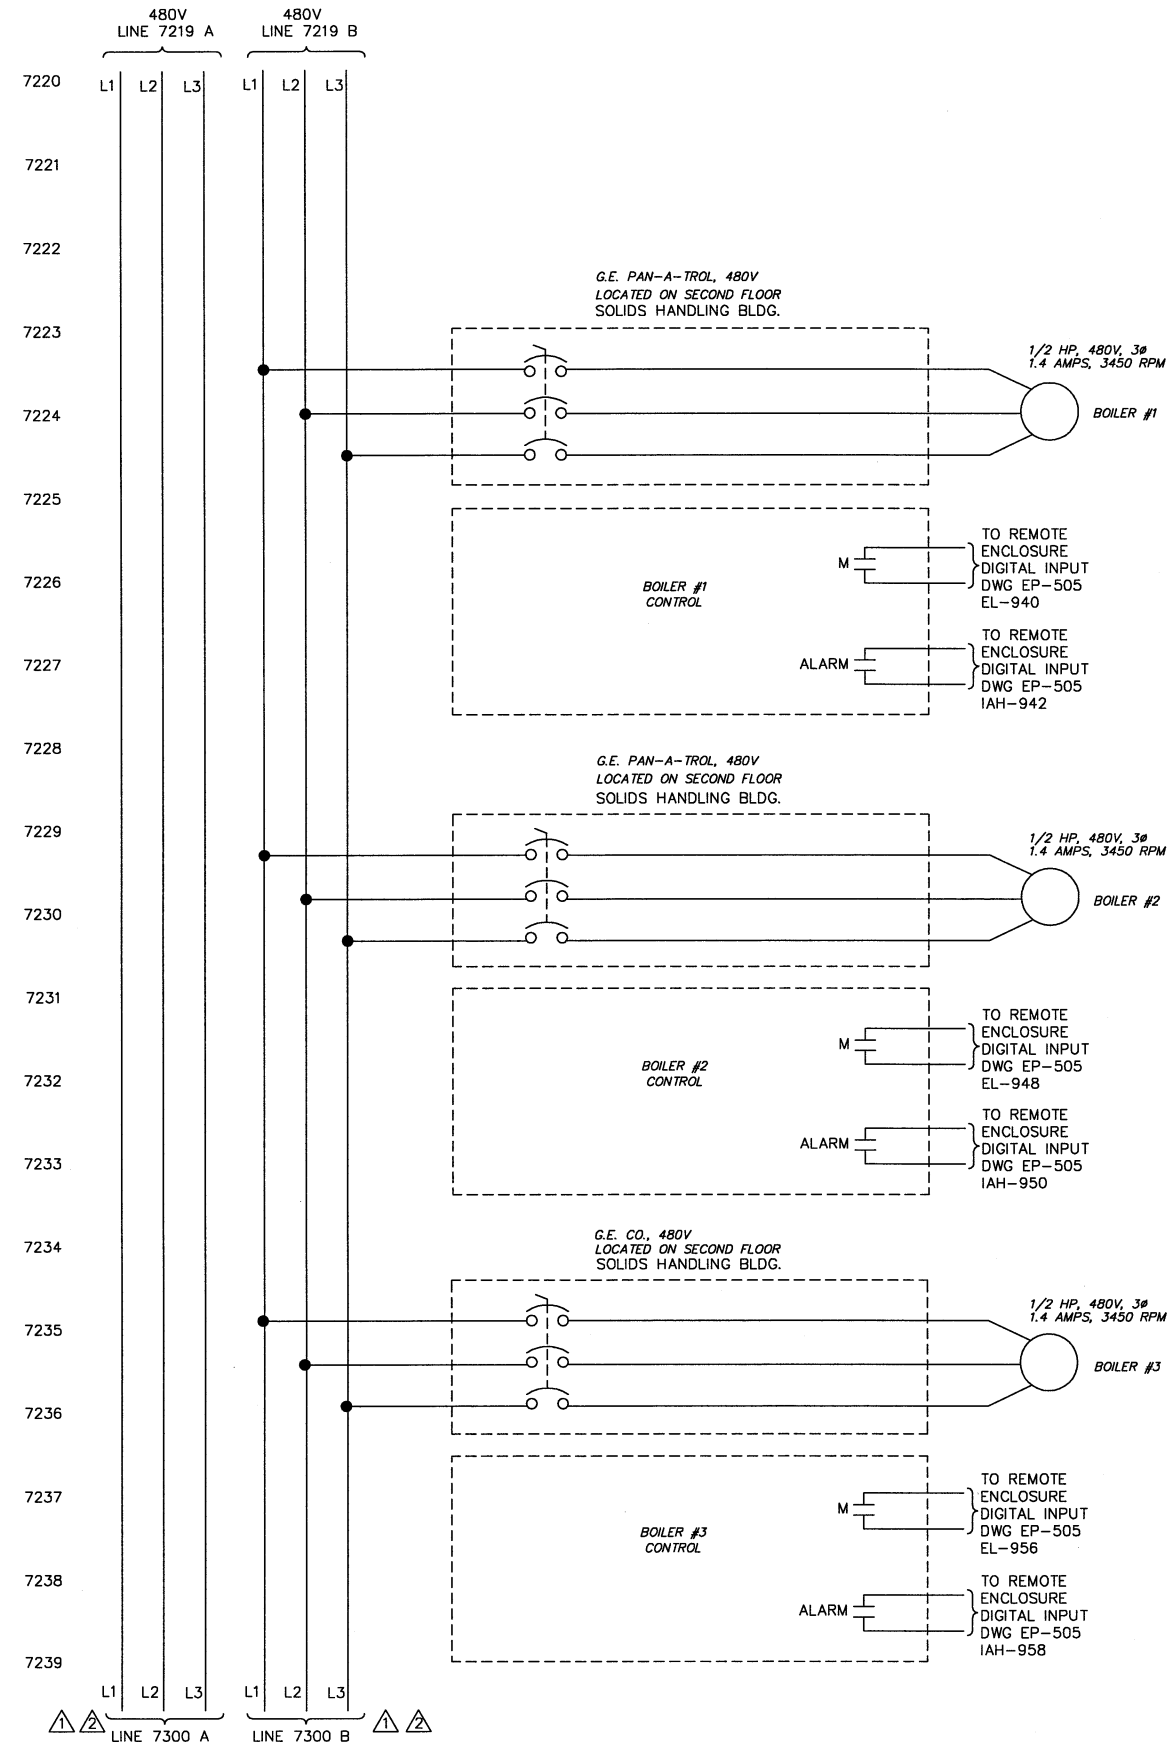

NOTE: ALL EQUIPMENT ON THIS DW'G. WAS
PREVIOUSLY CONNECTED TO MCC "D1A"

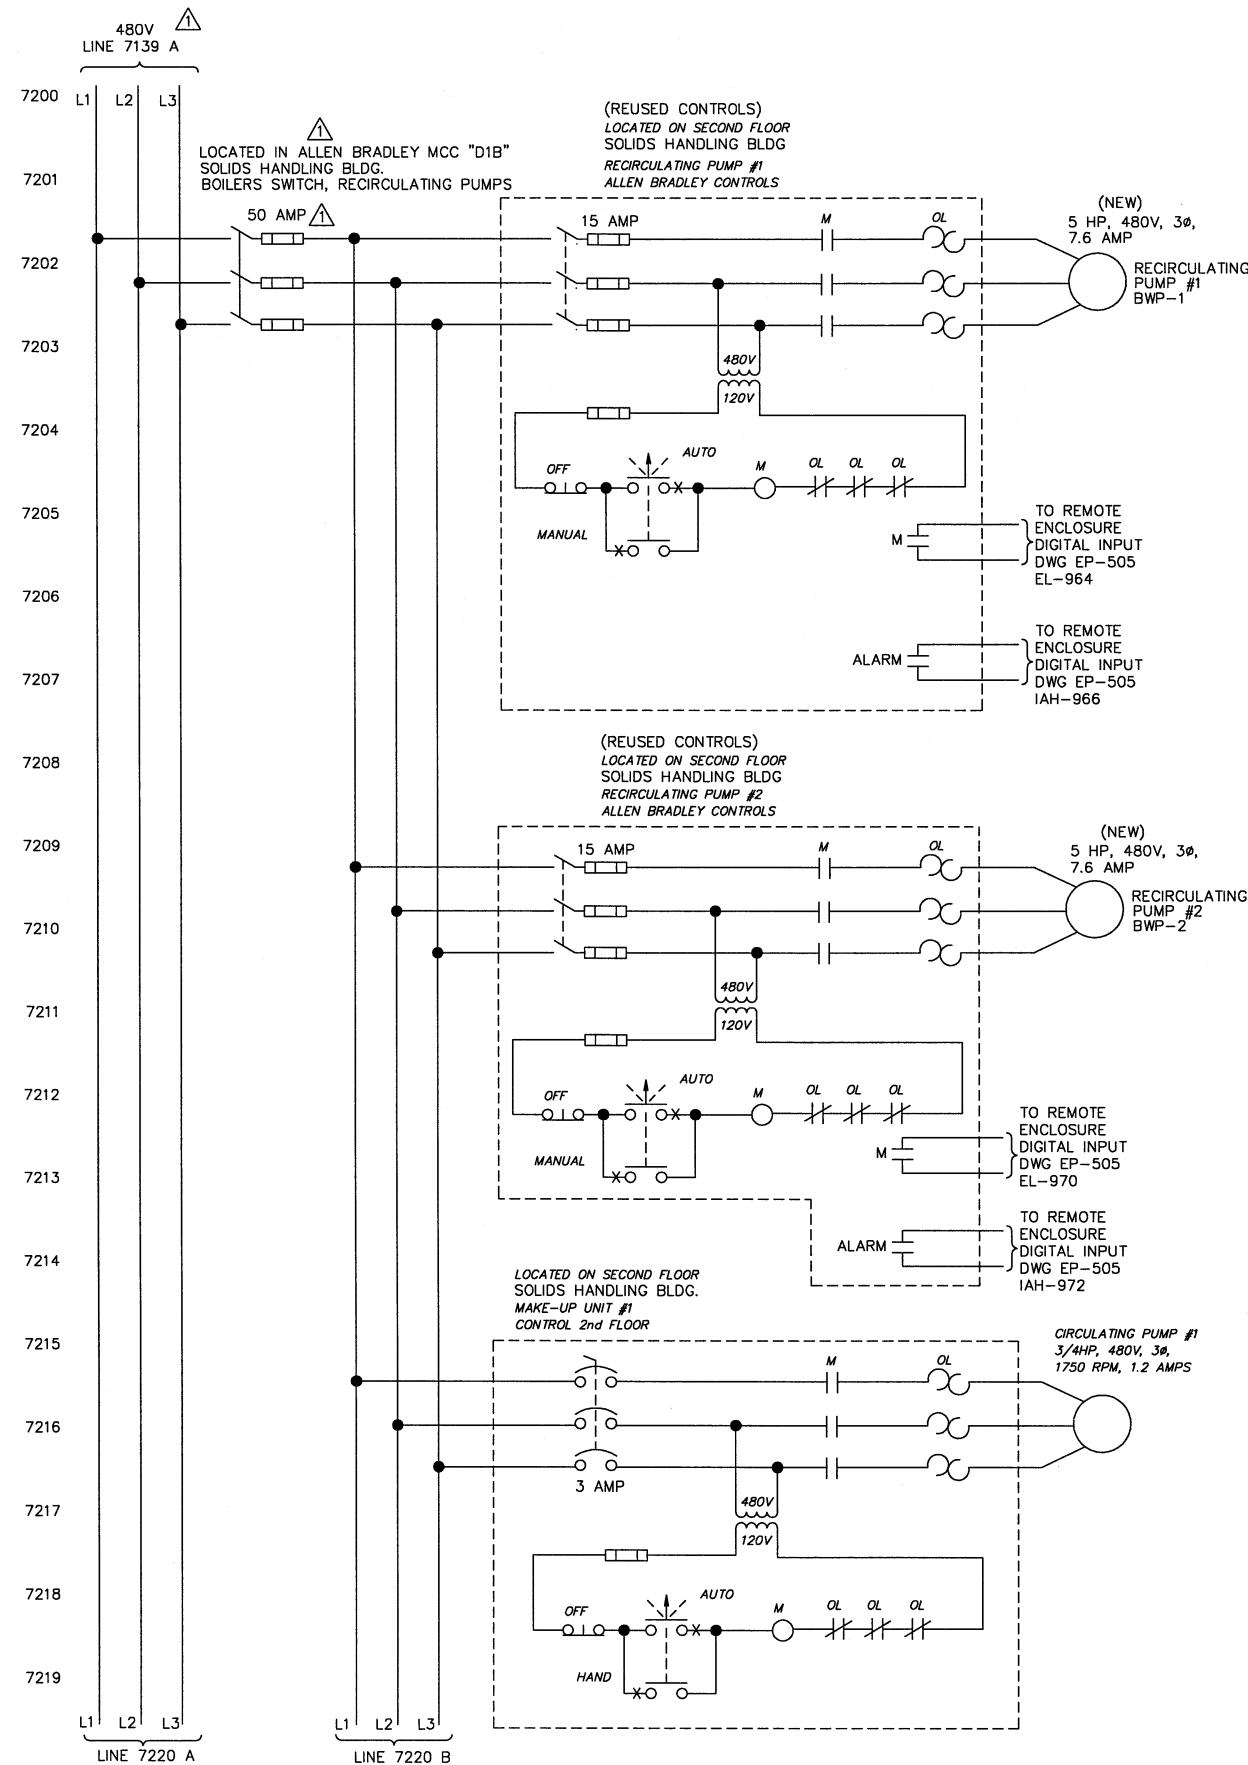

NO.	REVISIONS	DESCRIPTIONS	DATE	BY	APPROVED
1	REVISED AS PER CONSTRUCTION	8/13/02	TSS	RLL	
2	ADDED 480V BUS TO DWG. EP-737/02/03	TSS	RLL		

DESIGNED BY
STI/TSS

DRAWN BY
STI/TSS

CHECKED BY
STI/TSS

APPROVED BY
STI/RLL



CITY OF MASSILLON, OHIO
WWTP UPGRADE 2000
TRANSFORMER "D1", MCC-D1B
RECIRCULATING PUMPS, CIRCULATING PUMP, & BOILERS

JOB NO. E9031
DATE 7/17/02
SCALE N/A
SHEET EP72-2