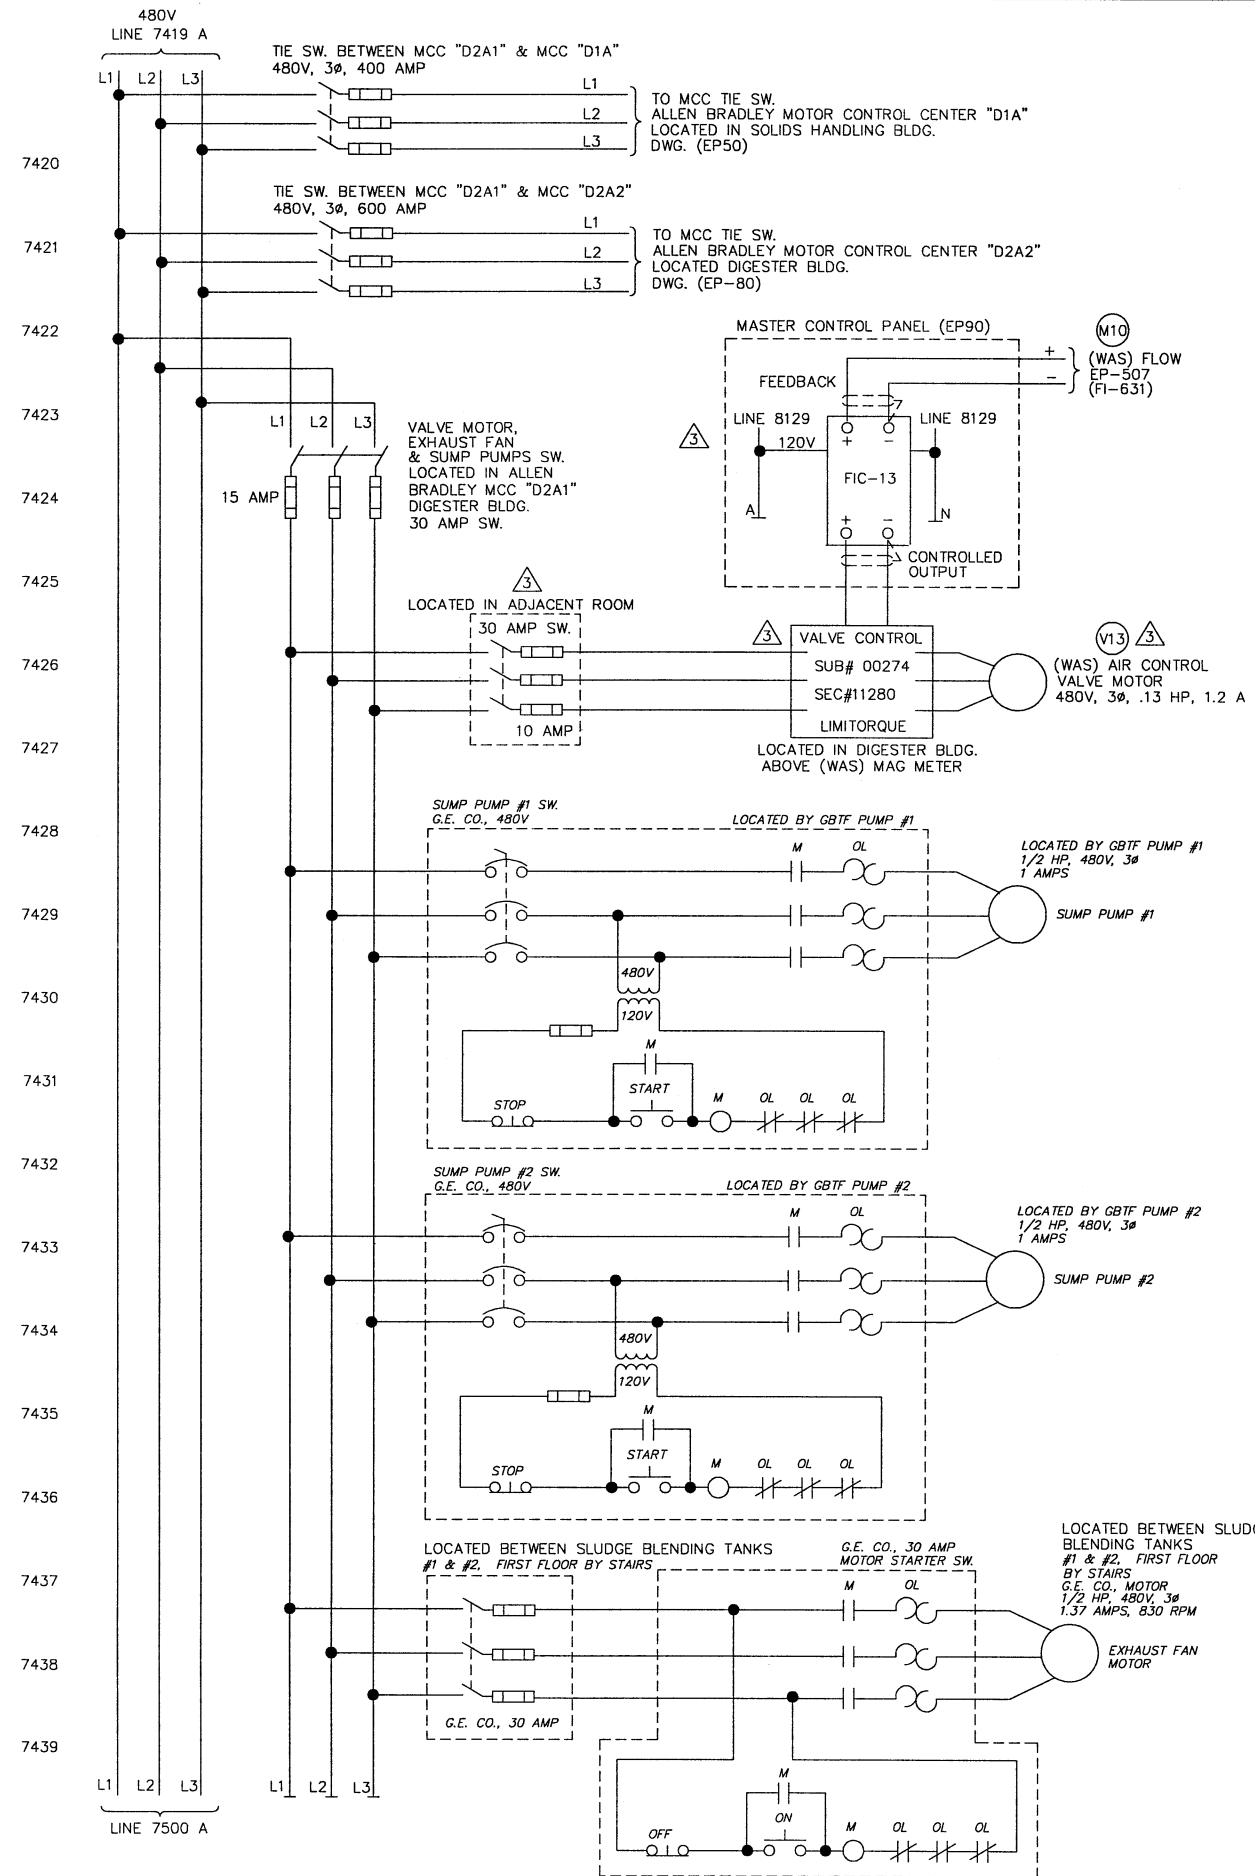
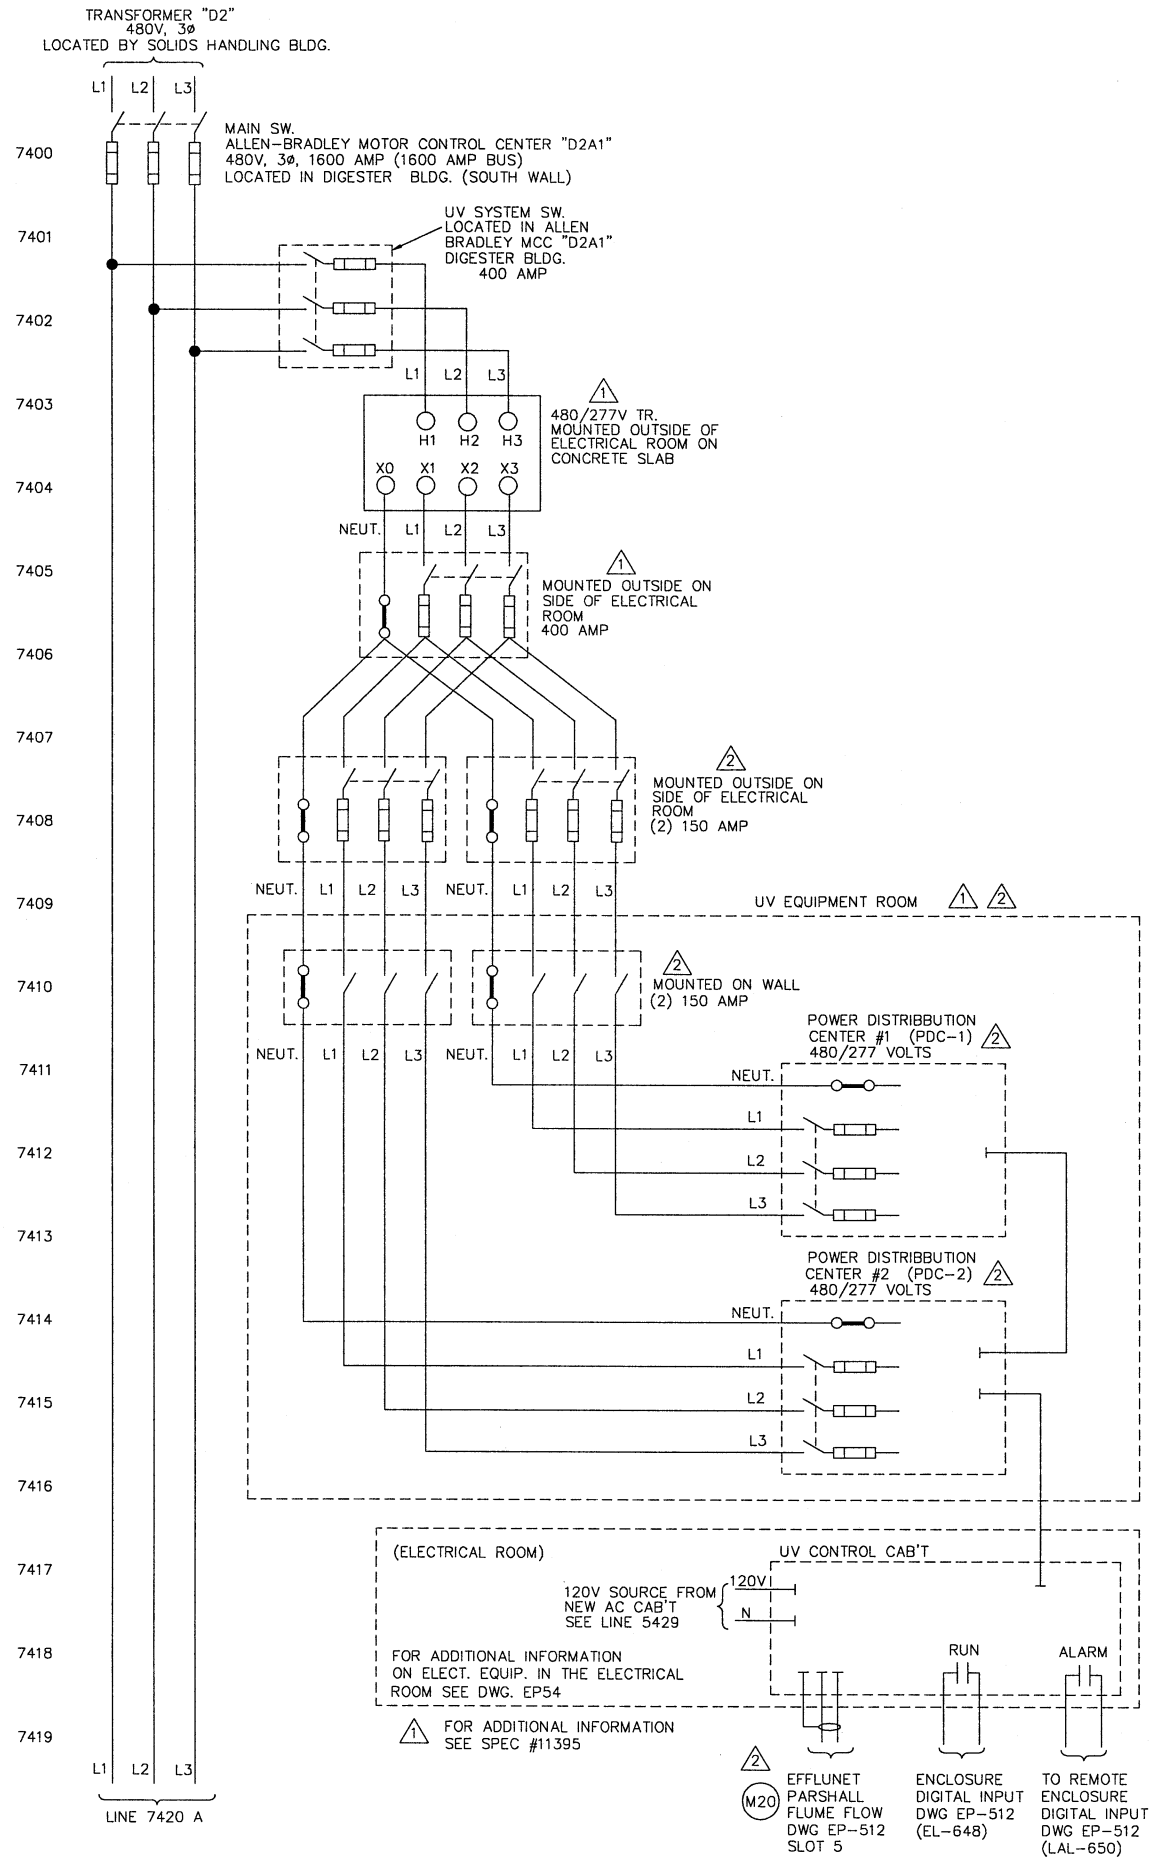


NO.	REVISIONS	DATE	BY	APP'D
1	DESIGNED	10/24/04	TSS	R.L.
2	REVISED AS PER CONSTRUCTION	4/03/04	TSS	R.L.
3	REVISED TERTIARY/UV WIRING	7/18/04	TSS	R.L.
4	ADDED AIR CONTROL VALVE "V13"			

DESIGNED BY STI/TSS
DRAWN BY STI/TSS
CHECKED BY STI/TSS
APPROVED BY STI/RJL

ENVIRONMENTAL, INC.
ENGINEERS IN WATER AND EARTH SCIENCES
UNIONTOWN, OHIO

CITY OF MASSILLON, OHIO
WWTP UPGRADE 2000
TRANSFORMER "D2", MCC-D2A1
EXHAUST FAN, SUMP PUMPS & UV SYSTEM SCHEMATIC

JOB NO. E9031
DATE 7/18/01
SCALE N/A
SHEET EP74-3