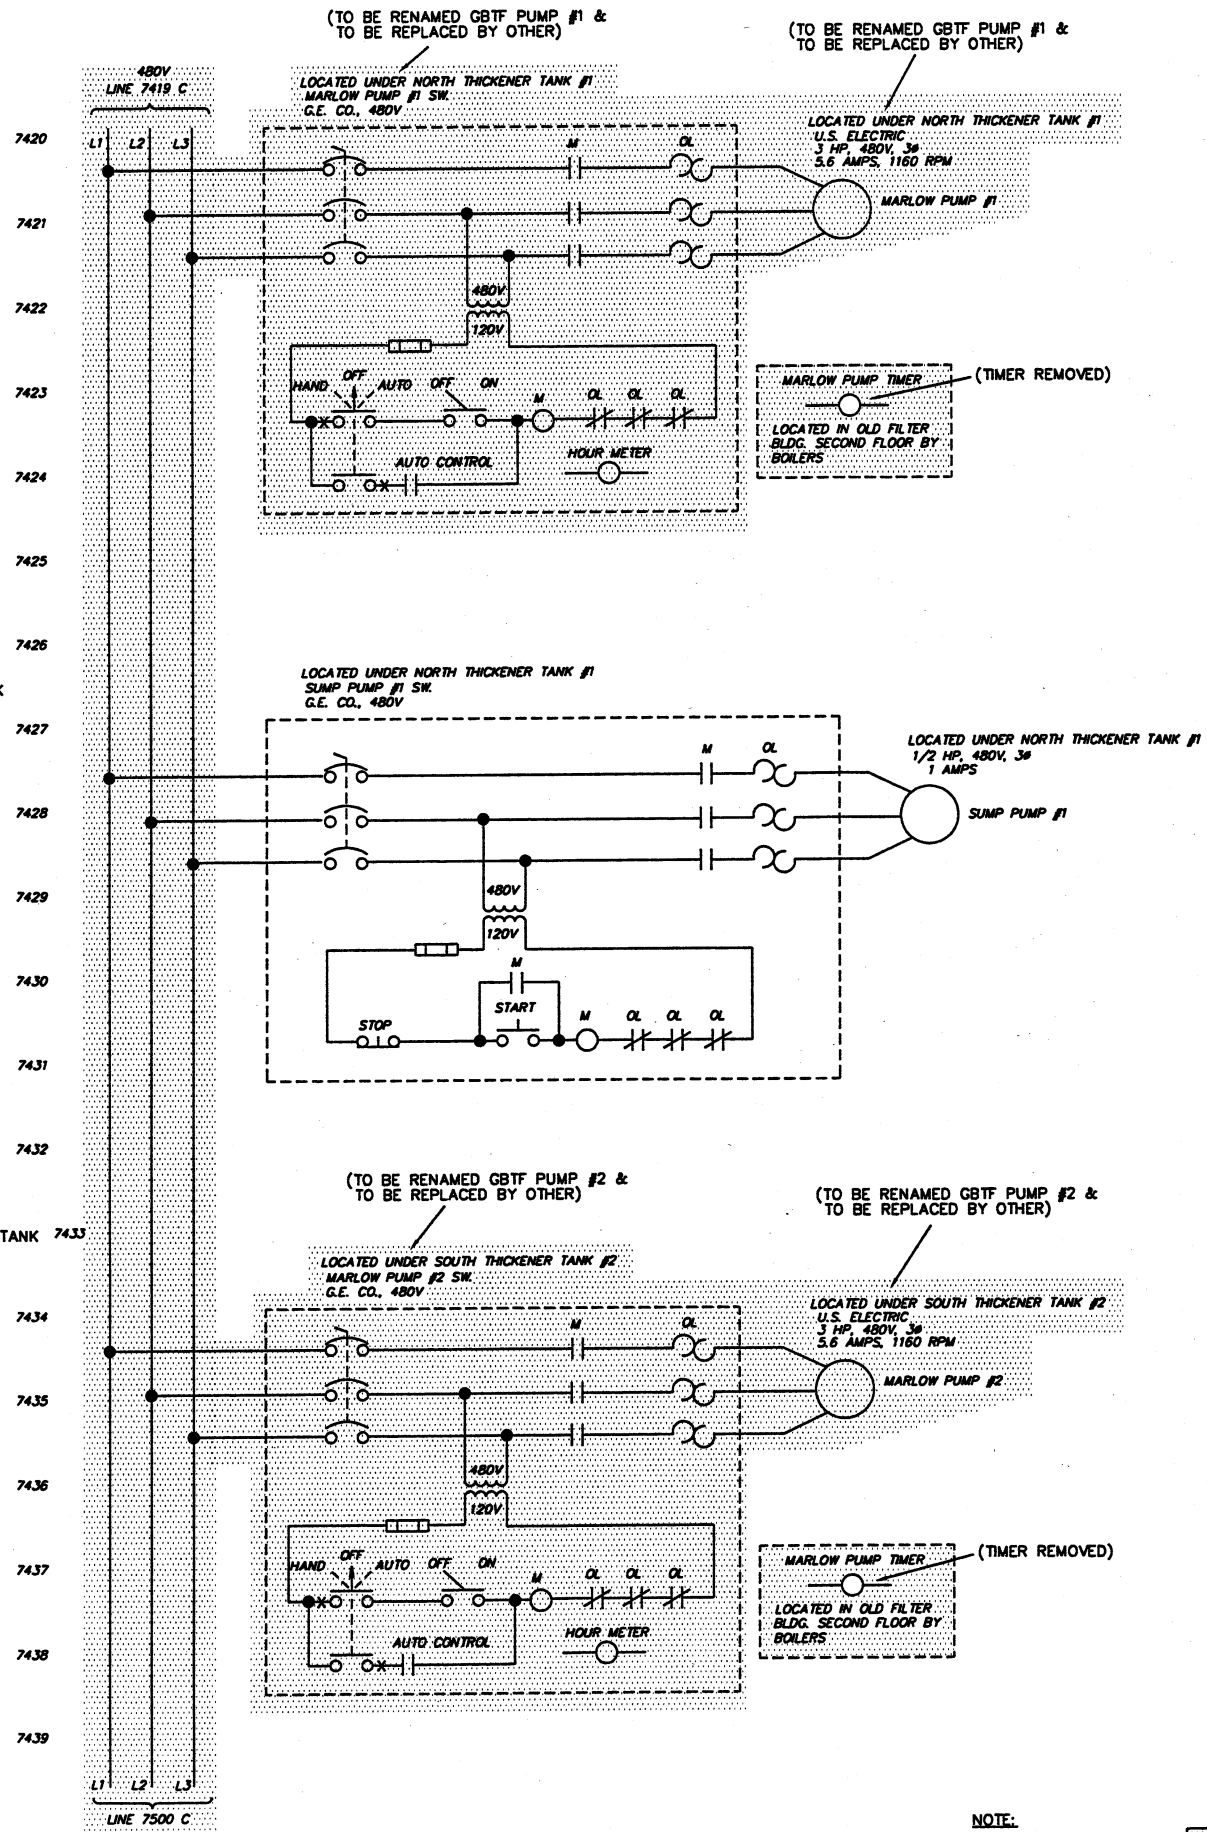
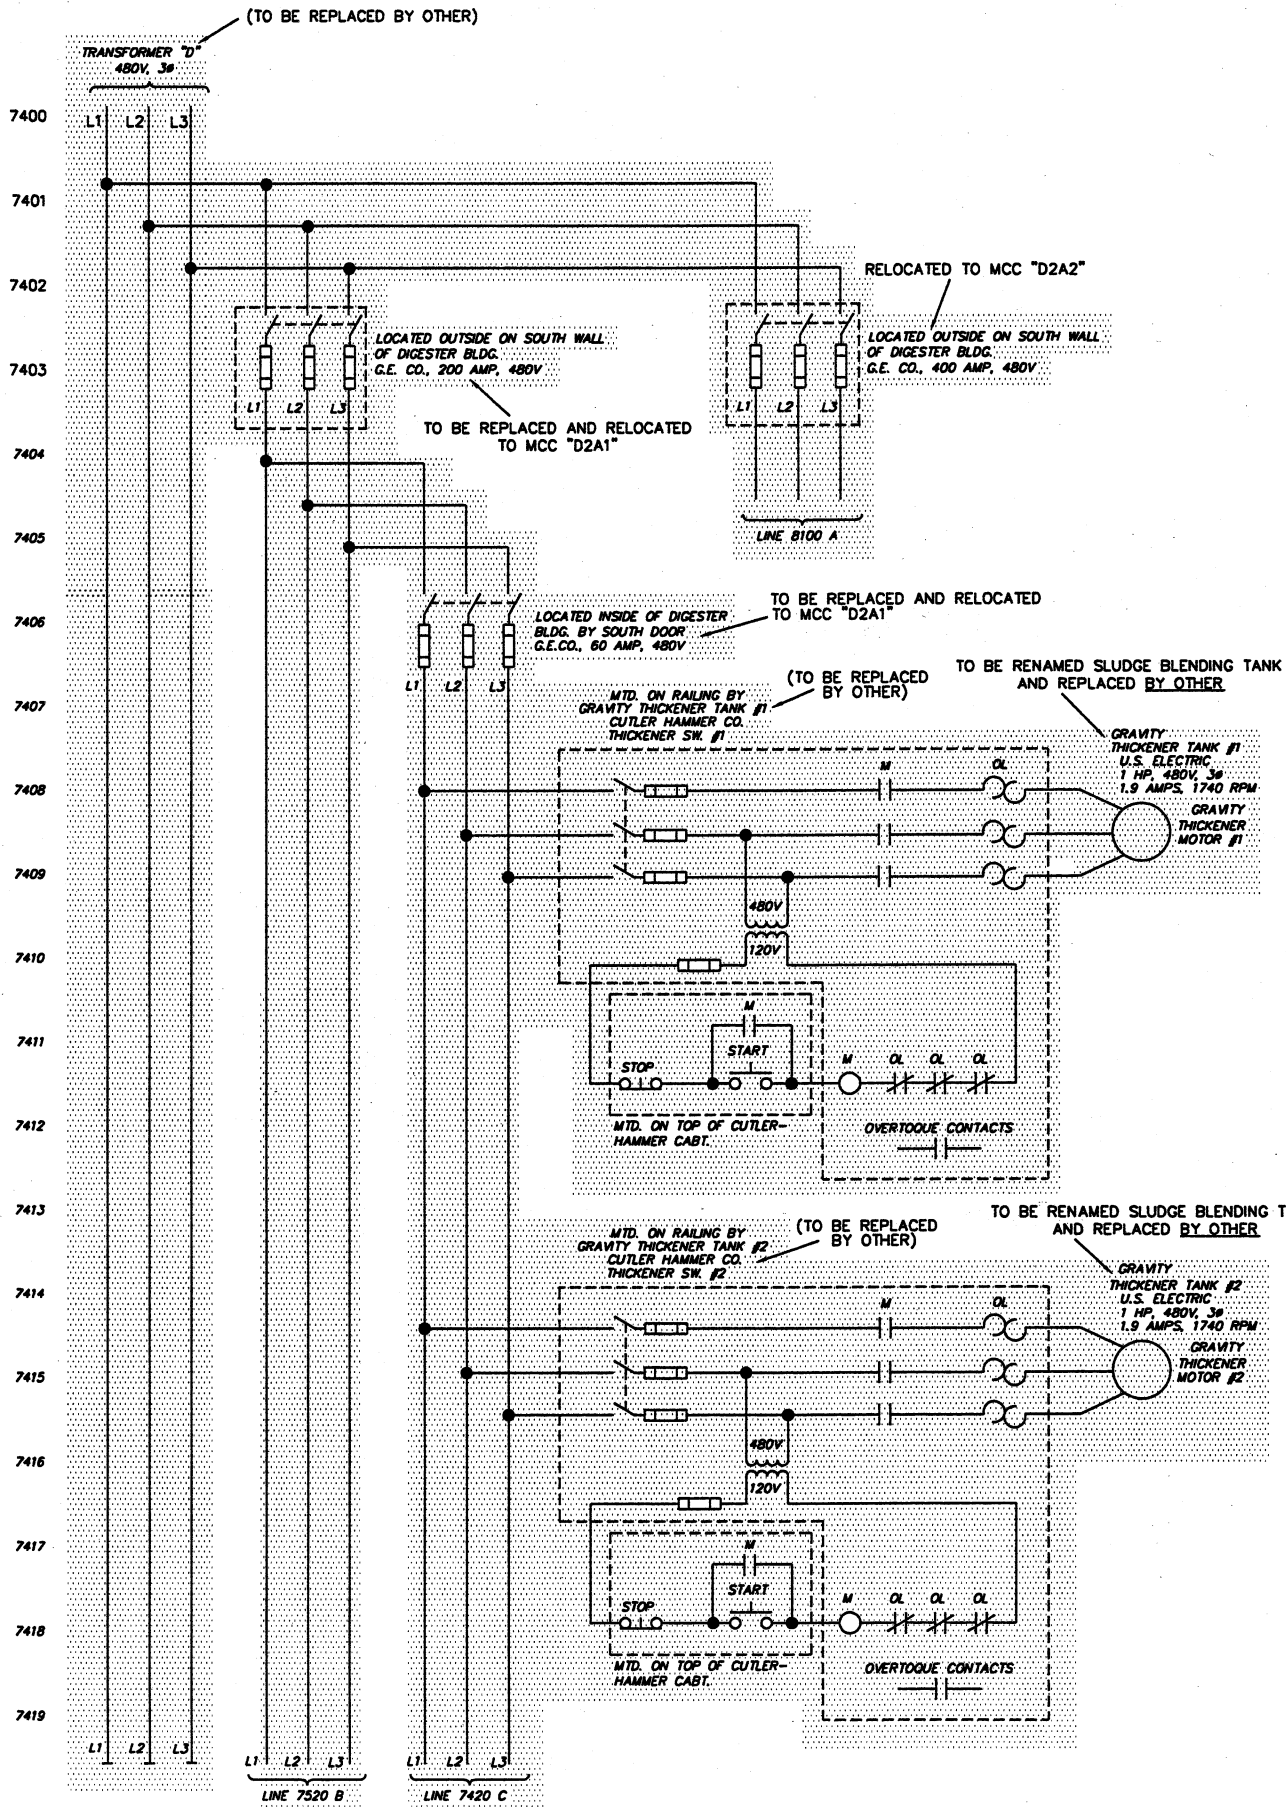


DESIGNED BY	STI/TSS	DRAWN BY	STI/TSS	CHECKED BY	STI/TSS	APPROVED BY	STI/R/L
NO.		NO.		NO.		NO.	
REVISIONS	NO.	DESCRIPTIONS	DATE	BY	APP'D		

ENVIRONMENTAL, INC.
ENGINEERS IN WATER AND EARTH SCIENCES
UNIONTOWN, OHIO

CITY OF MASSILLON, OHIO
WWTP UPGRADE 2000
TRANSFORMER "D"
WIRING SCHEMATIC DEMOLITION PLAN

JOB NO. E9031
DATE 7/5/01
SCALE N/A
SHEET EP74-D