
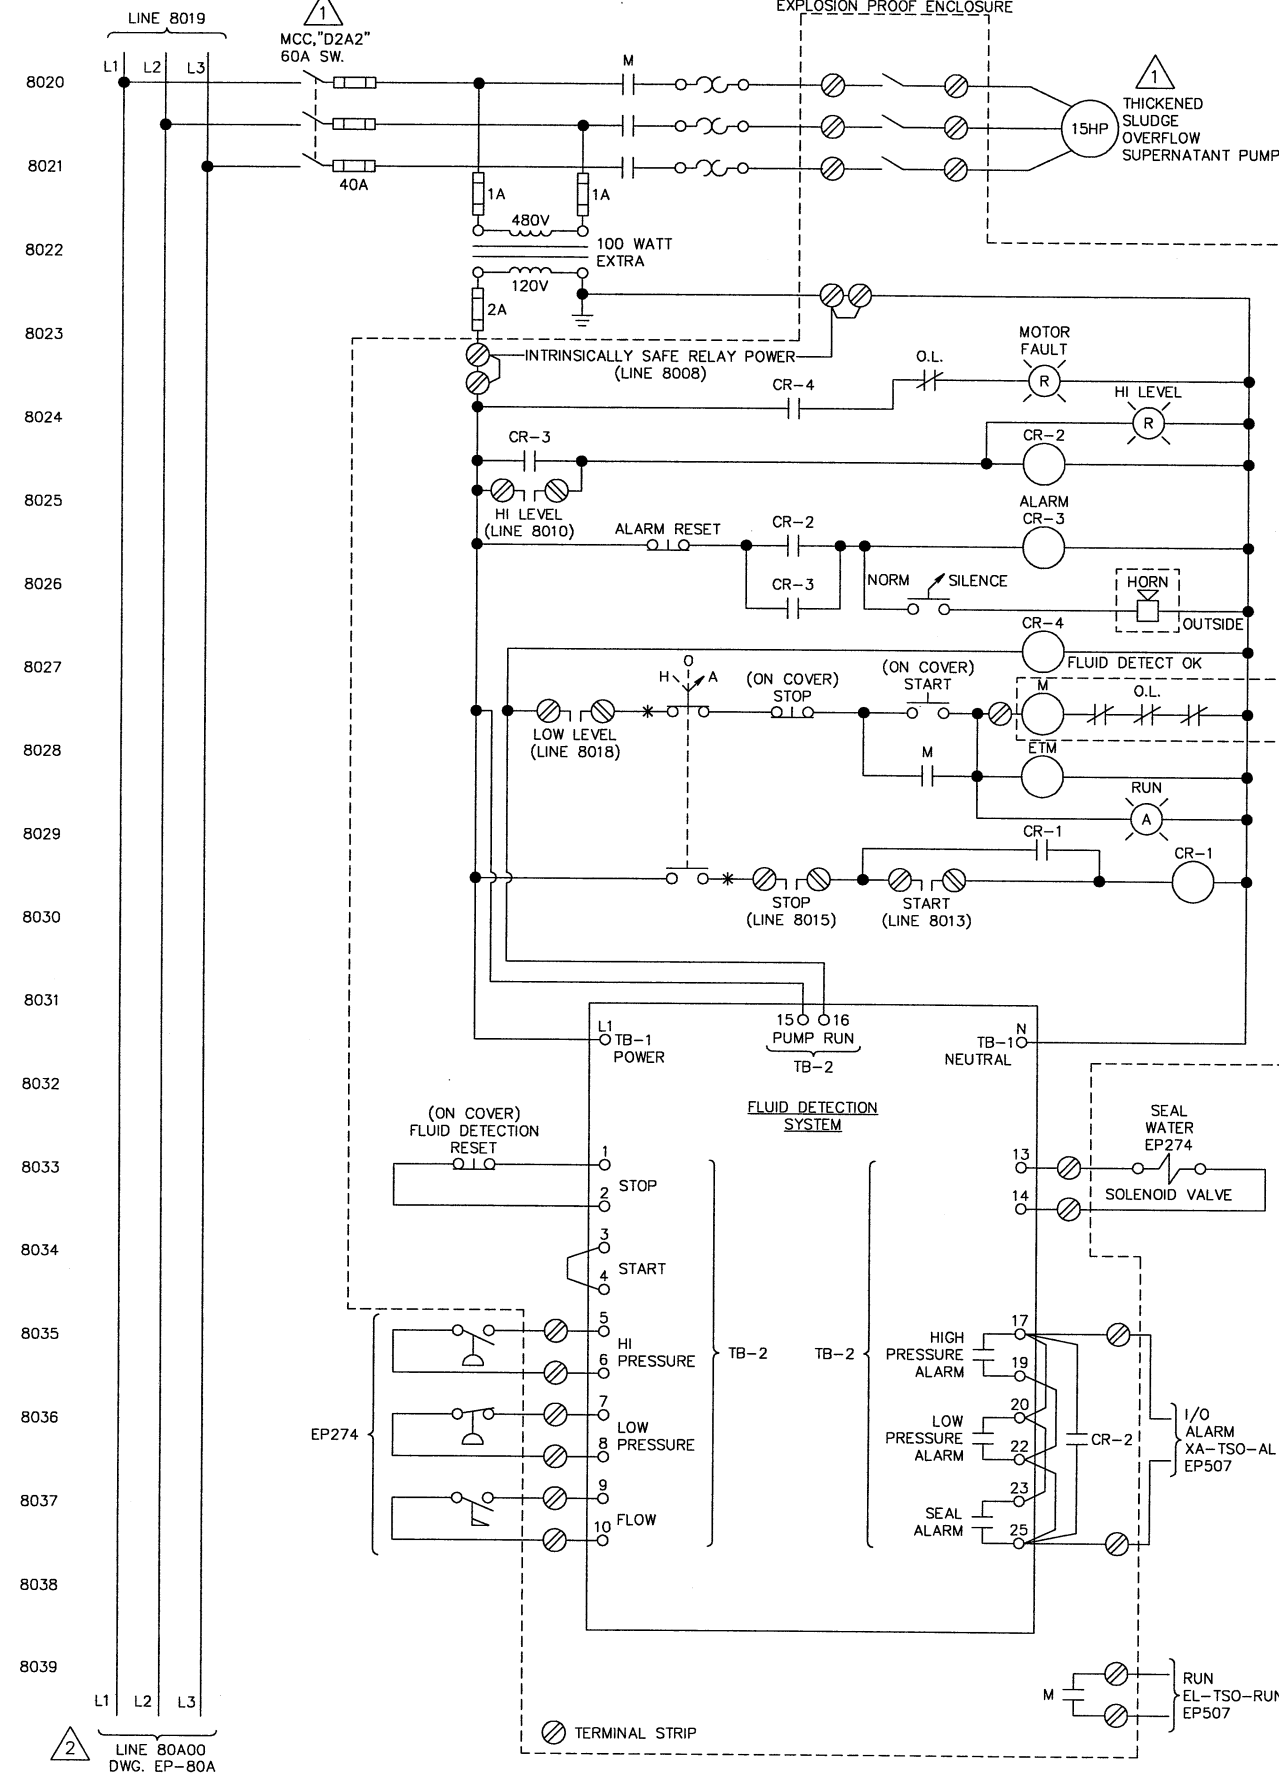


TRANSFORMER "D2"
480V, 3Ø
LOCATED BY SOLIDS HANDLING BLDG.

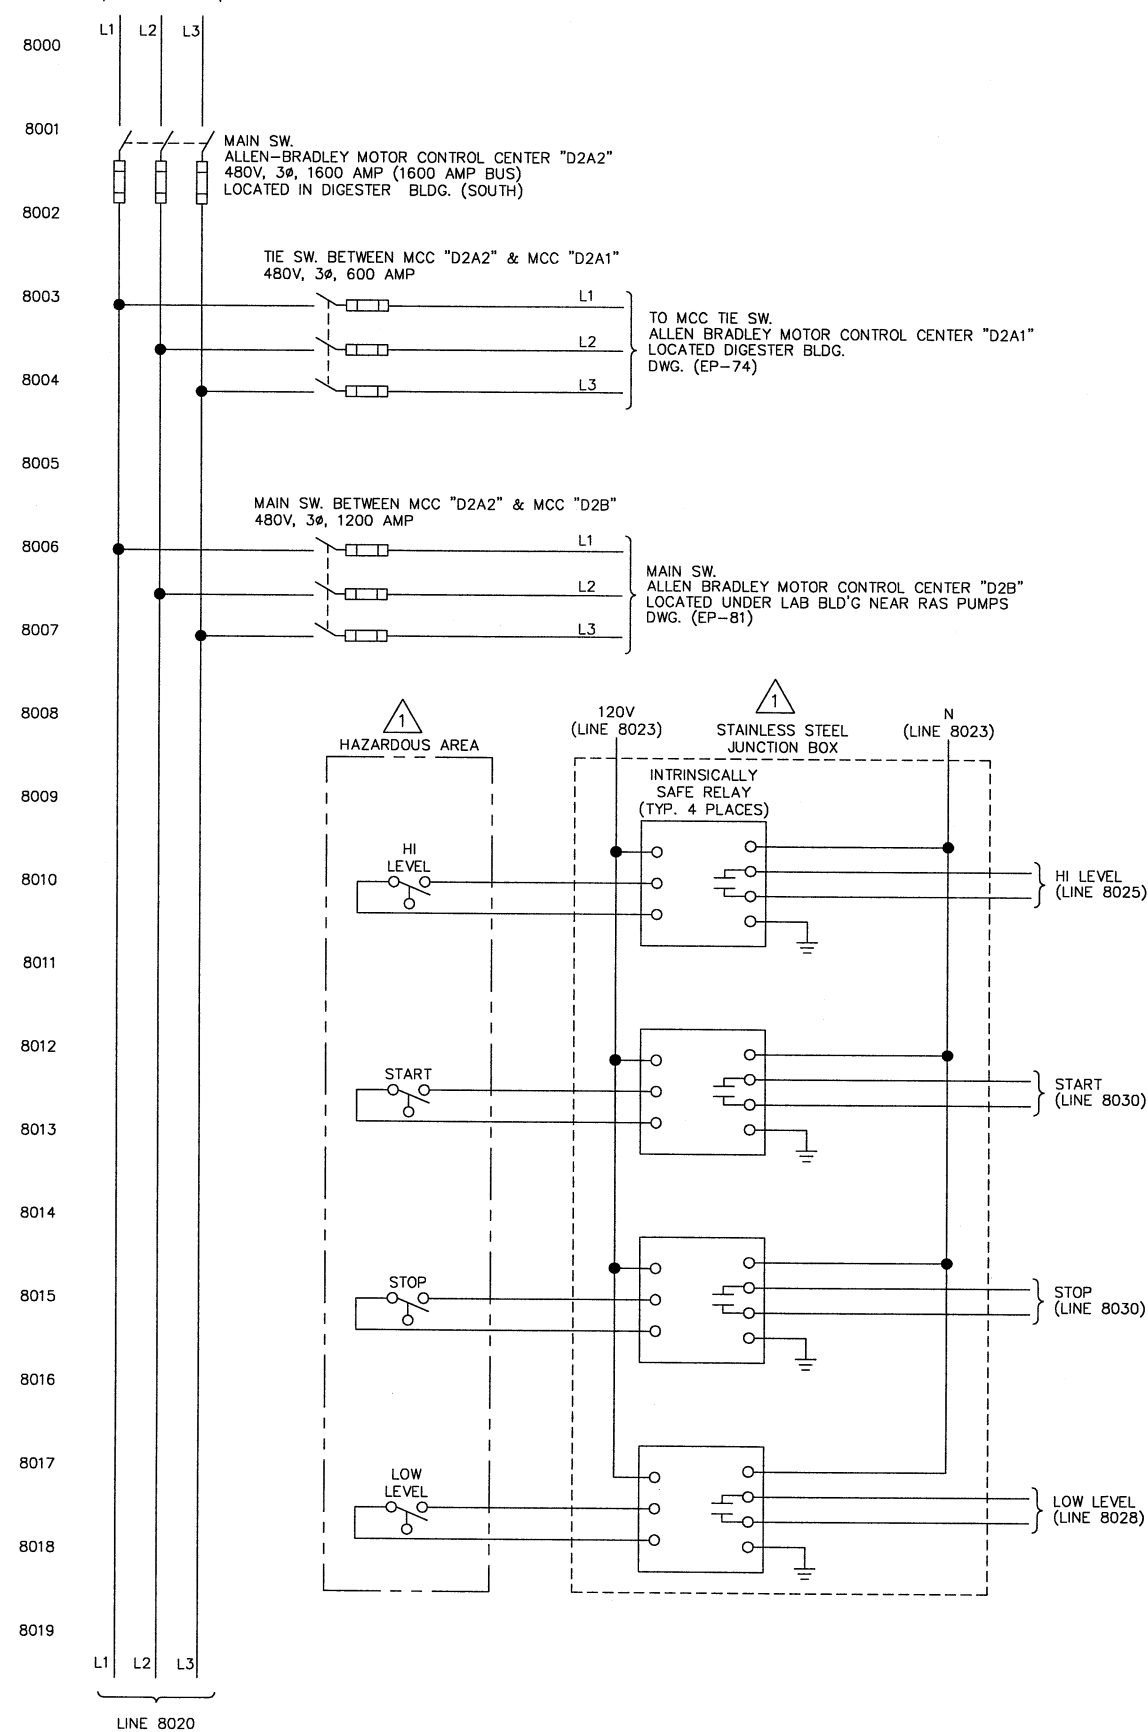

SEIERT TECHNOLOGIES, INC.
MASSILLON, OHIO
JUL 1994

REVISIONS		DATE	BY	APP'D
NO.	DESCRIPTION	DATE	BY	APP'D
1	REVISED FOR CONSTRUCTION	5/7/03	STI/TSS	CD
2	CONT. 480V BUS TO DWG. EP-80A	8/5/03	STI/TSS	R/L

DESIGNED BY
STI/TSS

DRAWN BY
STI/TSS

CHECKED BY
STI/TSS

APPROVED BY
STI/R/L

ENVIRONMENTAL, INC.
ENGINEERS IN WATER AND EARTH SCIENCES
UNIONTOWN, OHIO

CITY OF MASSILLON, OHIO
WWTP UPGRADE 2000

TRANSFORMER "D2", MCC-D2A2

SUPERNATANT PUMP SCHEMATIC

JOB NO.
E9031
DATE
7/18/01
SCALE
N/A
SHEET
EP80-2

9031SCHE80.DWG