
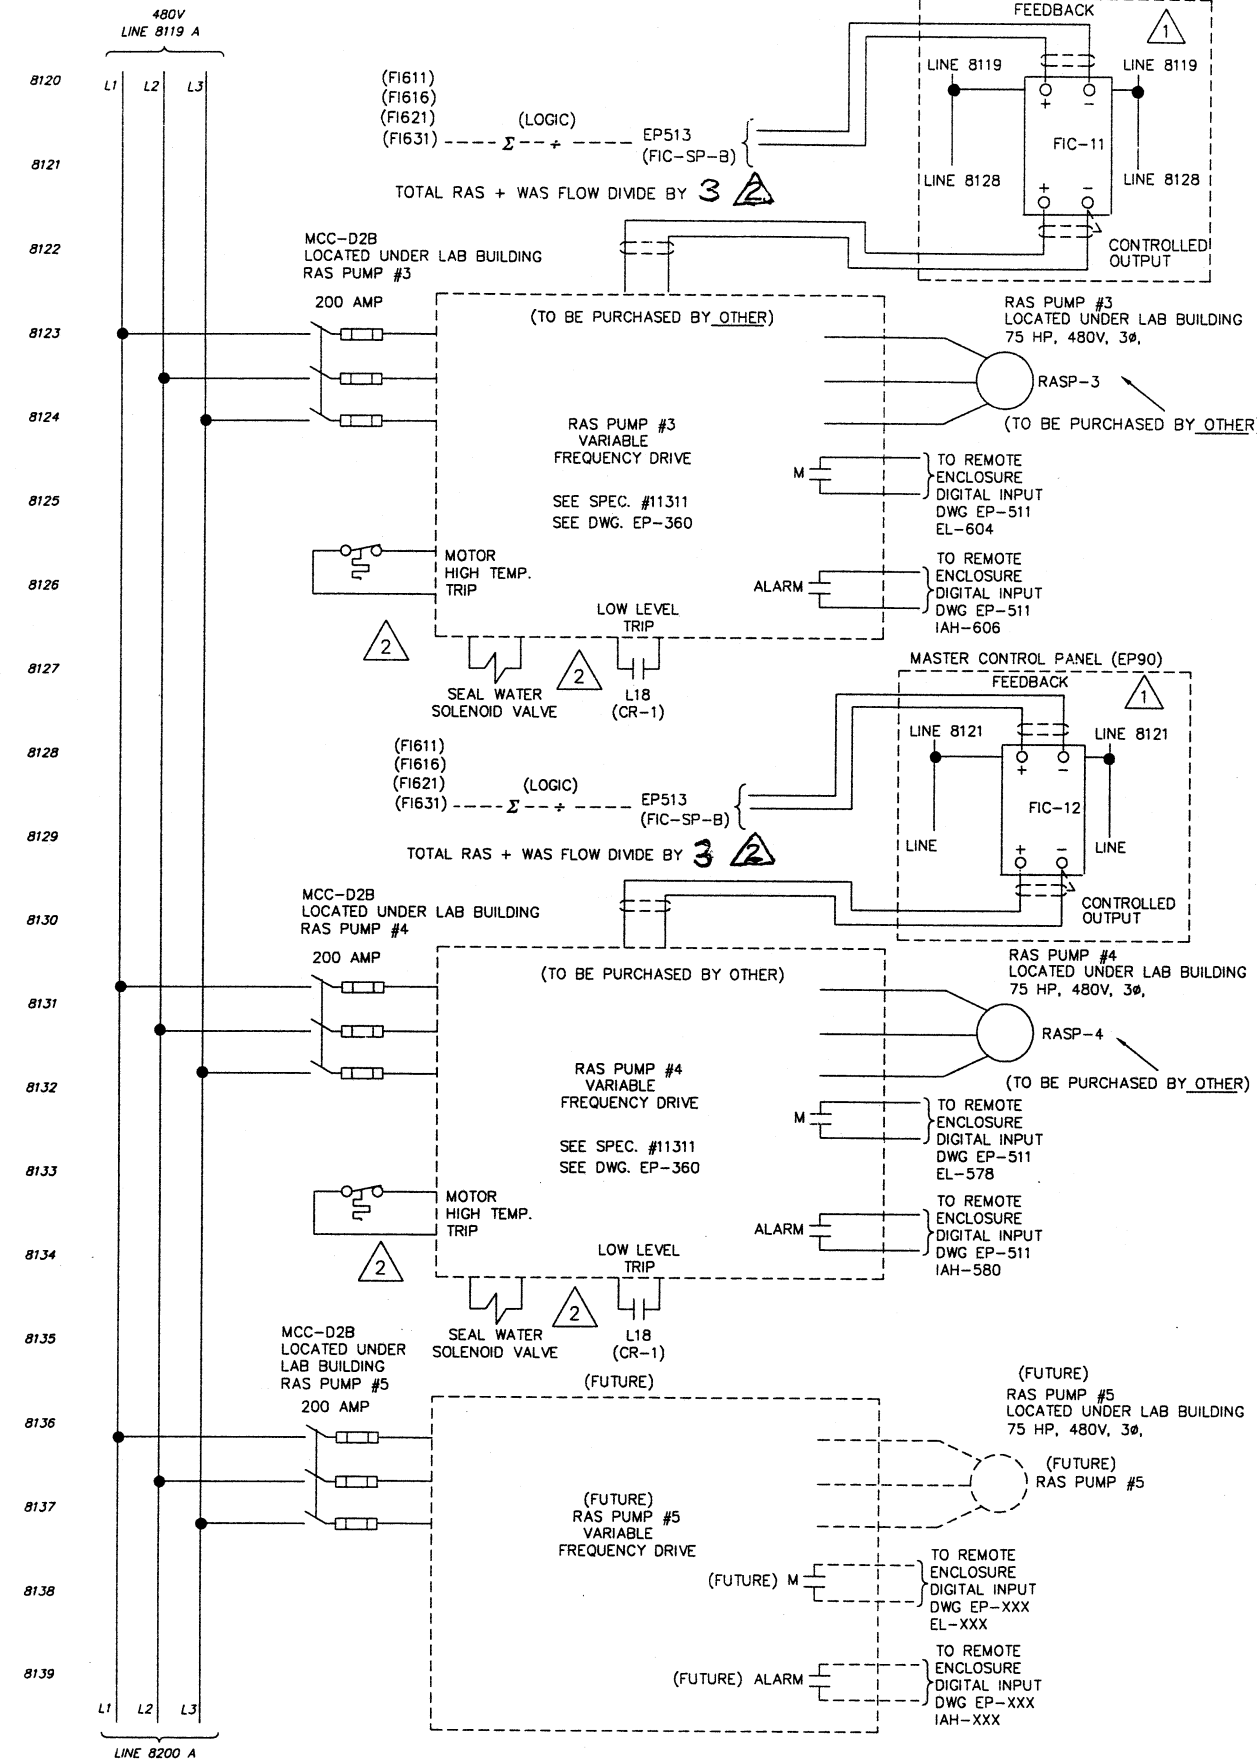


TR. "D2" MAIN SW.
ALLEN BRADLEY MOTOR CONTROL CENTER "D2A2"
LOCATED UNDER LAB BLD'G NEAR RAS PUMPS
LINE 8013
DWG. (EP-80)

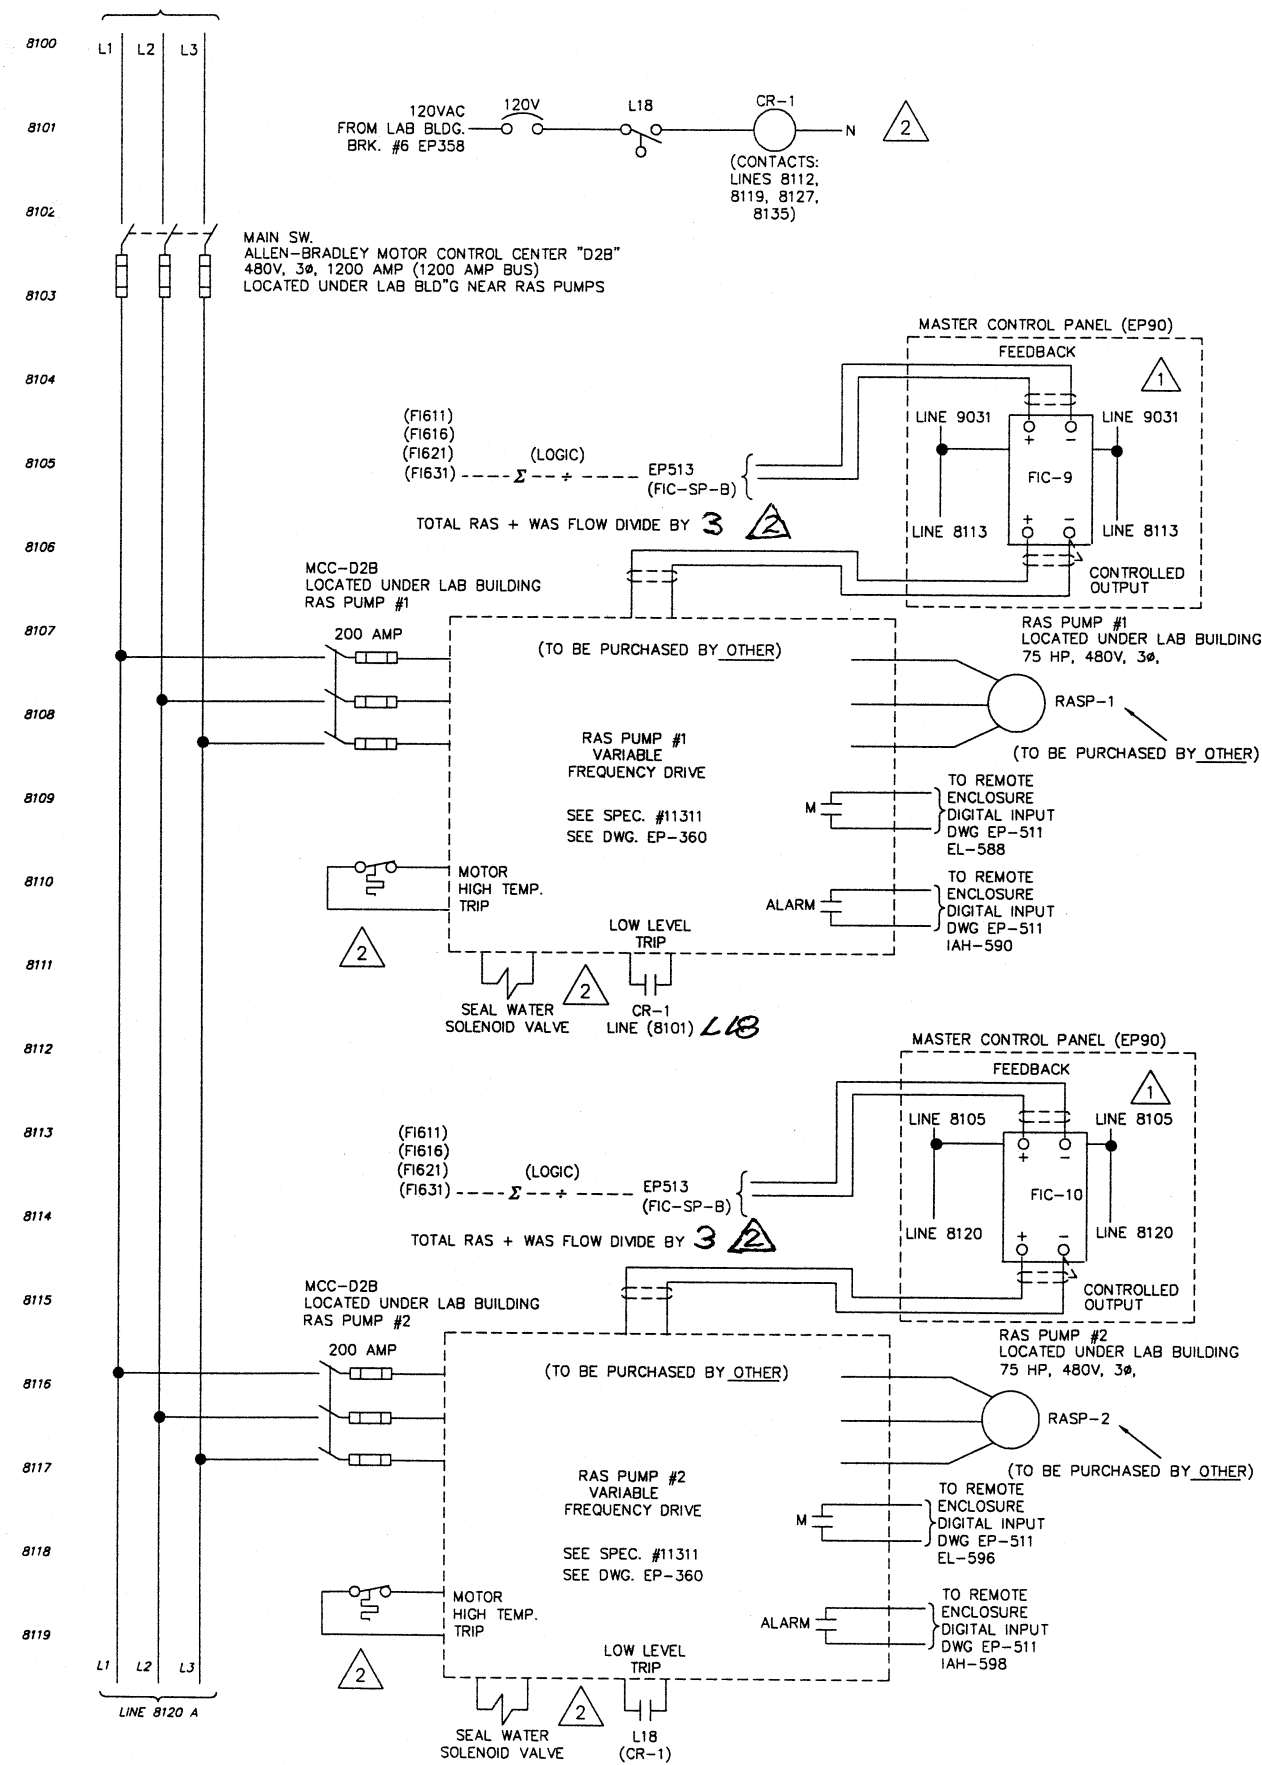

REVISIONS

NO.	DATE	BY	APPD	DESCRIPTION
1	9/17/01	STI/TSS	R.L.	ADDED MASTER CONTROL PANEL
2	9/6/03	STI/TSS	R.L.	ADDED MASTER CONTROL PANEL

DESIGNED BY: STI/TSS
DRAWN BY: STI/TSS
CHECKED BY: STI/TSS
APPROVED BY: STI/RJL

ENVIRONMENTAL, INC.
ENGINEERS IN WATER AND EARTH SCIENCES
UNIONTOWN, OHIO

CITY OF MASSILLON, OHIO
WWTP UPGRADE 2000
TRANSFORMER "D2", MCC-D2B
RAS PUMPS SCHEMATIC DIAGRAM

JOB NO.
E9031
DATE
7/19/01
SCALE
N/A
SHEET
EP81-2