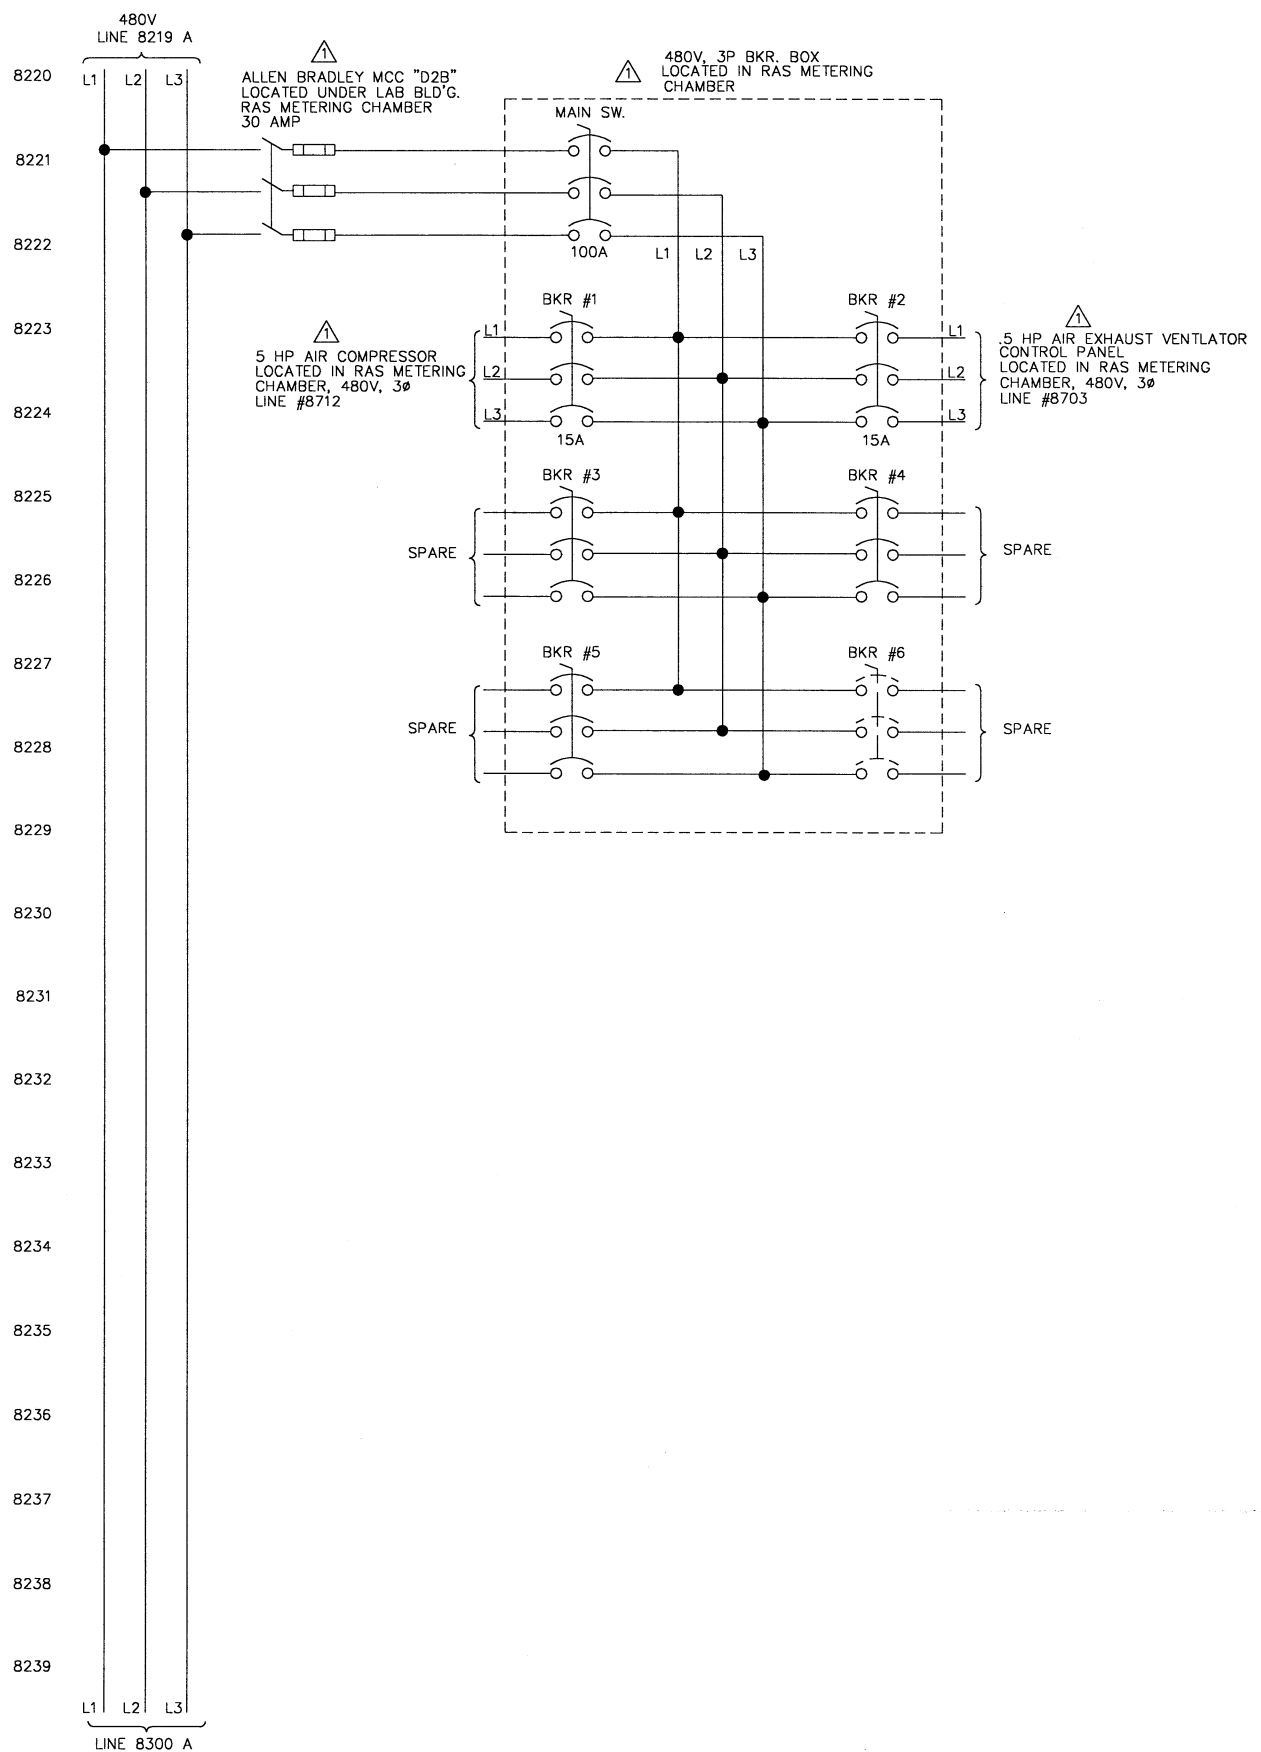
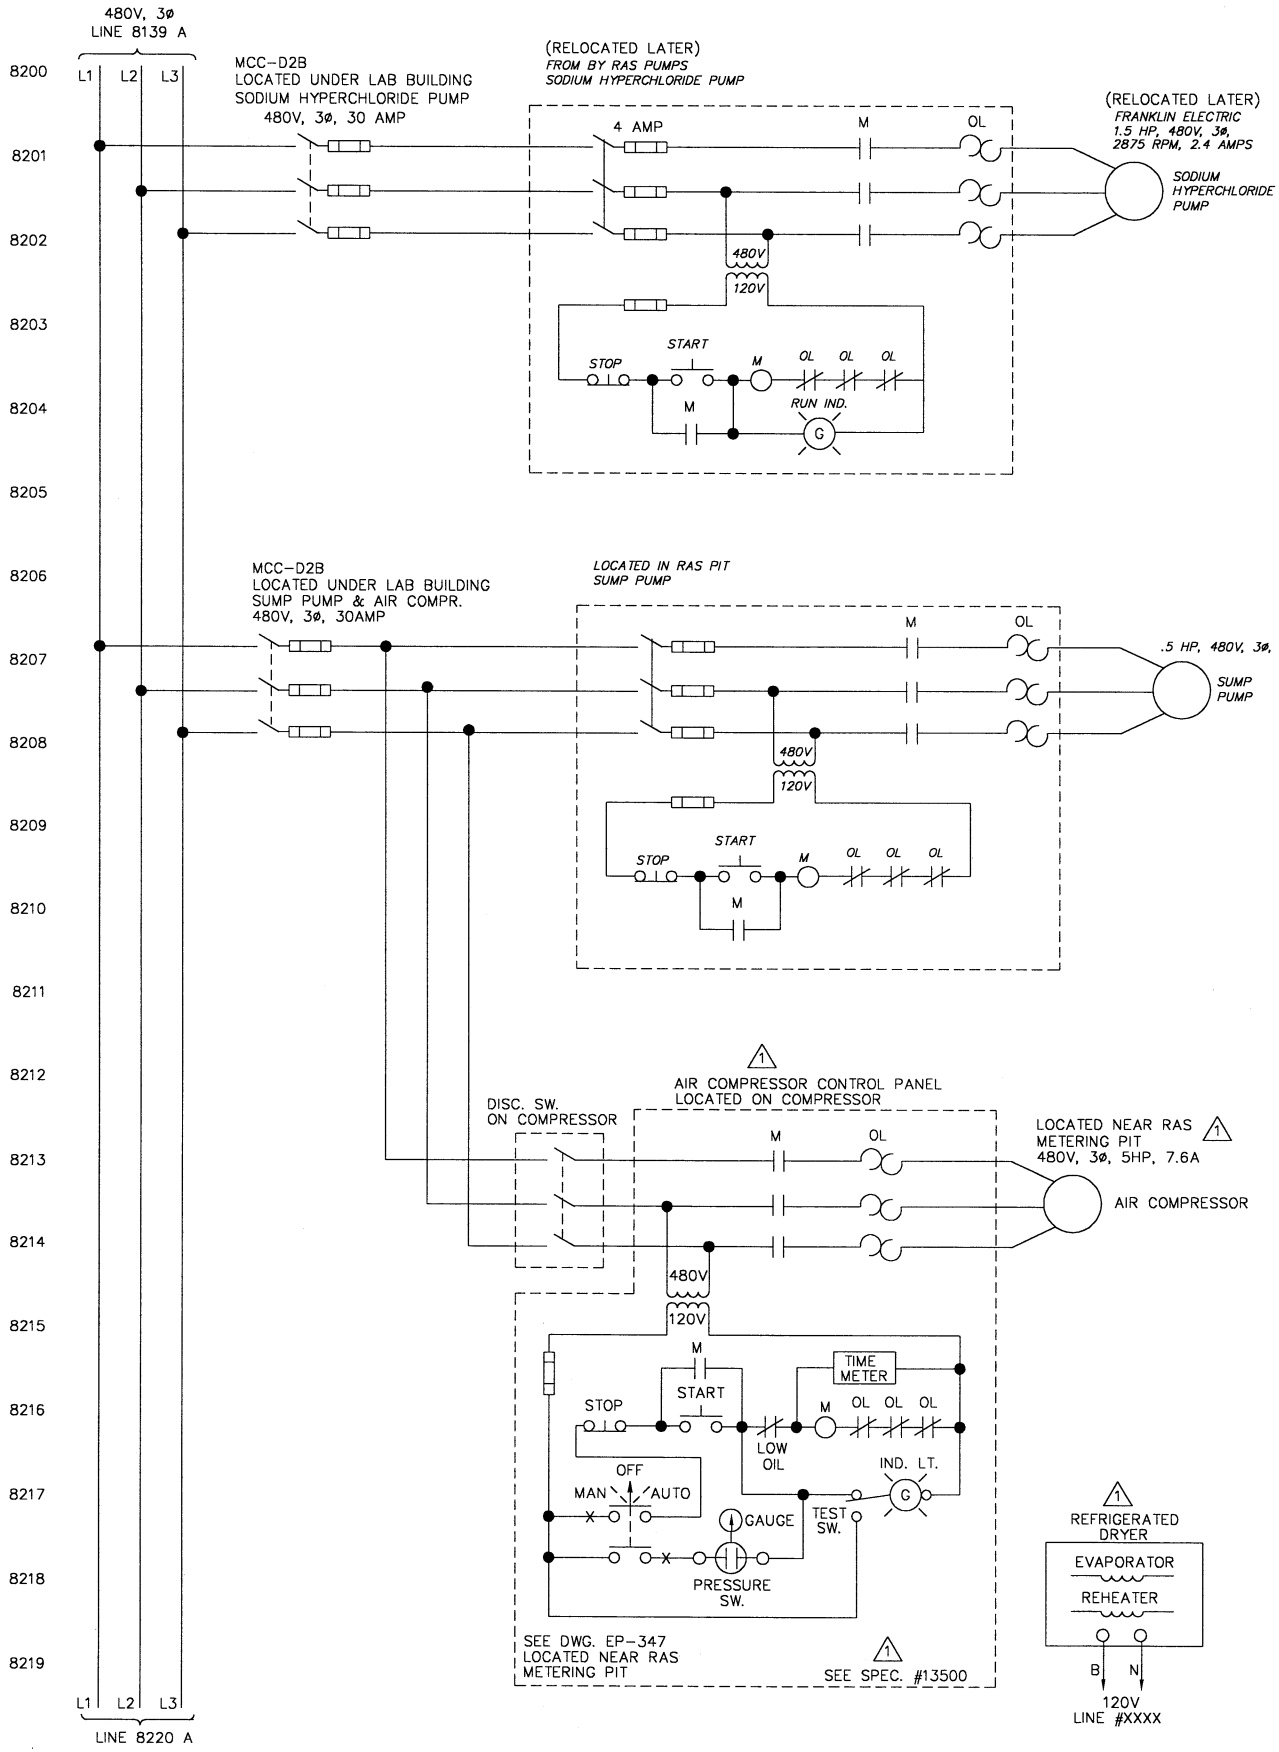


DESIGNED BY	NO.	REVISED AS PER CONSTRUCTION	REVISIONS		DATE	BY	APP'D
			DESCRIPTIONS	DATE			
STI/TSS	1			3/24/03	TSS	R/L	
DRAWN BY							
CHECKED BY							
APPROVED BY							

ENVIRONMENTAL, INC.
ENGINEERS IN WATER AND EARTH SCIENCES
UNIONTOWN, OHIO

CITY OF MASSILLON, OHIO
WWTP UPGRADE 2000
TRANSFORMER "D2", MCC-D2B
SUMP PUMPS & AIR COMPR. - SCHEMATIC DIAGRAM

JOB NO. E9031
DATE 7/18/01
SCALE N/A
SHEET EP82-1