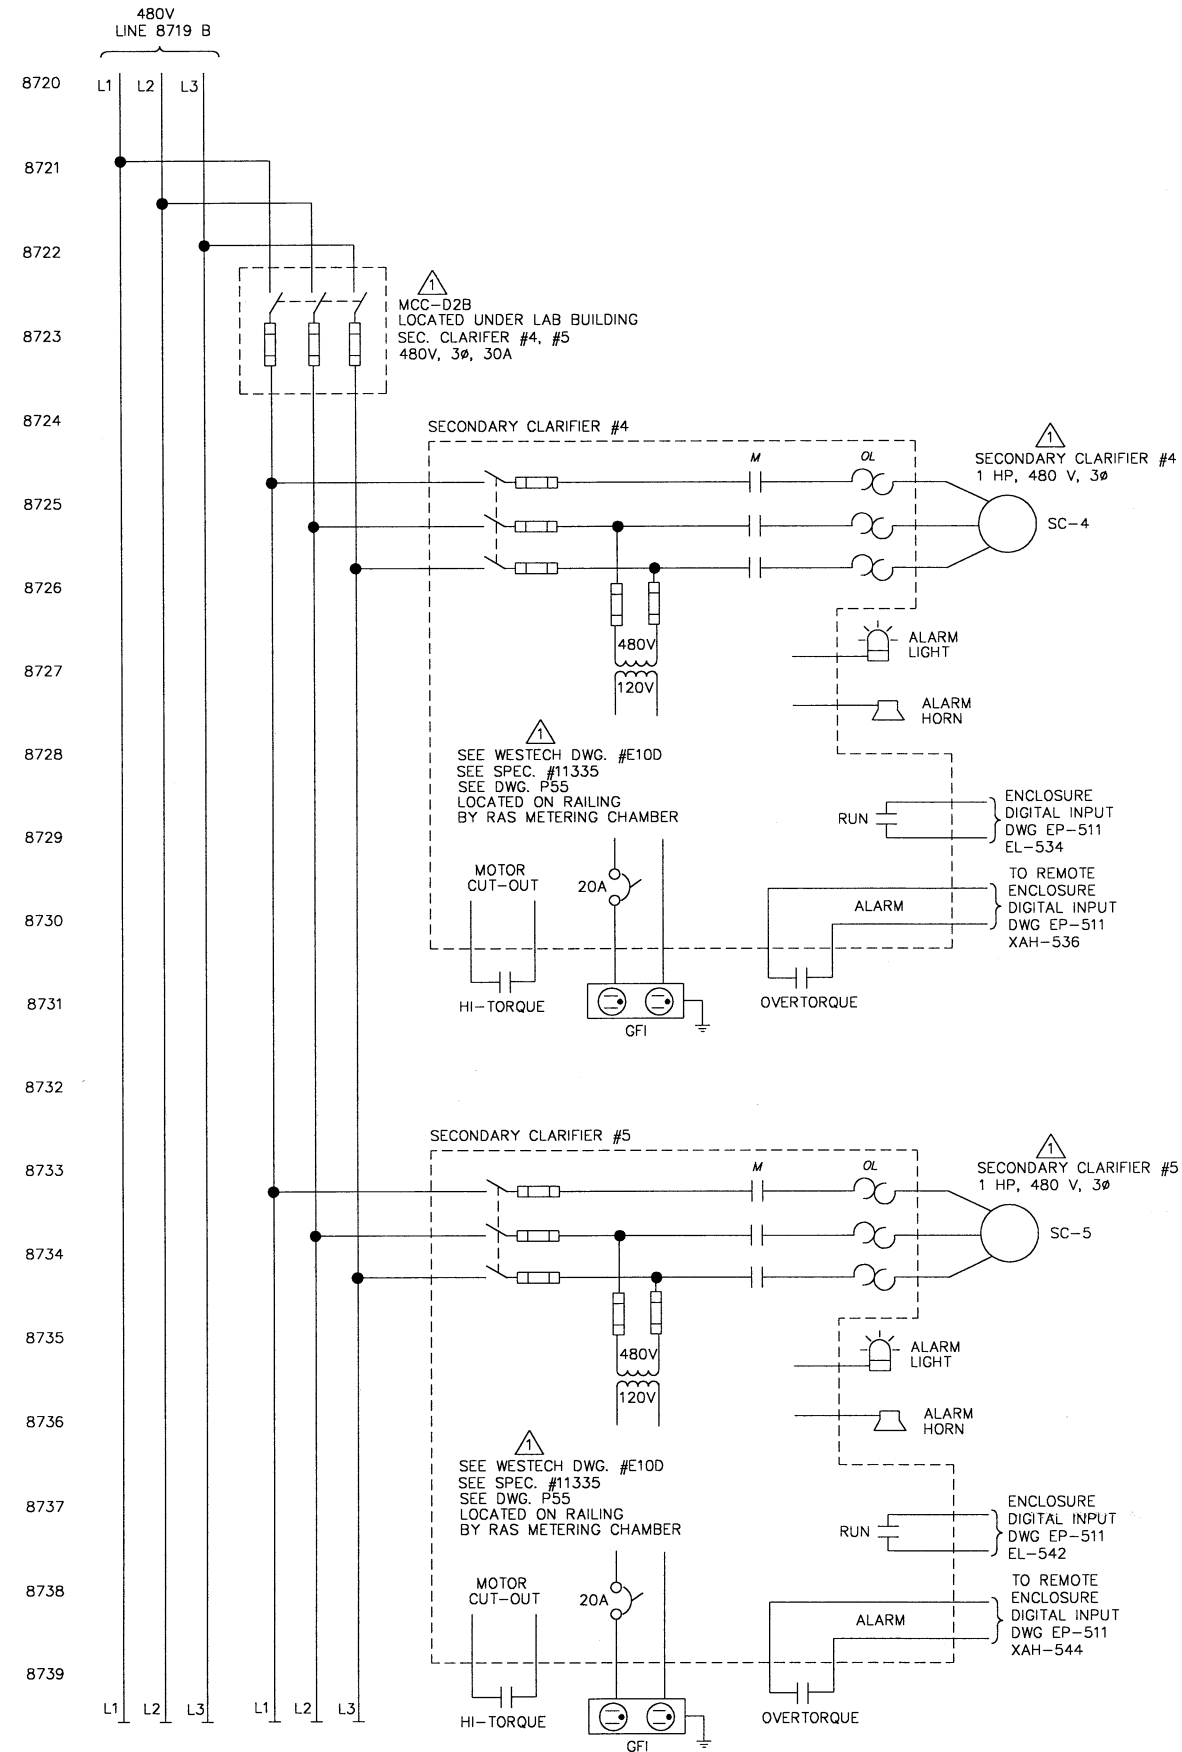
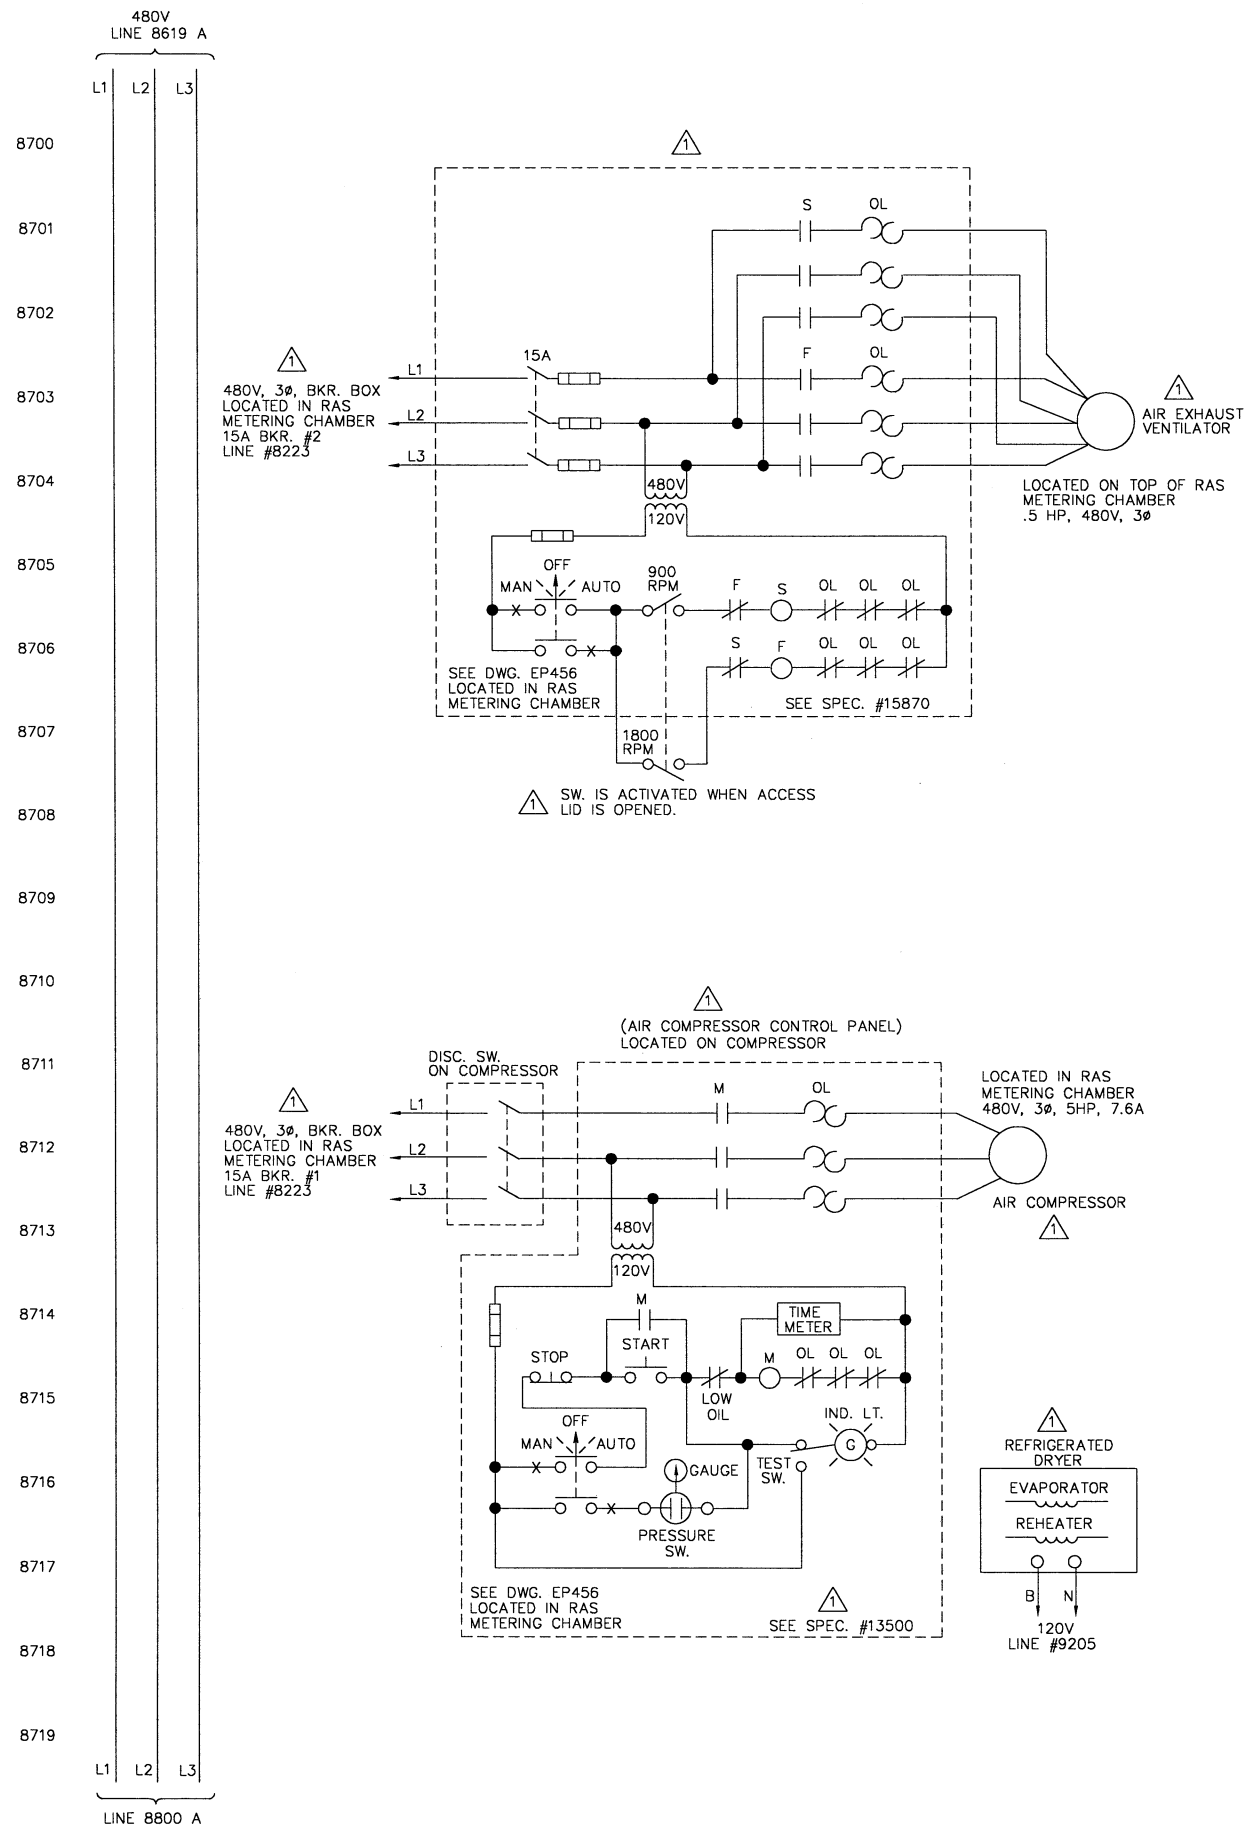


NO.	REVISED AS PER CONSTRUCTION	DATE	BY	APP'D
1		3/24/01	TSS	

DESIGNED BY STI/TSS
 DRAWN BY STI/TSS
 CHECKED BY STI/TSS
 APPROVED BY STI/R/L

ENVIRONMENTAL, INC.
 WATER AND EARTH SCIENCES
 UNIONTOWN, OHIO

CITY OF MASSILLON, OHIO
 WWTU UPGRADE 2000
 TRANSFORMER "D2", MCC-D2B
 SECONDARY CLARIFIERS 4 & 5, AND AIR COMP. SCHEMATIC

JOB NO. E9031
DATE 7/19/01
SCALE N/A
SHEET EP87-1