
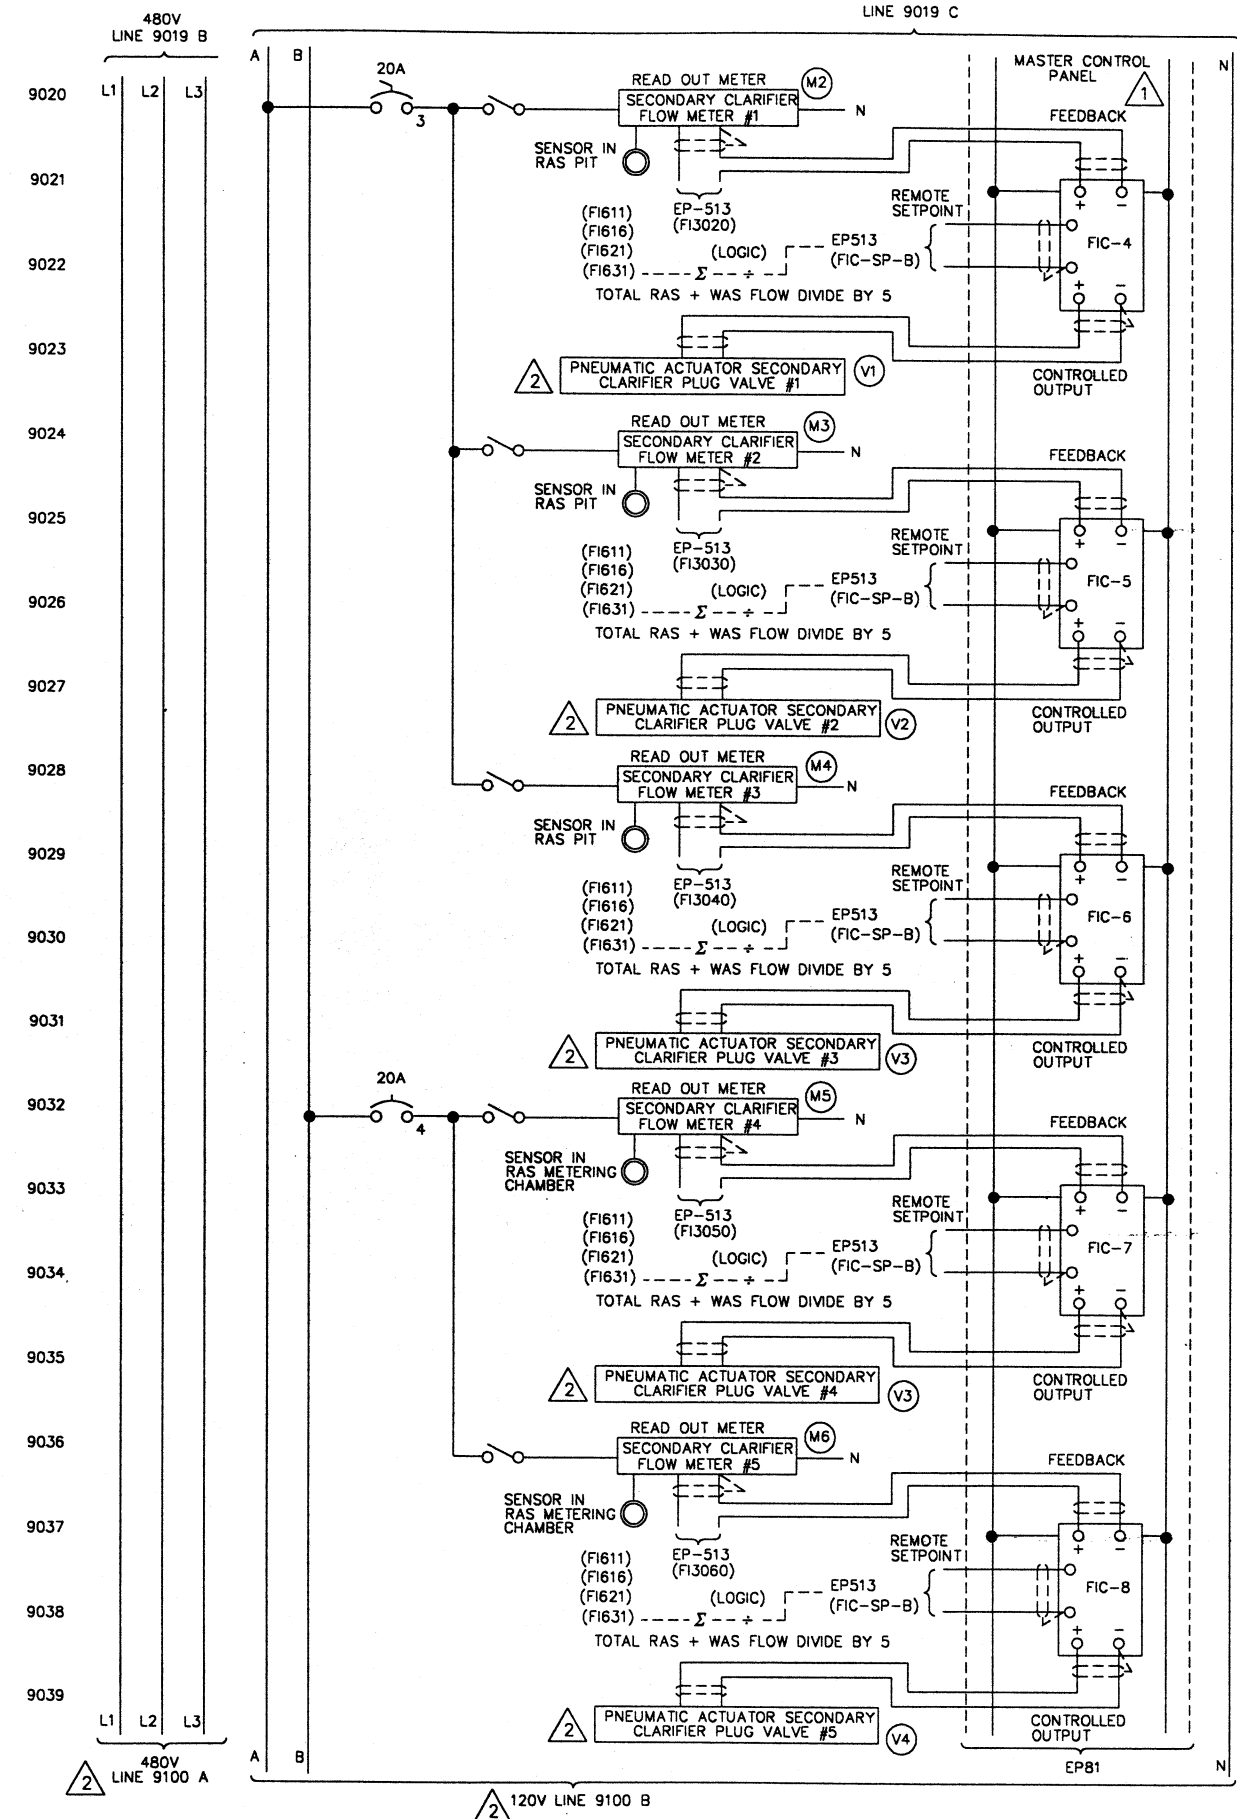


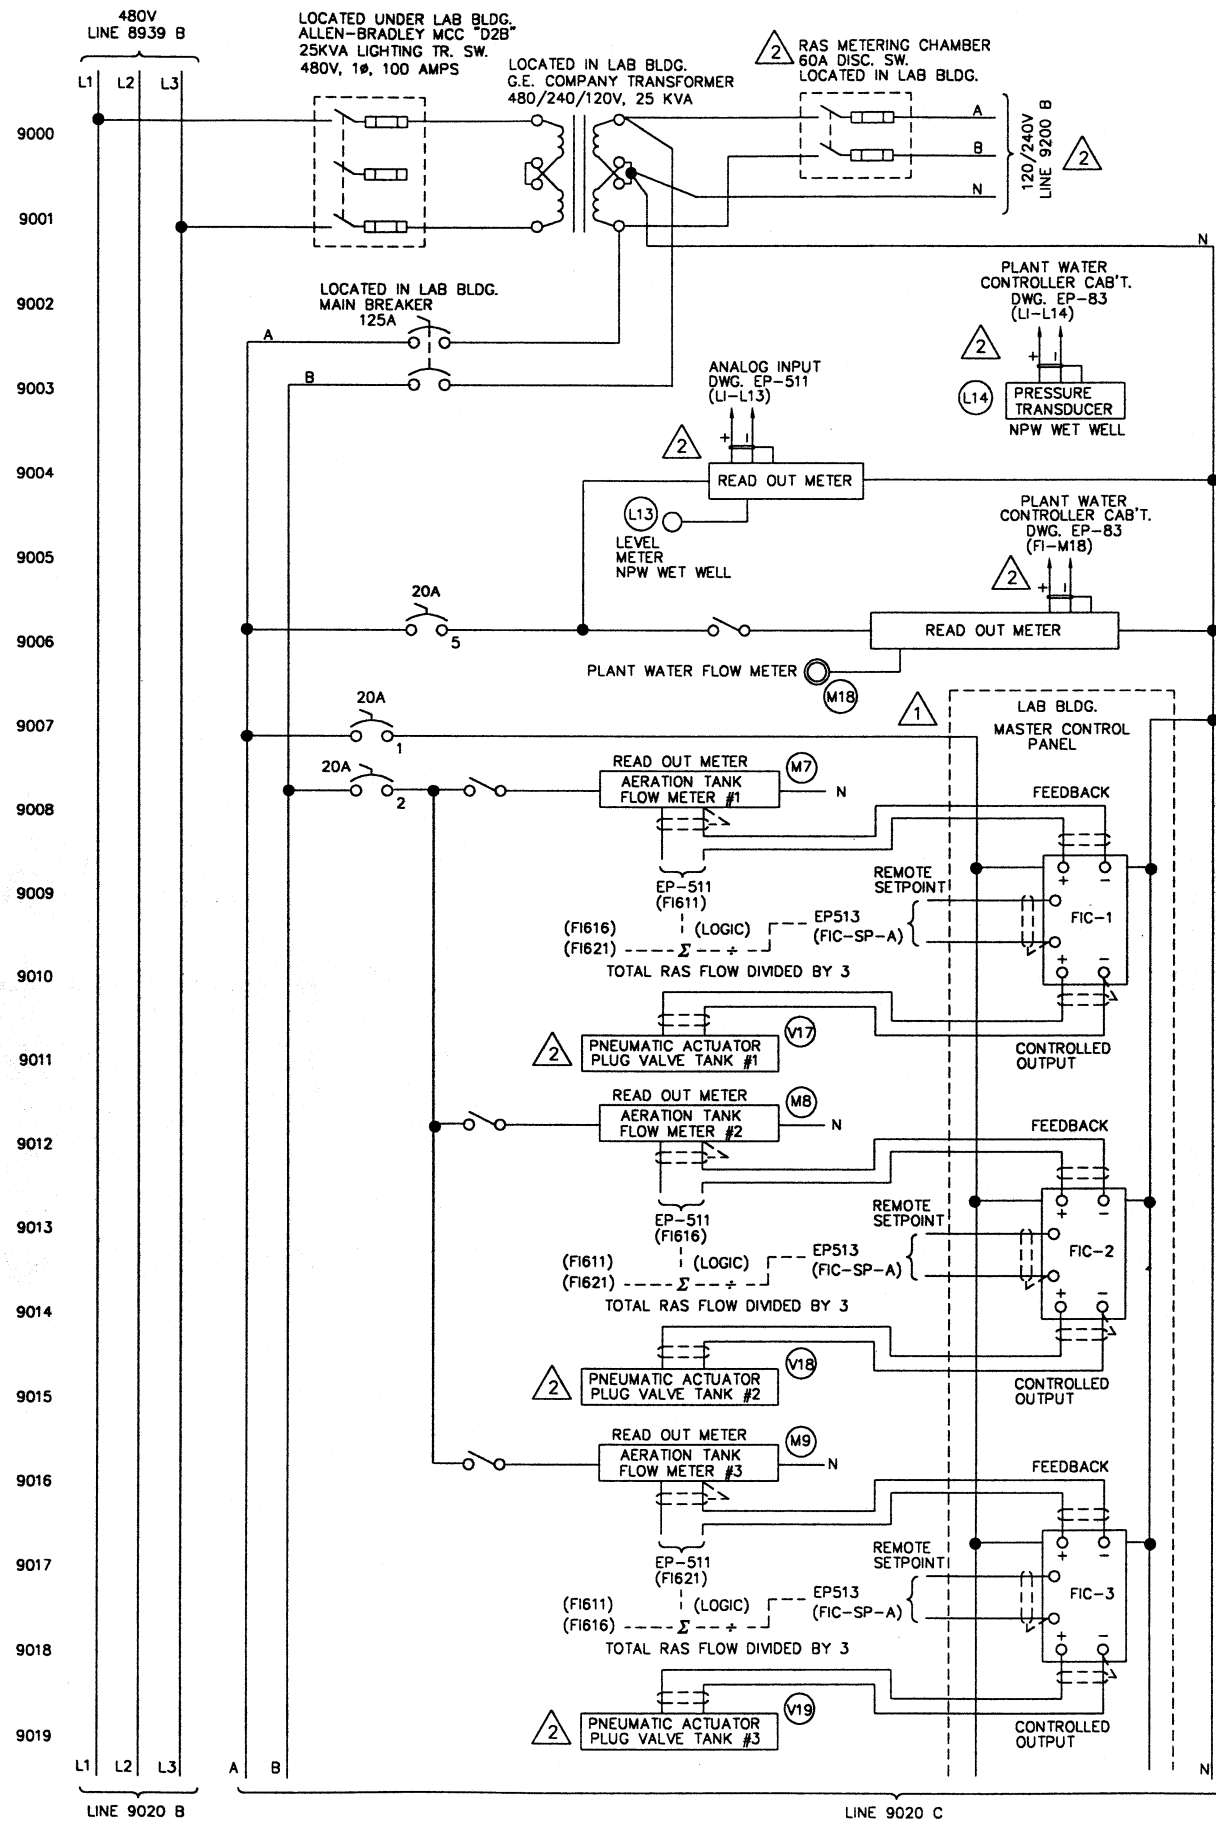

REVISIONS

NO.	DESCRIPTIONS	DATE	BY	APP'D
1	ADDED MASTER CONTROL PANEL	8/7/01	TSS	R/L
2	REVISED AS PER CONSTRUCTION	4/14/02	TSS	R/L

DESIGNED BY STI/TSS
DRAWN BY STI/TSS
CHECKED BY STI/TSS
APPROVED BY STI/R/L

ENVIRONMENTAL, INC.
 ENGINEERS IN WATER AND EARTH SCIENCES
 UNIONTOWN, OHIO

CITY OF MASSILLON, OHIO
 WWTP UPGRADE 2000
 TRANSFORMER "D2" MCC-D2B
 25 KVA TRANSFORMER SCHEMATIC DIAGRAM

JOB NO. E9031
 DATE 8/6/01
 SCALE N/A
 SHEET EP90-2

9031SCHE90.DWG