
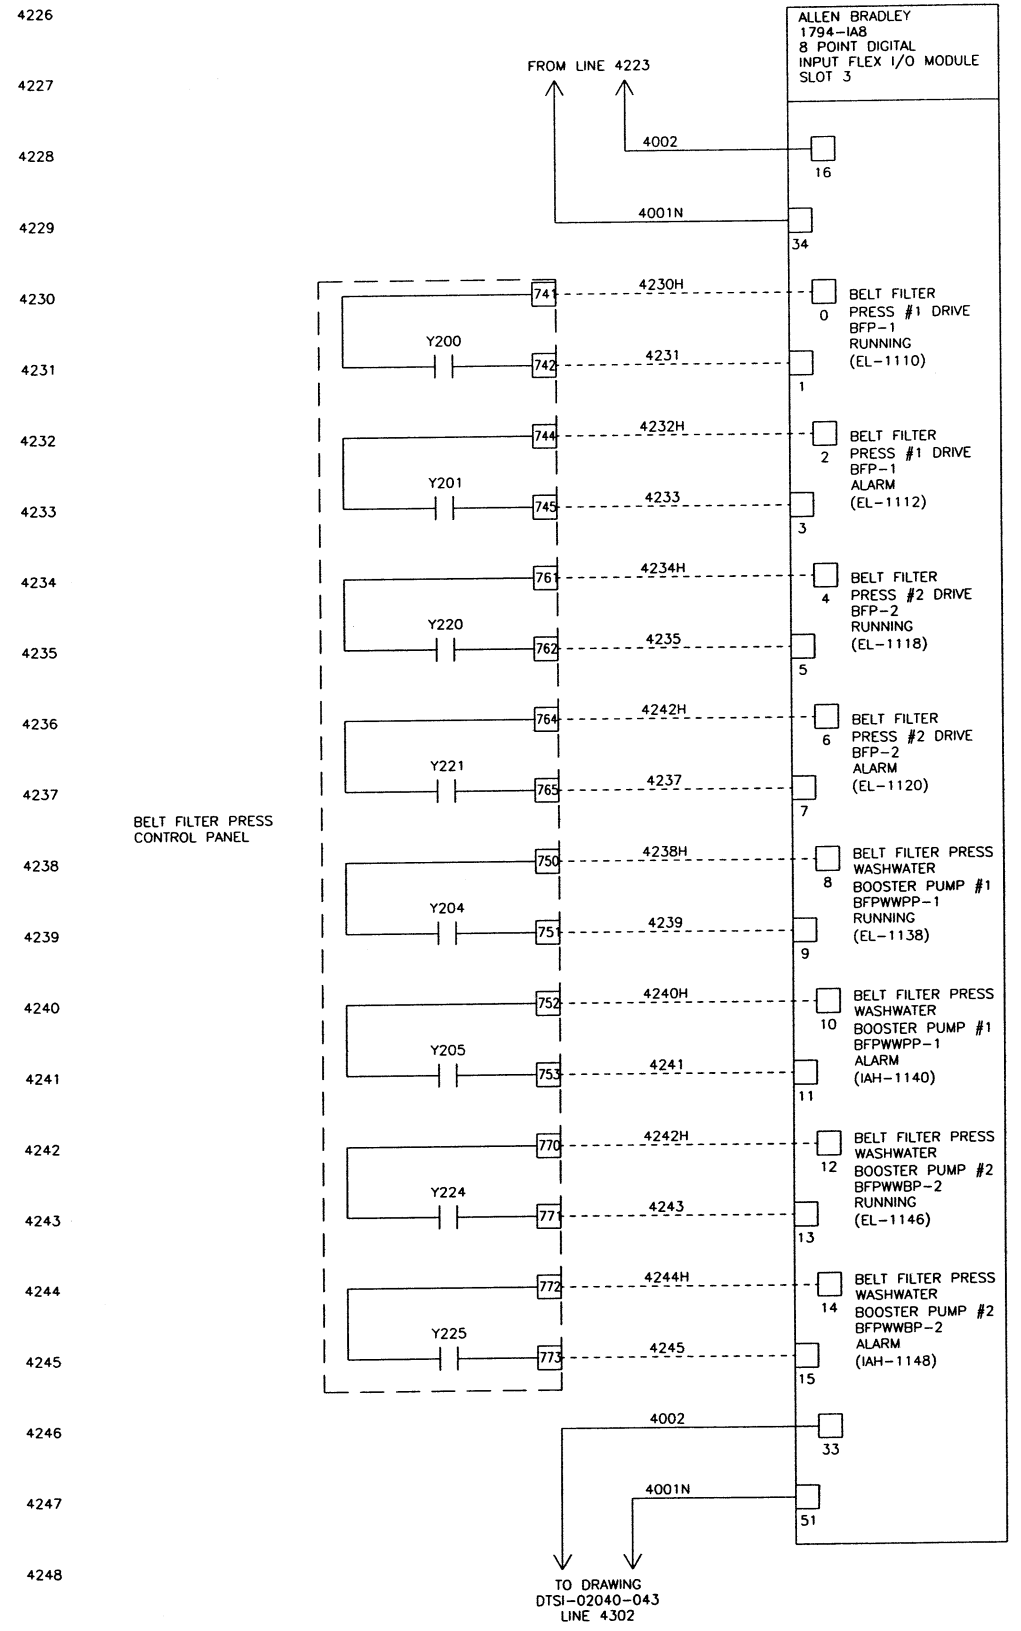


DATE	SYM	REVISION RECORD	AUTH	DR	CK
5/12/03	A	FOR APPROVAL	CUST	HR	BS

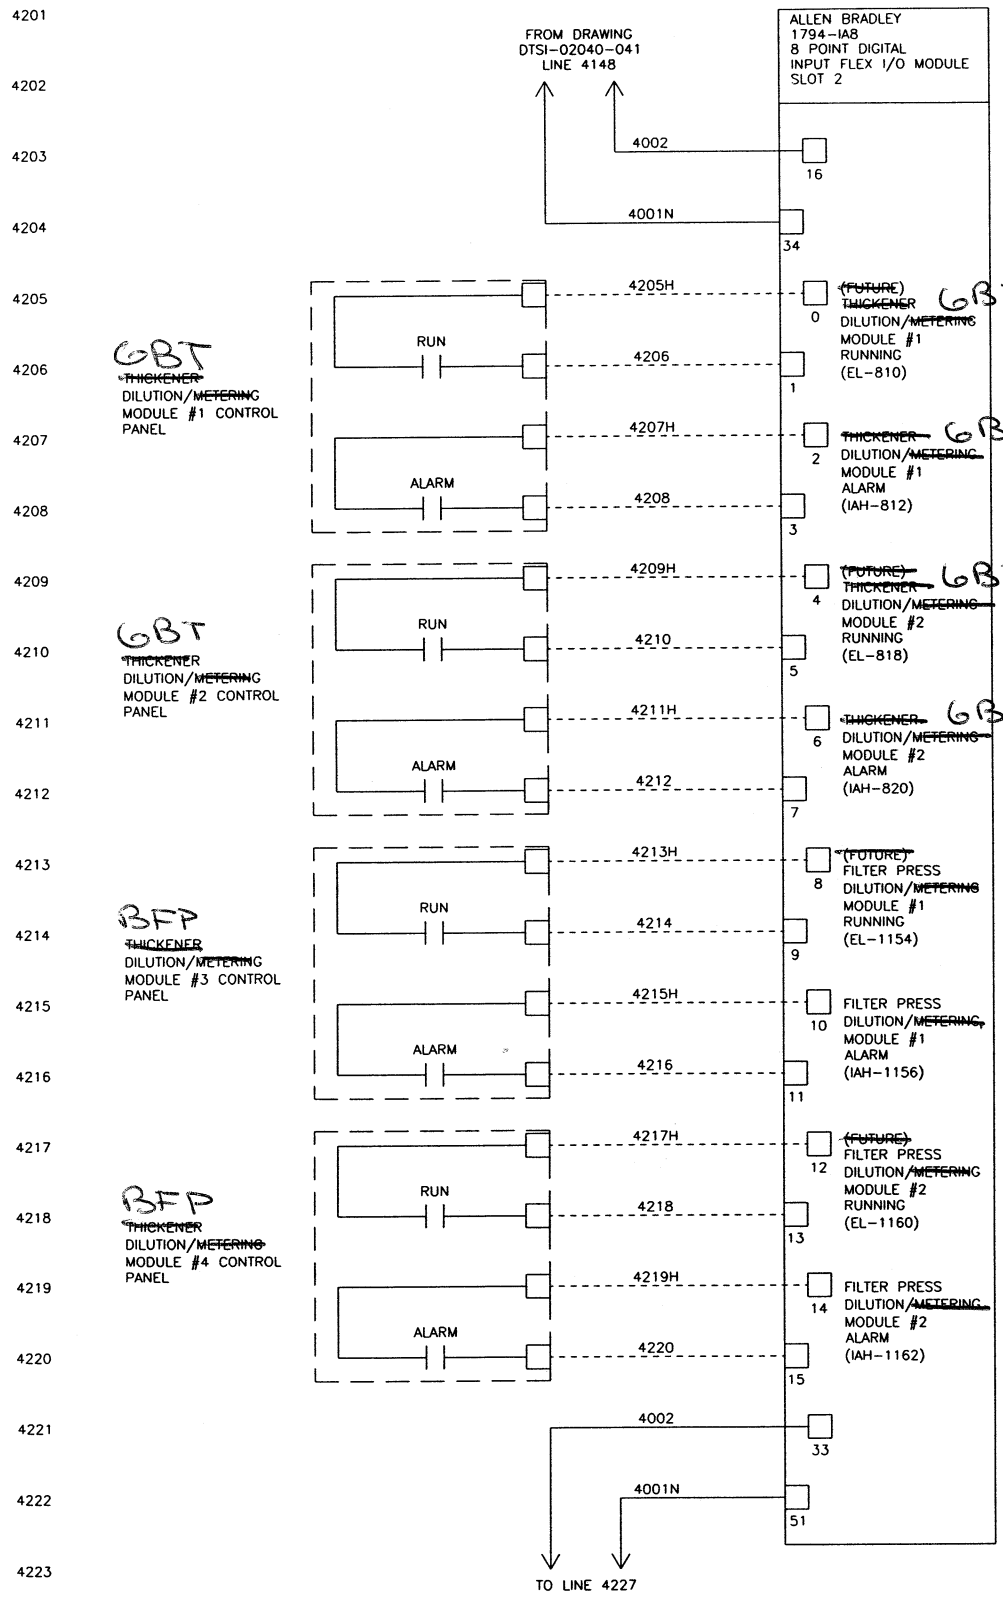

05/21/03 16:11	WIRE LUGS - NO ☒ YES ☐ RING ☐ LOCKING SPADE ☐	STATE OF OHIO ROBERT A. LANDTHORN E-37992 PROFESSIONAL ENGINEER	KOKOSING CONSTRUCTION CO. P.O. #	TOLERANCES ± DECIMAL ± .03 FRACTIONAL ± 1/32" ANGULAR ± 1"	DUBLIN TECHNICAL SYSTEMS, INC. CITY OF MASSILLON, OHIO REGIONAL WASTEWATER TREATMENT PLANT - UPGRADE 2000 PROJECT NO. E9031	SCALE	DRAWN BY	APPROVED BY
	NONE					HR	BS	
TITLE			TRANS D18 NODE 5 SOLIDS HANDLING UNIT #2 I/O WIRING DIAGRAM SLOTS 2 & 3			DATE	DRAWING NUMBER	
			4/08/02			DTSI - 02040 - 042		