
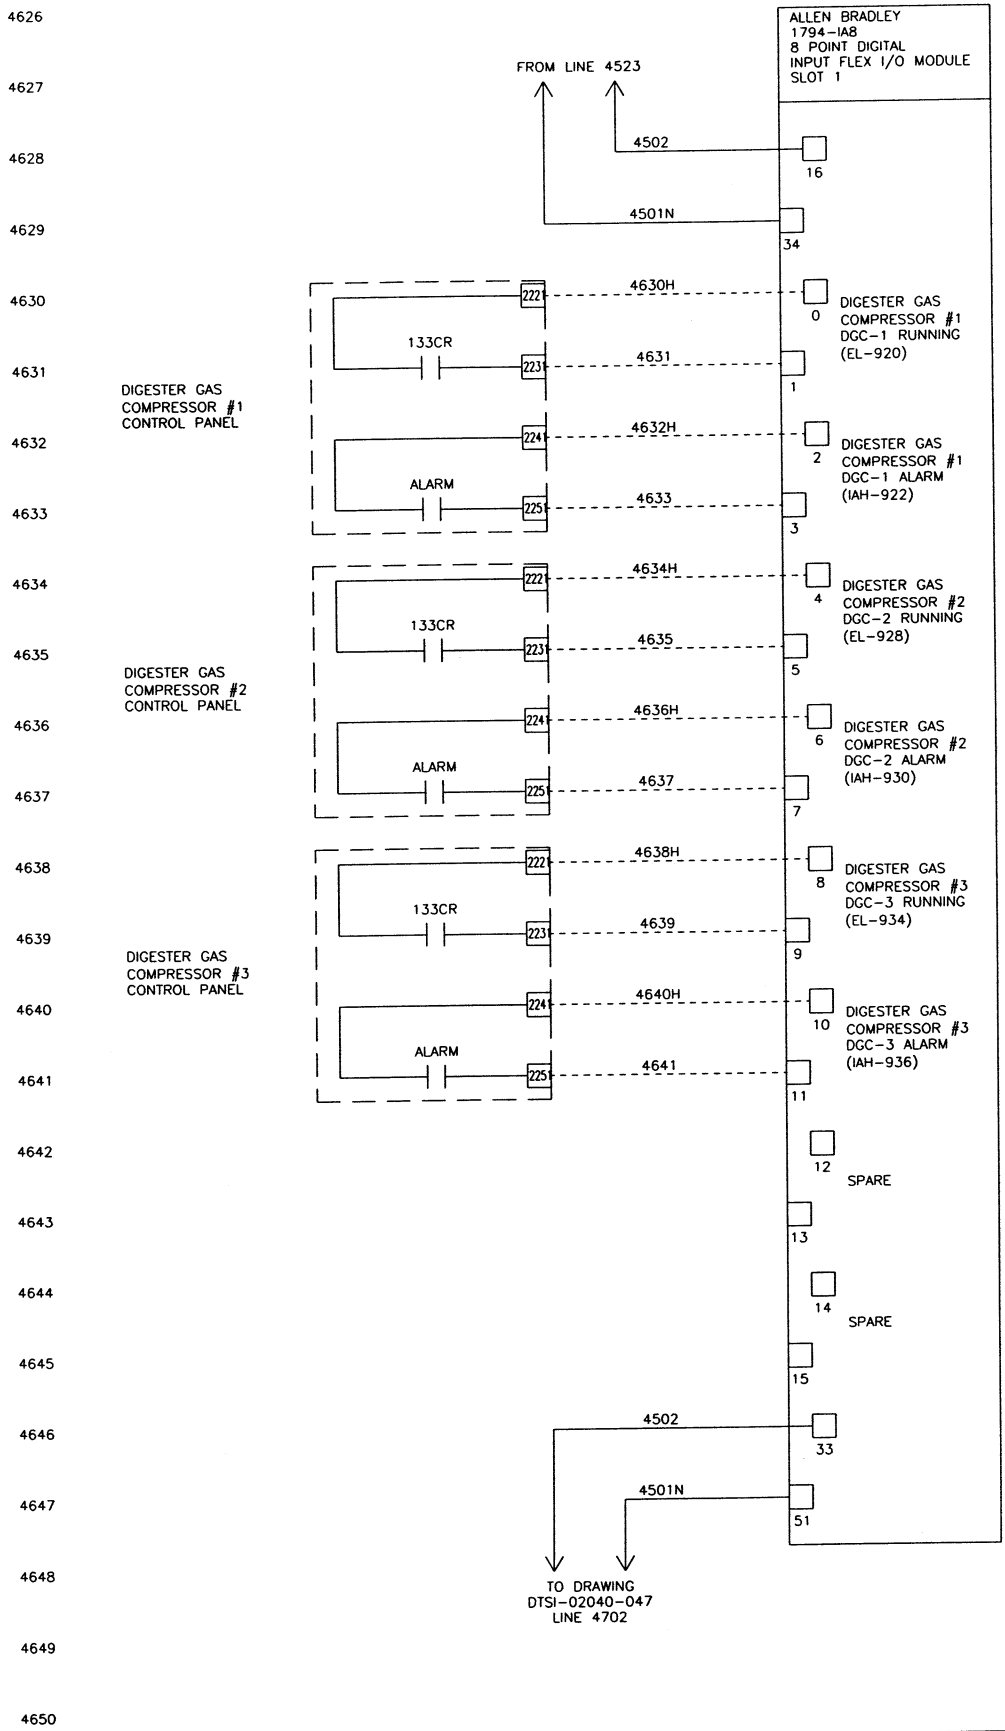


DATE	SYM	REVISION RECORD	AUTH	DR	CK
5/12/03	A	FOR APPROVAL	CUST	HR	BS

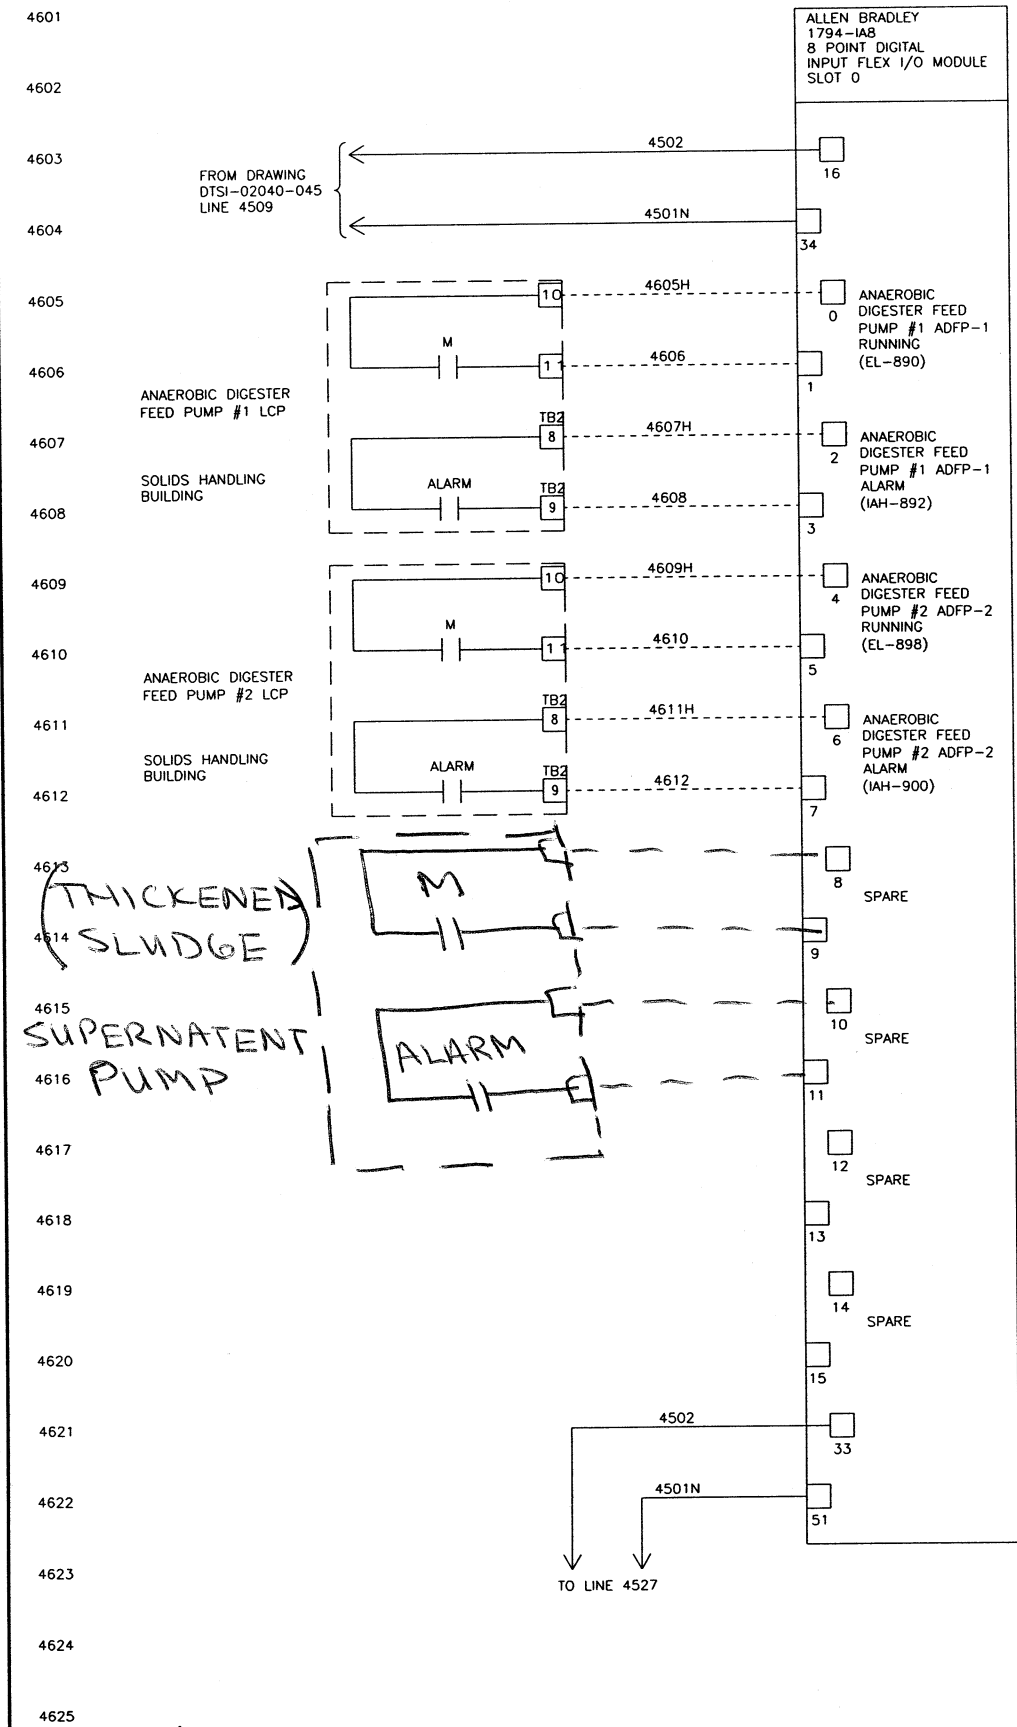

10/29/02 11:48	WIRE LUGS - NO ☒ YES ☐		RING ☐ LOCKING SPADE ☐			 KOKOSING CONSTRUCTION CO. P.O. #	TOLERANCES		 DUBLIN TECHNICAL SYSTEMS, INC.			
	INSULATION: NYLON ☐ PVC ☒						DECIMAL		CITY OF MASSILLON, OHIO REGIONAL WASTEWATER TREATMENT PLANT - UPGRADE 2000 PROJECT NO. E9031	SCALE	DRAWN BY HR	
	WIRE SPECIFICATIONS:						± .03	NONE	APPROVED BY BS			
	USAGE						FRACTIONAL		TITLE		TRANS D2A NODE 6 DIGESTER AREA I/O WIRING DIAGRAM SLOTS 0 & 1	
	AC PANEL POWER	AWG #12 BLK.	THW/THHN				± 1/32"		DATE	DRAWING NUMBER		
	AC PANEL NEUTRAL	AWG #12 WHI.	THW/THHN				ANGULAR		4/08/02	DTSI - 02040 - 046		
	AC PANEL GROUND	AWG #12 GRN.	THW/THHN				± 1"					
	AC CONTROL POWER	AWG #14 RED	THW/THHN									
	AC CONTROL NEUTRAL	AWG #14 WHI.	THW/THHN									
	AC FOREIGN	AWG #14 YELLOW	THW/THHN									
	DC POWER	AWG #16 BLUE	THW/THHN									
	DC CONTROL	AWG #16 BLUE	THW/THHN									
	SIGNAL/INSTRUMENTS	AWG #16 2 CONDUCTOR SHLD	THW/THHN									