
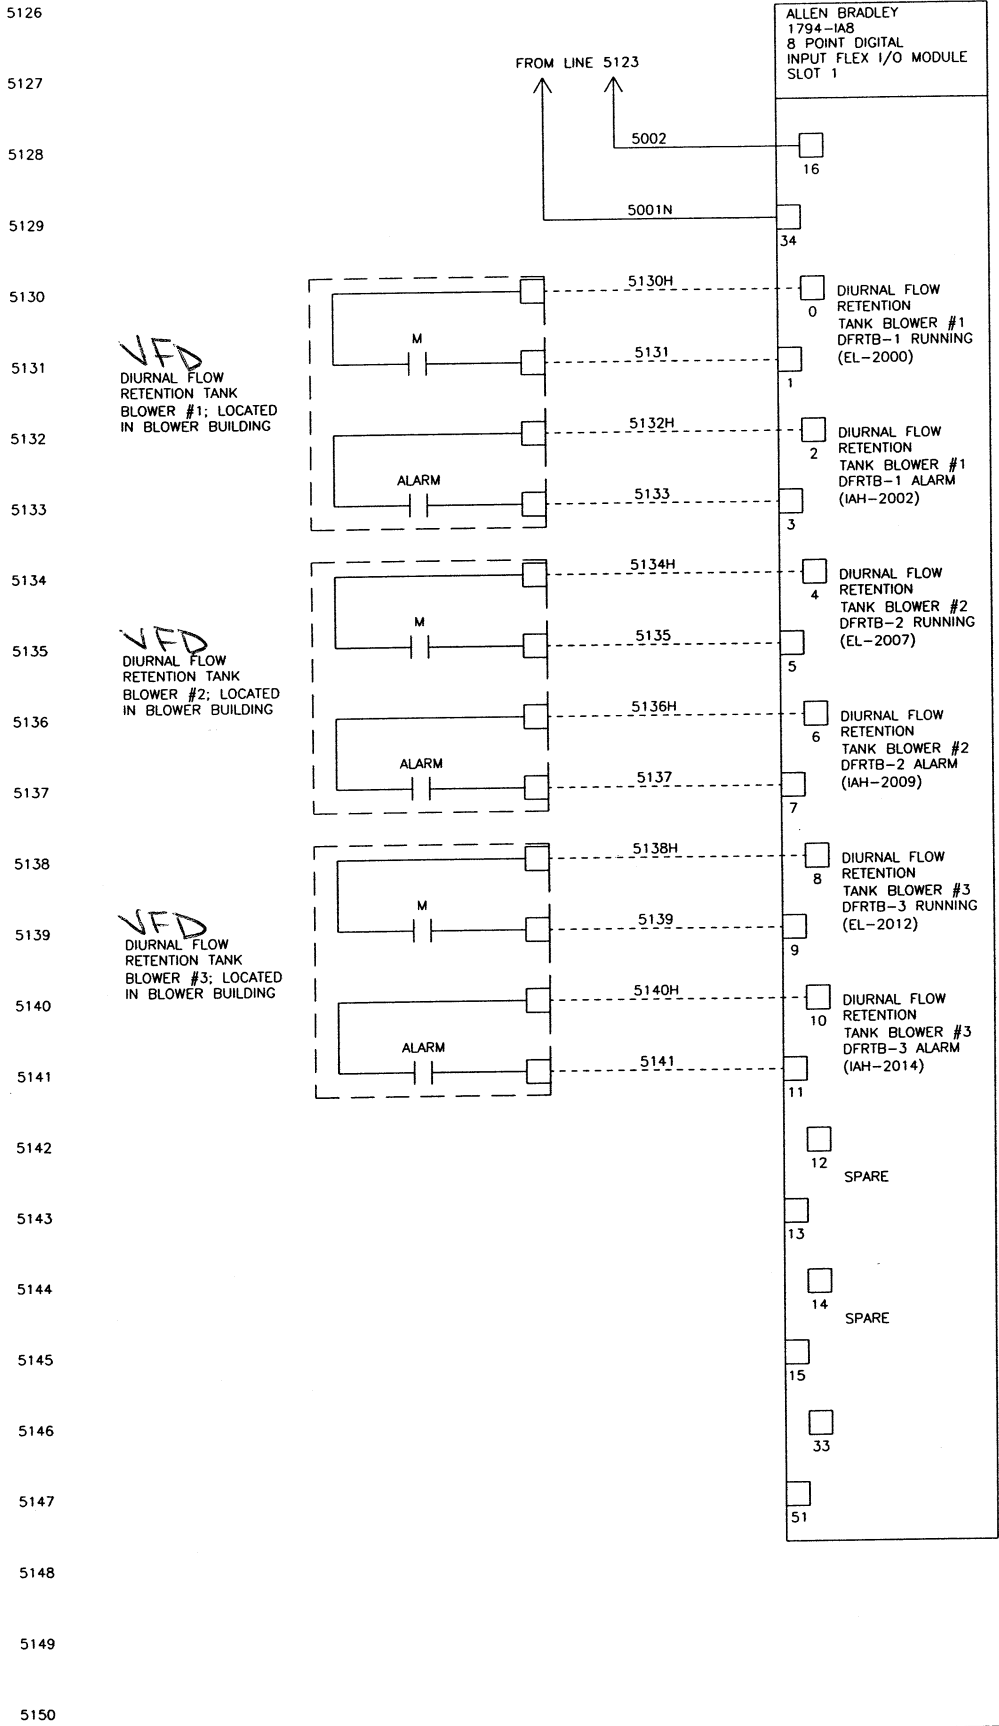


DATE	SYM	REVISION RECORD	AUTH	DR	CK
5/12/03	A	FOR APPROVAL	CUST	HR	BS

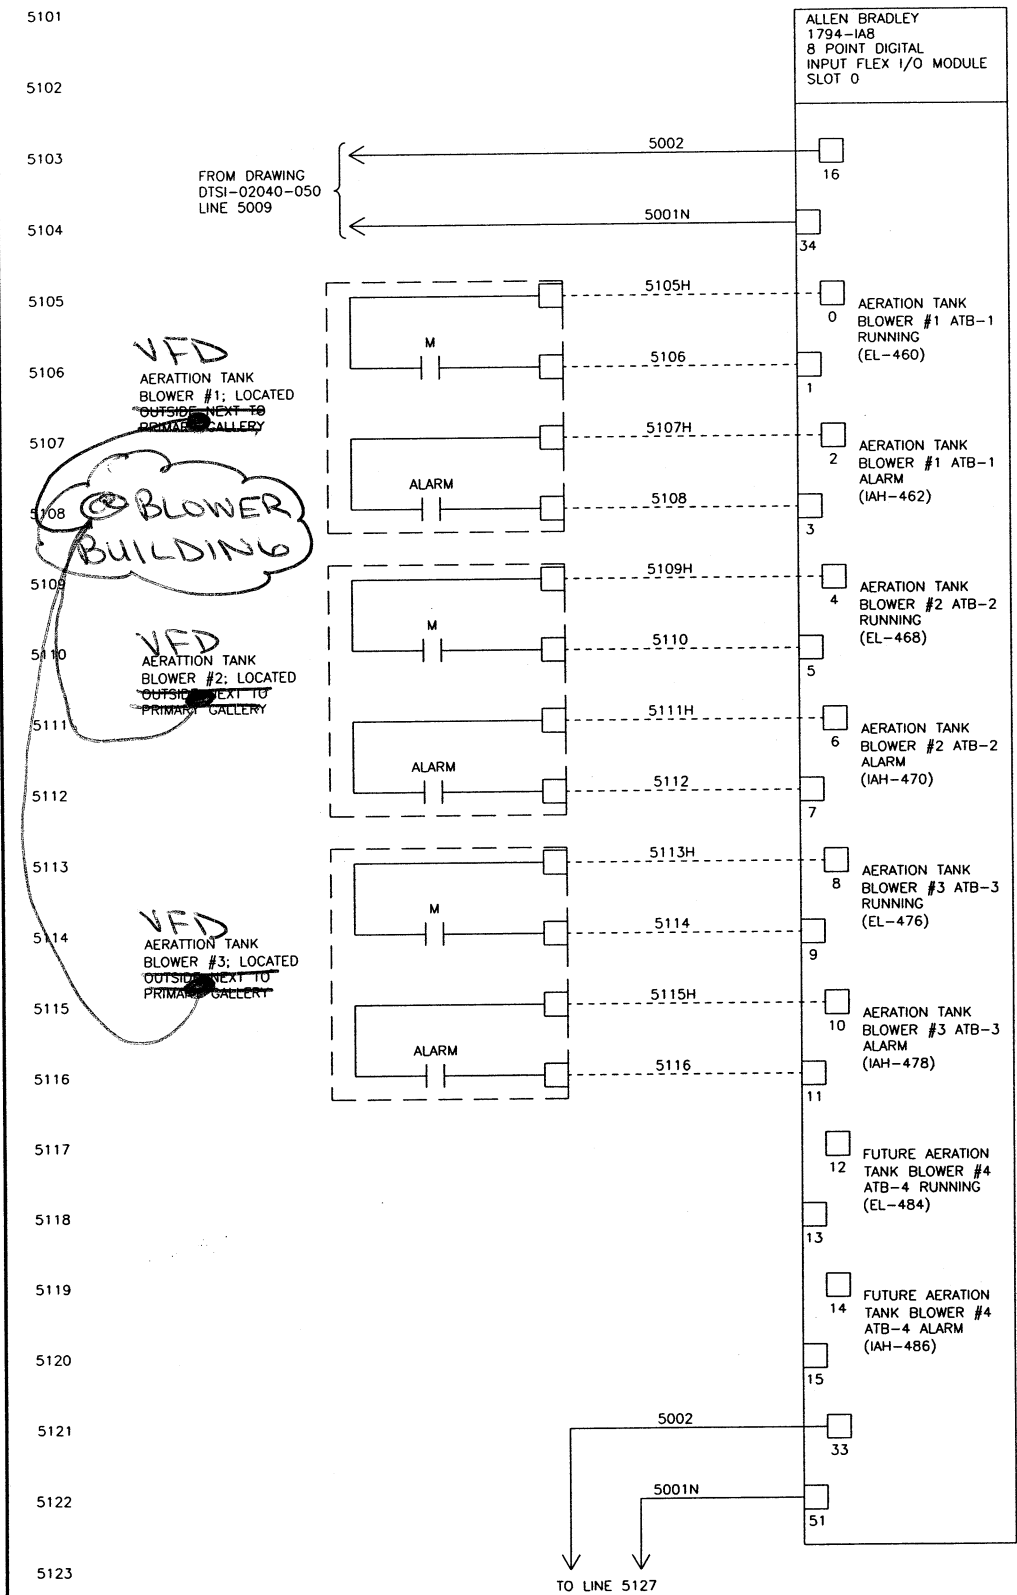

06/03/03 10:13	WIRE LUGS - NO ☒ YES ☐		RING ☐ LOCKING SPADE ☐			 KOKOSING CONSTRUCTION CO. P.O. #	TOLERANCES DECIMAL ± .03 FRACTIONAL ± 1/32" ANGULAR ± 1°	 DUBLIN TECHNICAL SYSTEMS, INC. CITY OF MASSILLON, OHIO REGIONAL WASTEWATER TREATMENT PLANT - UPGRADE 2000 PROJECT NO. E2031	SCALE NONE	DRAWN BY HR APPROVED BY BS	TITLE TRANS E1 & E2 NODE 7 BLOWER BUILDING I/O WIRING DIAGRAM SLOTS 0 & 1	DATE 4/08/02	DRAWING NUMBER DTSI - 02040 - 051								
	INSULATION: NYLON ☐ PVC ☒																				
	WIRE SPECIFICATIONS:													STATE OF OHIO REGISTERED PROFESSIONAL ENGINEER ROBERT A. LANDTHORN C-37992							
	USAGE		SIZE	COLOR										INSULATION							
	AC PANEL POWER		AWG #12	BLK.										THW/THHN							
	AC PANEL NEUTRAL		AWG #12	WHI.										THW/THHN							
	AC PANEL GROUND		AWG #12	GRN.										THW/THHN							
	AC CONTROL POWER		AWG #14	RED										THW/THHN							
	AC CONTROL NEUTRAL		AWG #14	WHI.										THW/THHN							
	AC FORECH		AWG #14	YELLOW										THW/THHN							
	DC POWER		AWG #16	BLUE										THW/THHN							
	DC CONTROL SIGNAL/INSTRUMENTS		AWG #16	BLUE										THW/THHN							
			AWG #16	2 CONDUCTOR SHLD										THW/THHN							