


DATE	SYM	REVISION RECORD	AUTH	OR	CK
5/12/03	A	FOR APPROVAL	CUST	TL	JK

 
L3 FIELD

PLC PANEL NODE 8

FIELD

STORM BASIN PUMP CONTROL PANEL

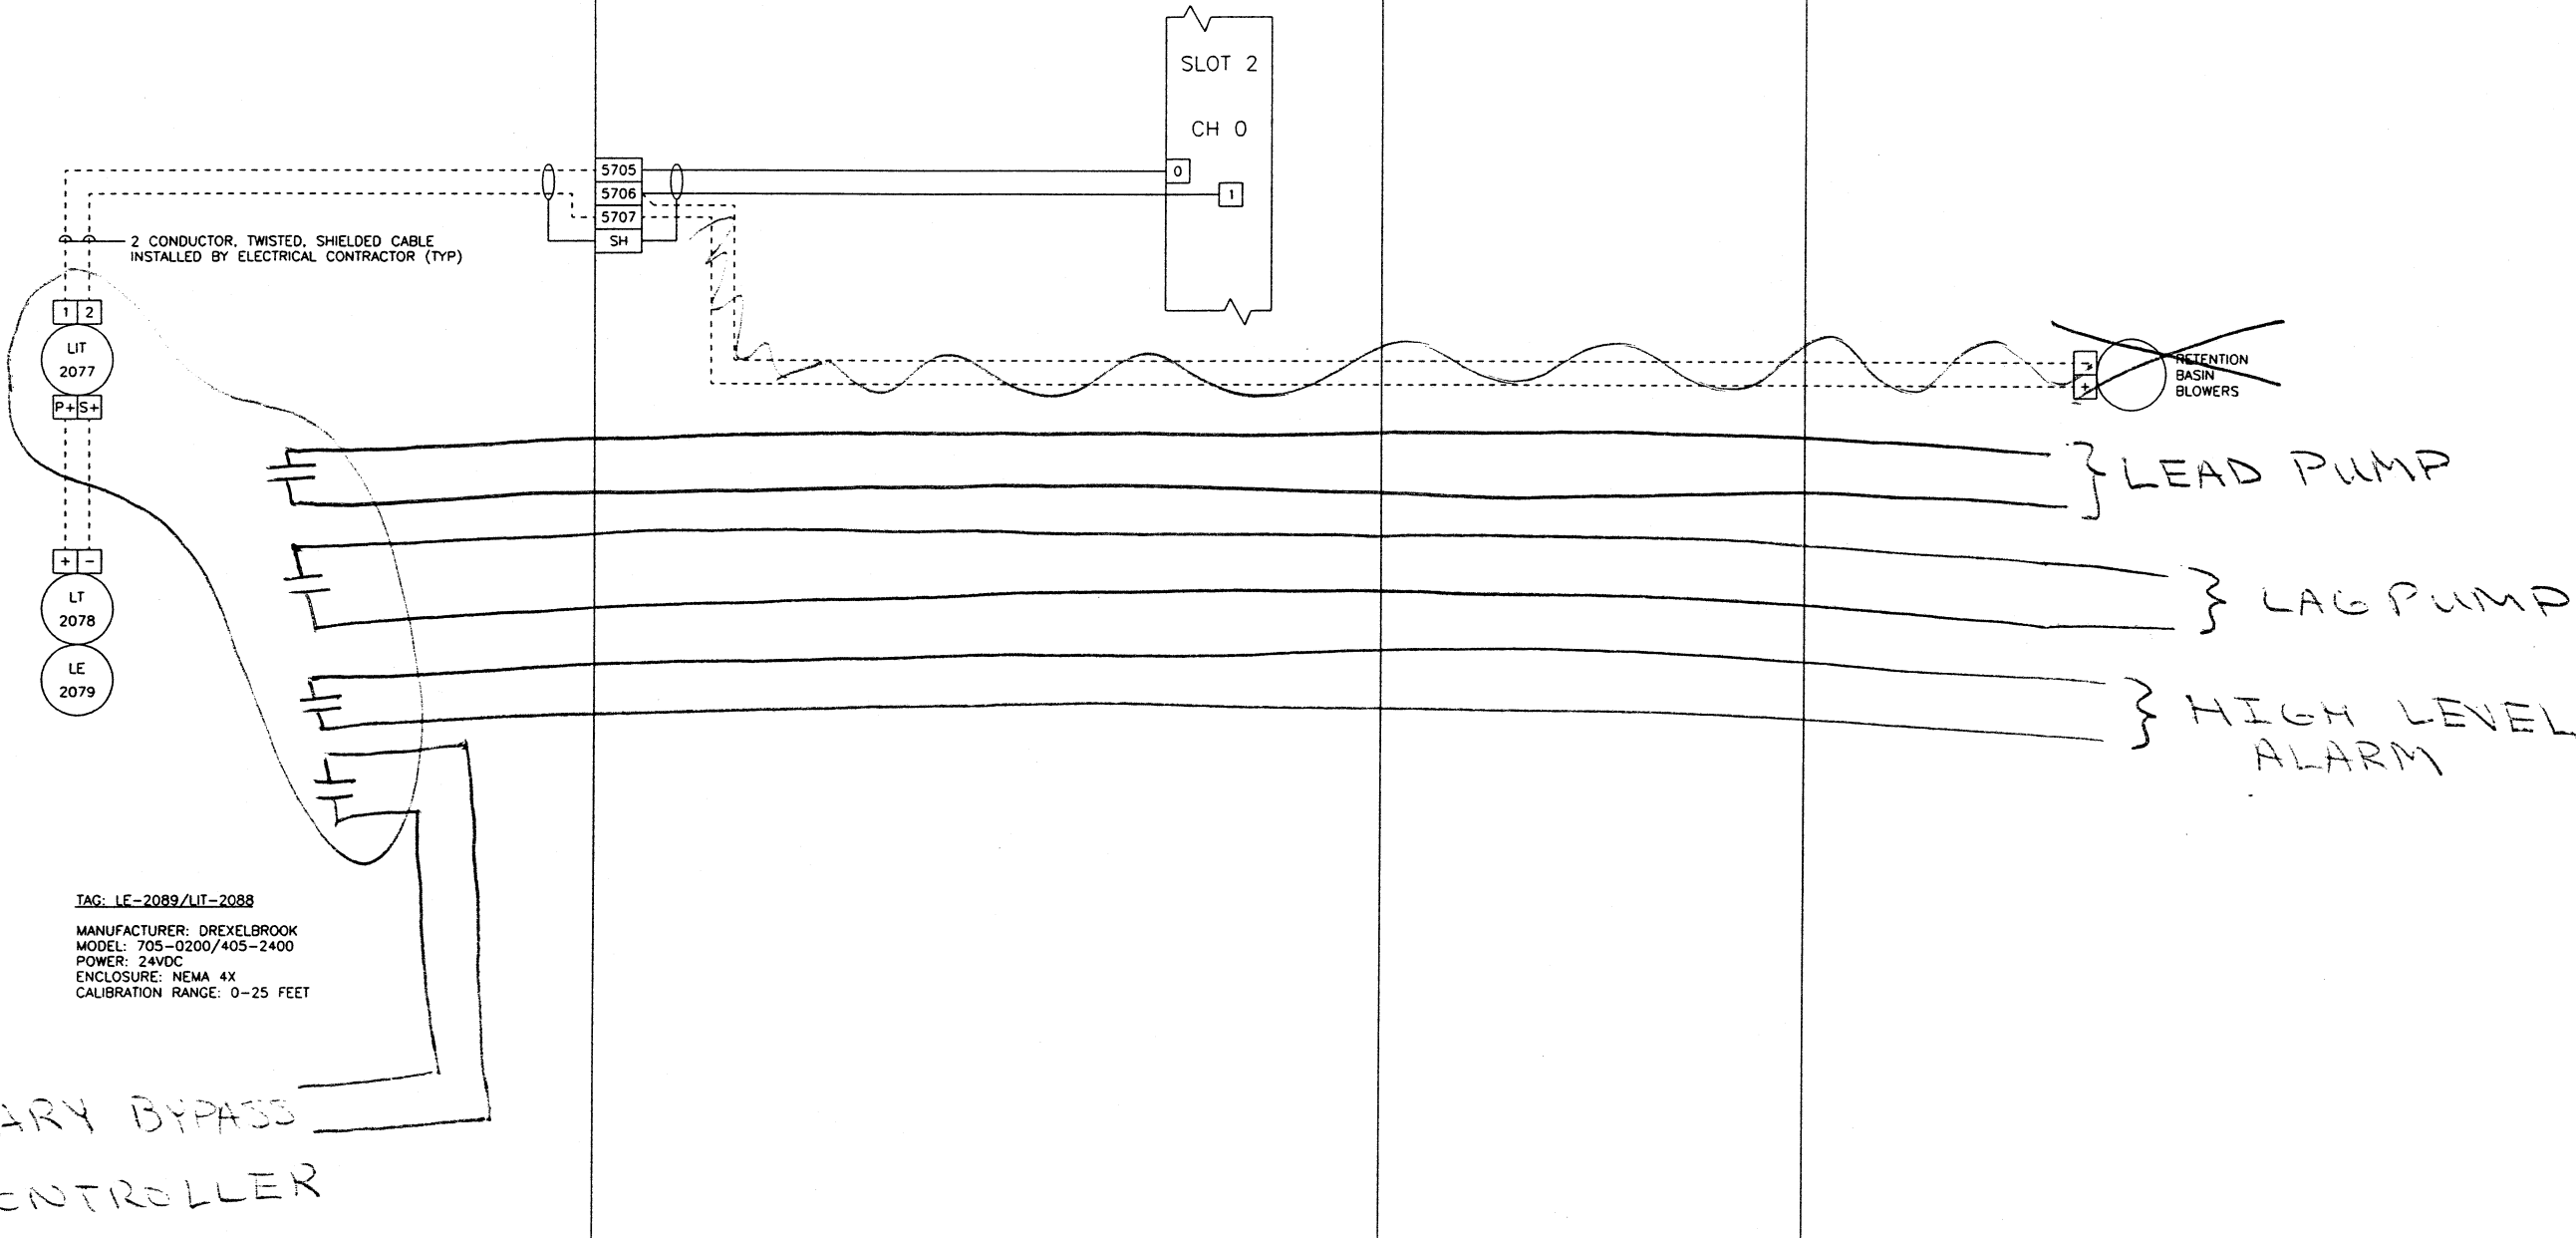

06/04/03 14:16	WIRE LUGS - NO ☒ YES ☐		RING ☐ LOCKING SPADE ☐			 KOKOSING CONSTRUCTION CO. P.O. #	TOLERANCES		 DUBLIN TECHNICAL SYSTEMS, INC.		
	INSULATION: NYLON ☐ PVC ☒						DECIMAL	CITY OF MASSILLON, OHIO REGIONAL WASTEWATER TREATMENT PLANT - UPGRADE 2000 PROJECT NO. 03031		SCALE	DRAWN BY <i>TL</i>
	WIRE SPECIFICATIONS:						+ .03			NONE	APPROVED BY <i>JK</i>
	USAGE	SIZE	COLOR	INSULATION			FRACTIONAL	TITLE STORM FLOW RETENTION TANK WATER LEVEL L3			
	AC PANEL POWER	AWG #12	BLK	THW/THHN			+ 1/32"				
	AC PANEL NEUTRAL	AWG #12	WHT	THW/THHN							
	AC PANEL GROUND	AWG #12	GRN	THW/THHN							
	AC CONTROL POWER	AWG #14	RED	THW/THHN							
	AC CONTROL NEUTRAL	AWG #14	WHT	THW/THHN							
	AC FOREIGN	AWG #14	YELLOW	THW/THHN							
DC POWER	AWG #16	BLUE	THW/THHN								
DC CONTROL	AWG #16	BLUE	THW/THHN								
SIGNAL/INSTRUMENTS	AWG #16	2 CONDUCTOR SHLD	THW/THHN								
						DUBLIN TECHNICAL SYSTEMS INC. PROJECT # 02040		DATE	DRAWING NUMBER		
								9/18/02	DTSI - 02040 - 251		