


DATE	SYM	REVISION RECORD	AUTH	DR	CK
5/12/03	A	FOR APPROVAL			

L4 FIELD

PLC PANEL NODE 4

FIELD

GBT CONTROL PANEL

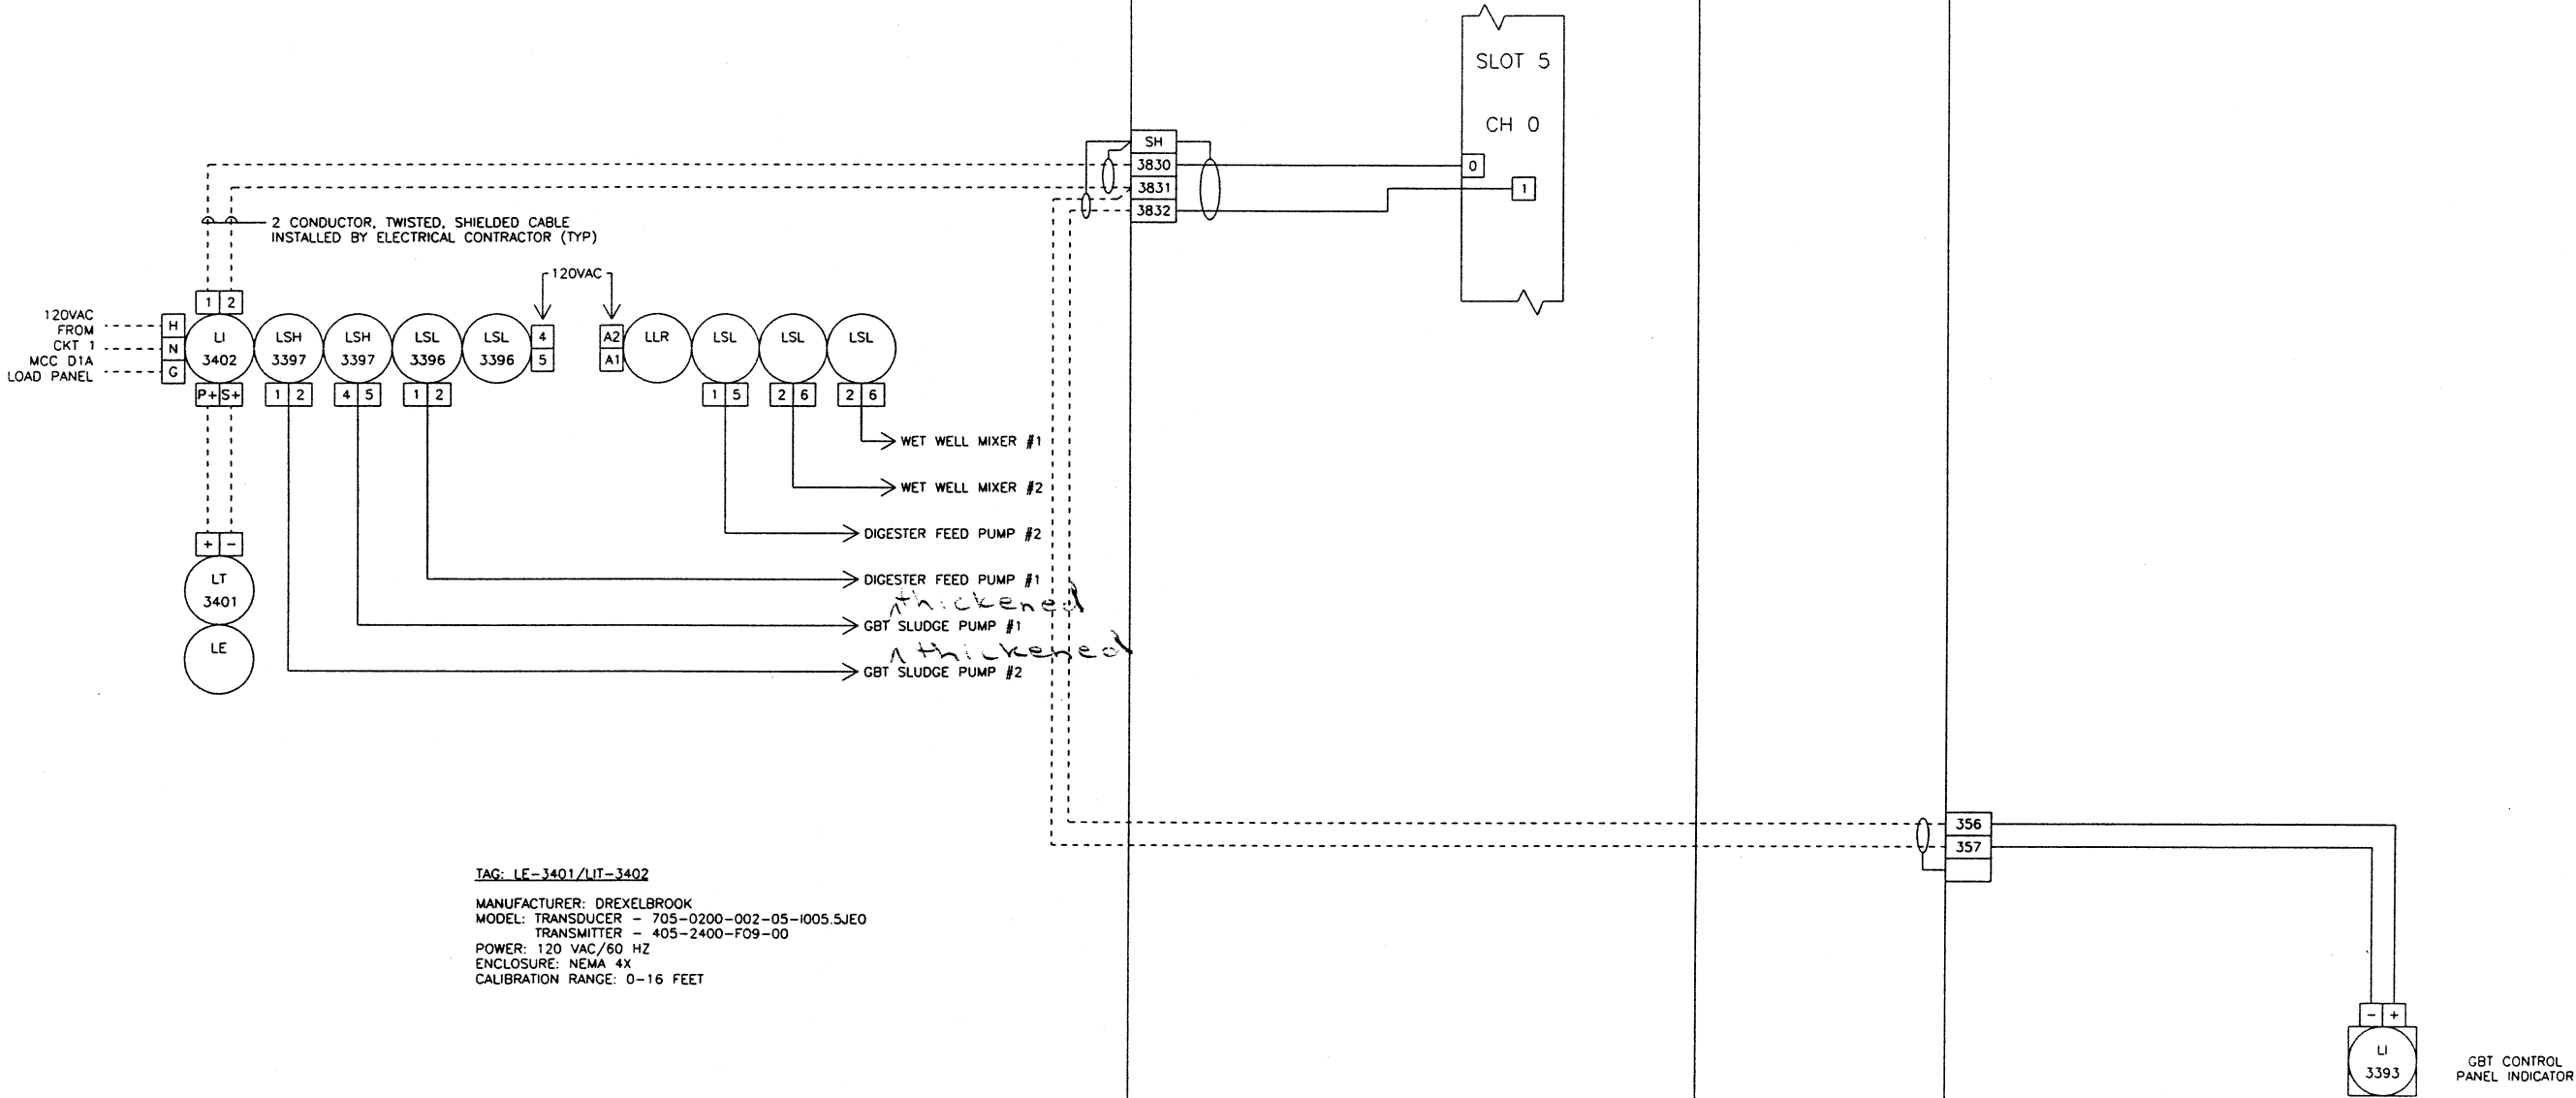

06/04/03 15:49

WIRE LUGS - NO ☒ YES ☐		RING ☐ LOCKING SPADE ☐	
INSULATION: NYLON ☐ PVC ☒			
WIRE SPECIFICATIONS:			
USAGE	SIZE	COLOR	INSULATION
AC PANEL POWER	AWG #12	BLK	THW/THHN
AC PANEL NEUTRAL	AWG #12	WHT	THW/THHN
AC PANEL GROUND	AWG #12	GRN	THW/THHN
AC CONTROL POWER	AWG #14	RED	THW/THHN
AC CONTROL NEUTRAL	AWG #14	WHT	THW/THHN
AC FOREIGN	AWG #14	YELLOW	THW/THHN
DC POWER	AWG #16	BLUE	THW/THHN
DC CONTROL	AWG #16	BLUE	THW/THHN
SIGNAL/INSTRUMENTS	AWG #16	2 CONDUCTOR SHLD	THW/THHN



KOKOSING
CONSTRUCTION CO.
P.O. #

DUBLIN TECHNICAL SYSTEMS INC.
PROJECT # 02040

TOLERANCES	DUBLIN TECHNICAL SYSTEMS, INC.
DECIMAL	CITY OF MASSILLON, OHIO REGIONAL WASTEWATER TREATMENT PLANT - UPGRADE 2000 PROJECT NO. E9031
FRACTIONAL	SCALE NONE
ANGULAR	DRAWN BY TL APPROVED BY JK
	TITLE THICKENED SLUDGE WET WELL LEVEL, L-4
	DATE 9/18/02
	DRAWING NUMBER DTSI - 02040 - 252