


DATE	SYM	REVISION RECORD	AUTH	DR	CK
5/12/03	A	FOR APPROVAL	CUST	RTR	JK

L10 FIELD

PLC PANEL OPERATORS LABORATORY ENCLOSURE

HIGH RIVER LEVEL PUMPS CONTROL PANEL

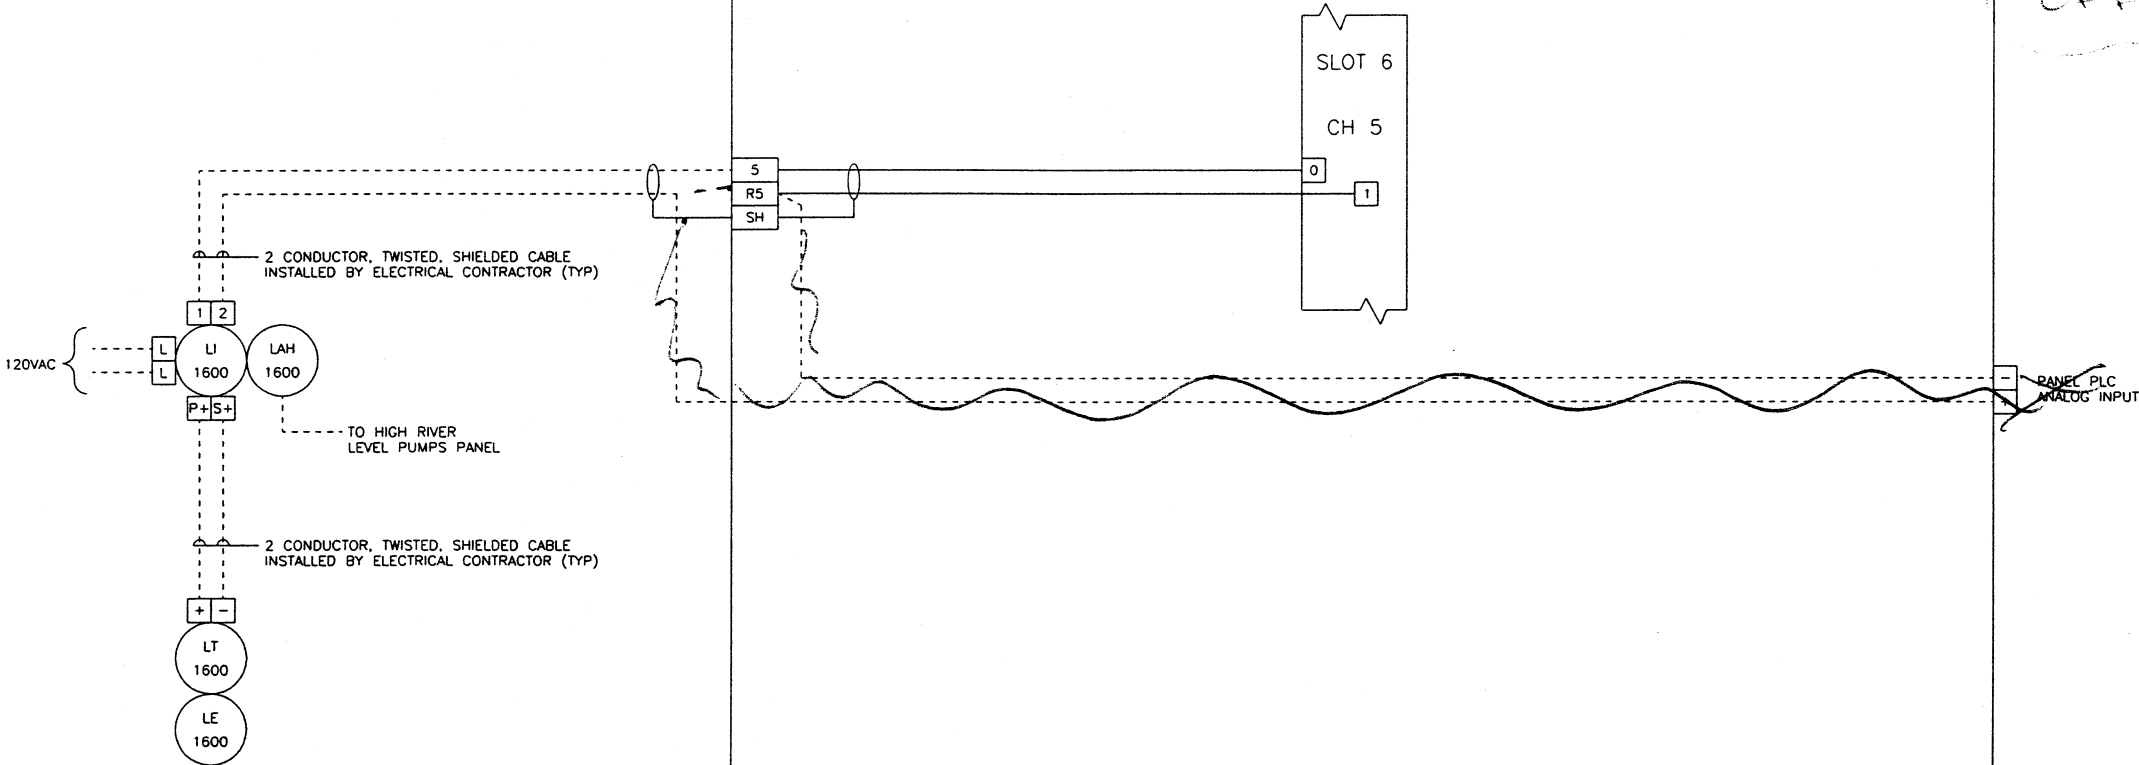

TAG: LE-/LT-1600
MANUFACTURER: DREXELBROOK
MODEL: 705-6200/405-2400
POWER: 120VAC
ENCLOSURE: NEMA 4X
CALIBRATION RANGE: 0-16 FEET

08/28/02 09:07	WIRE LUGS - NO ☒ YES ☐		RING ☐ LOCKING SPADE ☐				TOLERANCES		DUBLIN TECHNICAL SYSTEMS, INC.		
	INSULATION: NYLON ☐ PVC ☒						DECIMAL	CITY OF MASSILLON, OHIO REGIONAL WASTEWATER TREATMENT PLANT - UPGRADE 2000 PROJECT NO. E9031	SCALE	DRAWN BY <i>RTR</i>	
	WIRE SPECIFICATIONS:						± .03		NONE	APPROVED BY <i>JK</i>	
	USAGE						FRACTIONAL	TITLE HIGH RIVER STAGE LEVEL, L-10			
	AC PANEL POWER	AWG #12	BLK.	THW/THHN			± 1/32"	DATE			
	AC PANEL NEUTRAL	AWG #12	WHT.	THW/THHN			± 1°	DRAWING NUMBER			
	AC PANEL GROUND	AWG #12	GRN.	THW/THHN			9/18/02	DTSI - 02040 - 256			
	AC CONTROL POWER	AWG #14	RED	THW/THHN							
	AC CONTROL NEUTRAL	AWG #14	WHT.	THW/THHN							
	AC FOREIGN	AWG #14	YELLOW	THW/THHN							
	DC POWER	AWG #18	BLUE	THW/THHN							
	AC CONTROL SIGNAL/INSTRUMENTS	AWG #18	2 CONDUCTOR SHLD.	THW/THHN							