


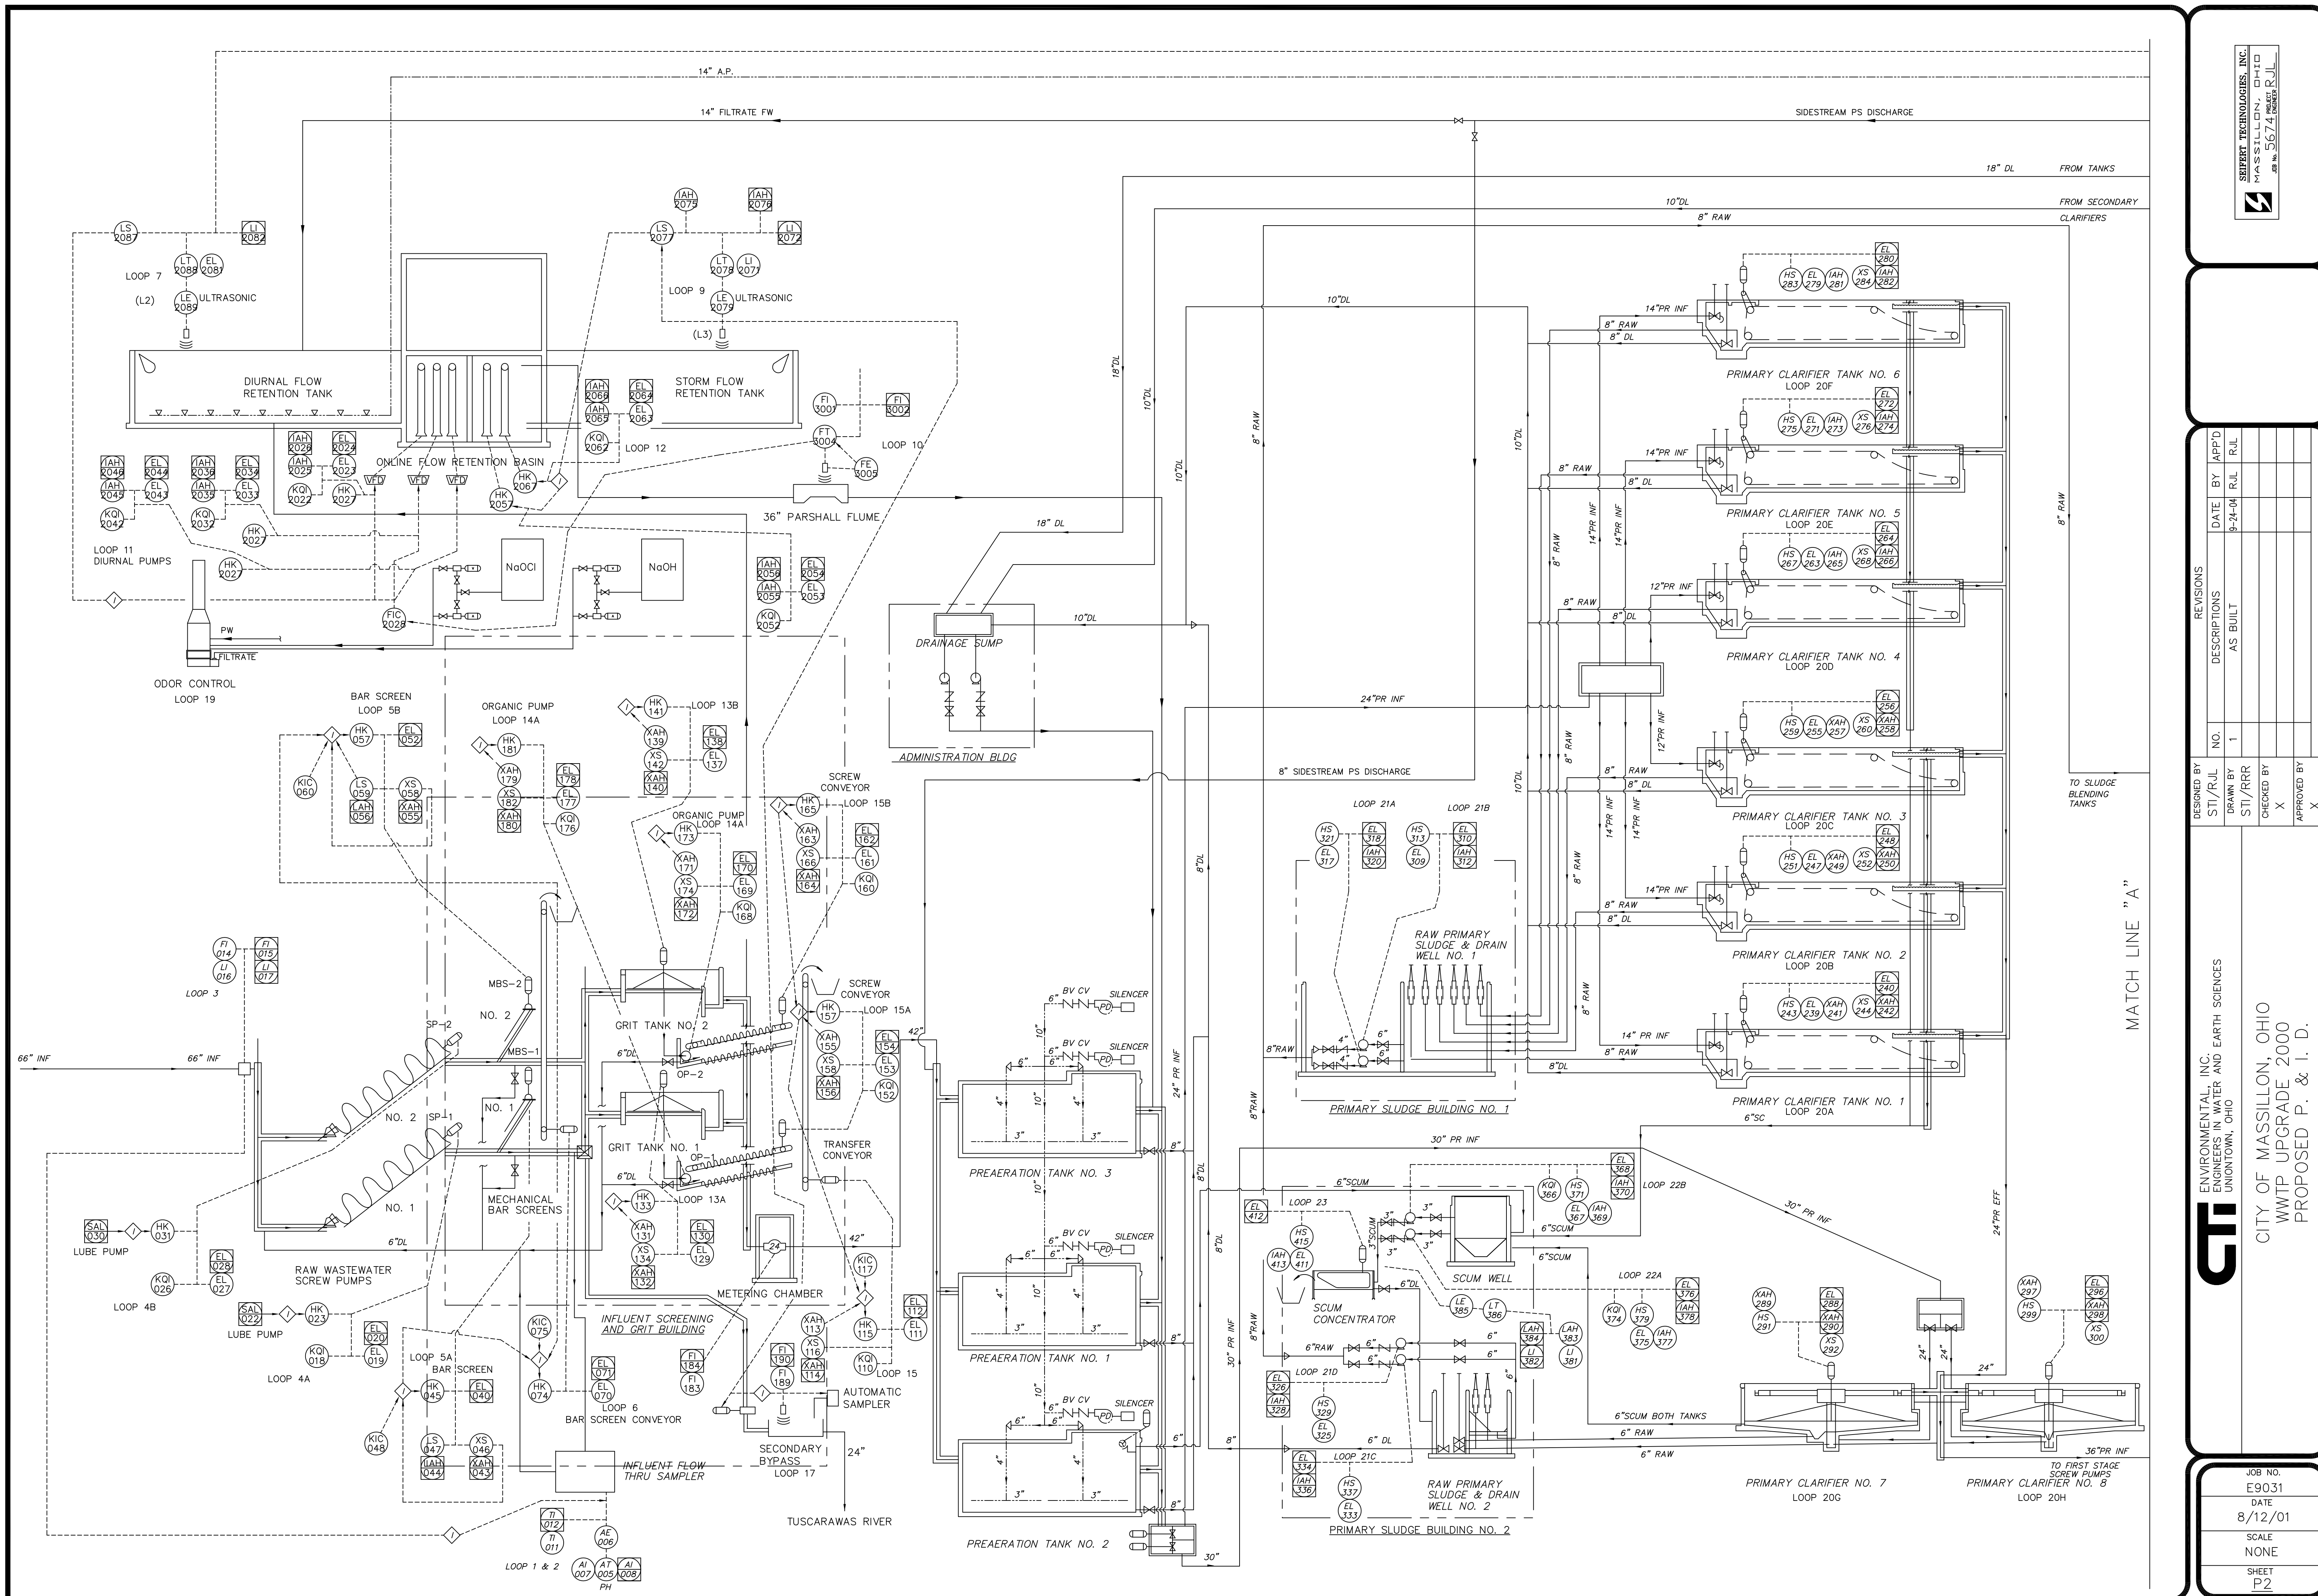

REVISIONS			
NO.	DESCRIPTIONS	DATE	BY
1	AS BUILT	9-24-04	R.J.L.
DESIGNED BY: STI/RJL			
DRAWN BY: STI/RRR			
CHECKED BY: X			
APPROVED BY: X			

ENVIRONMENTAL, INC.
ENGINEERS IN WATER AND EARTH SCIENCES
UNIONTOWN, OHIO



CITY OF MASSILLON, OHIO
WWTP UPGRADE 2000
PROPOSED P. & I. D.

JOB NO. E9031
DATE 8/12/01
SCALE NONE
SHEET P2