




SUPERT TECHNOLOGIES, INC.
MASSILLON, OHIO
JOB NO. 5674

DESIGNED BY		REVISIONS		BY		DATE	
STI/RJL		DESCRIPTIONS					
DRAWN BY	STI/RRR	AS BUILT				9-24-04	
CHECKED BY	X						
APPROVED BY	X						

ENVIRONMENTAL, INC.
ENGINEERS IN WATER AND EARTH SCIENCES
UNIONTOWN, OHIO

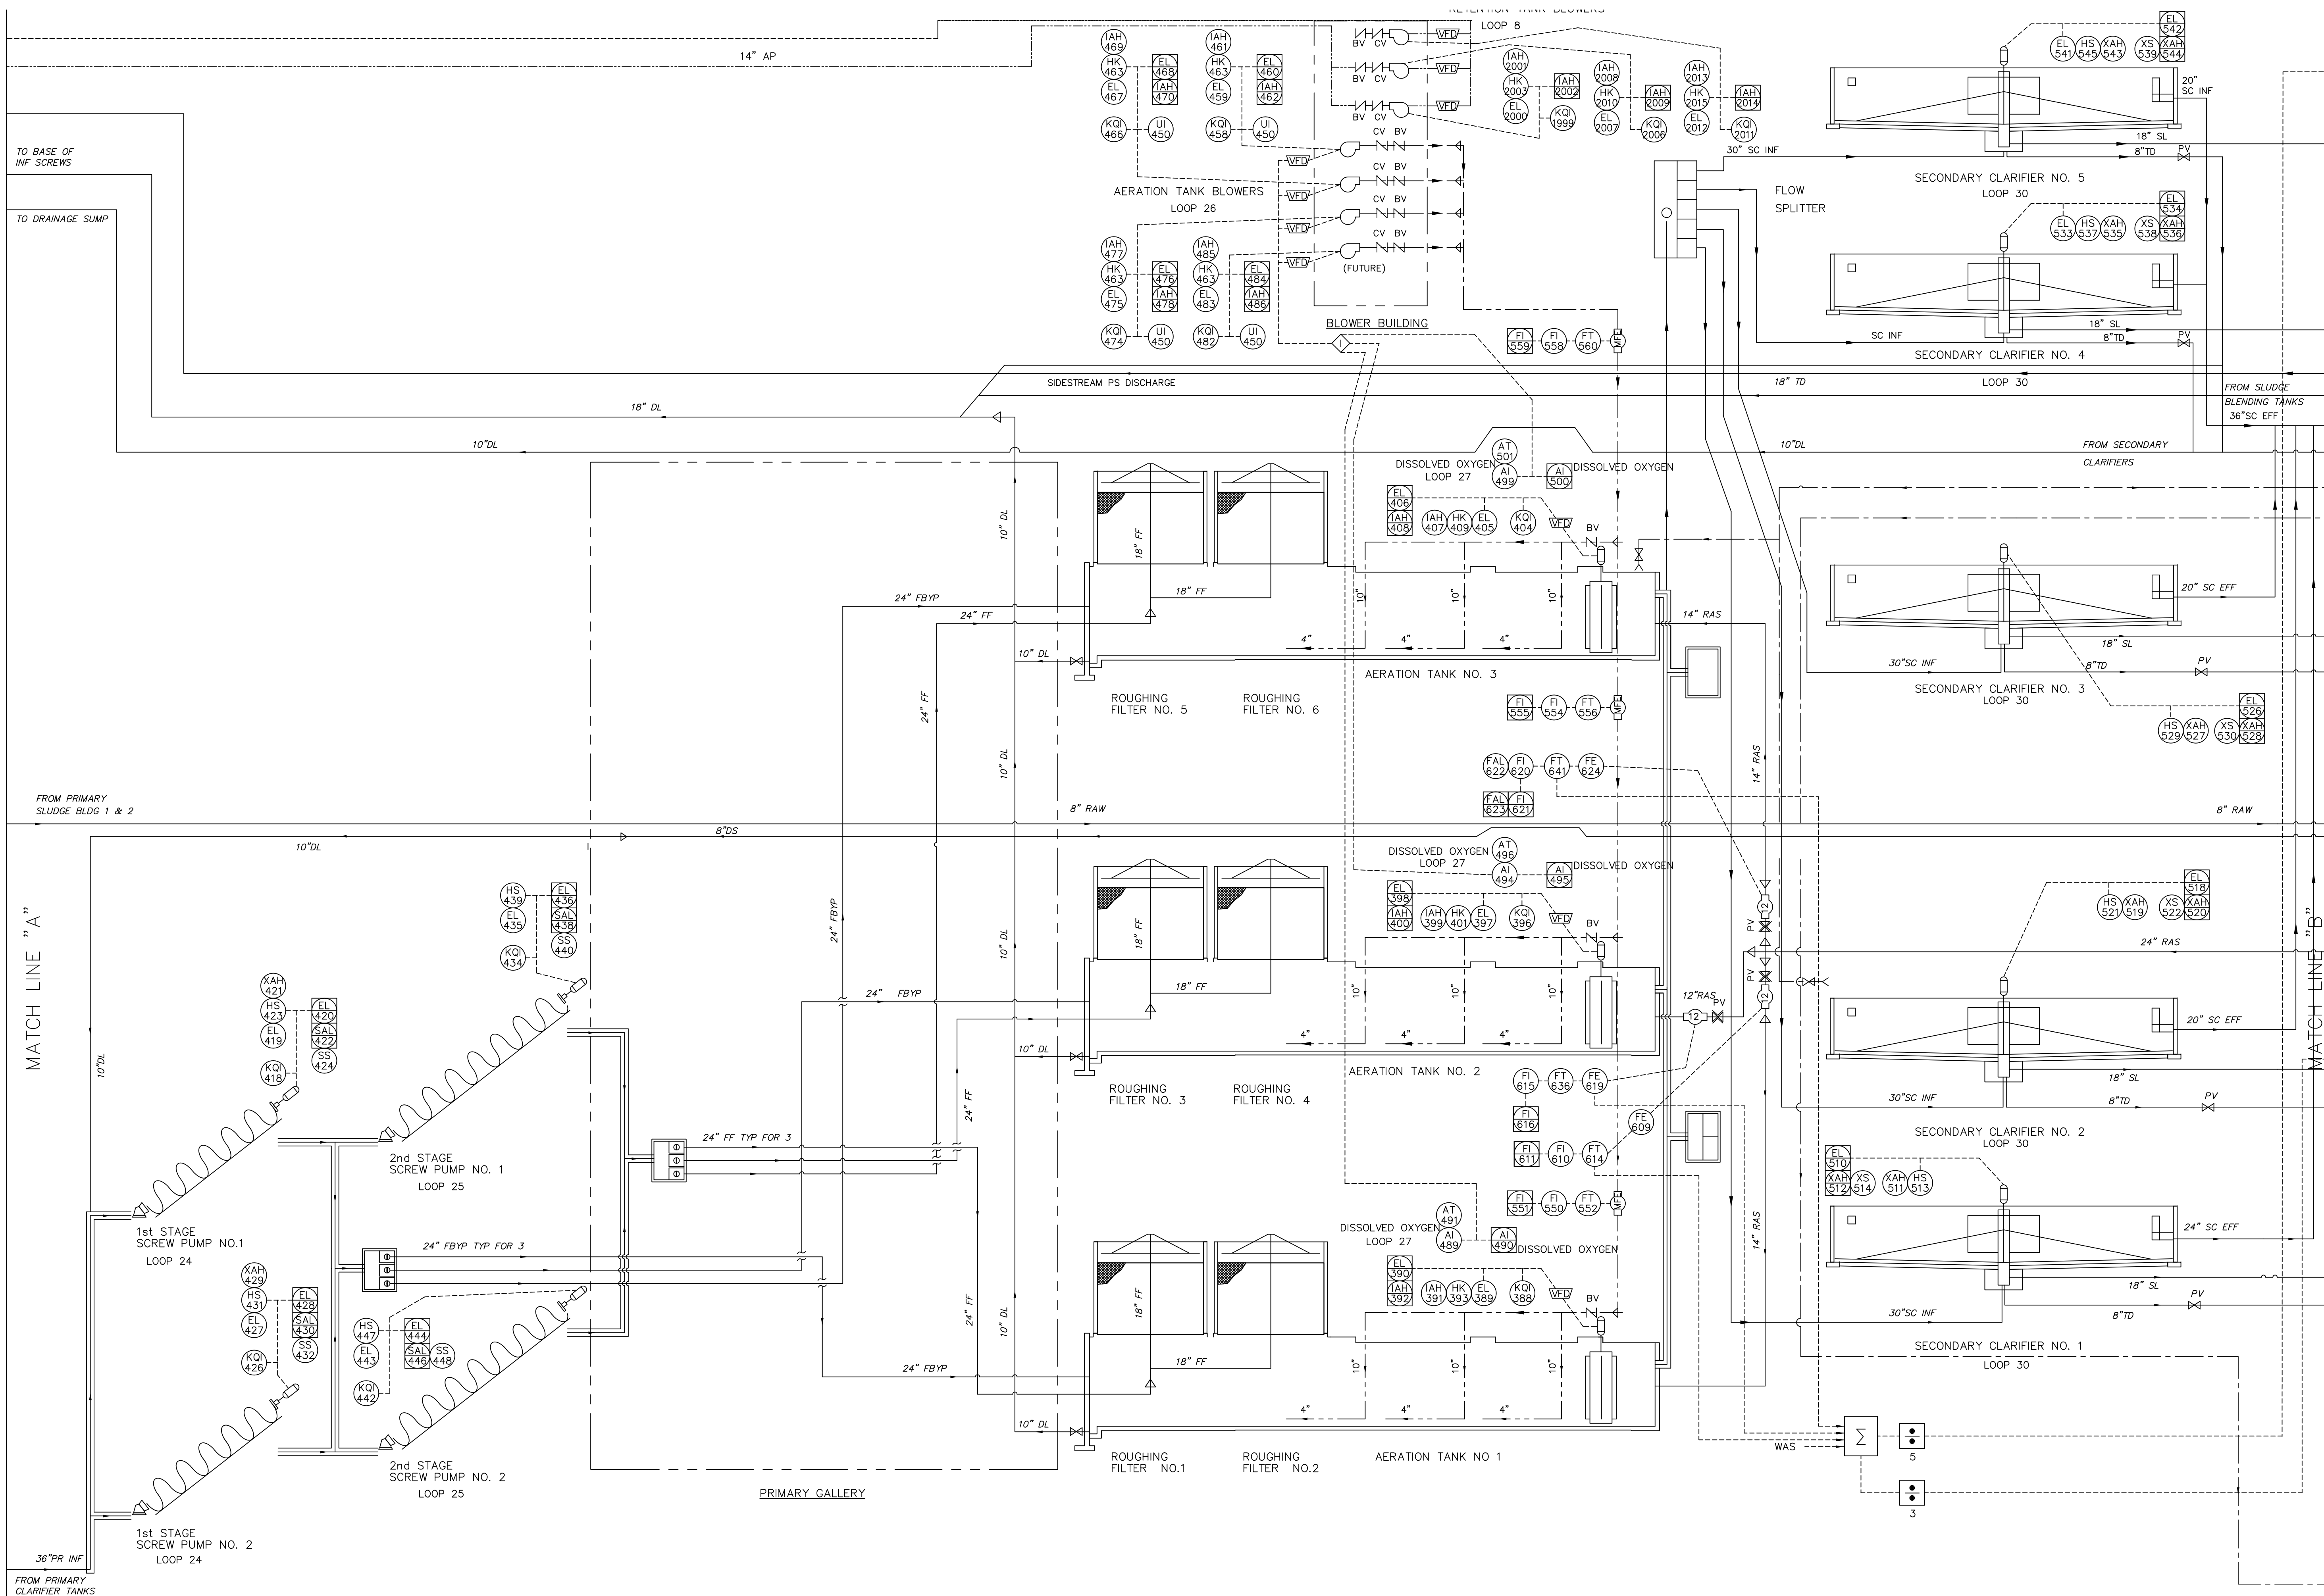

CITY OF MASSILLON, OHIO
WWT UPGRADE 2000
PROPOSED P. & I. D.

JOB NO.	E9031
DATE	8/12/01
SCALE	NONE
SHEET	P3