


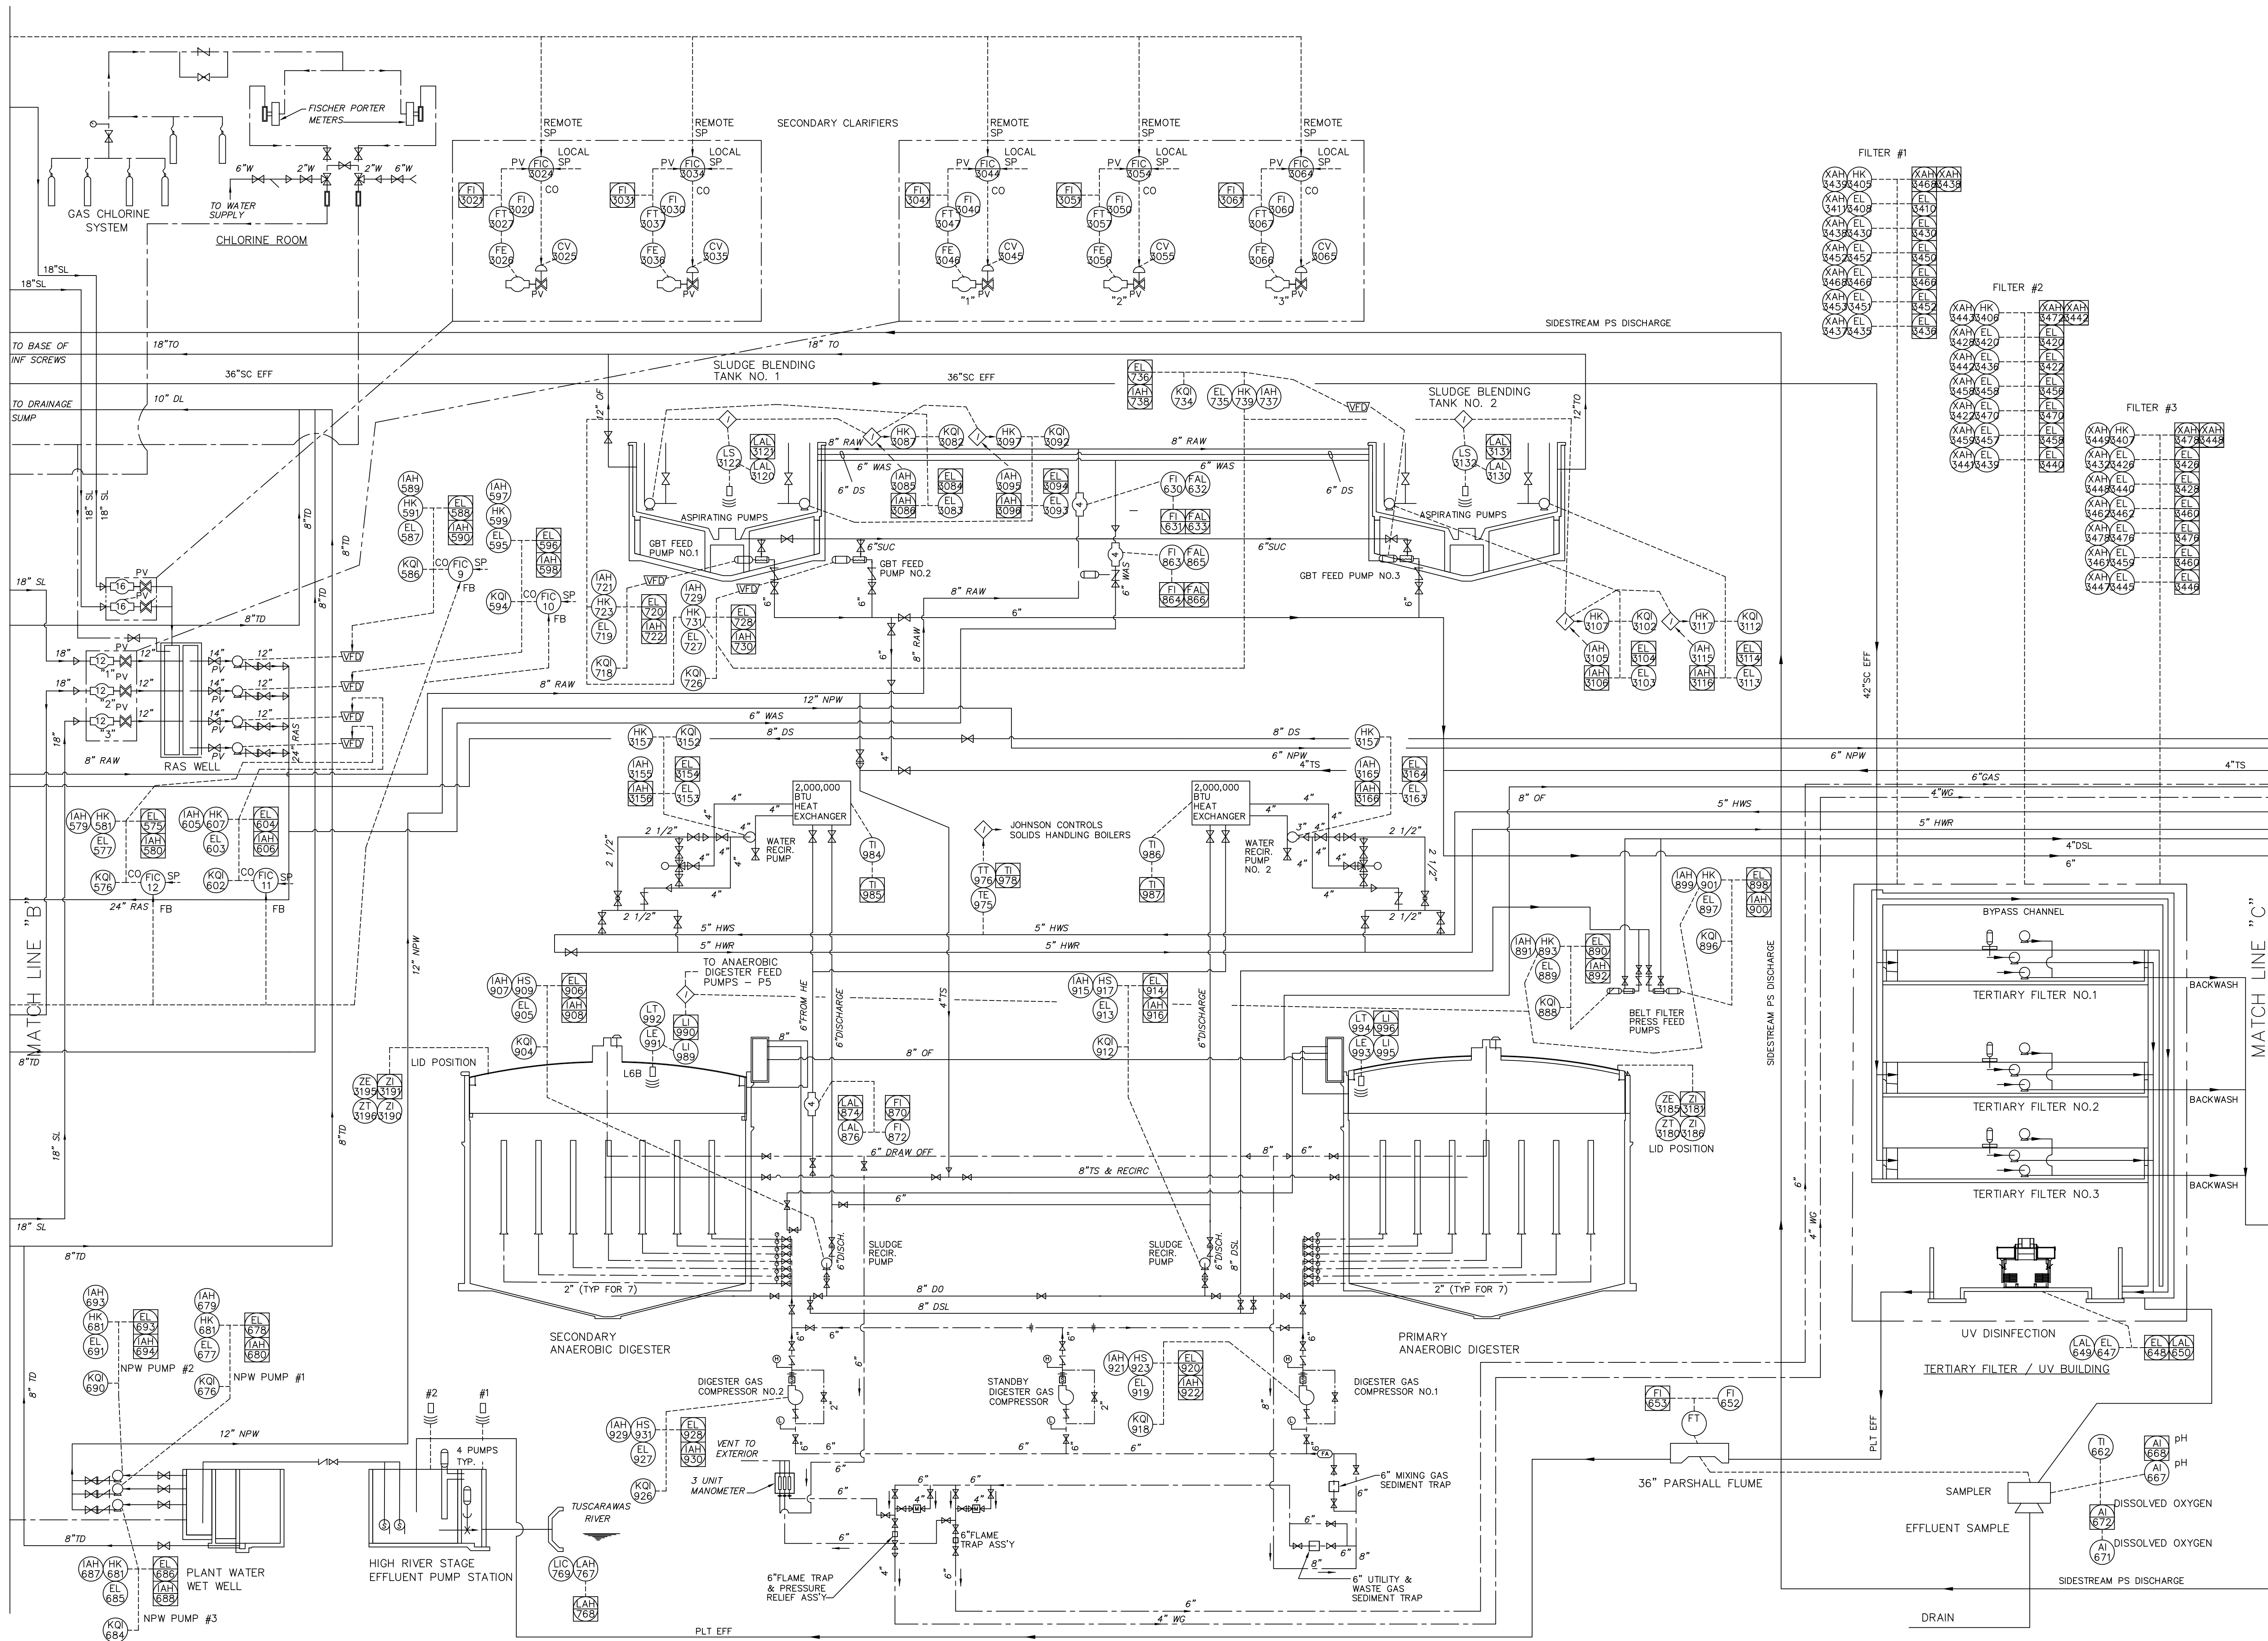

REVISIONS				
NO.	DESCRIPTIONS	DATE	BY	APP'D
1	AS BUILT	9-24-04	R.J.L.	

DESIGNED BY
STI/RJL

DRAWN BY
STI/RRR

CHECKED BY
X

APPROVED BY
X



ENVIRONMENTAL, INC.
ENGINEERS IN WATER AND EARTH SCIENCES
UNIONTOWN, OHIO

CITY OF MASSILLON, OHIO
WWTP UPGRADE 2000
PROPOSED P. & I. D.

JOB NO.
E9031

DATE
8/12/01

SCALE
NONE

SHEET
P4