


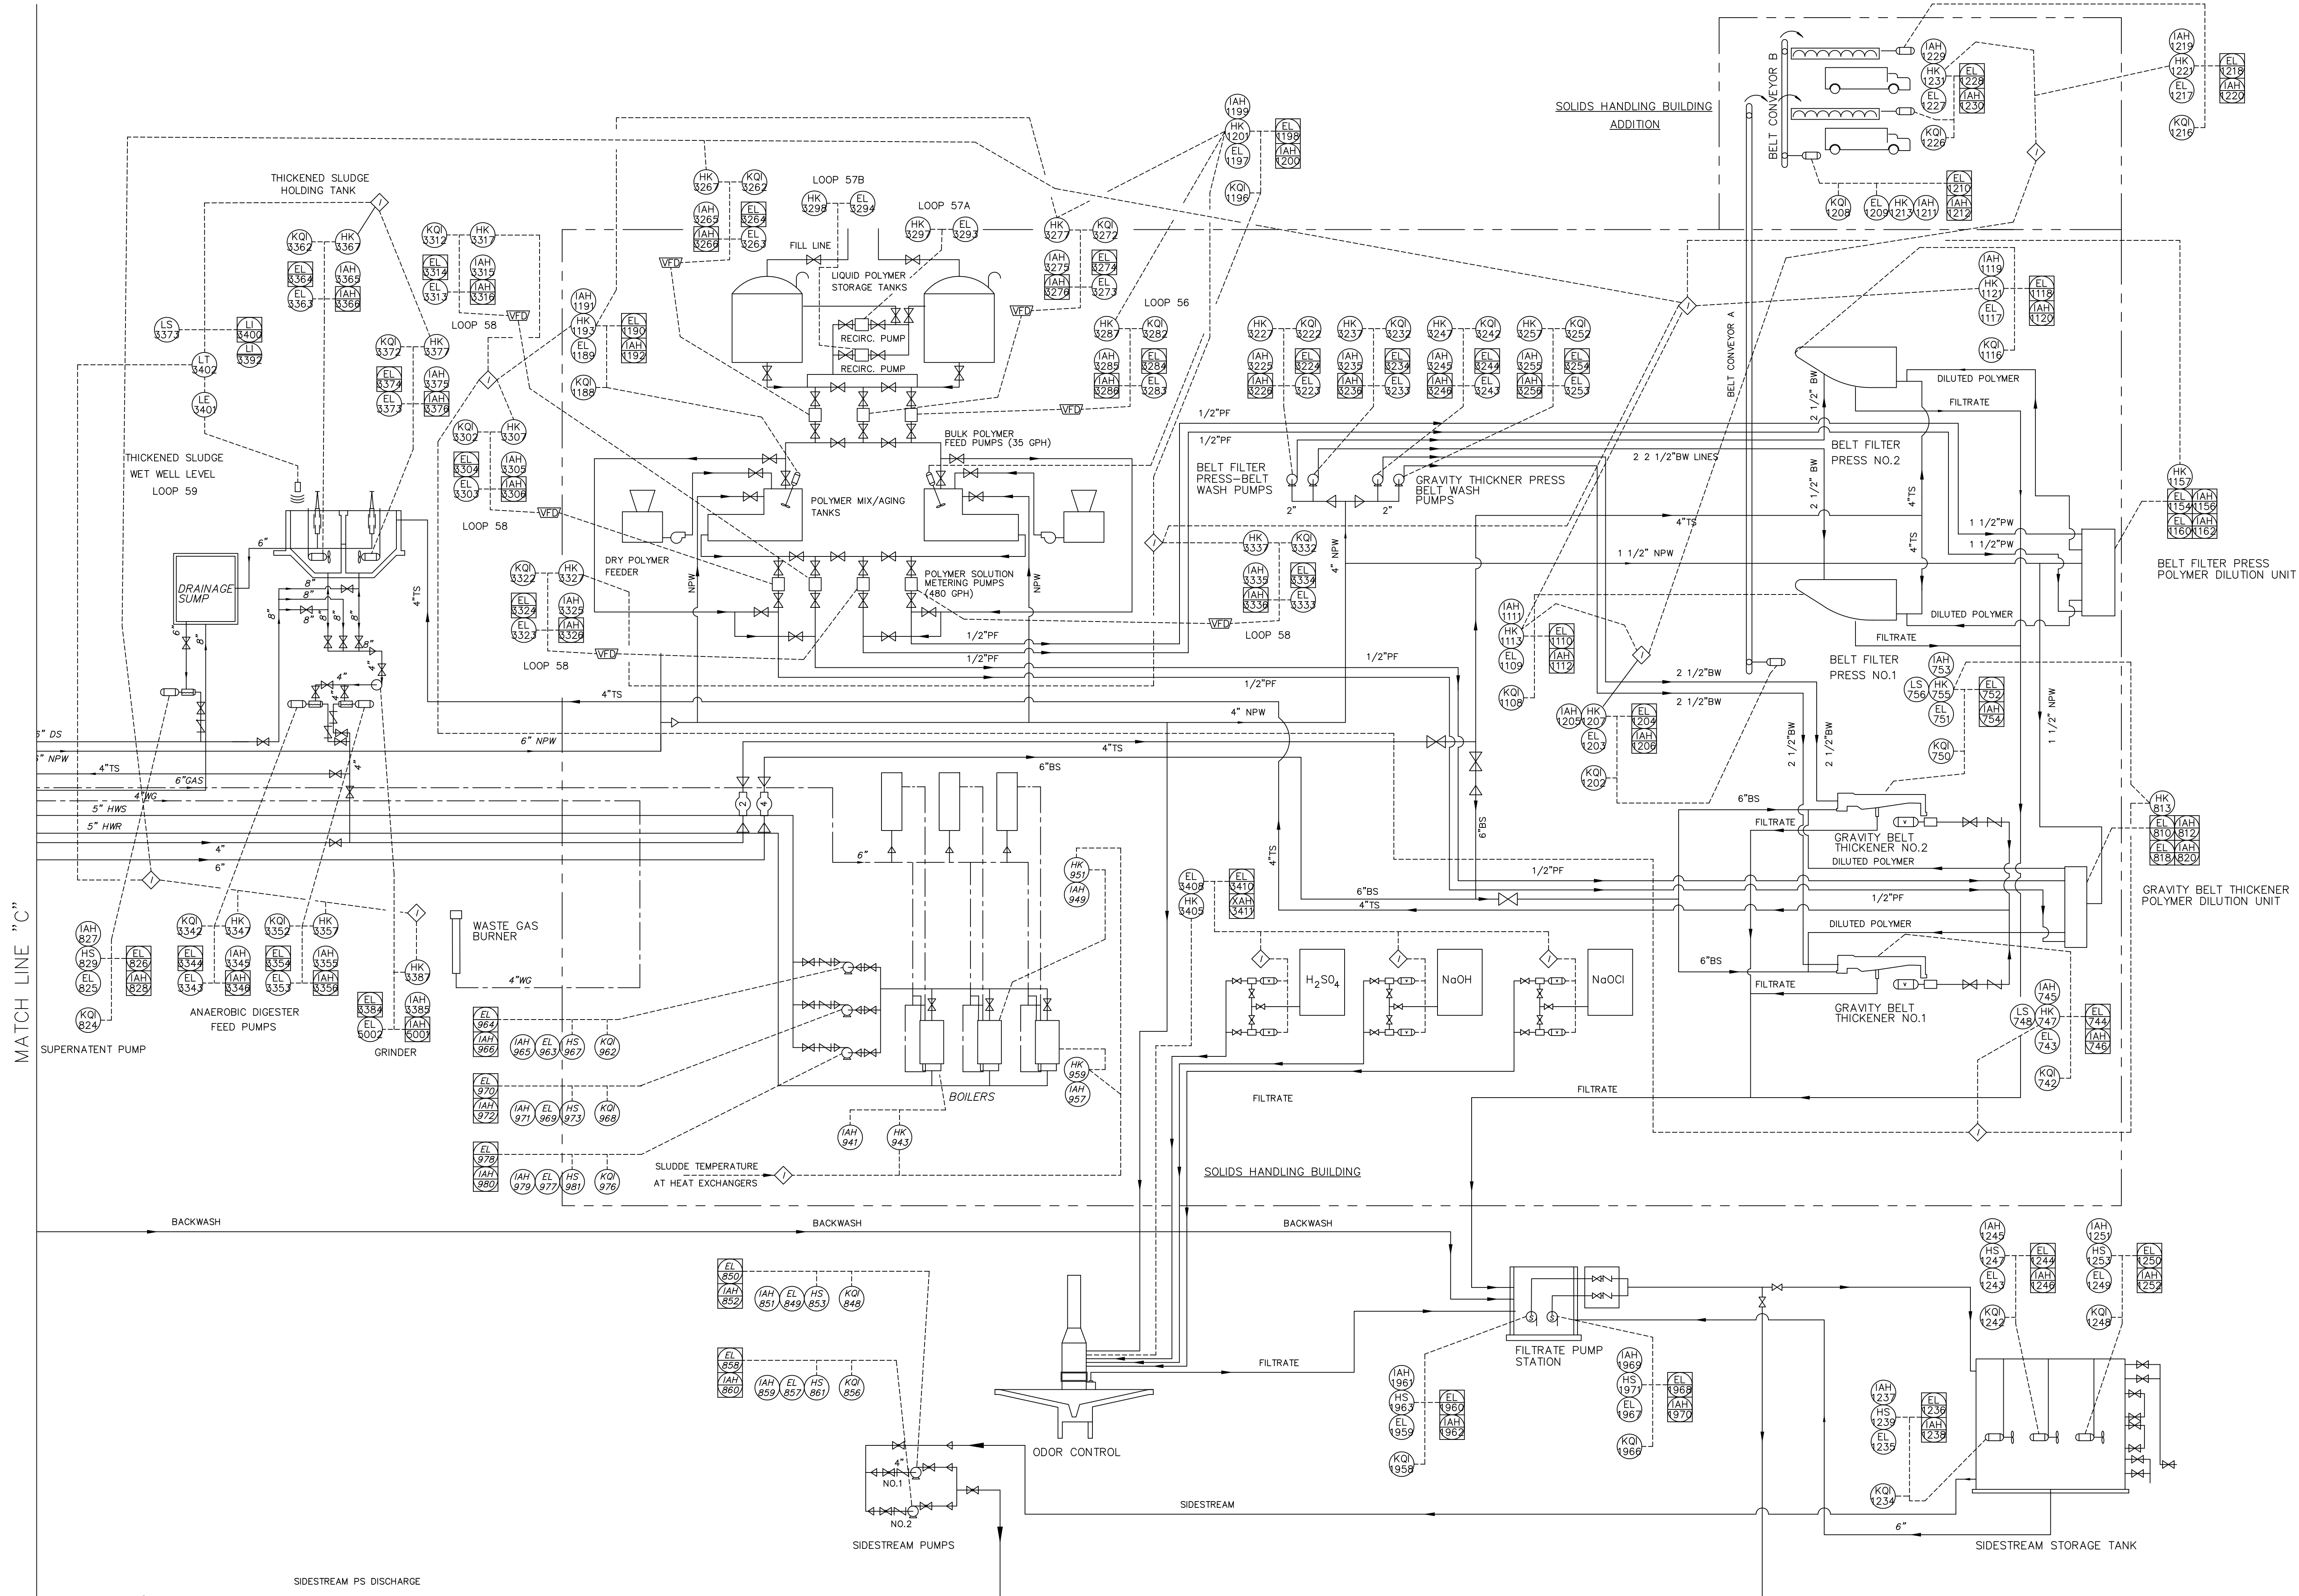

MATCH LINE "C"

SHUPERT TECHNOLOGIES, INC.
MASSILLON, OHIO
JOB NO. 5674
SHEET R.J.L.

REVISIONS			
NO.	DATE	BY	APP'D
1	9-24-04	R.J.L.	
DESCRIPTIONS			
AS BUILT			

DESIGNED BY
STI/RJL

DRAWN BY
STI/RRR

CHECKED BY
X

APPROVED BY
X



CITY OF MASSILLON, OHIO
WWTP UPGRADE 2000
PROPOSED P. & I. D.

JOB NO. E9031
DATE 8/12/01
SCALE NONE
SHEET P5