


1. SPOOL PIECE FOR INJECTION RING
2. TAPPING RING
3. TAPPING SLEEVE
4. TIED COUPLING
5. TAPPED BLIND FLANGE

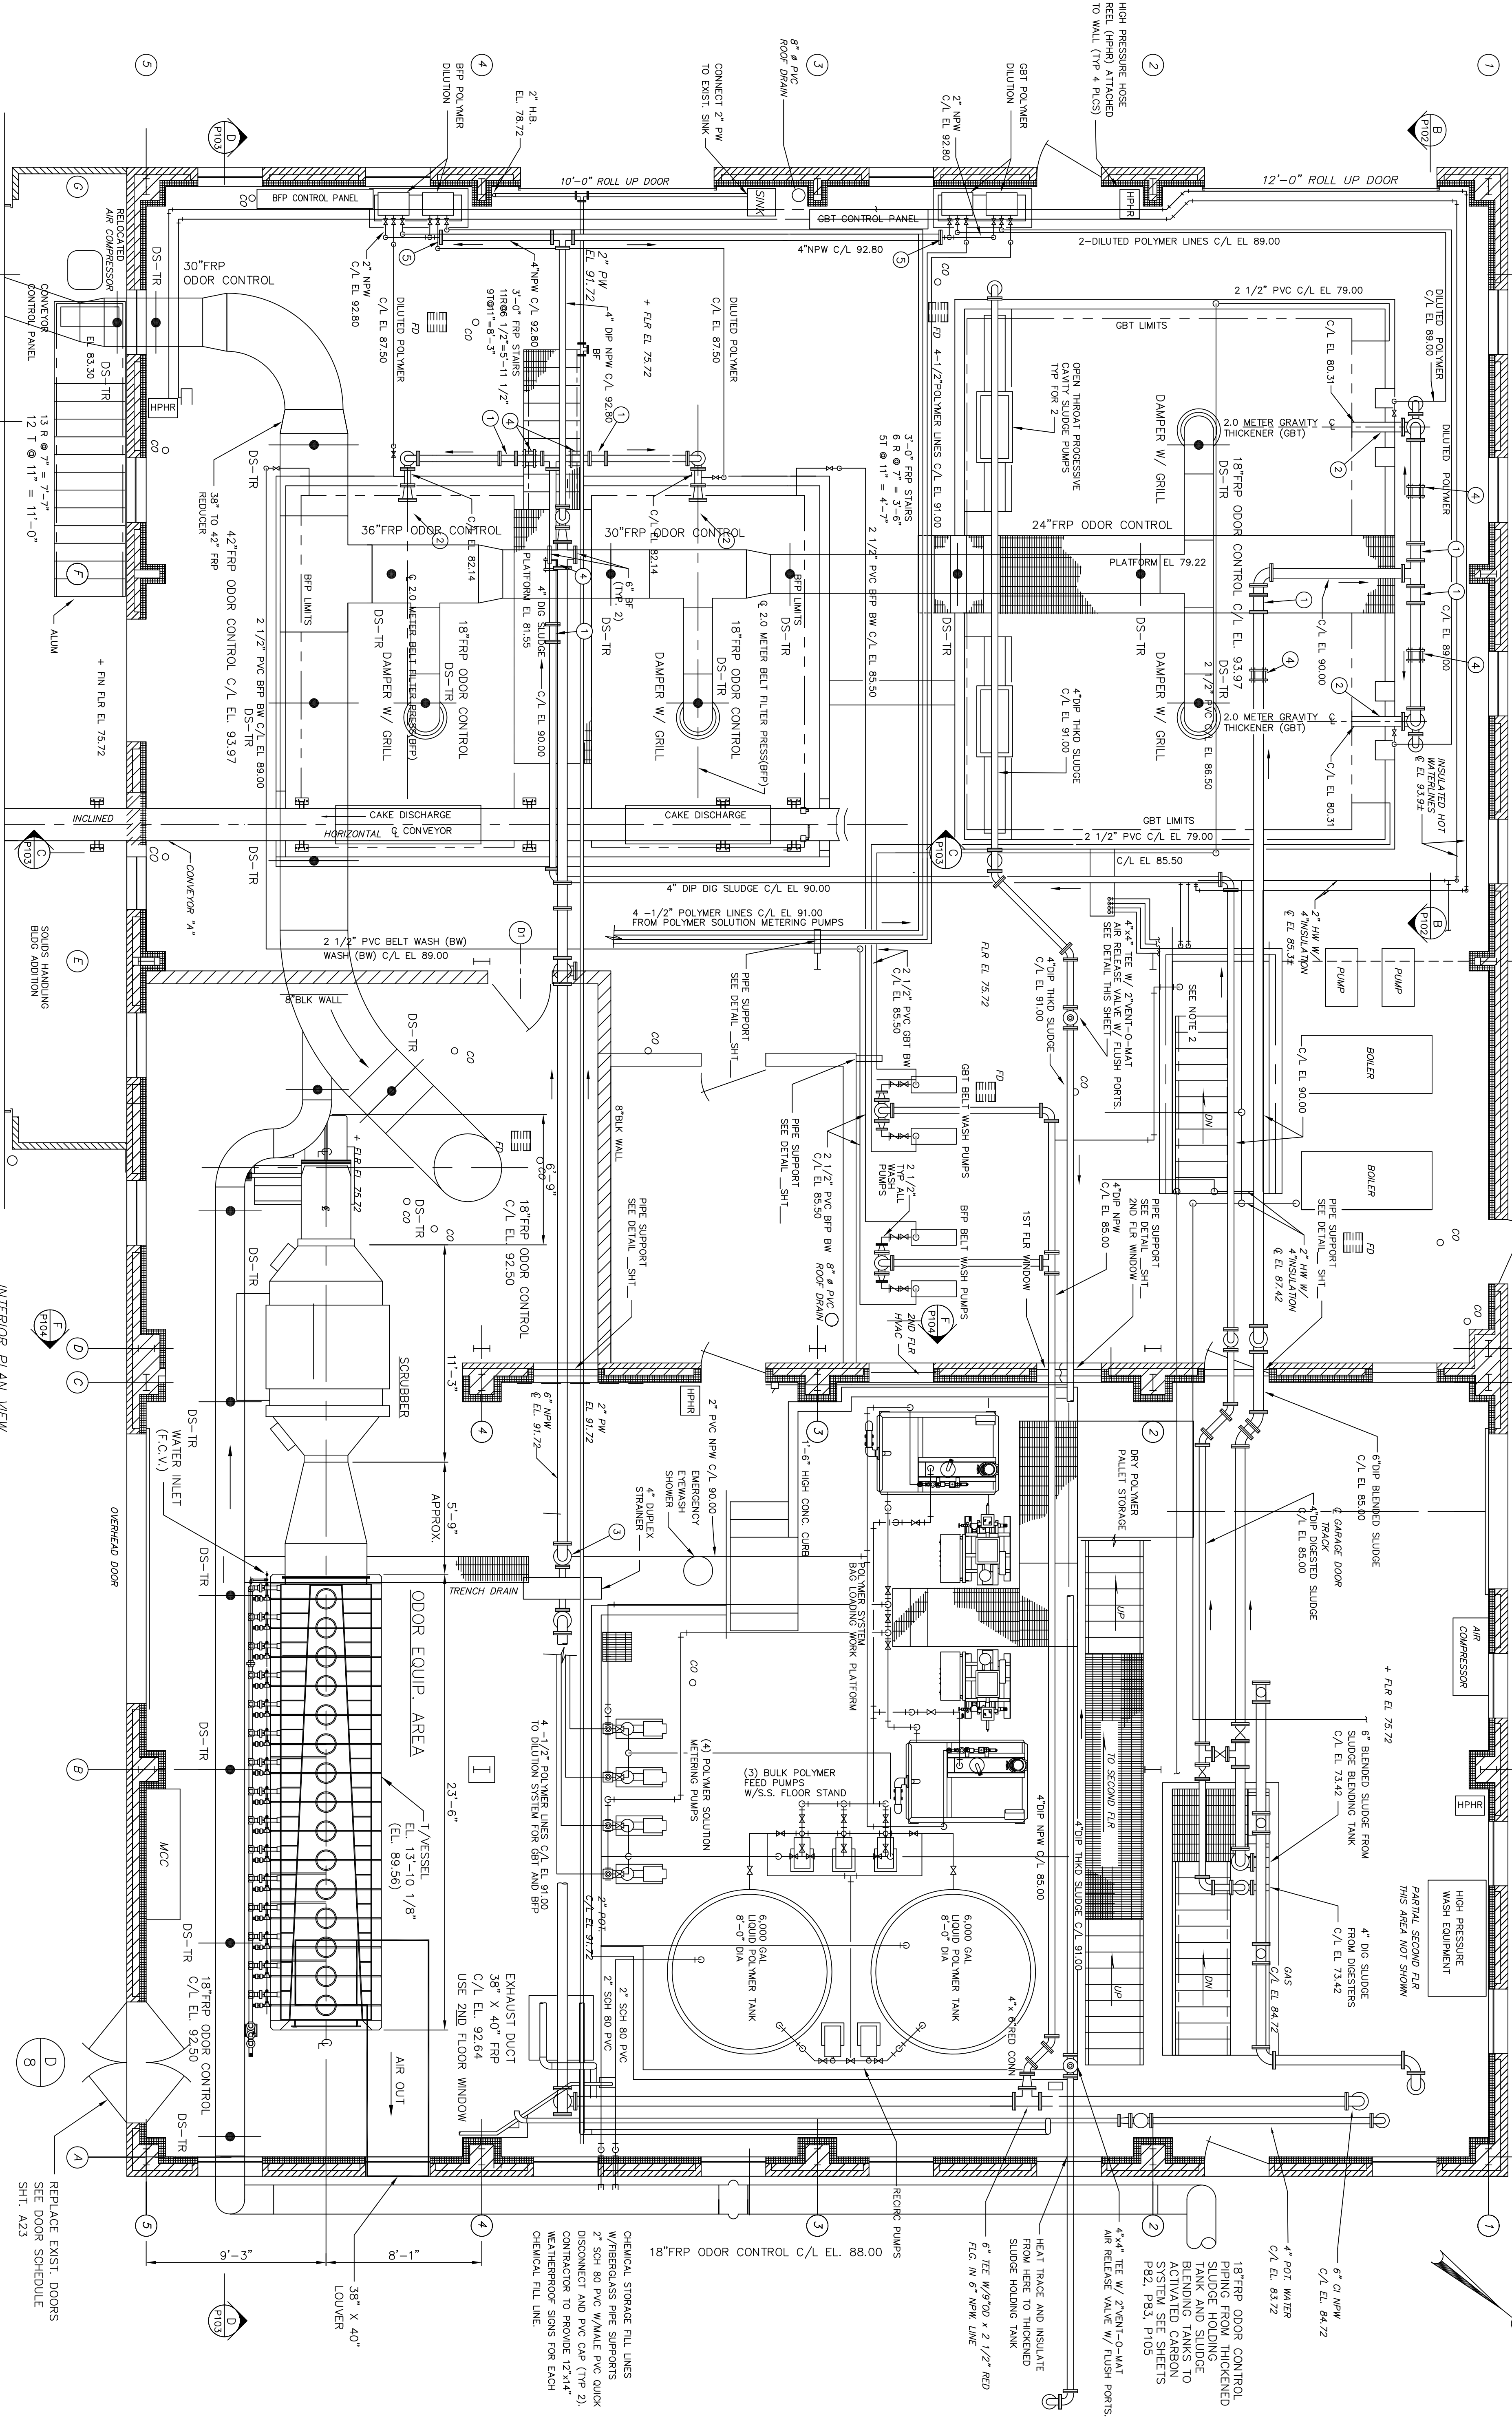

NOTES TO CONTRACTOR:
1. FOR GENERAL ODOR CONTROL NOTES 1 THRU 6 SEE SHEET P24.

2. FOR INSTALLATION OF DUCTWORK INSIDE EXISTING SOLIDS HANDLING FACILITIES BUILDING (SHOWN THIS SHEET), DUCT WORK SHOULD BE FITTED WITH SADDLE BANDS AT 8' TO 12' CENTERS, SUSPENDED WITH ALL THREAD ROD (DS-TR). DUCTWORK SHOULD ALSO BE SUSPENDED AT EACH CHANGE IN DIRECTION. CONTRACTOR IS REQUIRED TO DETERMINE SIZE OF SADDLE BANDS AND ALL THREAD ROD. PER DUCT MANUFACTURERS REQUIREMENTS. DUCTWORK IS TO BE SUSPENDED FROM CEILING "I" BEAMS WHERE POSSIBLE, OTHERWISE FROM PRE CAST ROOF SLAB.

3. CONTRACTOR SHALL FURNISH AND INSTALL FIXED LOUVER AT DISCHARGE OF ODOR EQUIPMENT

THESE RECORD DOCUMENTS HAVE BEEN PREPARED BASED ON INFORMATION PROVIDED BY OTHERS. CTI ENVIRONMENTAL HAS REVIEWED THE INFORMATION SUBMITTED AND BELIEVES IT REFLECTS THE WORK AS CONSTRUCTED. HOWEVER, ALL PERSONS SHALL VERIFY INFORMATION TAKEN FROM THIS DRAWING.



ENVIRONMENTAL, INC.
ENGINEERS IN WATER AND EARTH SCIENCES
UNIONTOWN, OHIO

CITY OF MASSILLON, OHIO
WWTP UPGRADE 2000
ODOR CONTROL SOLIDS HANDLING FACILITIES – PLAN

DESIGNED BY WAD	NO.	REVISIONS				DATE	BY	APP'D
DRAWN BY TGL	1	RECORD DRAWING				5/05	MGW	WAD
CHECKED BY WAD								
APPROVED BY WAD								

JOB NO.
E9031

DATE
08/13/01

SCALE
1/4"=1'-0"

SHEET
P100

THIS DRAWING IS AN INSTRUMENT OF SERVICE OWNED BY CTI ENVIRONMENTAL, INC. WHICH SHALL BE DEEMED THE AUTHOR AND WHICH SHALL RETAIN ALL STATUTORY AND COMMON LAW RIGHTS, INCLUDING COPYRIGHTS. THIS DRAWING SHALL NOT BE SCANNED, COPIED, OR DISTRIBUTED TO OTHERS IN ANY FORM OR USED FOR ANY OTHER PURPOSE OR PROJECT WITHOUT PRIOR WRITTEN CONSENT OF CTI ENVIRONMENTAL, INC. CTI ENVIRONMENTAL, INC. CANNOT GUARANTEE THAT ELECTRONIC COPIES OF THIS DRAWING ARE EXACT DUPLICATES OF THE SEALED ORIGINAL DRAWING. IN THE EVENT OF A CONFLICT BETWEEN AN ELECTRONIC COPY AND THE SEALED ORIGINAL, THE SEALED ORIGINAL SHALL GOVERN.