



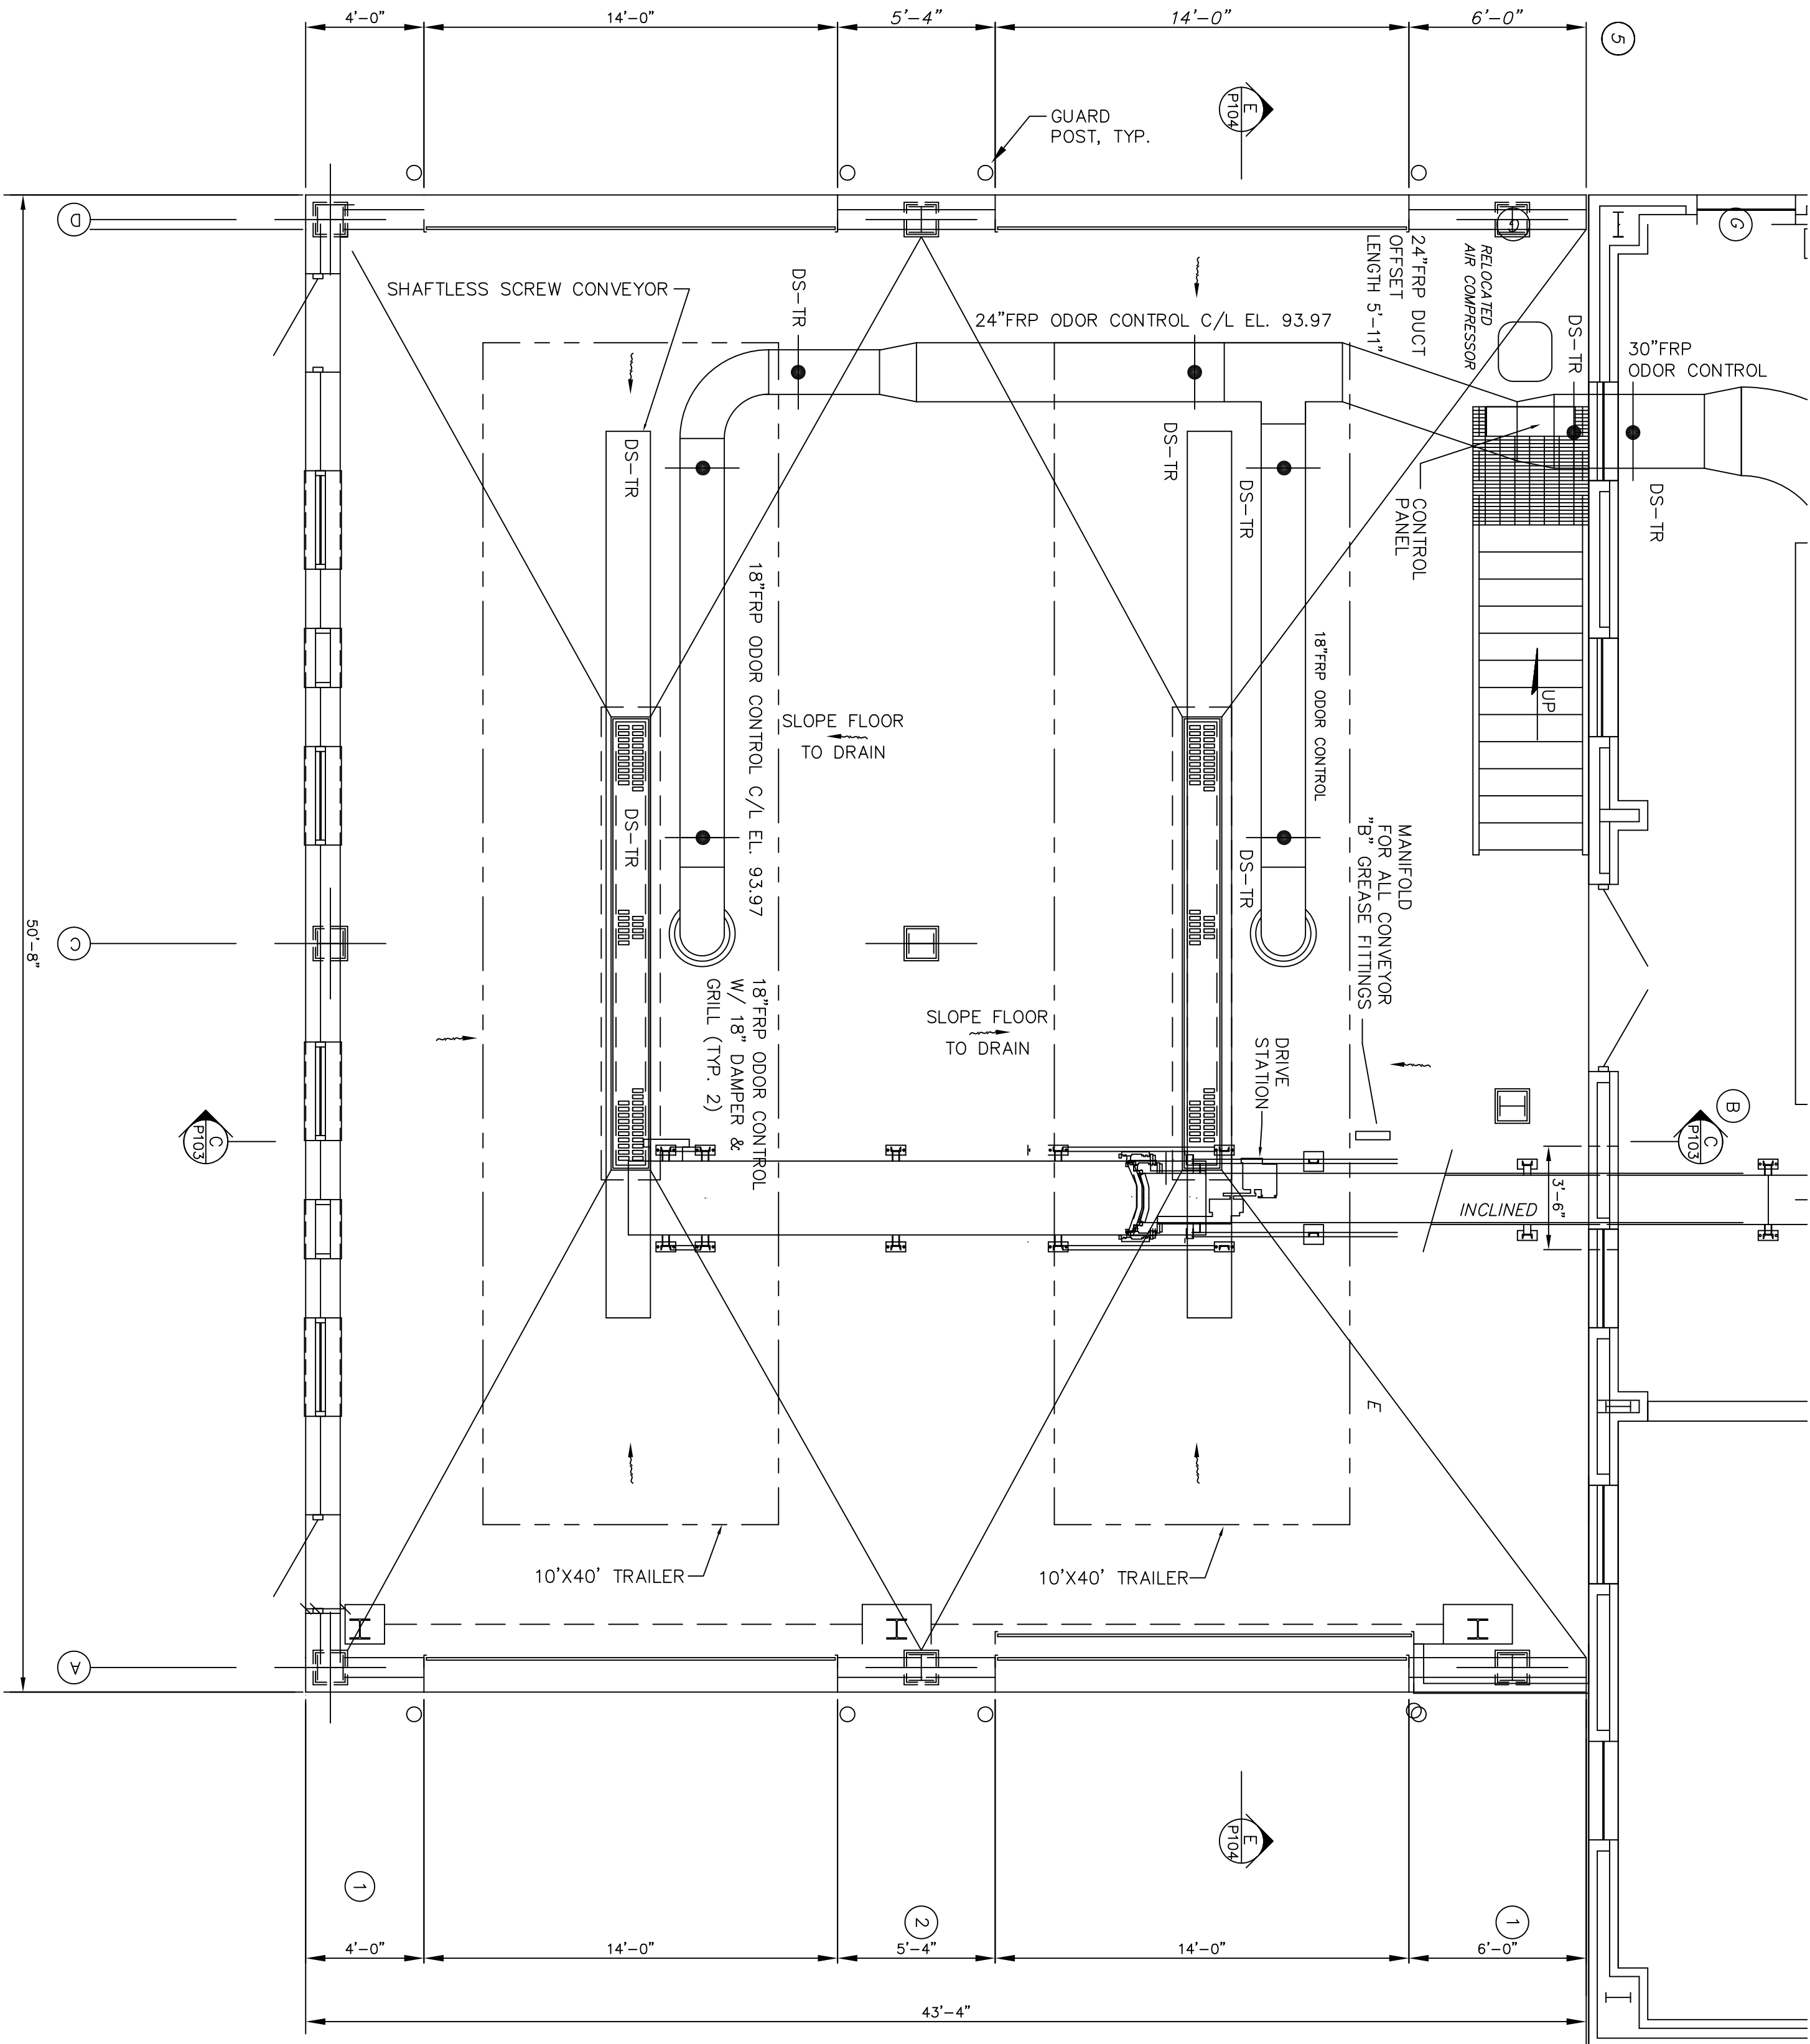

- NOTES TO CONTRACTOR:
1. FOR GENERAL ODOR CONTROL NOTES 1 THRU 6 SEE SHEET P24.
 2. FOR INSTALLATION OF DUCTWORK INSIDE NEW ADDITION OF SOLIDS HANDLING FACILITIES (SHOWN THIS SHEET), DUCT WORK SHOULD BE FITTED WITH SADDLE BANDS AT 8' TO 12' CENTERS, SUSPENDED WITH ALL THREAD ROD (DS-TR). DUCTWORK SHOULD ALSO BE SUSPENDED AT EACH CHANGE IN DIRECTION. CONTRACTOR IS REQUIRED TO DETERMINE SIZE OF SADDLE BANDS AND ALL THREAD ROD, PER DUCT MANUFACTURES REQUIREMENTS. DUCTWORK IS TO BE SUSPENDED FROM PRE CAST ROOF SLAB.

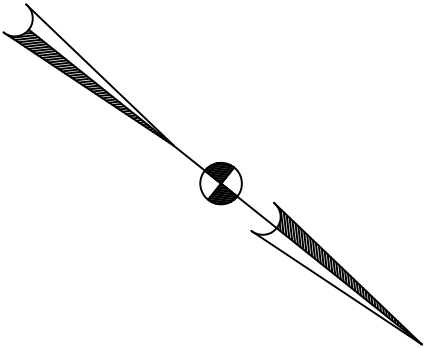

ENVIRONMENTAL, INC.
ENGINEERS IN WATER AND EARTH SCIENCES
UNIONTOWN, OHIO

CITY OF MASSILLON, OHIO
WWTP UPGRADE 2000
ODOR CONTROL SOLIDS HANDLING FACILITIES ADDITION – PLAN

DESIGNED BY	REVISIONS				
	NO.	DESCRIPTIONS	DATE	BY	APP'D
WAD	1	RECORD DRAWING	5/05	MGW	WAD
DRAWN BY					
TGL					
CHECKED BY					
WAD					
APPROVED BY					
WAD					

THIS DRAWING IS AN INSTRUMENT OF SERVICE OWNED BY CTI ENVIRONMENTAL, INC. WHICH SHALL BE DEEMED THE AUTHOR AND WHICH SHALL RETAIN ALL STATUTORY AND COMMON LAW RIGHTS, INCLUDING COPYRIGHTS. THIS DRAWING SHALL NOT BE SCANNED, COPIED, OR DISTRIBUTED TO OTHERS IN ANY FORM OR USED FOR ANY OTHER PURPOSE OR PROJECT WITHOUT PRIOR WRITTEN CONSENT OF CTI ENVIRONMENTAL, INC. CTI ENVIRONMENTAL, INC. CANNOT GUARANTEE THAT ELECTRONIC COPIES OF THIS DRAWING ARE EXACT DUPLICATES OF THE SEALED ORIGINAL DRAWING. IN THE EVENT OF A CONFLICT BETWEEN AN ELECTRONIC COPY AND THE SEALED ORIGINAL THE SEALED ORIGINAL SHALL GOVERN.

THESE RECORD DOCUMENTS HAVE BEEN PREPARED BASED ON INFORMATION PROVIDED BY OTHERS. CTI ENVIRONMENTAL HAS REVIEWED THE INFORMATION SUBMITTED AND BELIEVES IT REFLECTS THE WORK AS CONSTRUCTED. HOWEVER, ALL PERSONS SHALL VERIFY INFORMATION TAKEN FROM THIS DRAWING.

JOB NO.
E9031

DATE
08/13/01

SCALE
1/4"=1'-0"

SHEET
P101