
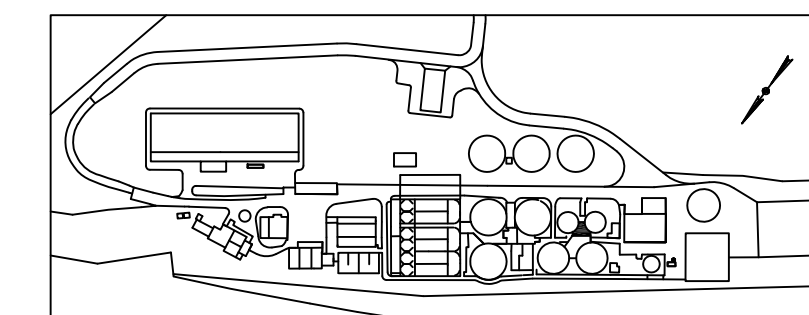
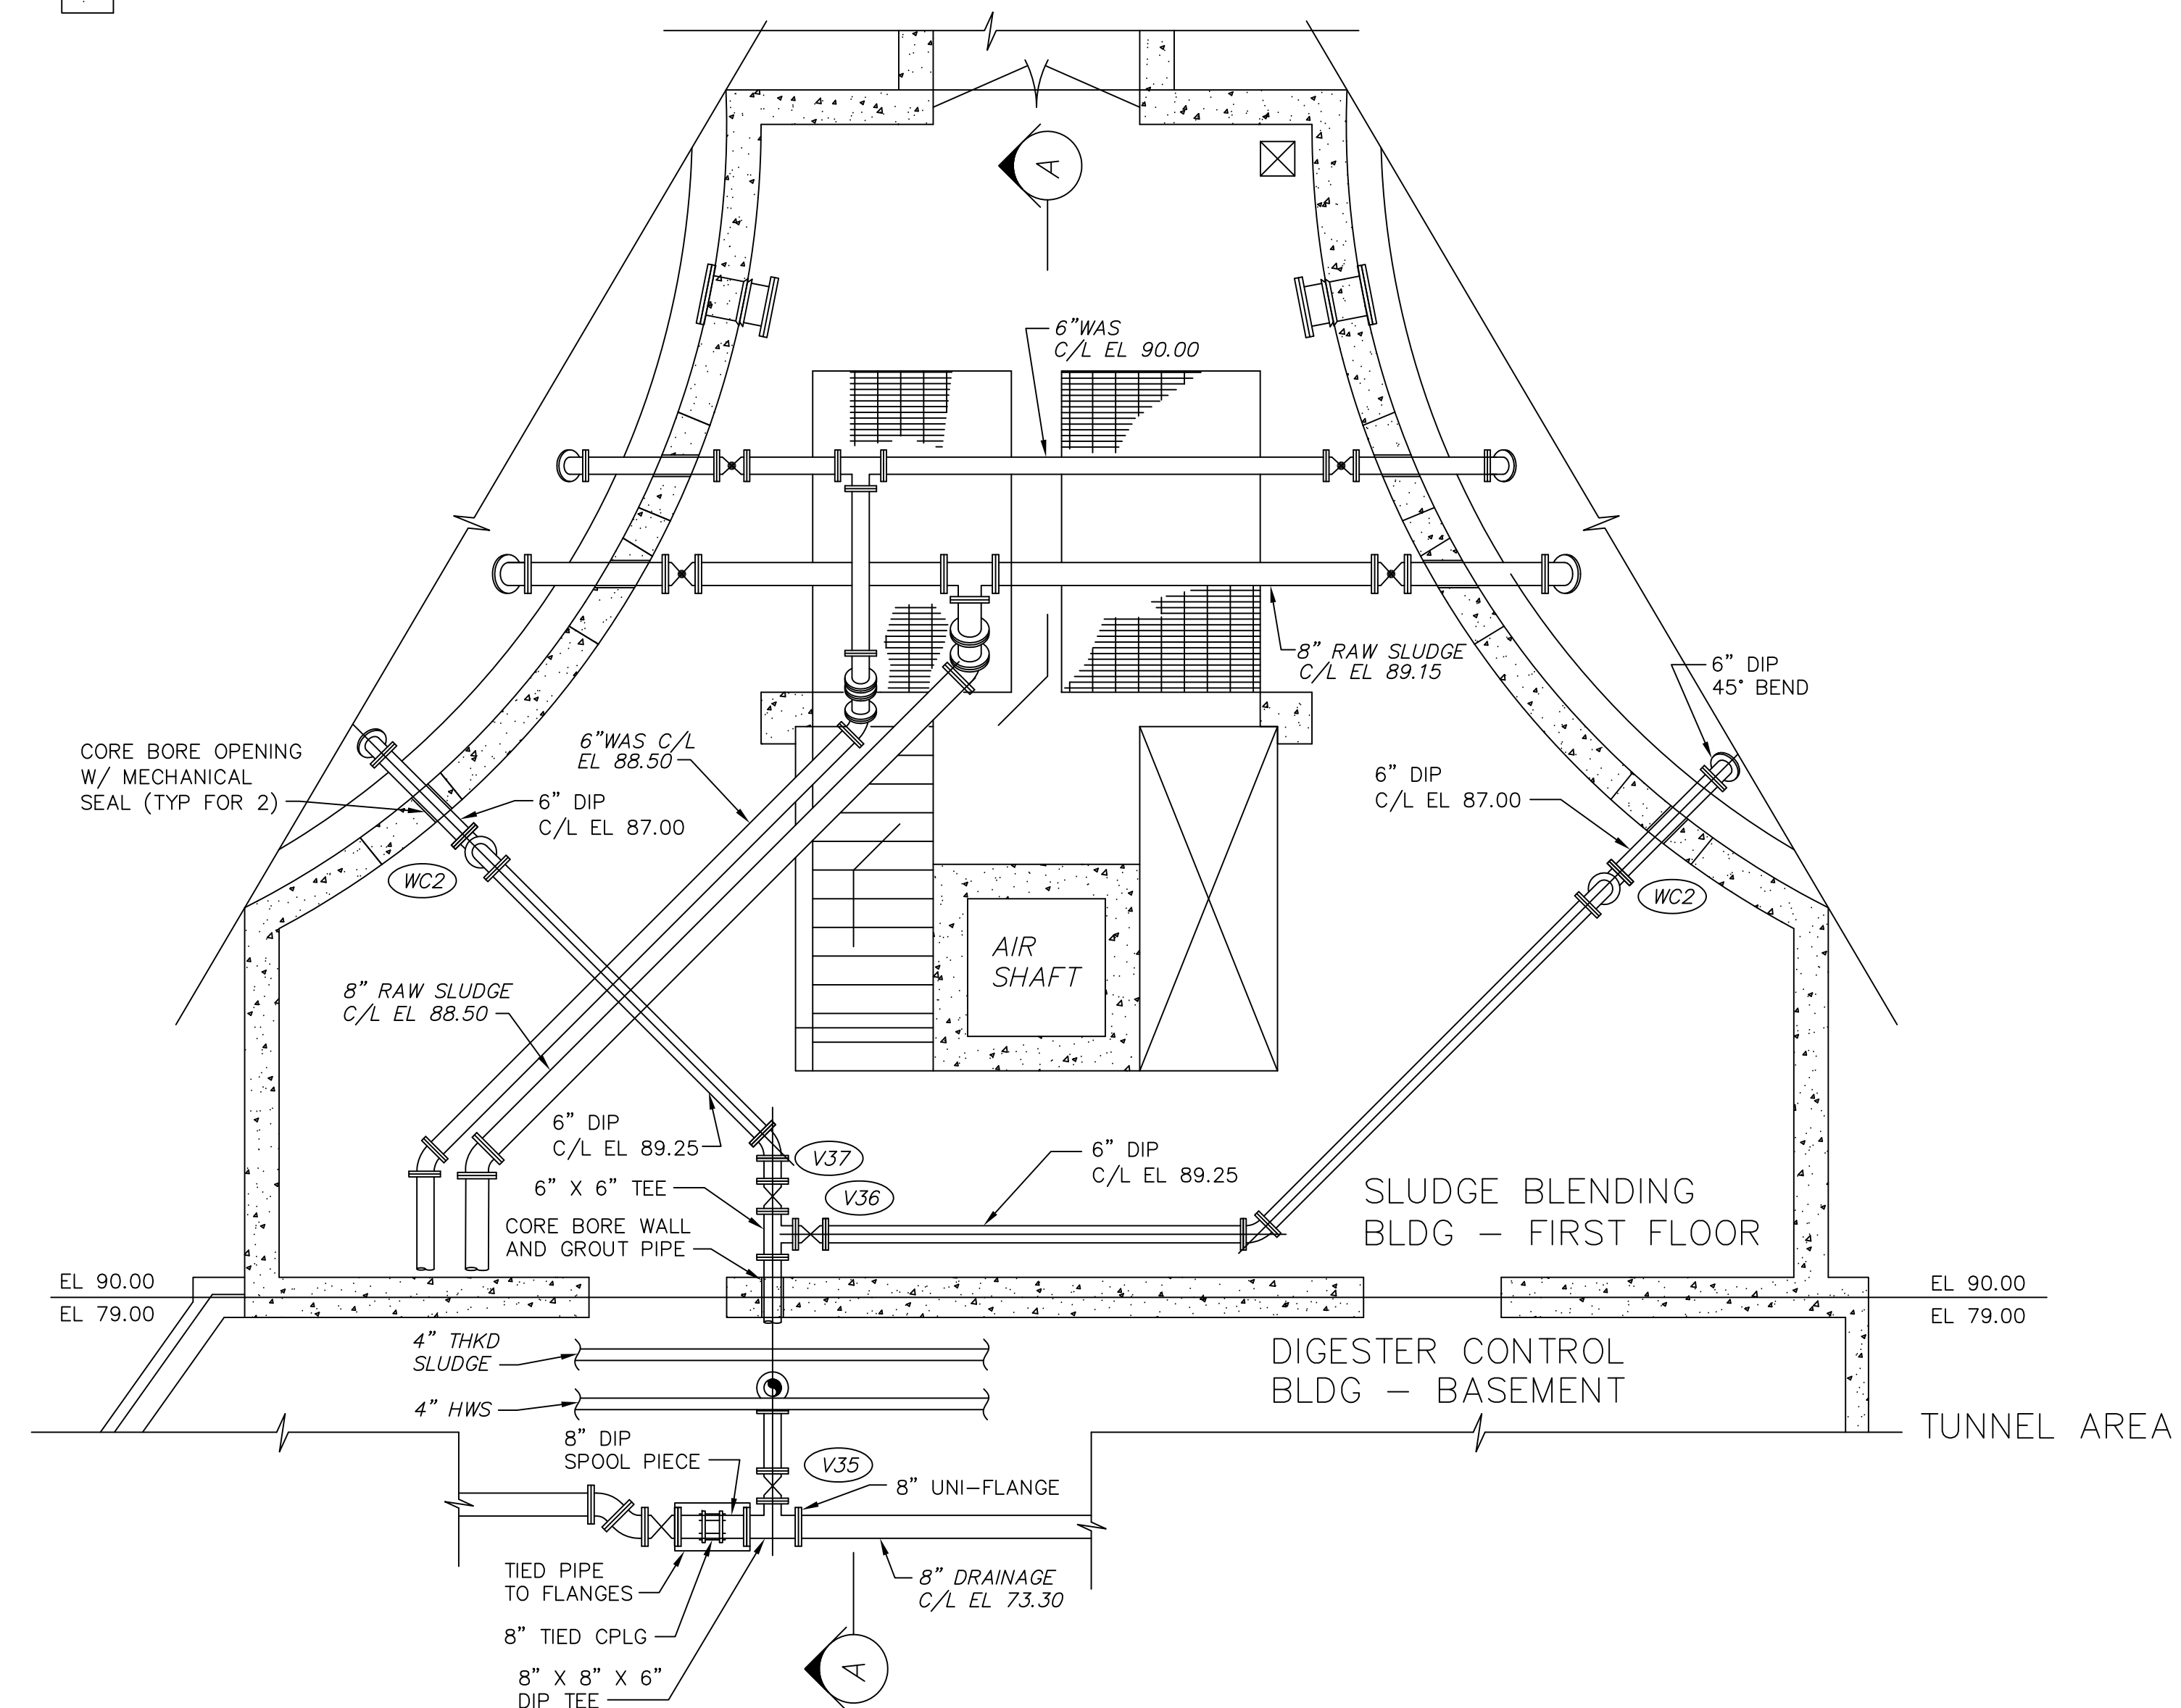


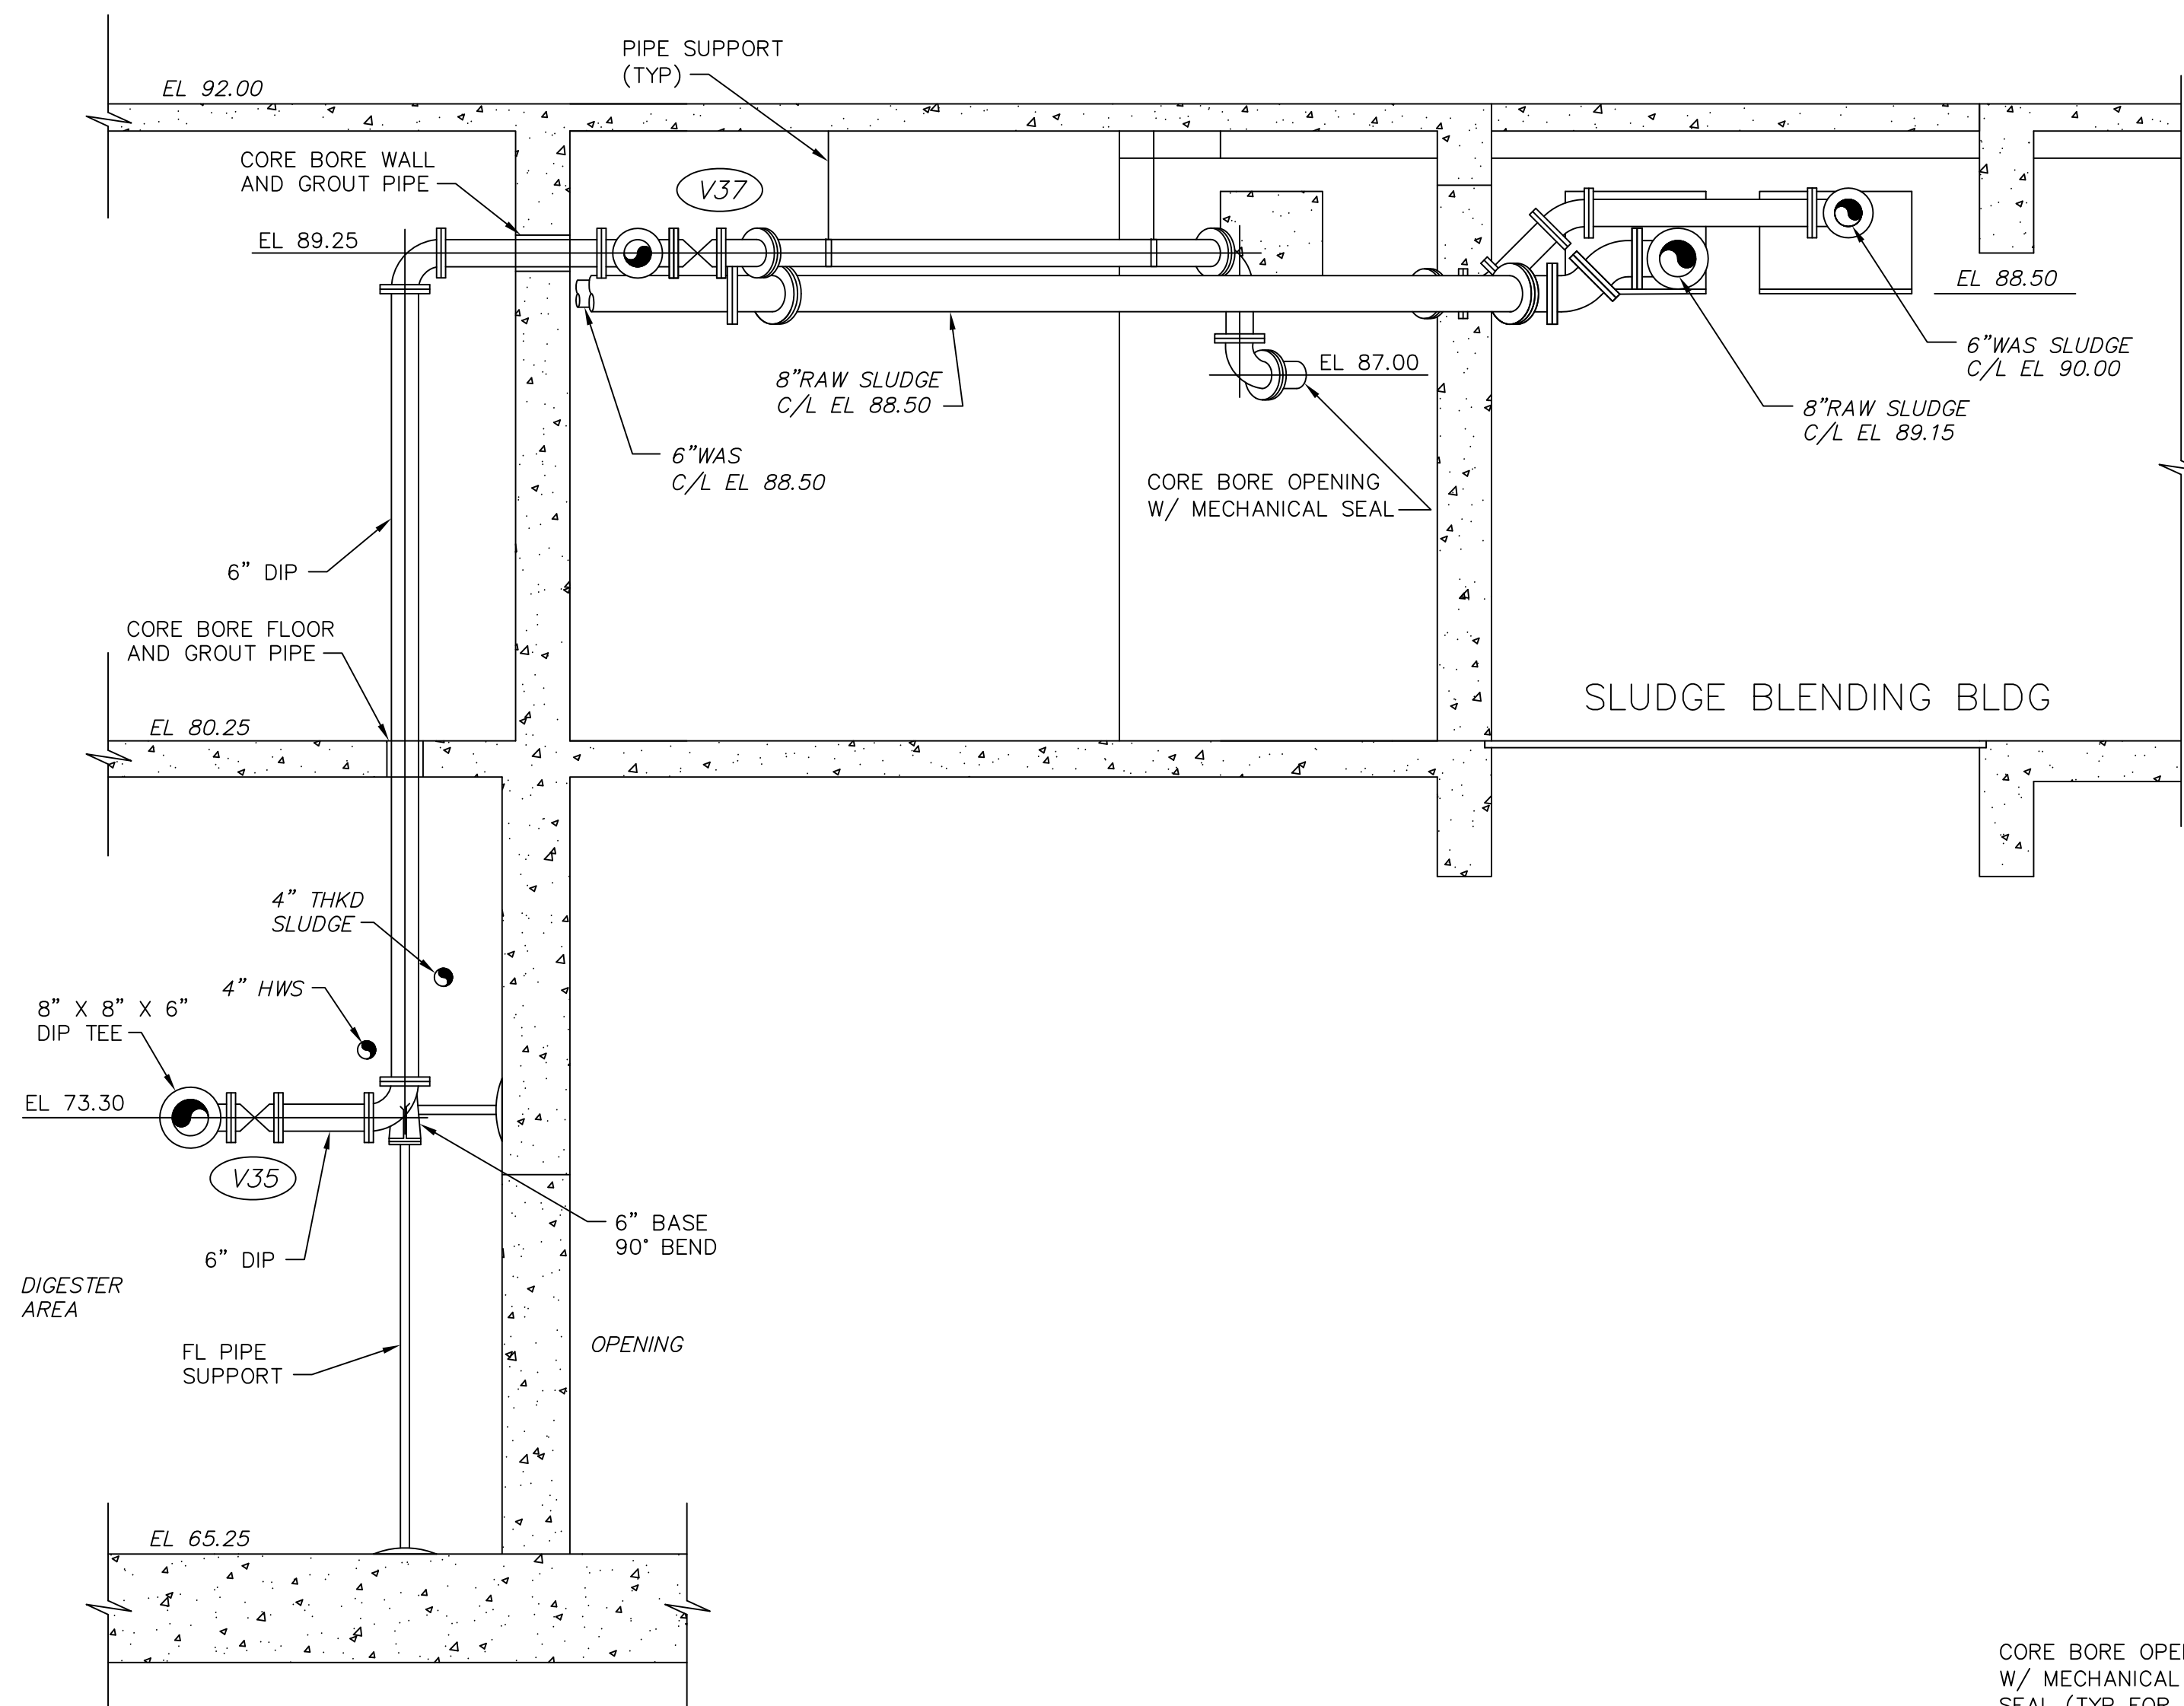

THESE RECORD DOCUMENTS HAVE BEEN PREPARED BASED ON INFORMATION PROVIDED BY OTHERS. CTI ENVIRONMENTAL HAS REVIEWED THE INFORMATION SUBMITTED AND BELIEVES IT REFLECTS THE WORK AS CONSTRUCTED. HOWEVER, ALL PERSONS SHALL VERIFY INFORMATION TAKEN FROM THIS DRAWING.

THIS DRAWING IS AN INSTRUMENT OF SERVICE OWNED BY CTI ENVIRONMENTAL, INC. WHICH SHALL BE DEEMED THE AUTHOR AND WHICH SHALL RETAIN ALL STATUTORY AND COMMON LAW RIGHTS. IT IS NOT TO BE REPRODUCED, COPIED, OR IN ANY MANNER USED FOR ANY OTHER PROJECT WITHOUT THE WRITTEN CONSENT OF CTI ENVIRONMENTAL, INC. THAT ELECTRONIC COPIES OF THIS DRAWING ARE EXACT DUPLICATES OF THE SEALED ORIGINAL. THE SEALED ORIGINAL SHALL GOVERN.

DESIGNED BY		REVISIONS		DATE		BY		APP'D	
NO.	DESCRIPTION	NO.	DESCRIPTION	DATE	BY	DATE	BY	DATE	BY
1	SUPERNATANT PUMP REPLACEMENT	3/03	TMK	MSW					
2	RECORD DRAWING	1/25	MGW	WAD					

ENVIRONMENTAL, INC.
ENGINEERS IN WATER AND EARTH SCIENCES
UNIONTOWN, OHIO

CITY OF MASSILLON, OHIO
WWTP UPGRADE 2000
SUPERNATANT PUMP PLAN AND SECTIONS

JOB NO. E02008
DATE 4/6/04
SCALE AS NOTED
SHEET P107B