



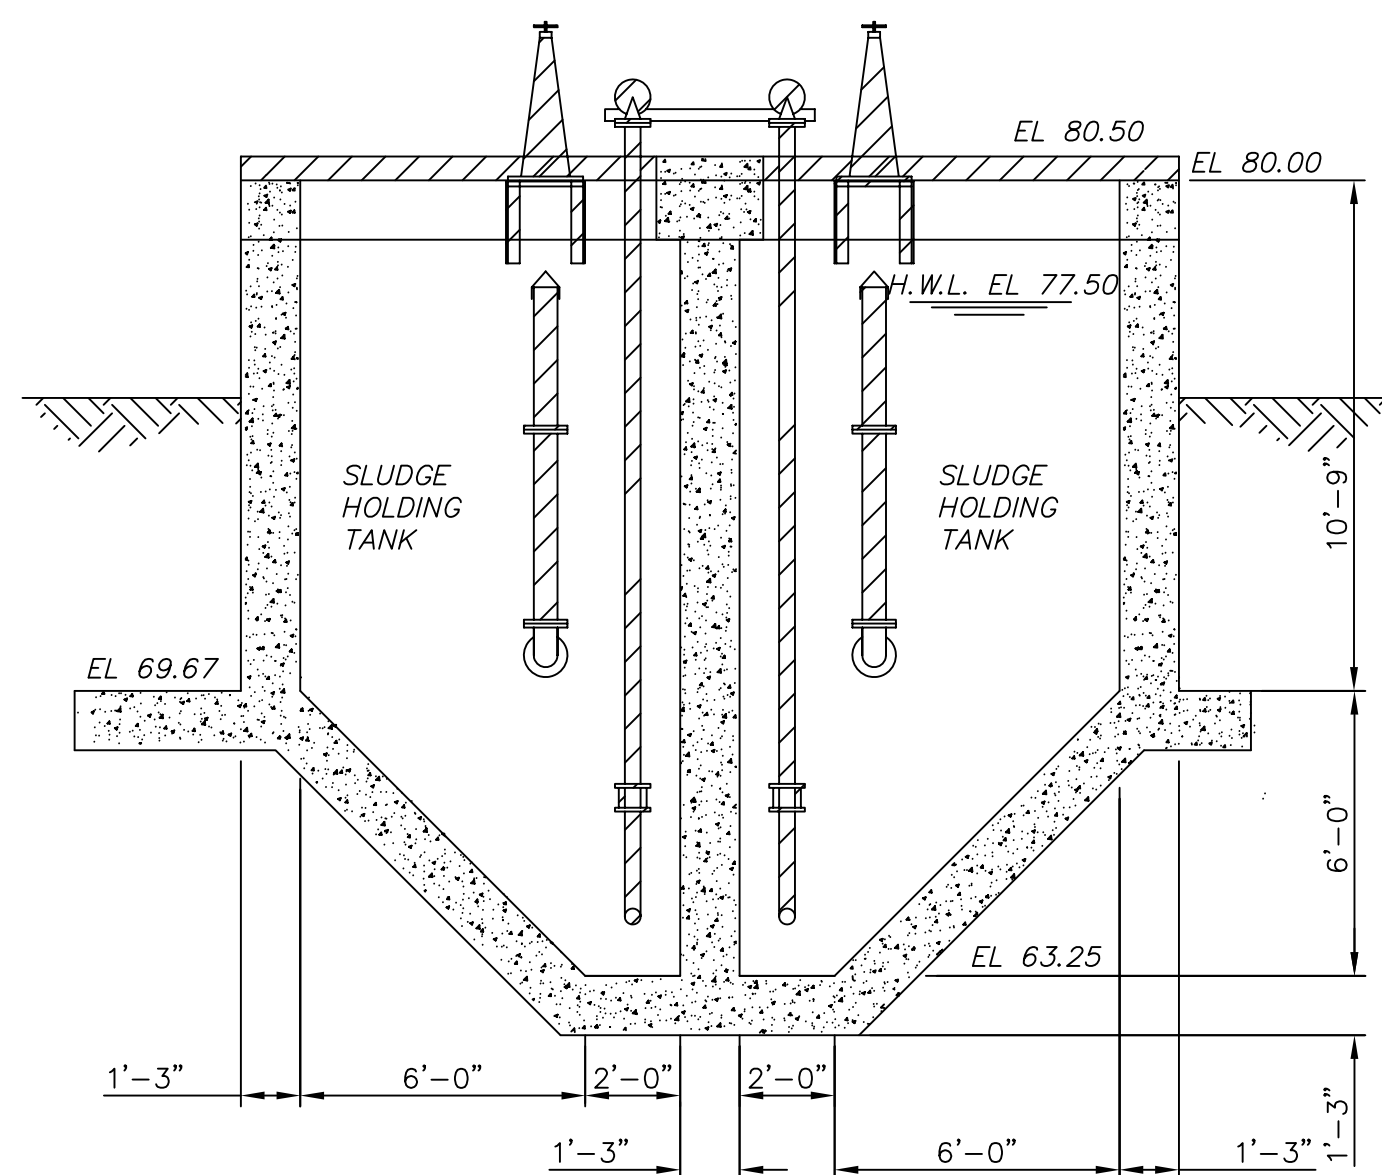

THESE RECORD DOCUMENTS HAVE BEEN PREPARED
BASED ON INFORMATION PROVIDED BY OTHERS. CTI
ENVIRONMENTAL HAS REVIEWED THE INFORMATION
SUBMITTED AND BELIEVES IT REFLECTS THE WORK AS
CONSTRUCTED. HOWEVER, ALL PERSONS SHALL
VERIFY INFORMATION TAKEN FROM THIS DRAWING.

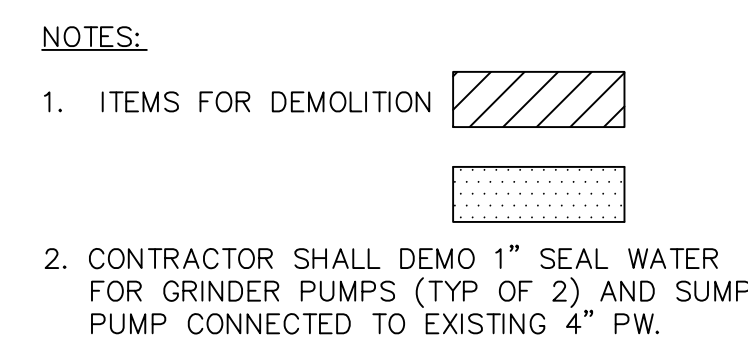

KEY PLAN

DESIGNED BY		REVISIONS			
TMK	NO.	DESCRIPTIONS	DATE	BY	APP'D
AMF	1	RECORD DRAWING	1/25	MGW	WAD
RWR					
WAD					

GT ENVIRONMENTAL, INC.
ENGINEERS IN WATER AND EARTH SCIENCES
UNIONTOWN, OHIO

CITY OF MASSILLON, OHIO
WWTP UPGRADE 2000
THICKENED SLUDGE HOLDING TANK - DEMOLITION

JOB NO.
E9031

DATE
08/13/01

SCALE
AS NOTED

SHEET
P108