
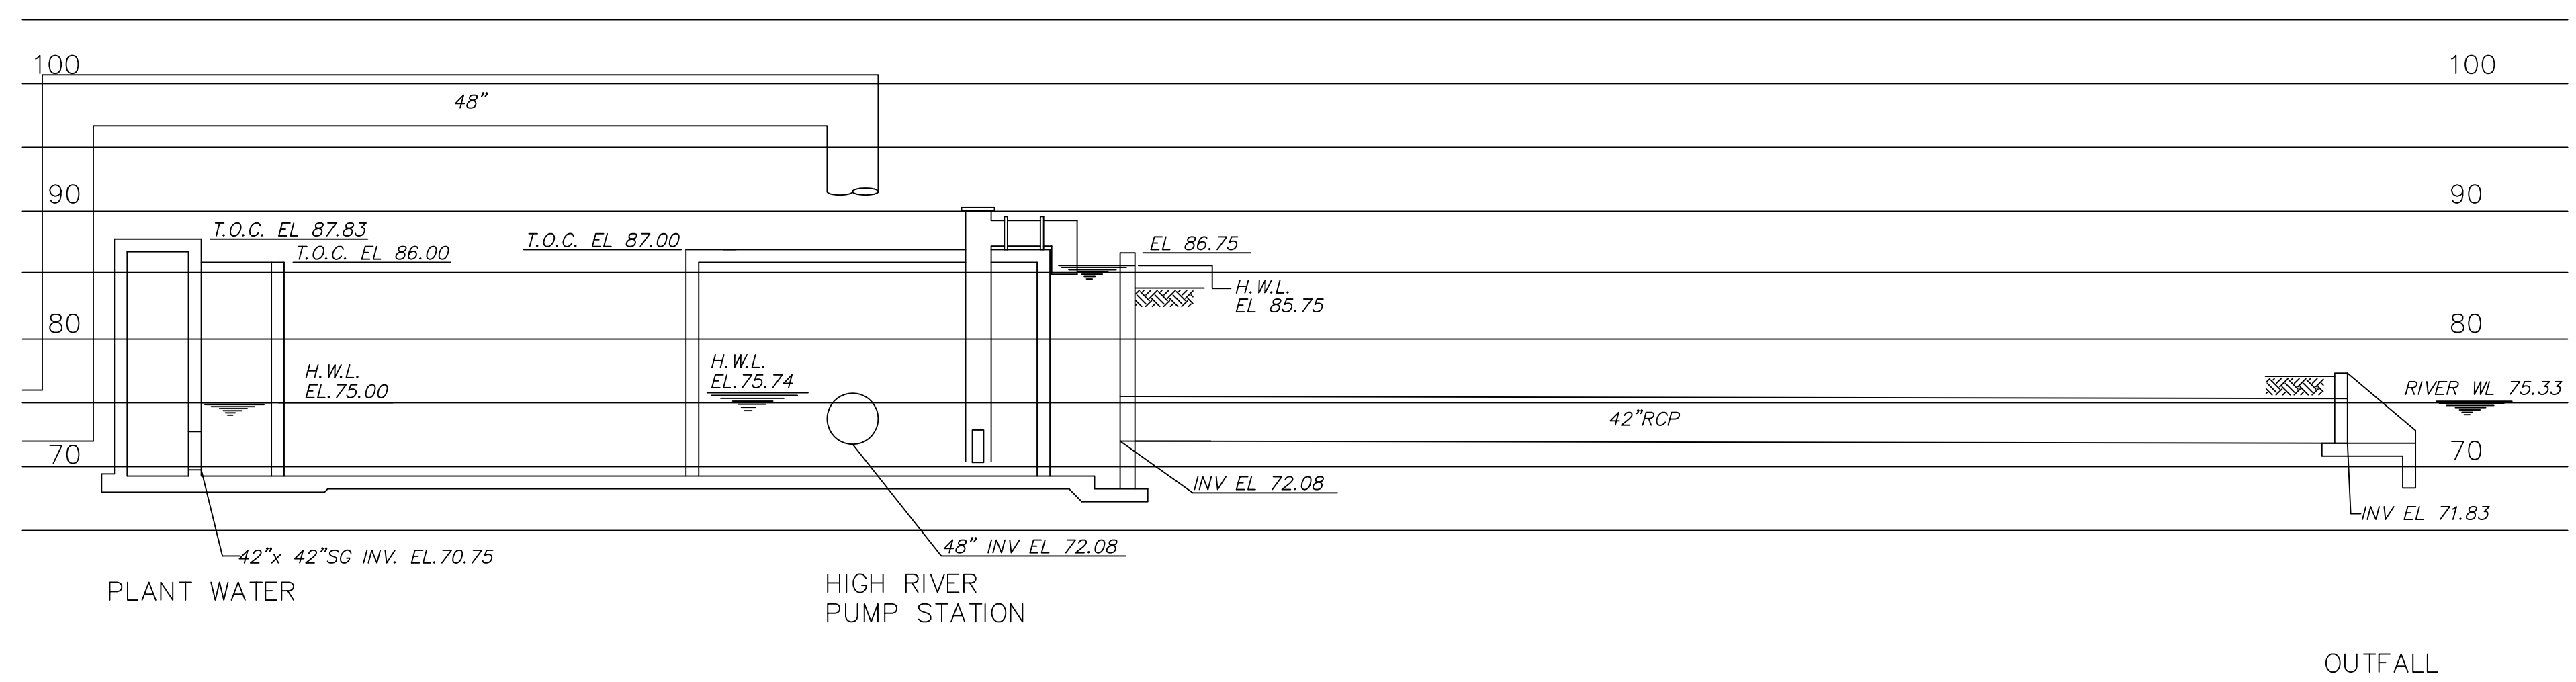
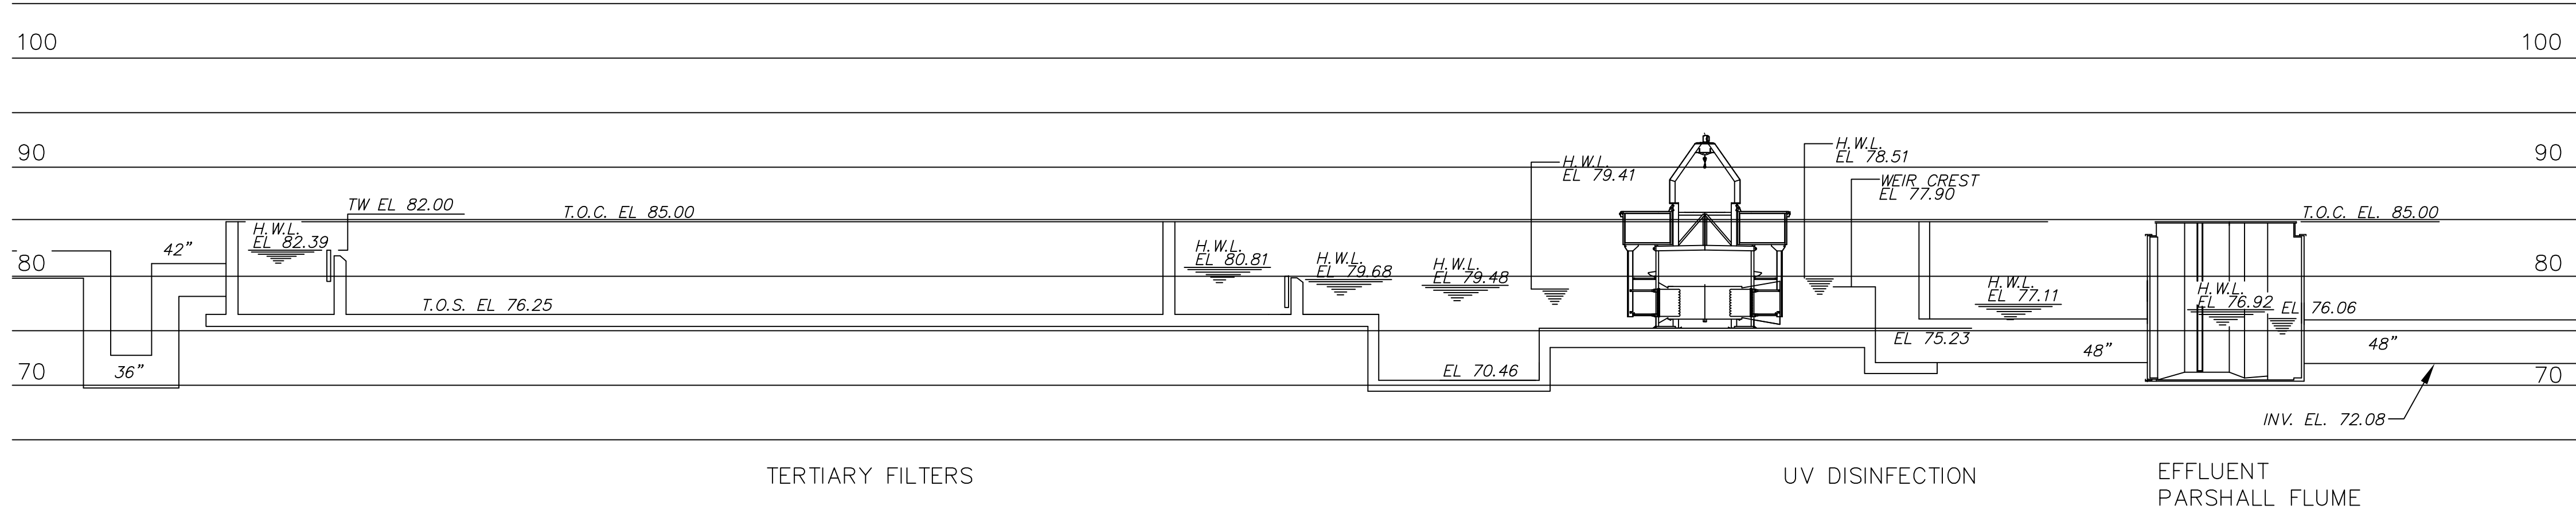


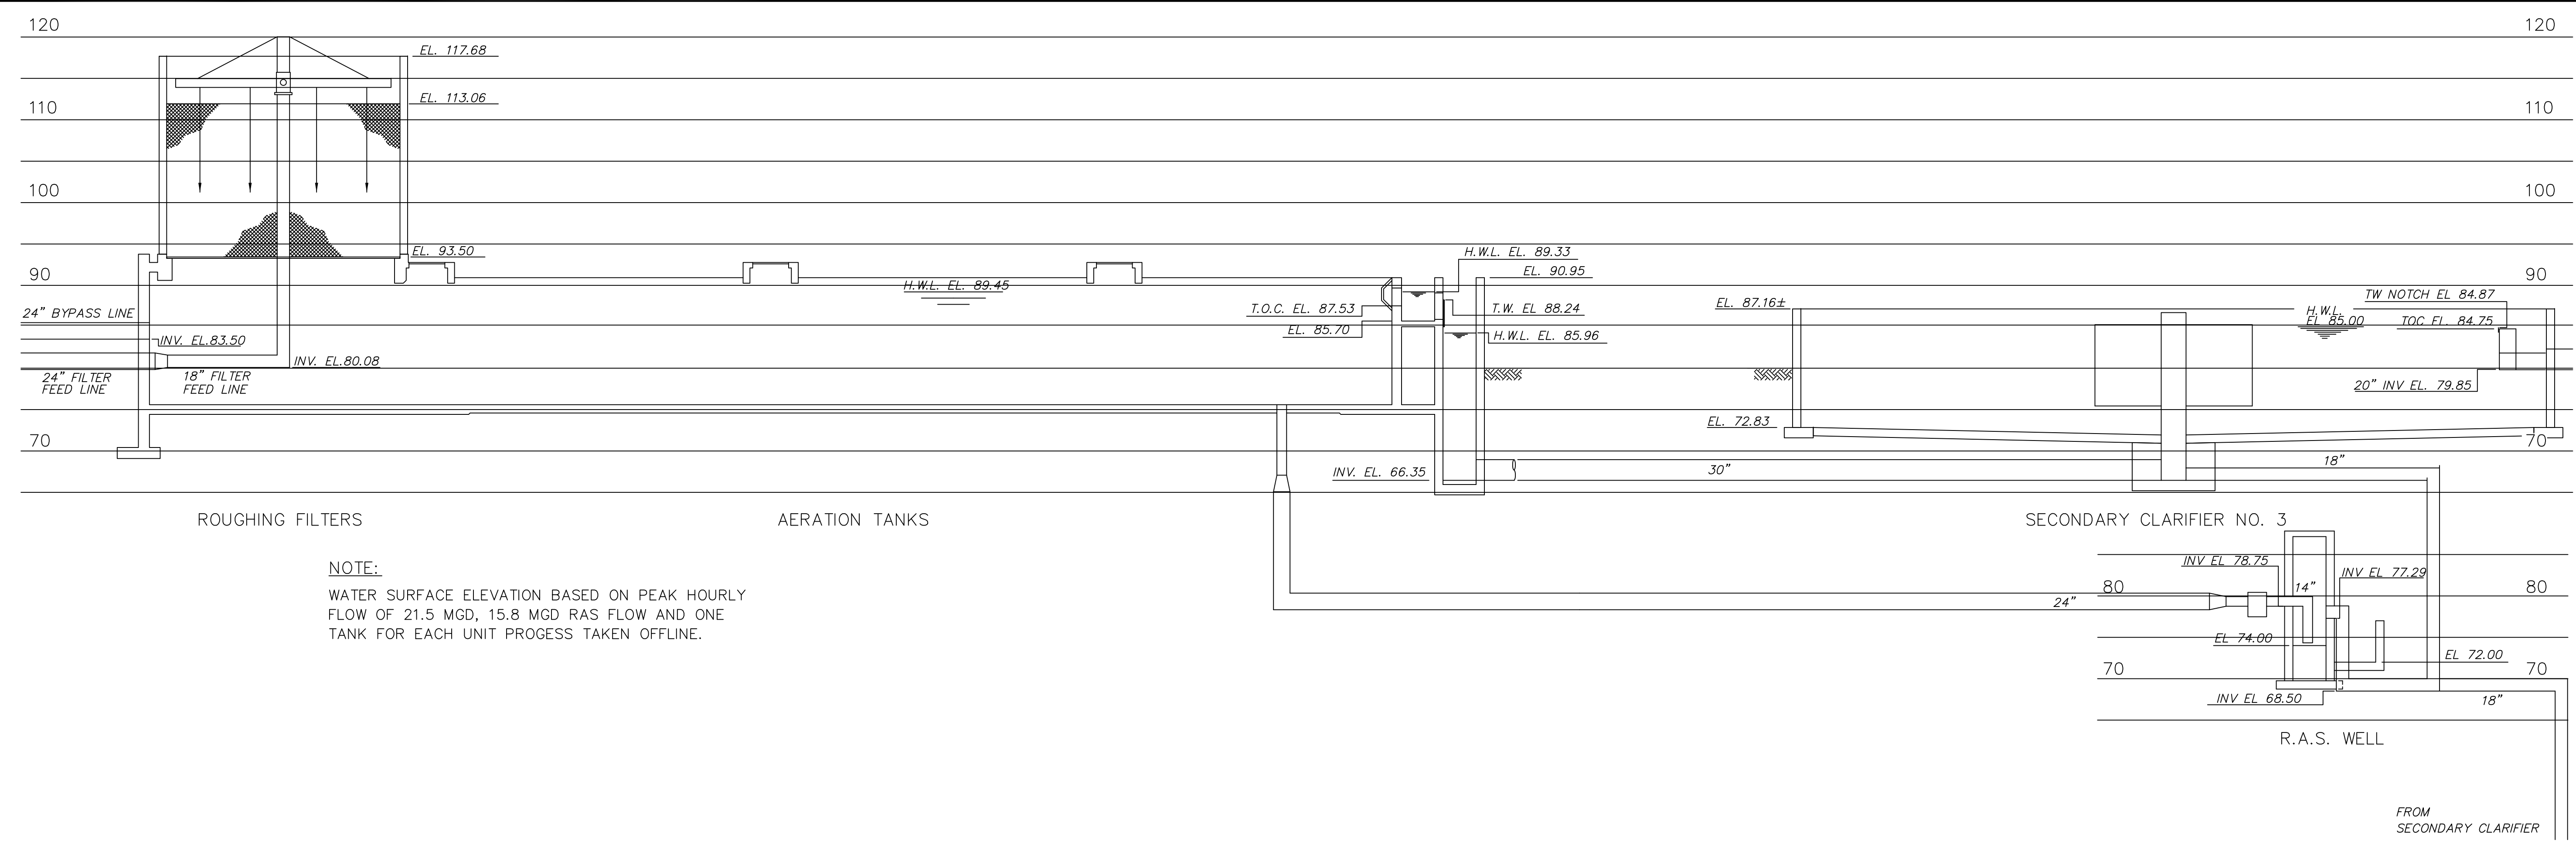

**LEGEND:**

EL. ELEVATION  
H.W.L. HIGH WATER LEVEL  
INV. INVERT  
T.O.C. TOP OF CONCRETE  
T.O.S. TOP OF SLAB  
T.W. TOP OF WEIR

**SCALE:**

HORIZONTAL: NOT TO SCALE  
VERTICAL: 1" = 10'

THESE RECORD DOCUMENTS HAVE BEEN PREPARED  
BASED ON INFORMATION PROVIDED BY OTHERS. CTI  
ENVIRONMENTAL HAS REVIEWED THE INFORMATION  
SUBMITTED AND BELIEVES IT REFLECTS THE WORK AS  
CONSTRUCTED. HOWEVER, ALL PERSONS SHALL  
VERIFY INFORMATION TAKEN FROM THIS DRAWING.

THIS DRAWING IS AN INSTRUMENT OF SERVICE OWNED  
BY CTI ENVIRONMENTAL, INC. WHICH SHALL BE DEEMED  
THE AUTHOR AND WHICH SHALL RETAIN ALL STATUTORY  
RIGHTS. IT IS NOT TO BE REPRODUCED, COPIED, OR  
THIS DRAWING SHALL NOT BE SCANNED, COPIED, OR  
ANY OTHER PURPOSE OR PROJECT WITHOUT THE  
WRITTEN CONSENT OF CTI ENVIRONMENTAL, INC.  
ELECTRONIC COPIES OF THIS DRAWING ARE EXACT  
DUPLICATES OF THE SEALED ORIGINAL DRAWING.  
ANY REVISIONS TO THE DRAWING SHALL BE MADE  
BY THE ORIGINAL DESIGNER AND THE SEALED ORIGINAL  
COPY AND THE SEALED ORIGINAL SHALL GOVERN.

| DESIGNED BY | NO. | DESCRIPTIONS   | DATE | BY  | APP'D |
|-------------|-----|----------------|------|-----|-------|
| AJP         | 1   | RECORD DRAWING | 4/05 | MGW | WAD   |
| DRAWN BY    |     |                |      |     |       |
| AJP         |     |                |      |     |       |
| CHECKED BY  |     |                |      |     |       |
| RWR         |     |                |      |     |       |
| APPROVED BY |     |                |      |     |       |
| WAD         |     |                |      |     |       |

ENVIRONMENTAL, INC.  
ENGINEERS IN WATER AND EARTH SCIENCES  
UNIONTOWN, OHIO

CITY OF MASSILLON, OHIO  
WWTP UPGRADE 2000  
LIQUID-HYDRAULIC PROFILE

JOB NO.  
E9031

DATE  
08/13/01

SCALE  
AS NOTED

SHEET  
P11