


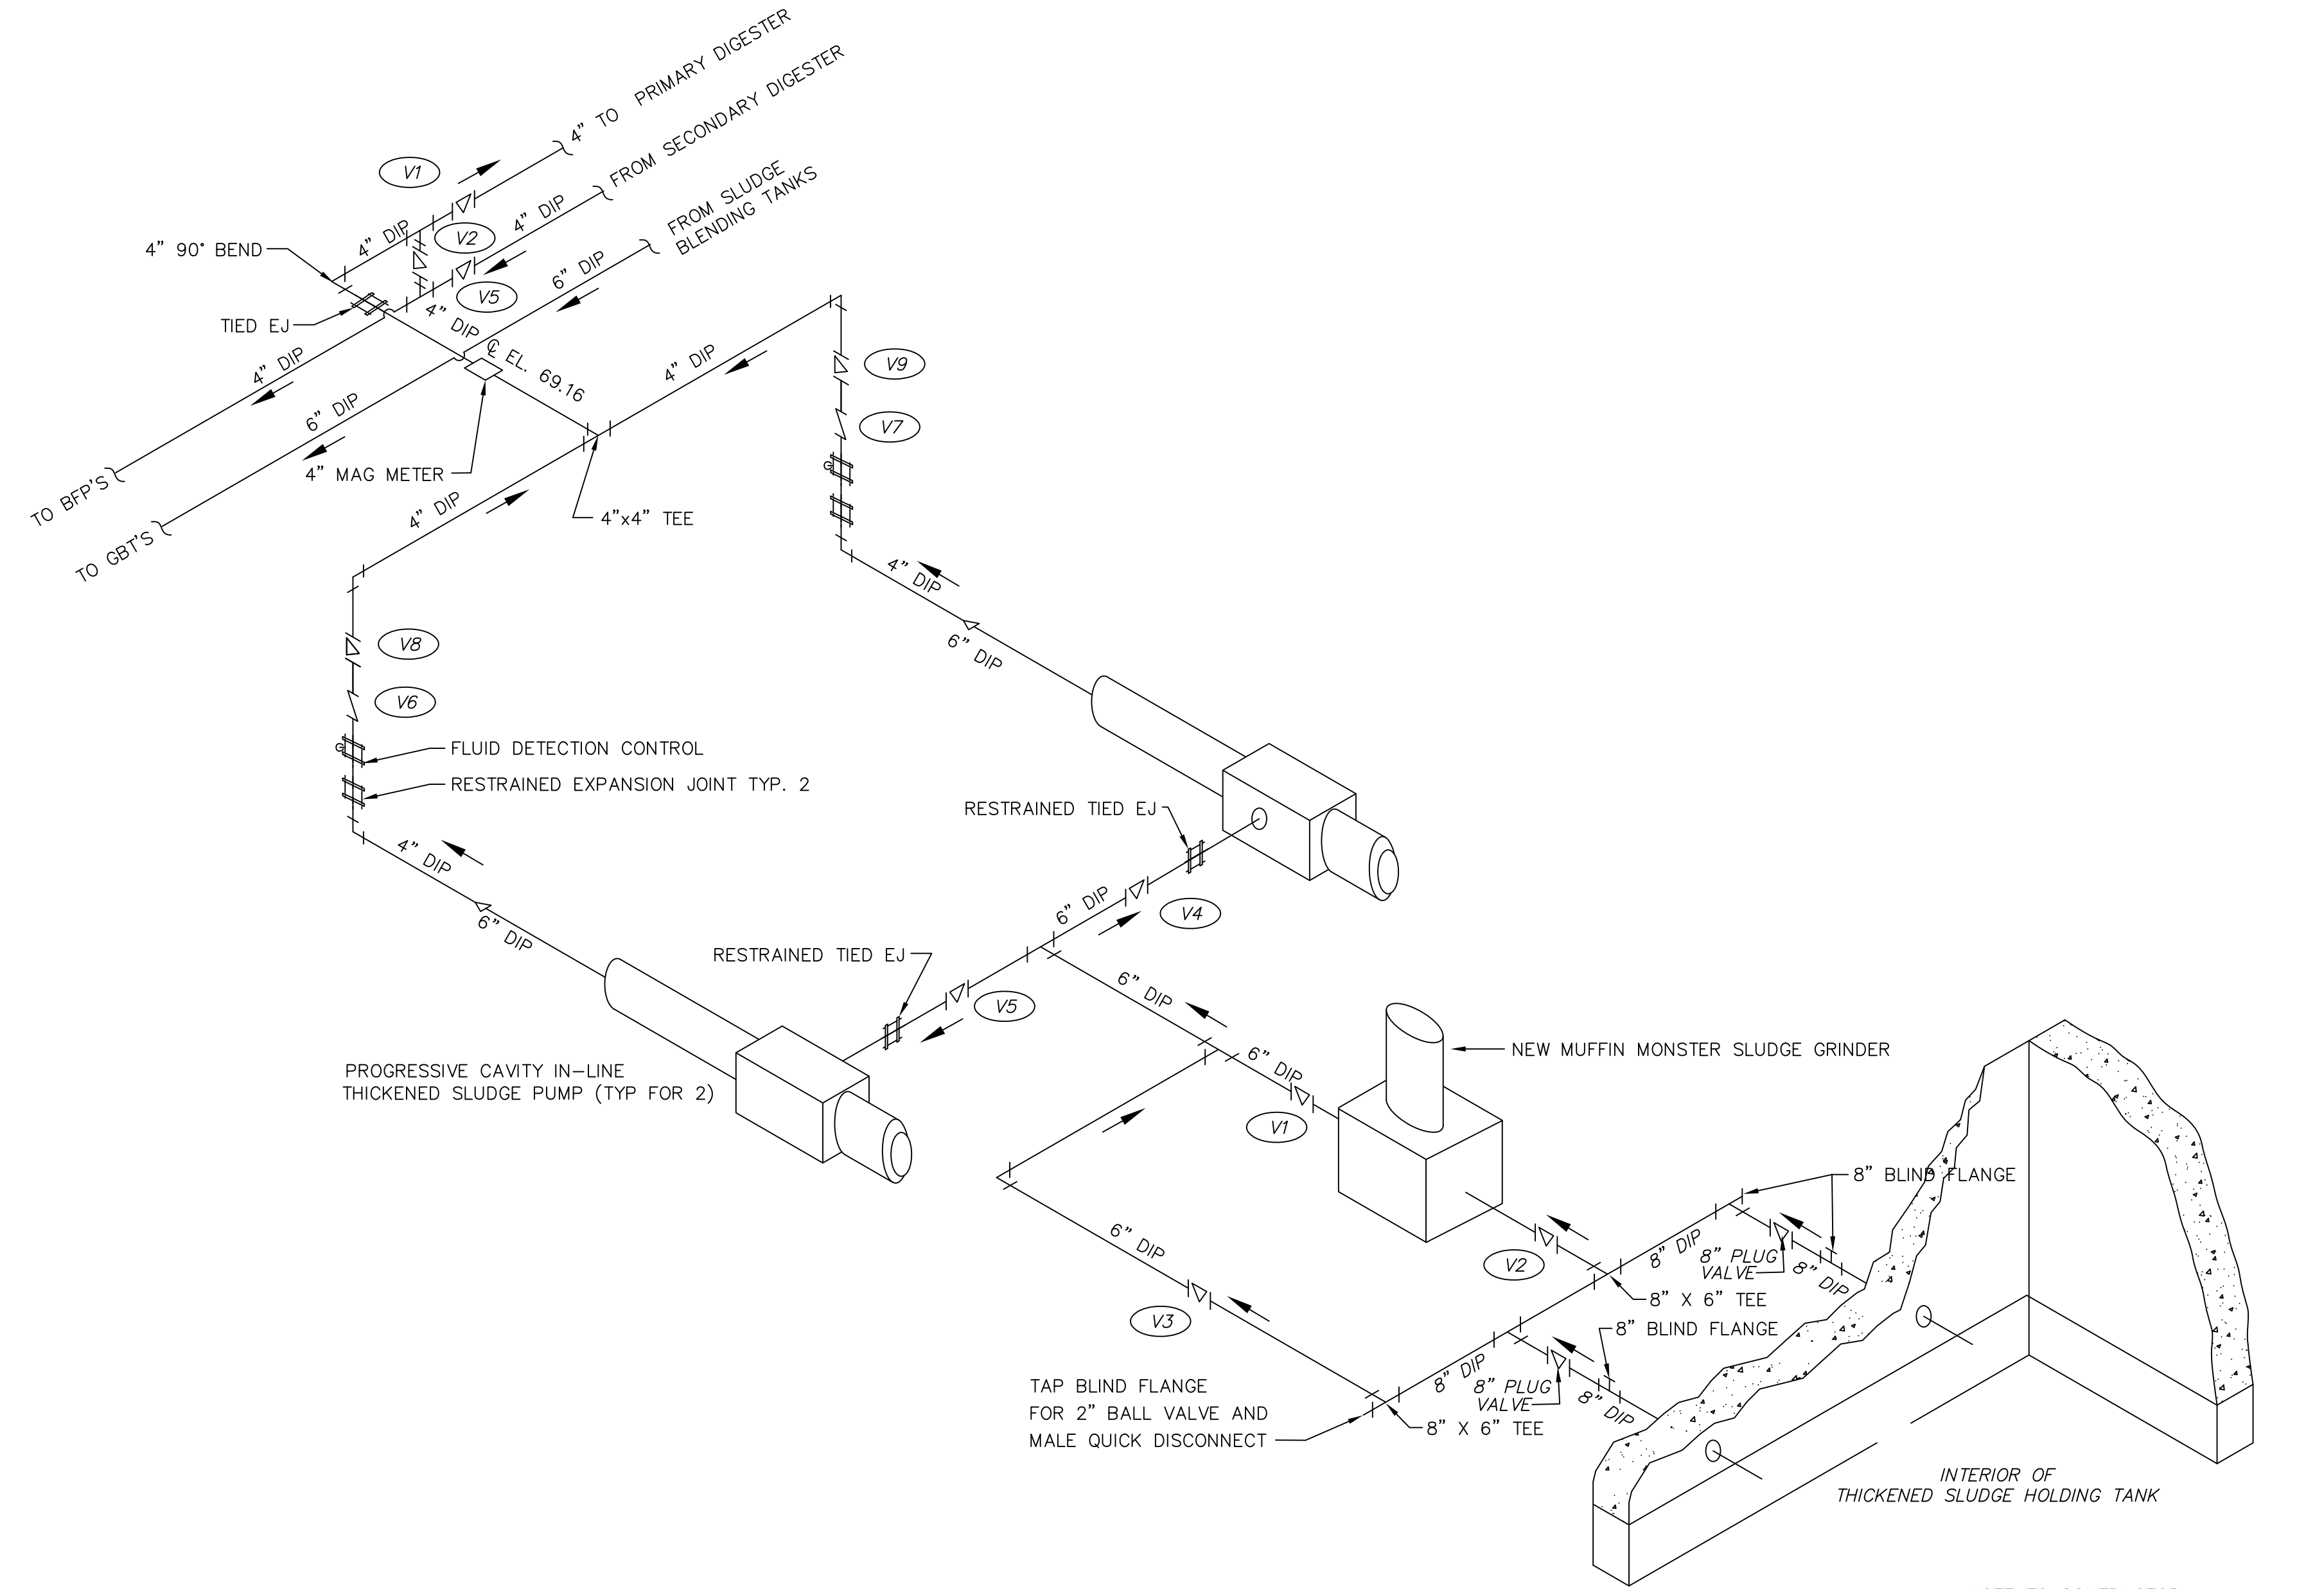

DIGESTER FEED PUMP SCHEMATIC

NTS

NOTE TO CONTRACTOR
1. CONTRACTOR SHALL PROVIDE SEAL WATER FROM EXIST 6" NPW TO BOTH THKD SLUDGE PUMPS.

THIS DRAWING IS AN INSTRUMENT OF SERVICE OWNED BY CTI ENVIRONMENTAL, INC. WHICH SHALL BE DEEMED THE AUTHOR AND WHICH SHALL RETAIN ALL STATUTORY AND COMMON LAW RIGHTS. NO PART OF THIS DRAWING SHALL BE REPRODUCED, COPIED, OR TRANSMITTED IN ANY FORM OR BY ANY MEANS, WITHOUT THE WRITTEN CONSENT OF CTI ENVIRONMENTAL, INC. THAT ELECTRONIC COPIES OF THIS DRAWING ARE EXACT DUPLICATES OF THE SEALED ORIGINAL DRAWING. ANY OTHER COPIES OF THIS DRAWING ARE NOT VALID. THIS DRAWING AND THE SEALED ORIGINAL SHALL GOVERN.

DESIGNED BY				REVISIONS			
NO.	DESCRIPTIONS	DATE	BY	APP'D	NO.	DESCRIPTIONS	DATE
1	RECORD DRAWING	5/05	MGW	WAD			

ENVIRONMENTAL, INC.
ENGINEERS IN WATER AND EARTH SCIENCES
UNIONTOWN, OHIO

CTI

CITY OF MASSILLON, OHIO
WWTP UPGRADE 2000
DIGESTER FEED PUMP SCHEMATIC

JOB NO. E9031
DATE 08/13/01
SCALE AS NOTED
SHEET P110

THESE RECORD DOCUMENTS HAVE BEEN PREPARED BASED ON INFORMATION PROVIDED BY OTHERS. CTI ENVIRONMENTAL HAS REVIEWED THE INFORMATION SUBMITTED AND BELIEVES IT REFLECTS THE WORK AS CONSTRUCTED. HOWEVER, ALL PERSONS SHALL VERIFY INFORMATION TAKEN FROM THIS DRAWING.