


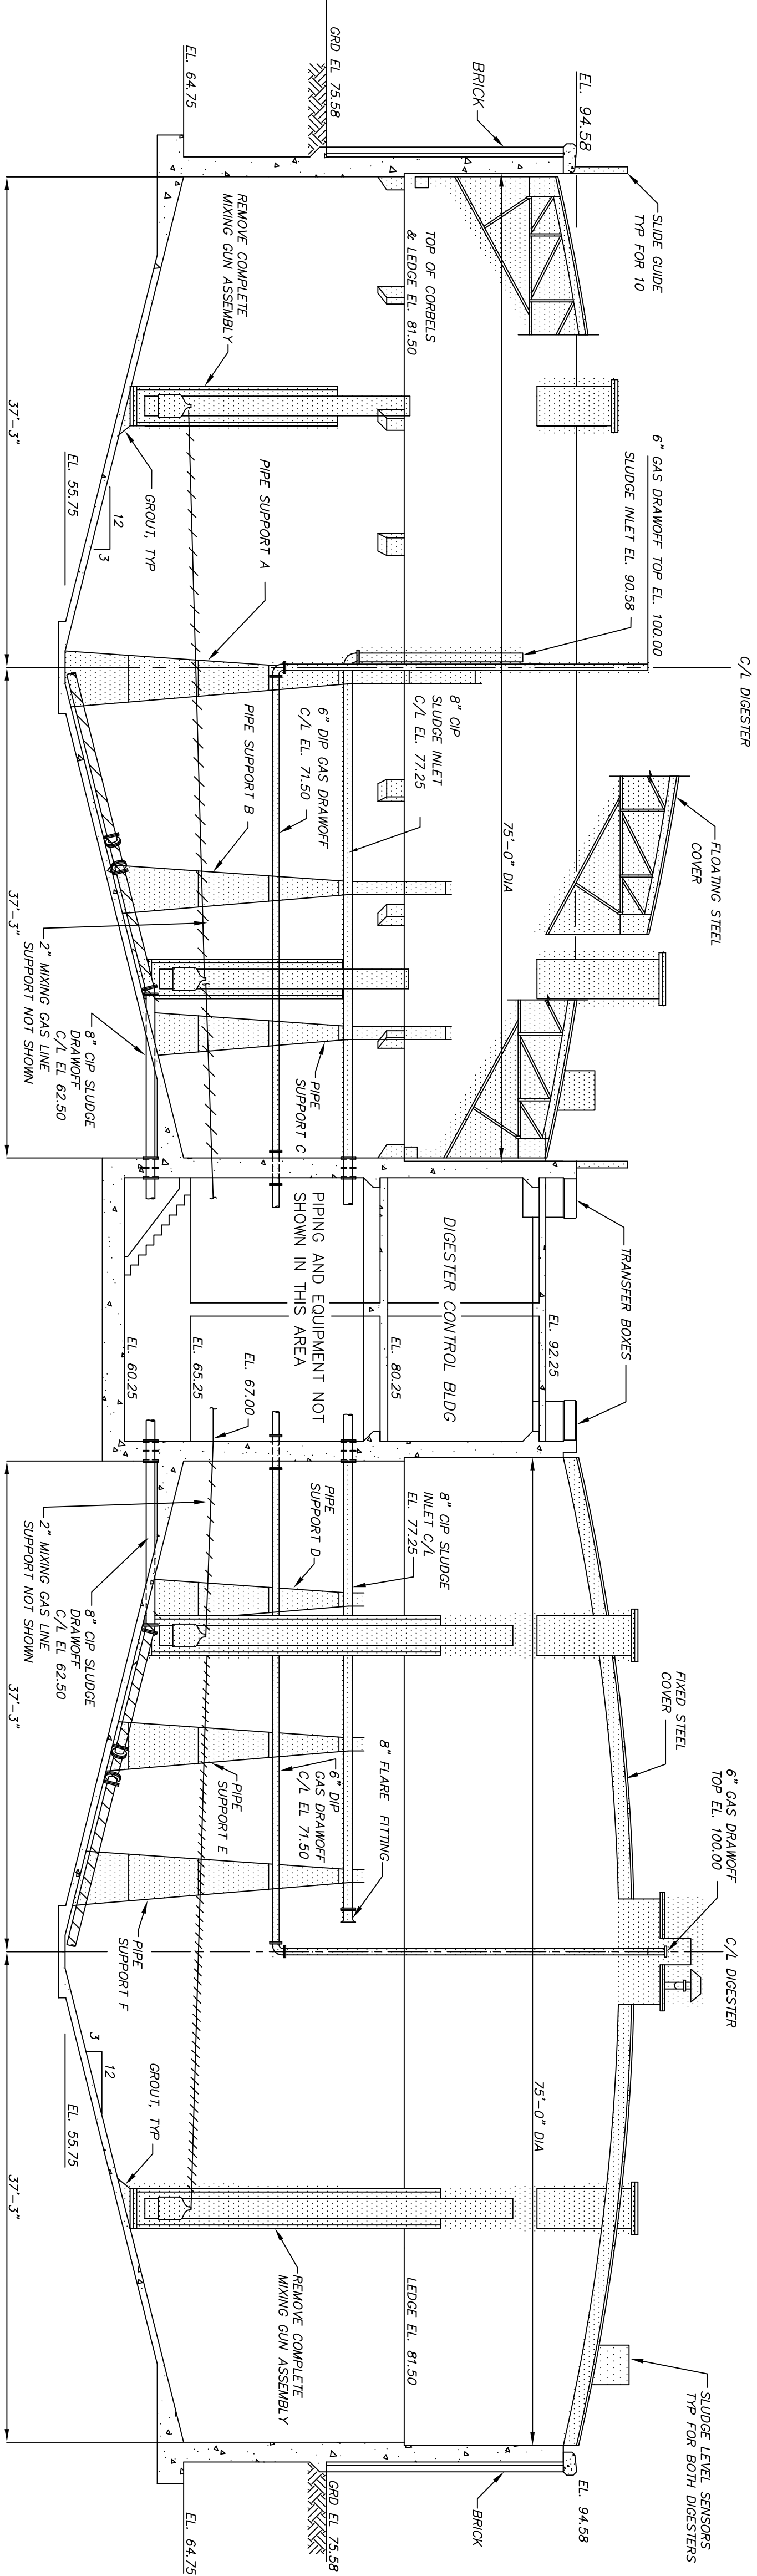


SECONDARY DIGESTER


PRIMARY DIGESTER

SECTION A
SCALE : 1/8"=1'-0"


- NOTES:
1. ITEMS FOR DEMOLITION
 2. EXISTING STEEL DIGESTER COVERS, AND RELATED APERTUREANCES (TYPICAL FOR 2) TO BE REMOVED.
 3. EXISTING DIGESTER MIXING EQUIPMENT (TYPICAL FOR 2) SHALL BE REMOVED. EXISTING MIXING EQUIPMENT IS MOUNTED TO THE DIGESTER FLOOR. THE MOUNTING BOLTS AND GROUT SHALL BE REMOVED AND GROUND SMOOTH.
 4. EXISTING SLUDGE AND DIG GAS PIPING AND THEIR SUPPORTS INSIDE THE DIGESTERS TO BE REMOVED, FOR DETAILS SEE THIS SHEET.
 5. ENTIRE INTERIOR OF THE EXISTING CONCRETE TANKS SHALL BE CLEANED WITH HIGH PRESSURE WATER.

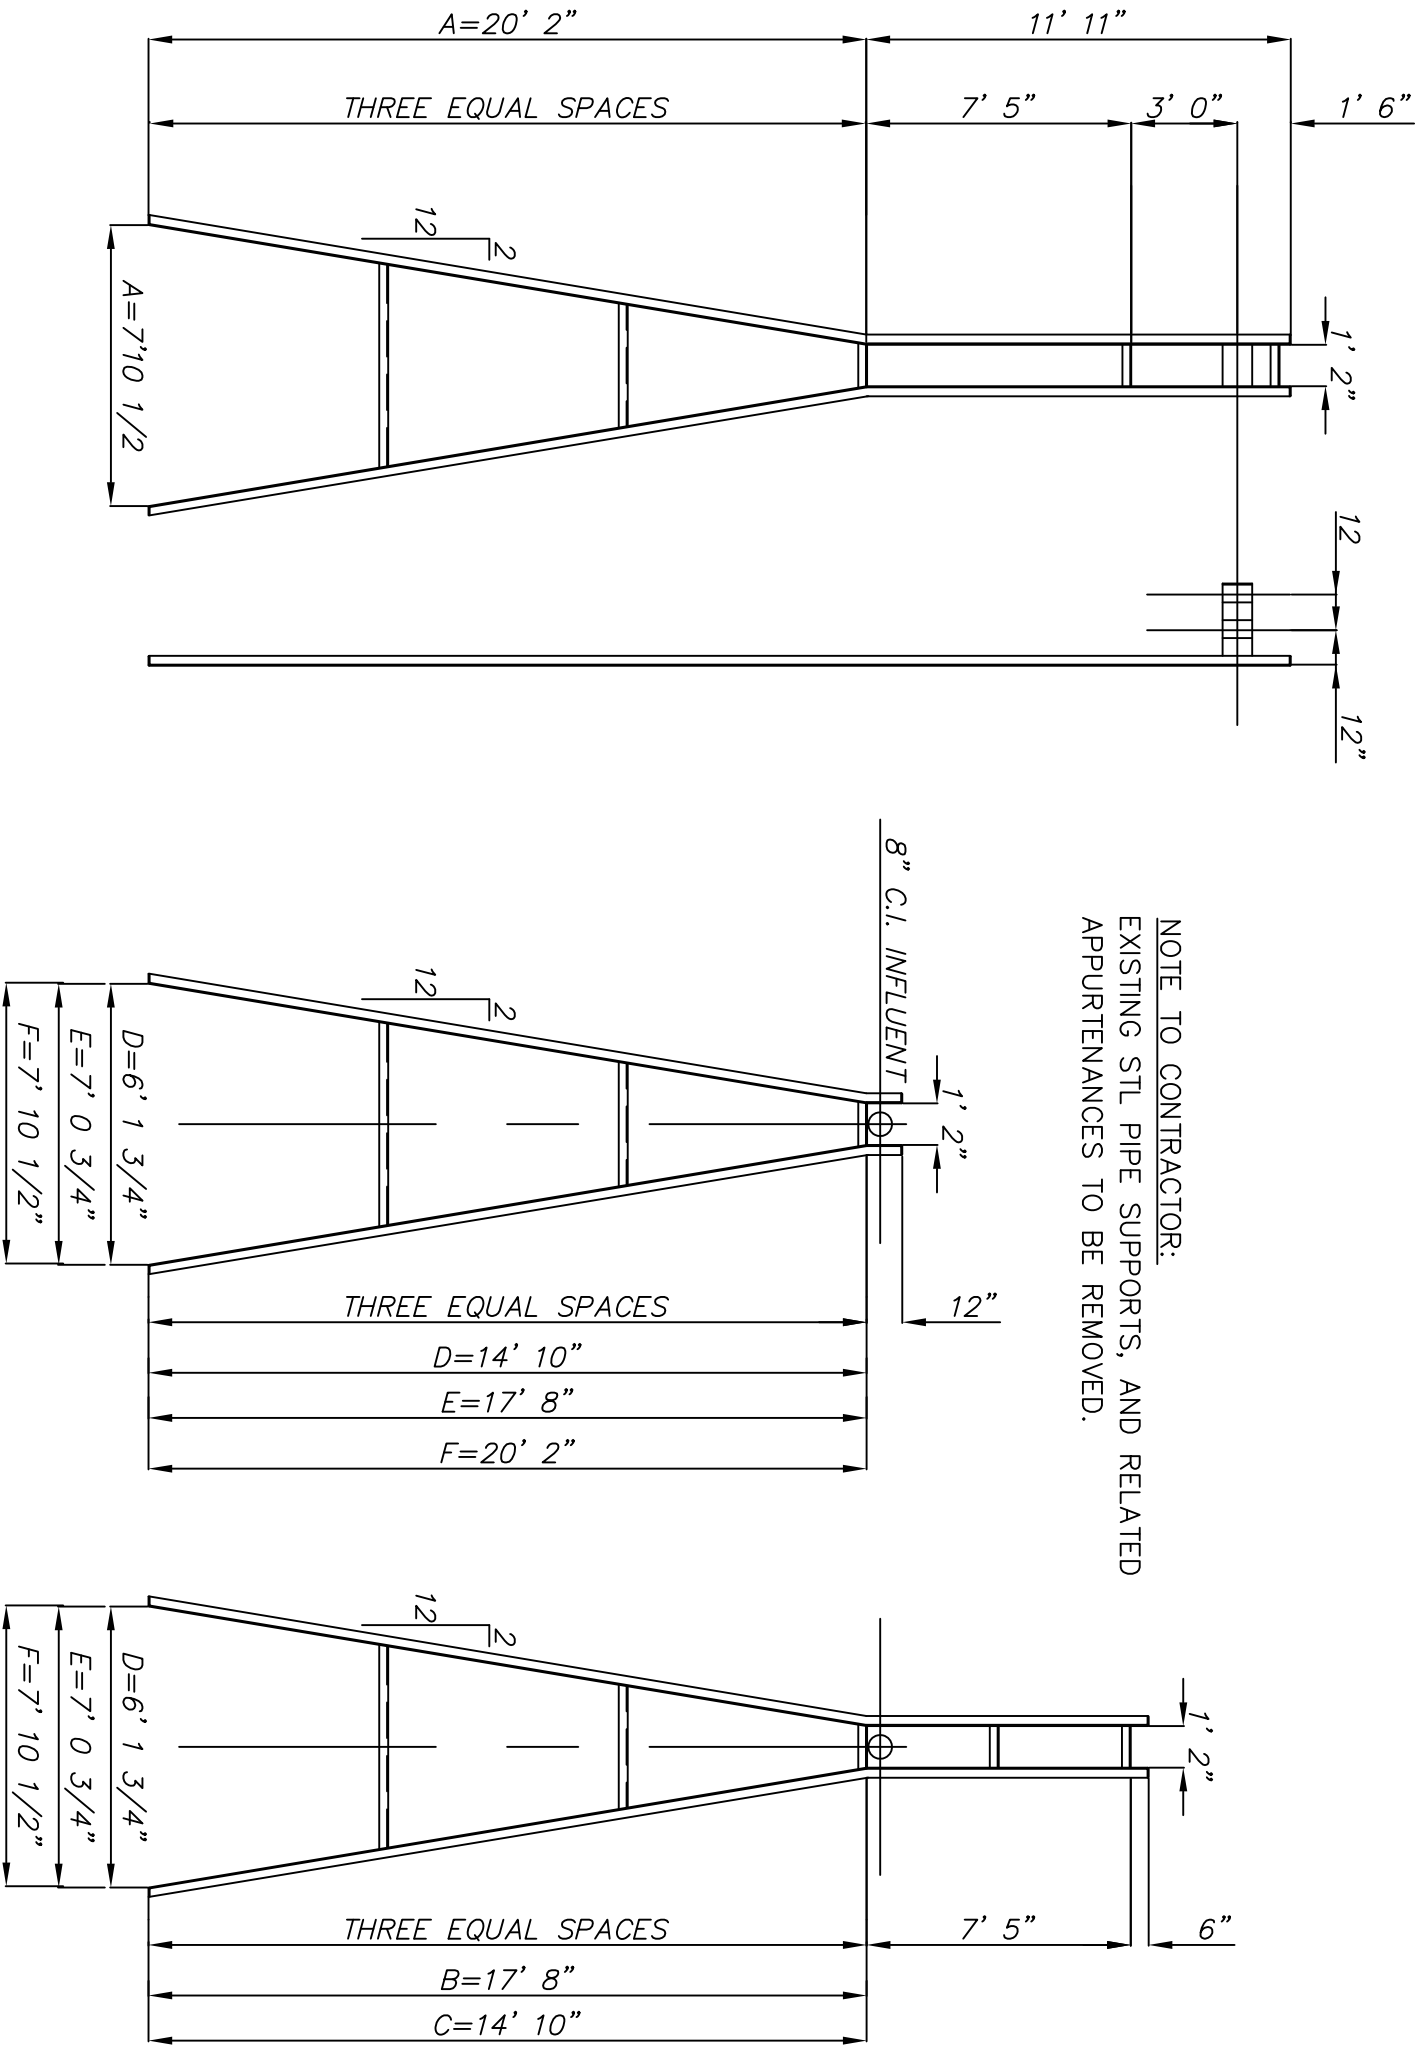

DIGESTER PIPE SUPPORTS
SCALE: 3/16"=1' 0"

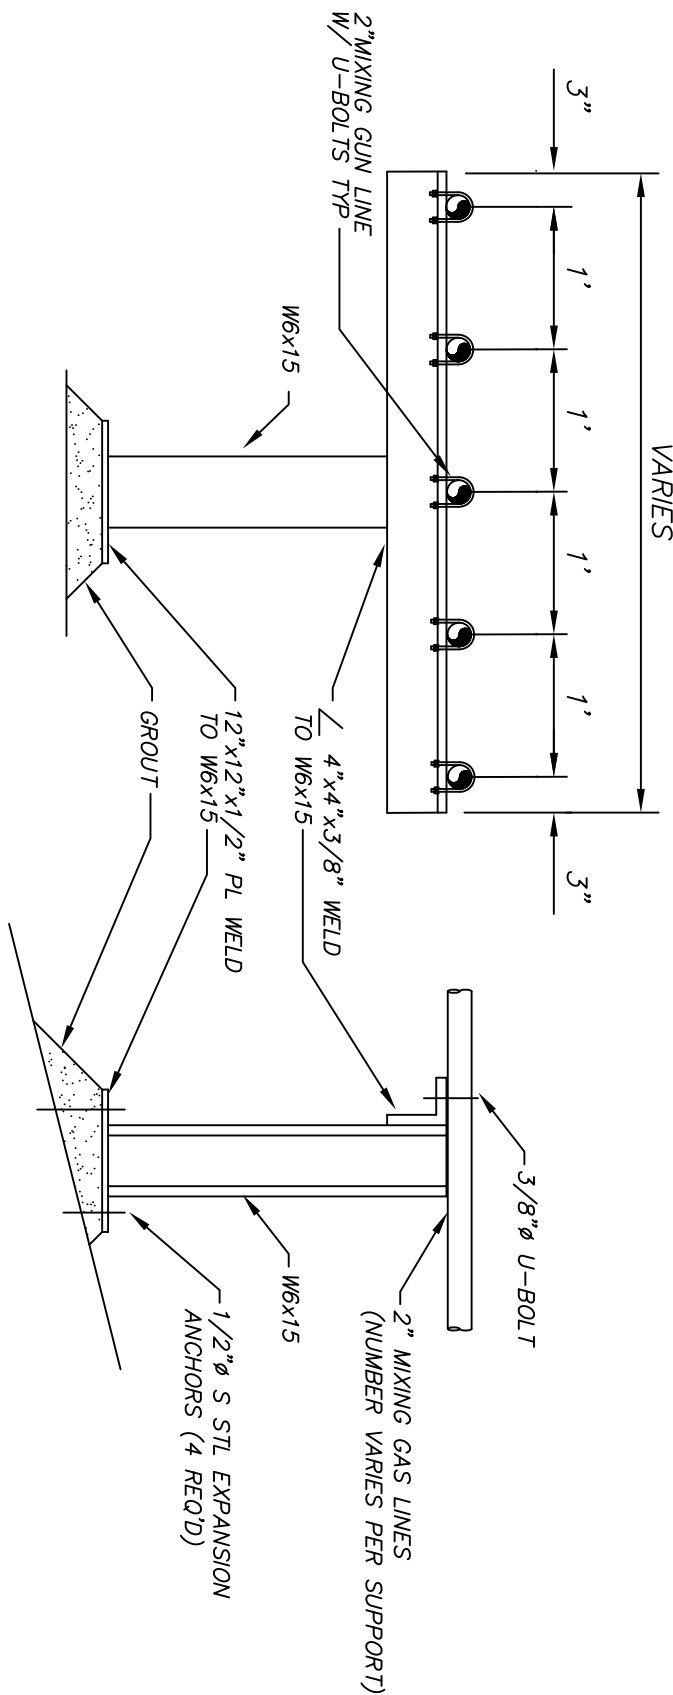

MIXING GAS LINE SUPPORT
SCALE: 3/4"=1'-0"

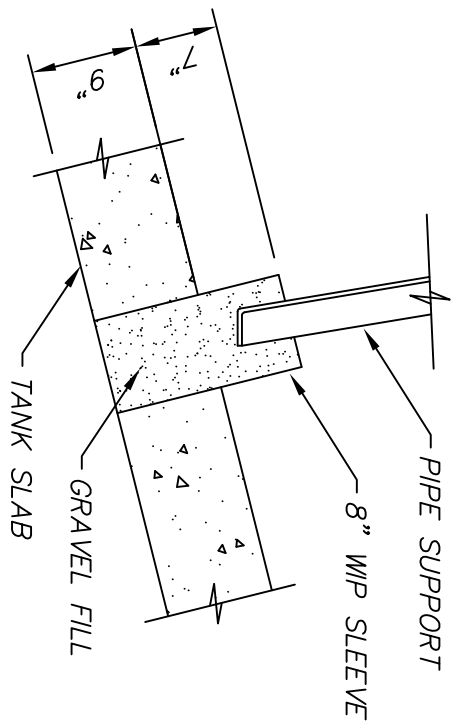

TYPICAL PIPE SUPPORT ANCHORAGE DETAIL
SCALE: 3/4"=1'-0"



ENVIRONMENTAL, INC.
ENGINEERS IN WATER AND EARTH SCIENCES
UNIONTOWN, OHIO

CITY OF MASSILLON, OHIO
WWTP UPGRADE 2000
ANAEROBIC DIGESTER SECTIONS AND DETAILS – DEMOLITION

DESIGNED BY	DRAWN BY	CHECKED BY	APPROVED BY	REVISIONS				
				NO.	DESCRIPTIONS	DATE	BY	APP'D
AJP	SAT	AJP	RWR	1	ADDENDUM NO. 1	9/12	RWR	WAD
				2	RECORD DRAWING	5/05	MGW	WAD

THIS DRAWING IS AN INSTRUMENT OF SERVICE OWNED BY CTE ENVIRONMENTAL, INC. WHICH SHALL BE DEEMED BY THE AUTHOR AND WHICH SHALL RETAIN ALL STATUTORY AND COMMON LAW RIGHTS, INCLUDING COPYRIGHTS. THIS DRAWING SHALL NOT BE SCANNED, COPIED, OR DISTRIBUTED TO OTHERS IN ANY FORM OR USED FOR ANY OTHER PURPOSE OR PROJECT WITHOUT PRIOR WRITTEN CONSENT OF CTE ENVIRONMENTAL, INC. CTE ENVIRONMENTAL, INC. CANNOT GUARANTEE THAT ELECTRONIC COPIES OF THIS DRAWING ARE EXACT DUPLICATES OF THE SEALED ORIGINAL DRAWING. IN THE EVENT OF A CONFLICT BETWEEN AN ELECTRONIC COPY AND THE SEALED ORIGINAL, THE SEALED ORIGINAL SHALL GOVERN.

THESE RECORD DOCUMENTS HAVE BEEN PREPARED BASED ON INFORMATION PROVIDED BY OTHERS. CTE ENVIRONMENTAL HAS REVIEWED THE INFORMATION AS SUBMITTED AND BELIEVES IT REFLECTS THE WORK AS CONSTRUCTED. HOWEVER, ALL PERSONS SHALL VERIFY INFORMATION TAKEN FROM THIS DRAWING.

JOB NO.	E9031
DATE	08/13/01
SCALE	AS NOTED
SHEET	P112