
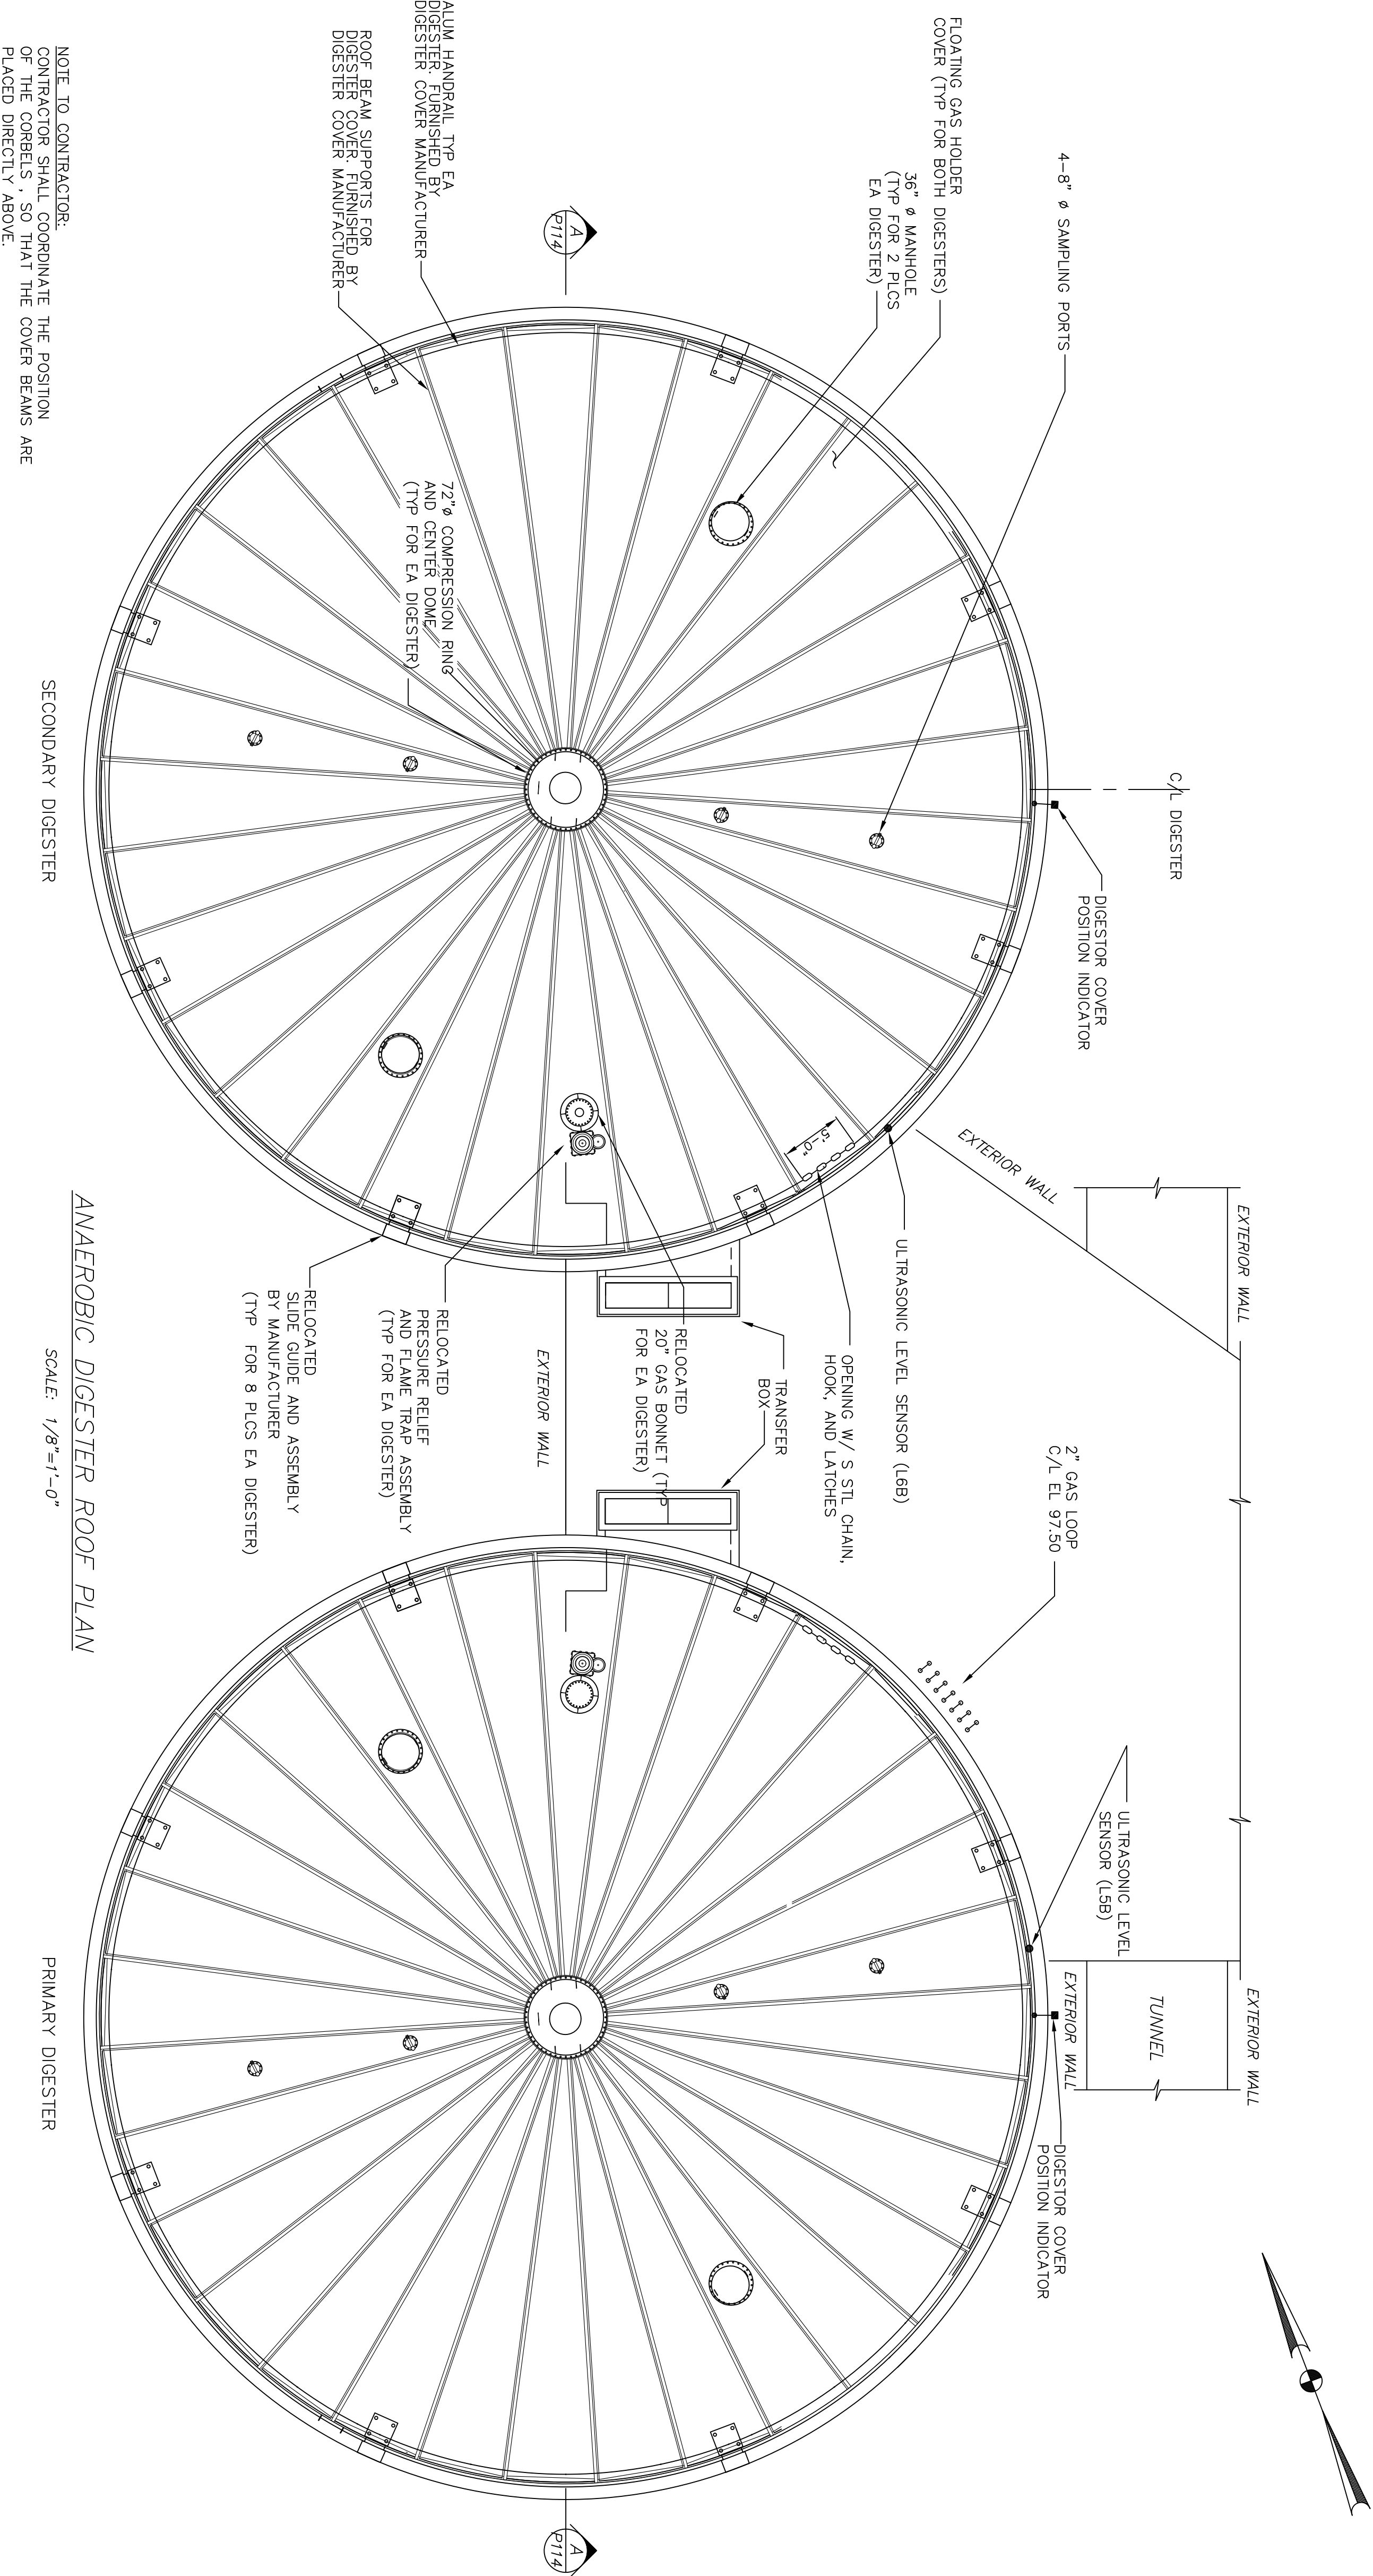


THIS DRAWING IS AN INSTRUMENT OF SERVICE OWNED BY CTI ENVIRONMENTAL, INC. WHICH SHALL BE DEEMED THE AUTHOR AND WHICH SHALL RETAIN ALL STATUTORY AND COMMON LAW RIGHTS, INCLUDING COPYRIGHTS. THIS DRAWING SHALL NOT BE SCANNED, COPIED, OR DISTRIBUTED TO OTHERS IN ANY FORM OR USED FOR ANY OTHER PURPOSE OR PROJECT WITHOUT PRIOR WRITTEN CONSENT OF CTI ENVIRONMENTAL, INC. CTI ENVIRONMENTAL, INC. CANNOT GUARANTEE THAT ELECTRONIC COPIES OF THIS DRAWING ARE EXACT DUPLICATES OF THE SEALED ORIGINAL DRAWING. IN THE EVENT OF A CONFLICT BETWEEN AN ELECTRONIC COPY AND THE SEALED ORIGINAL, THE SEALED ORIGINAL SHALL GOVERN.

NO.	DESIGNER	DATE	BY	APP'D
1	ADDENDUM NO. 1	9/14/01	RWR	WAD
2	REVISIONS	9/6/02	RWR	WAD
3	RECORD DRAWING	1/26/05	RWR	WAD

ENVIRONMENTAL, INC.
ENGINEERS IN WATER AND EARTH SCIENCES
UNIONTOWN, OHIO

CITY OF MASSILLON, OHIO
WWTP UPGRADE 2000
ANAEROBIC DIGESTER ROOF PLAN

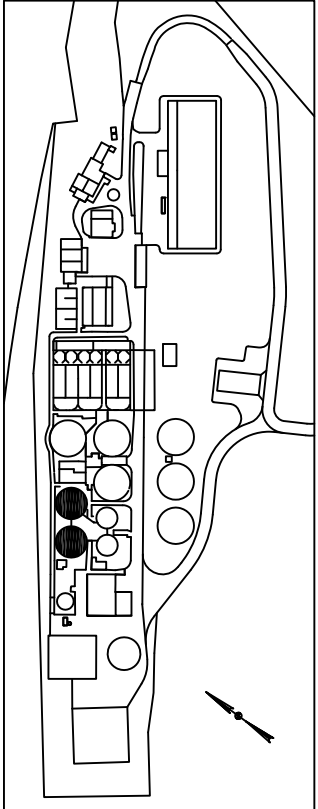

NOTE TO CONTRACTOR:
CONTRACTOR SHALL COORDINATE THE POSITION
OF THE CORBELS, SO THAT THE COVER BEAMS ARE
PLACED DIRECTLY ABOVE.

ANAEROBIC DIGESTER ROOF PLAN

SCALE: 1/8"=1'-0"

PRIMARY DIGESTER

SECONDARY DIGESTER