
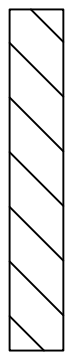


DIGESTER CONTROL BLDG
SLUDGE, WATER AND GAS PLAN AT EL. 89.00

SCALE: 3/8"=1'-0"

ITEMS FOR DEMOLITION

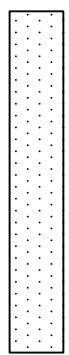


- NOTES TO CONTRACTOR:
1. PLUG WALL CASTING W/ NON-SHRINK GROUT.
 2. CONTRACTOR TO REPAIR CONC AND REPAINT CONC ON INTERIOR OF PRIMARY CONCRETE RESTORATION AND REPAIR AND SECTION 09900 PAINTING.

SECTION
SCALE : 1/2"=1'-0"

2


SECONDARY TRANSFER BOX

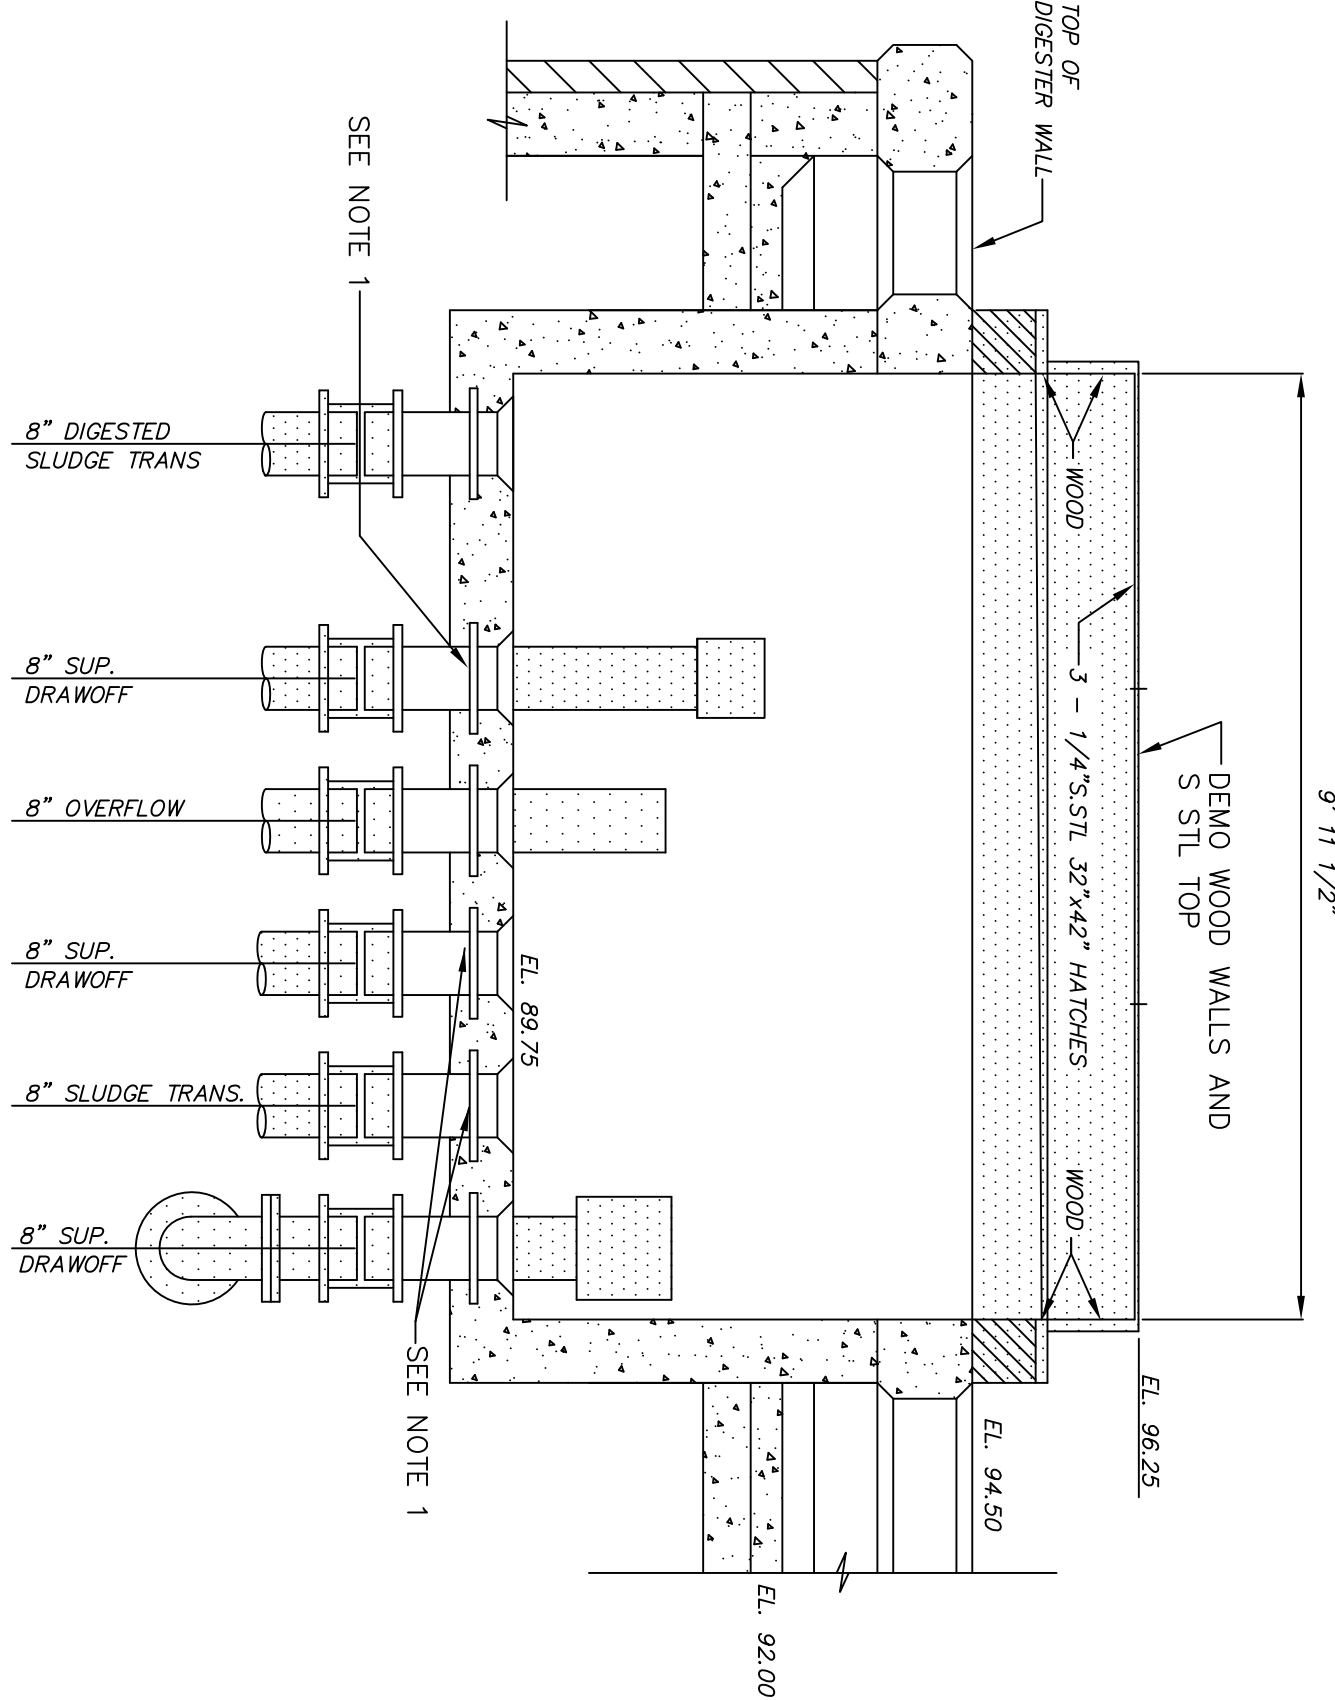

SECTION
SCALE : 1/2"=1'-0"

1

PRIMARY TRANSFER BOX

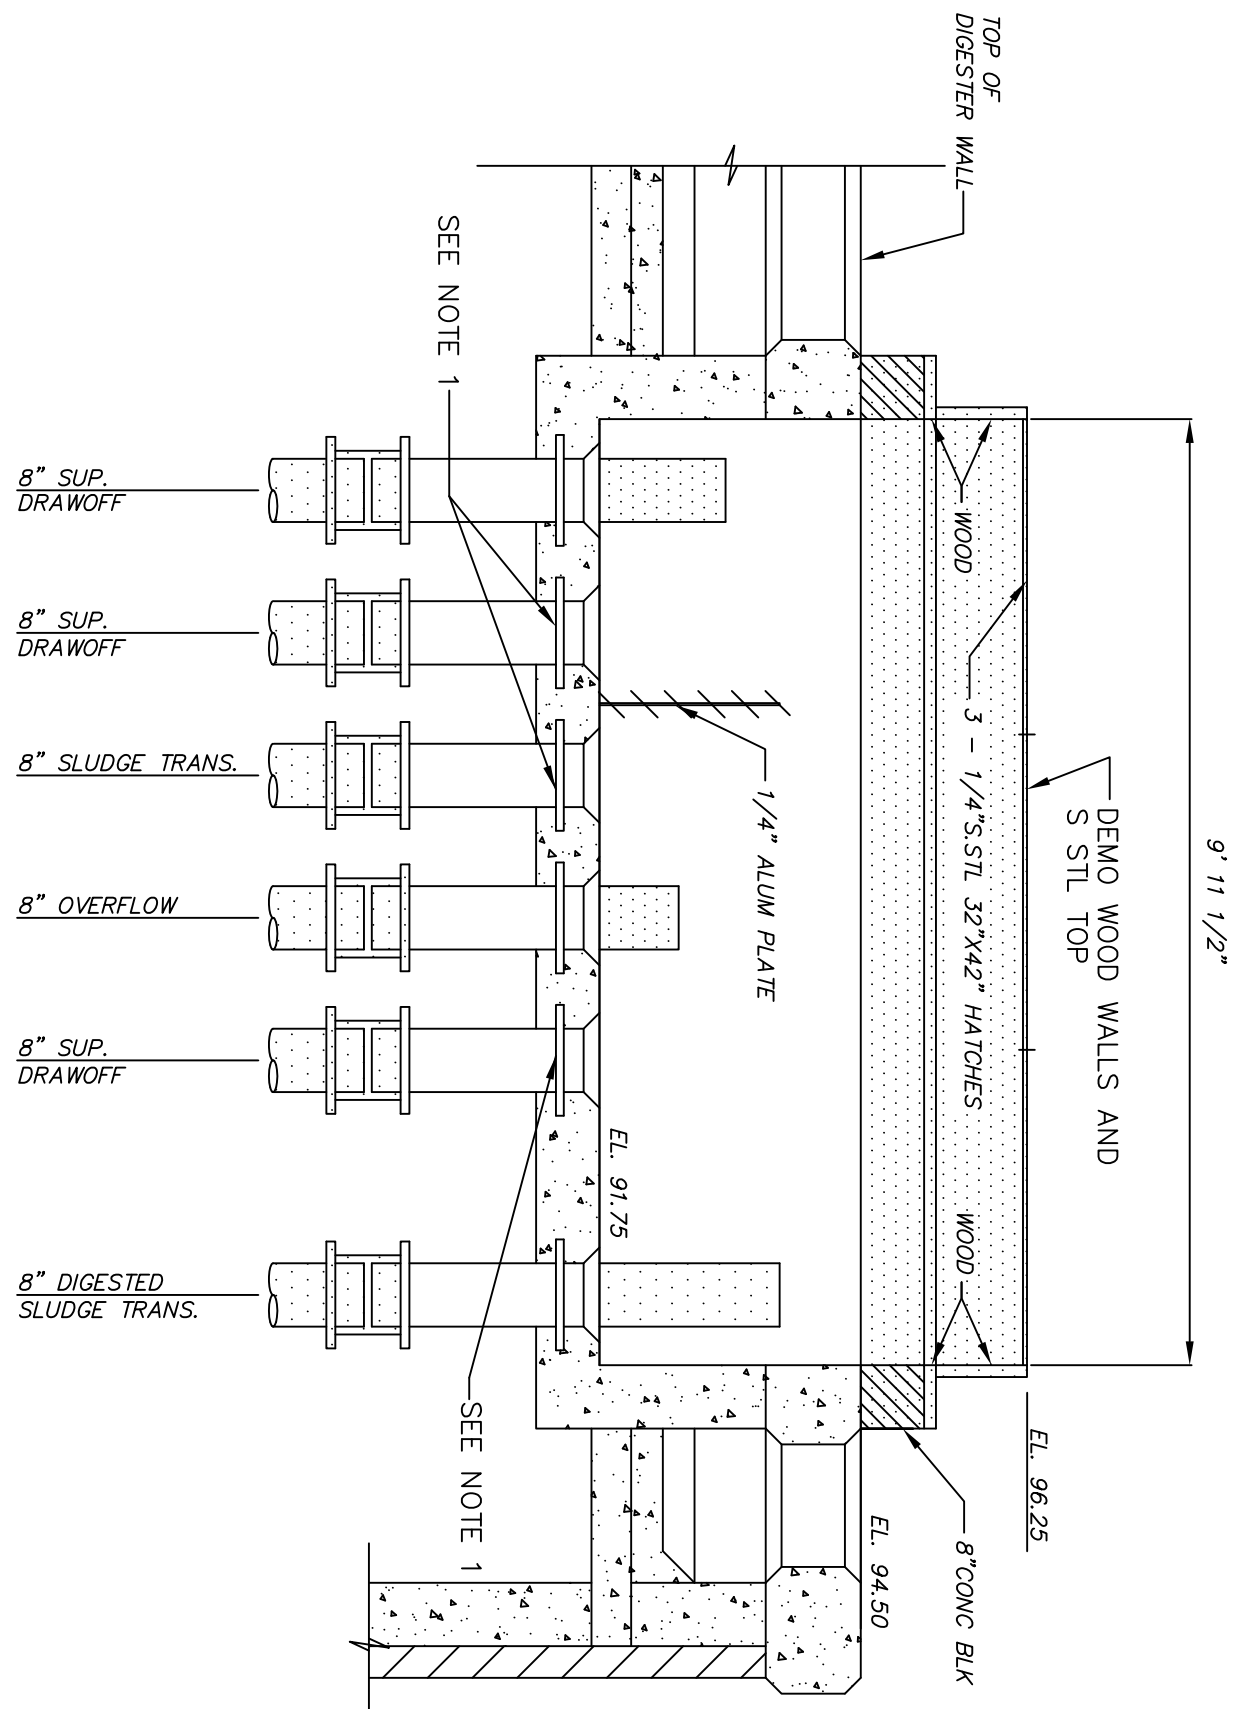

THESE RECORD DOCUMENTS HAVE BEEN PREPARED BASED ON INFORMATION PROVIDED BY OTHERS. CTE ENVIRONMENTAL HAS REVIEWED THE INFORMATION SUBMITTED AND BELIEVES IT REFLECTS THE WORK AS CONSTRUCTED. HOWEVER, ALL PERSONS SHALL VERIFY INFORMATION TAKEN FROM THIS DRAWING.



ENVIRONMENTAL, INC.
ENGINEERS IN WATER AND EARTH SCIENCES
UNIONTOWN, OHIO

CITY OF MASSILLON, OHIO
WWTP UPGRADE 2000
DIGESTER CONTROL BUILDING UPPER PLAN-DEMOLITION

DESIGNED BY PMK	REVISIONS				
	NO.	DESCRIPTIONS	DATE	BY	APP'D
DRAWN BY AJP	1	ADDENDUM NO. 1	9/12	RWR	WAD
	2	RECORD DRAWING	5/05	MGW	WAD
CHECKED BY RWR					
APPROVED BY WAD					

THIS DRAWING IS AN INSTRUMENT OF SERVICE OWNED BY CTE ENVIRONMENTAL, INC. WHICH SHALL BE DEEMED THE AUTHOR AND WHICH SHALL RETAIN ALL STATUTORY AND COMMON LAW RIGHTS, INCLUDING COPYRIGHTS. THIS DRAWING SHALL NOT BE SCANNED, COPIED, OR DISTRIBUTED TO OTHERS IN ANY FORM OR USED FOR ANY OTHER PURPOSE OR PROJECT WITHOUT PRIOR WRITTEN CONSENT OF CTE ENVIRONMENTAL, INC. CTE ENVIRONMENTAL, INC. CANNOT GUARANTEE THAT ELECTRONIC COPIES OF THIS DRAWING ARE EXACT DUPLICATES OF THE SEALED ORIGINAL DRAWING. IN THE EVENT OF A CONFLICT BETWEEN AN ELECTRONIC COPY AND THE SEALED ORIGINAL, THE SEALED ORIGINAL SHALL GOVERN.