




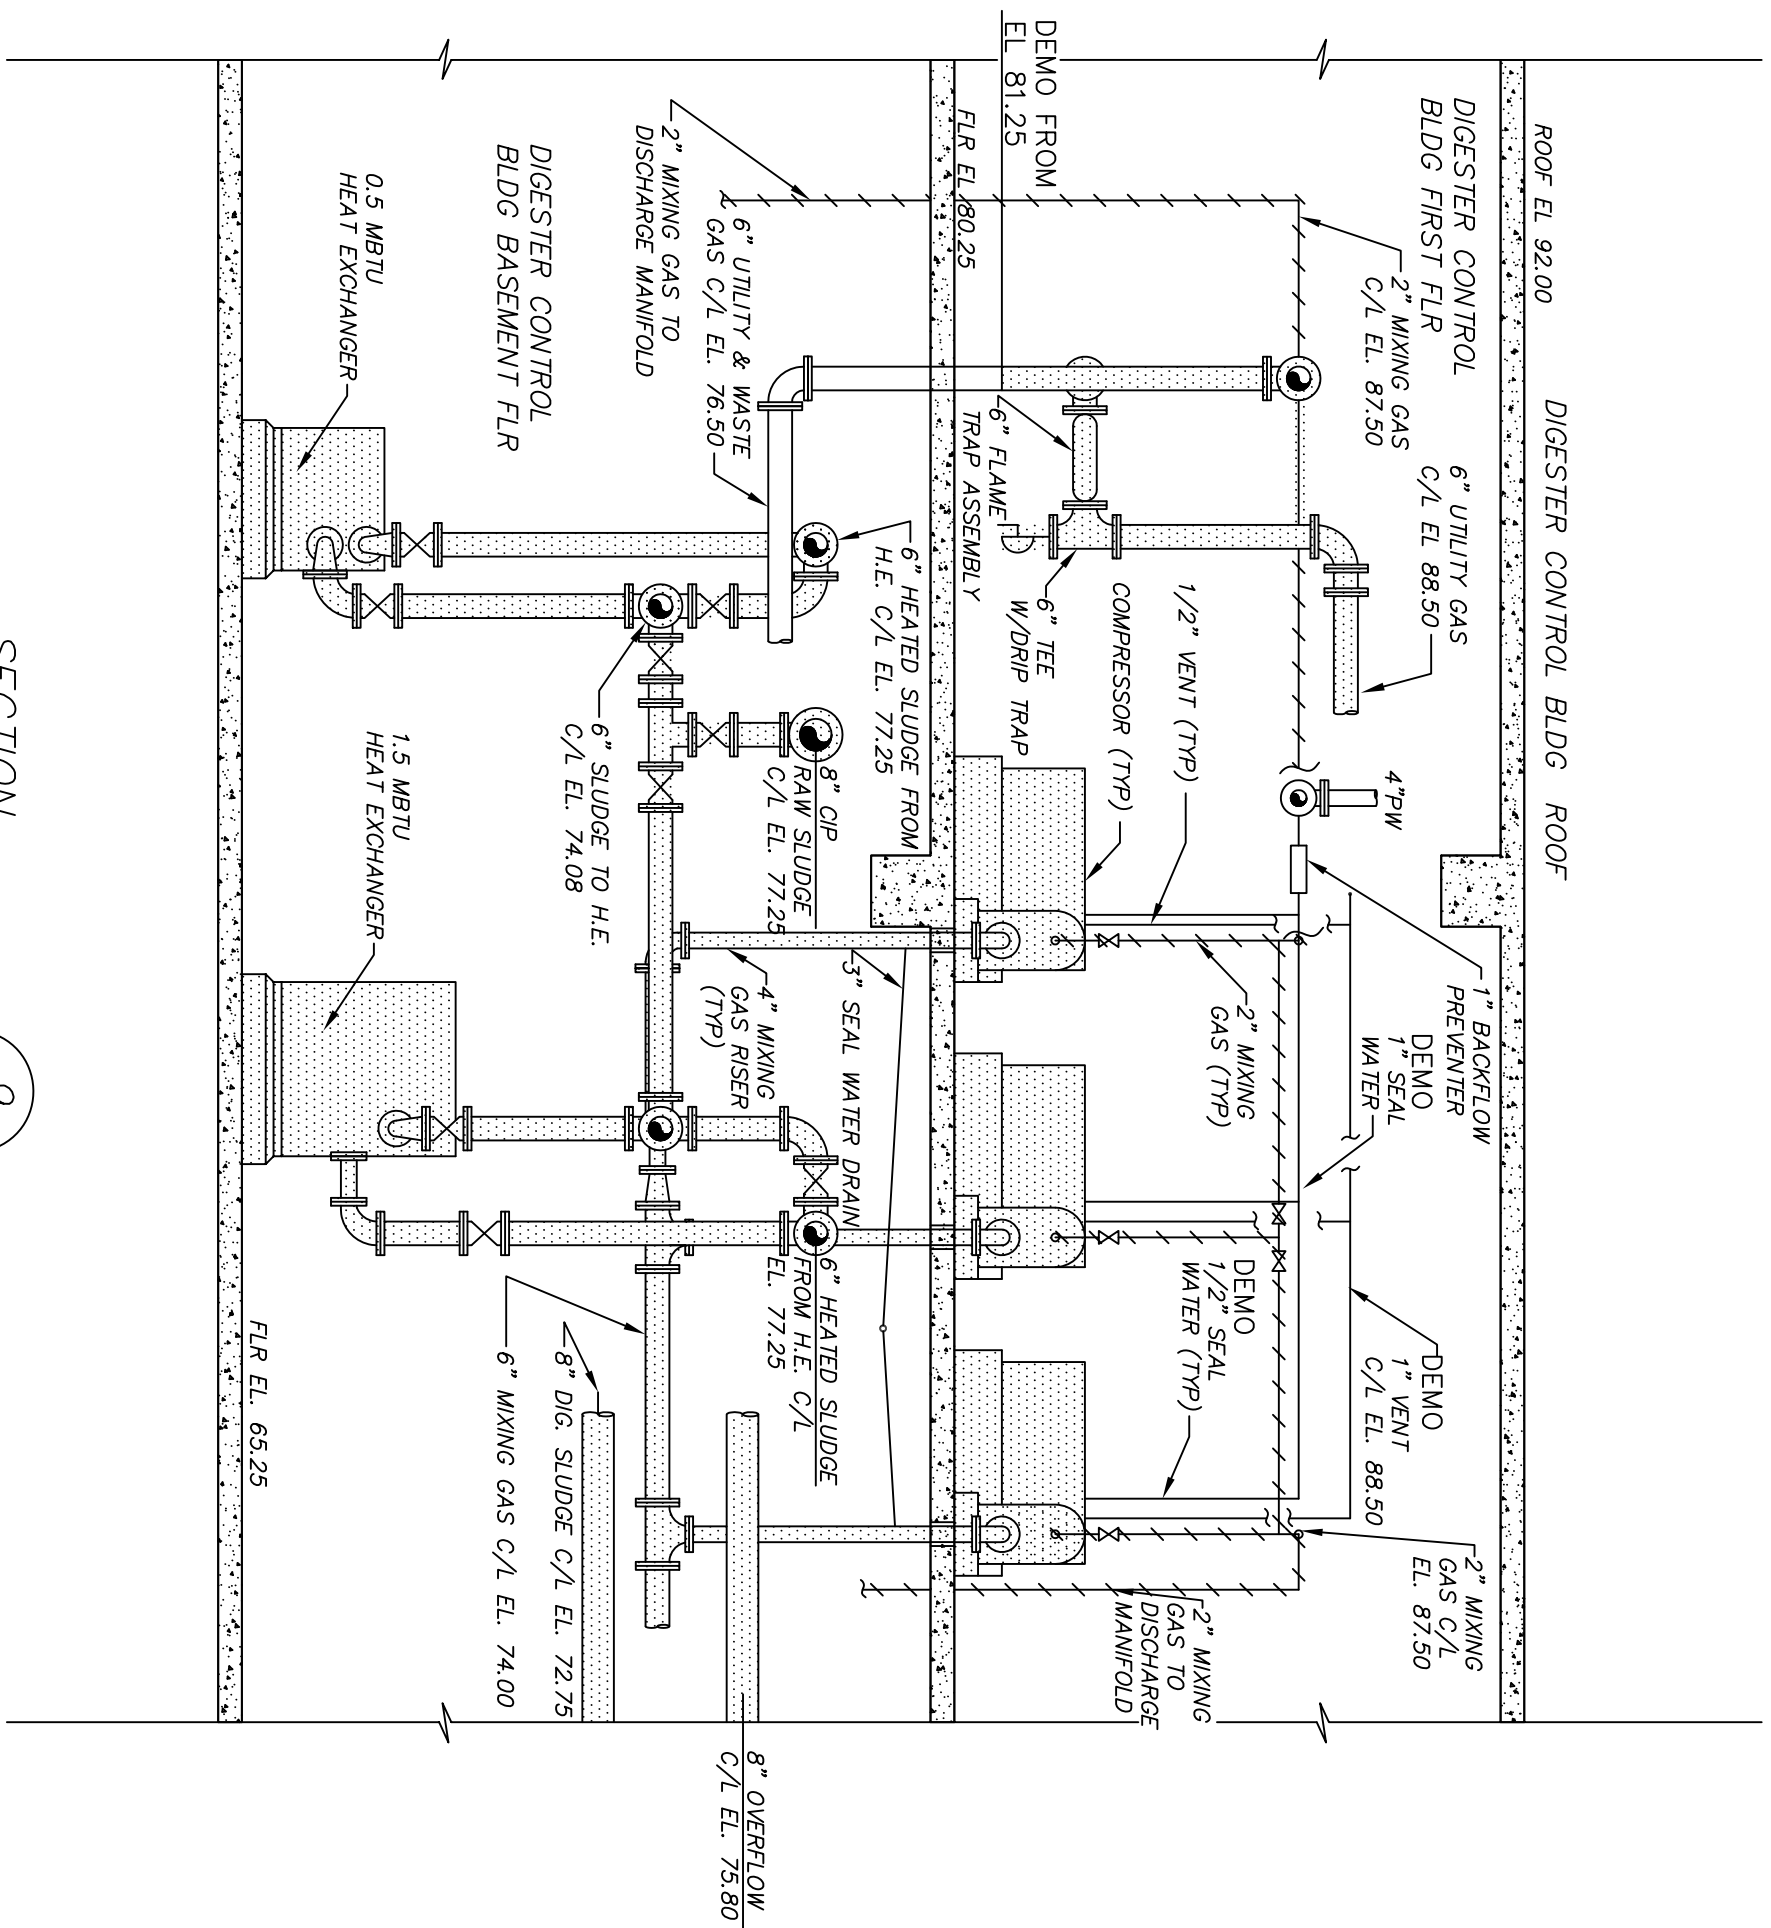


SECTION 9
SCALE : 1/4"=1'-0"
P115

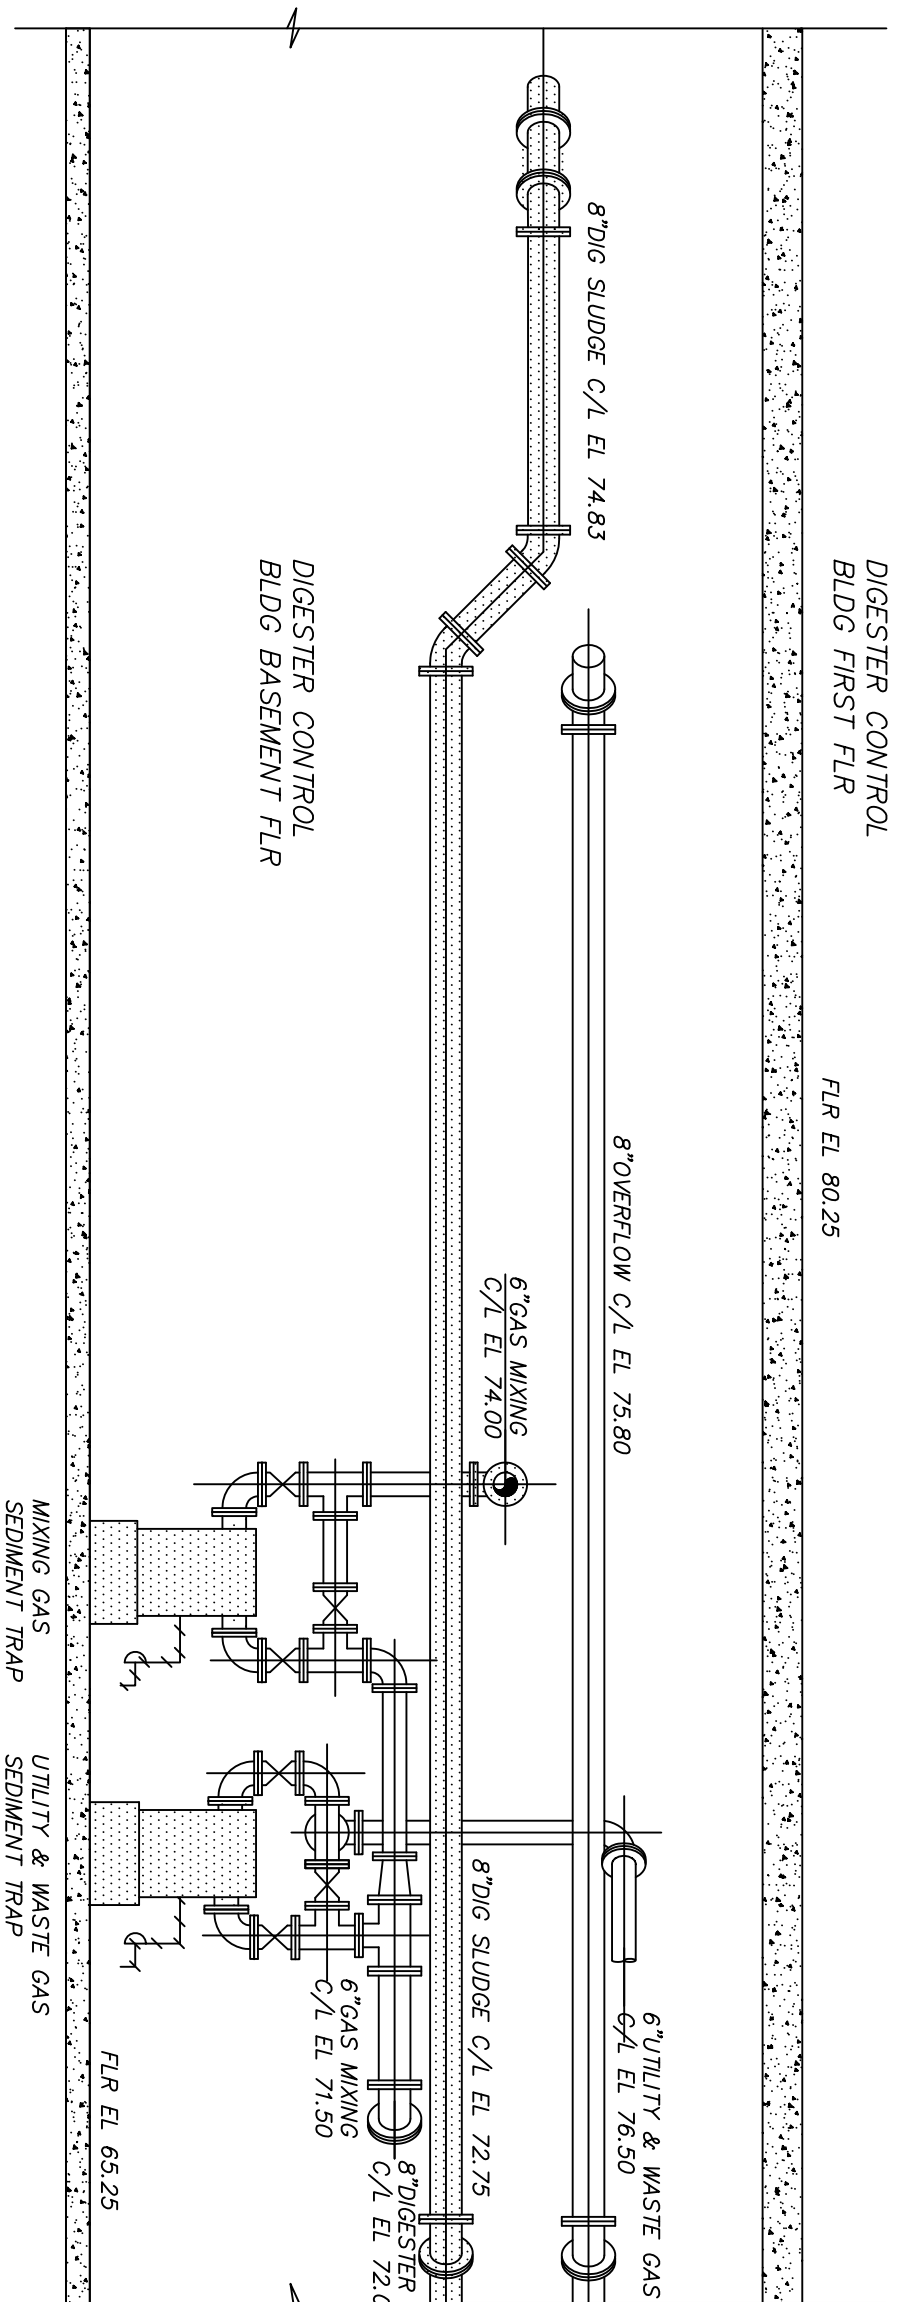

SECTION 3
SCALE: 1/4"=1'-0" P115

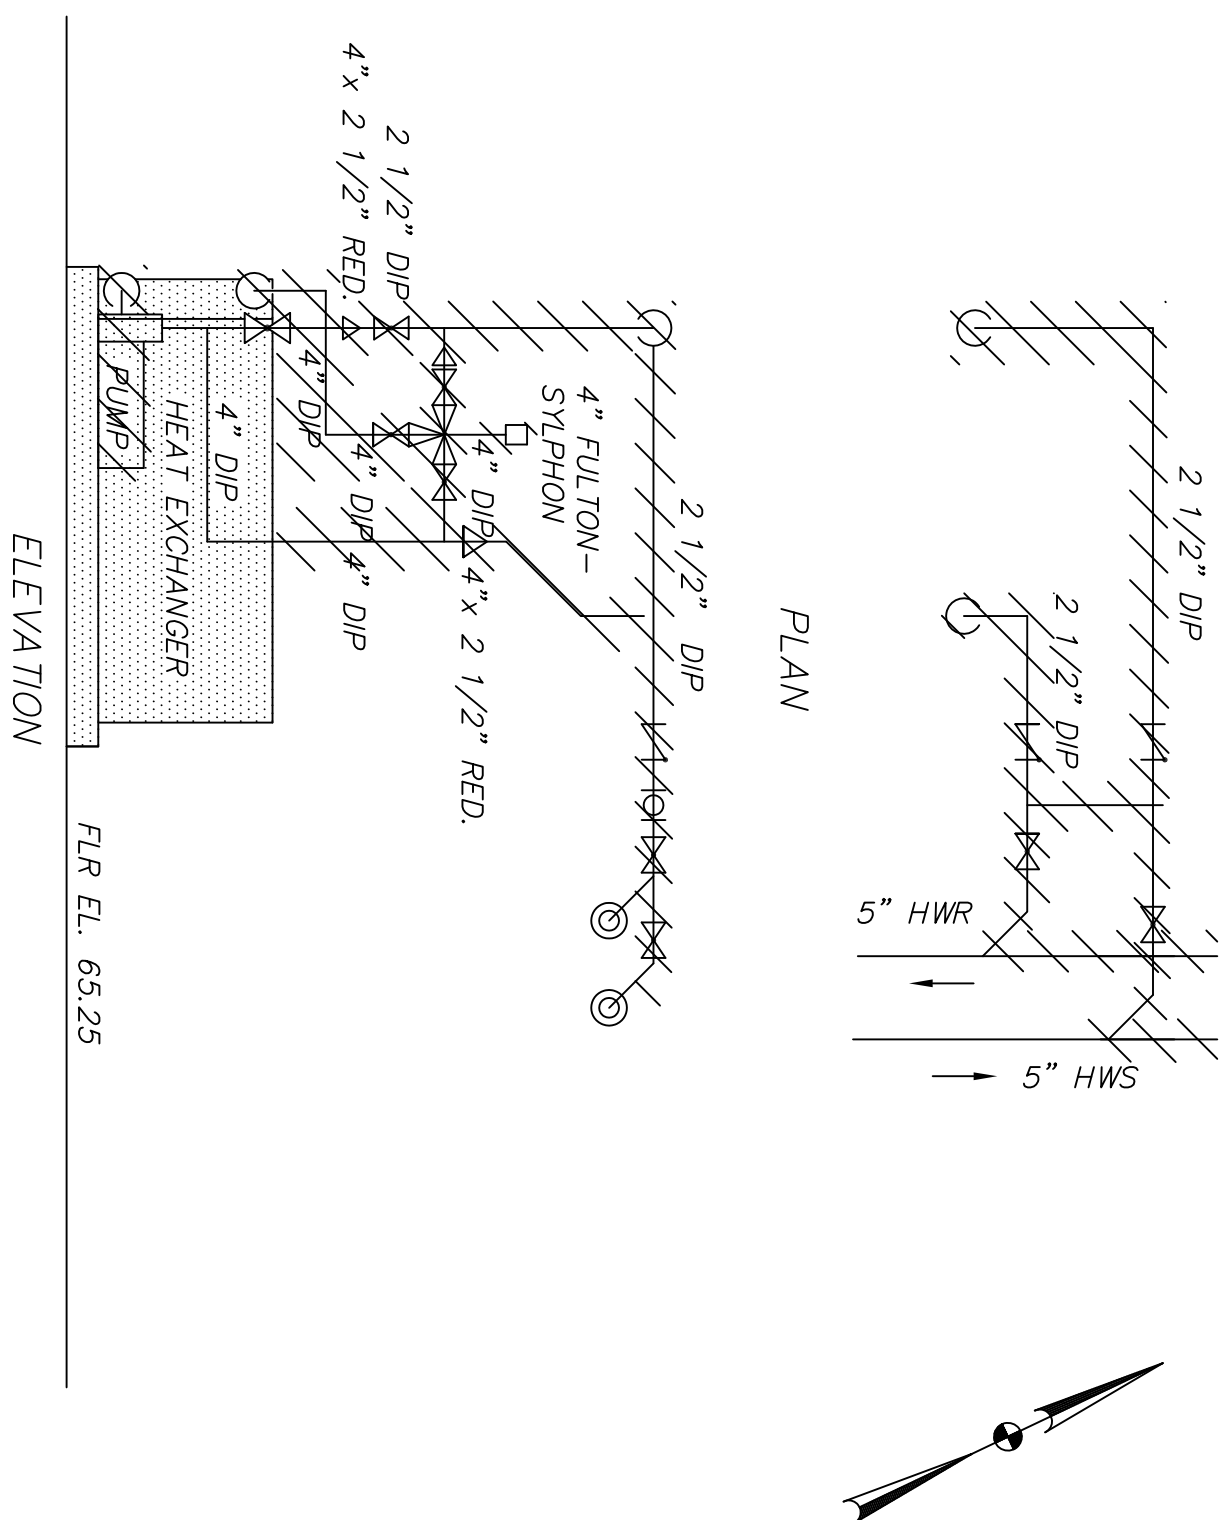


1.5 MBTU HEAT EXCHANGER-WATER PIPING DETAIL

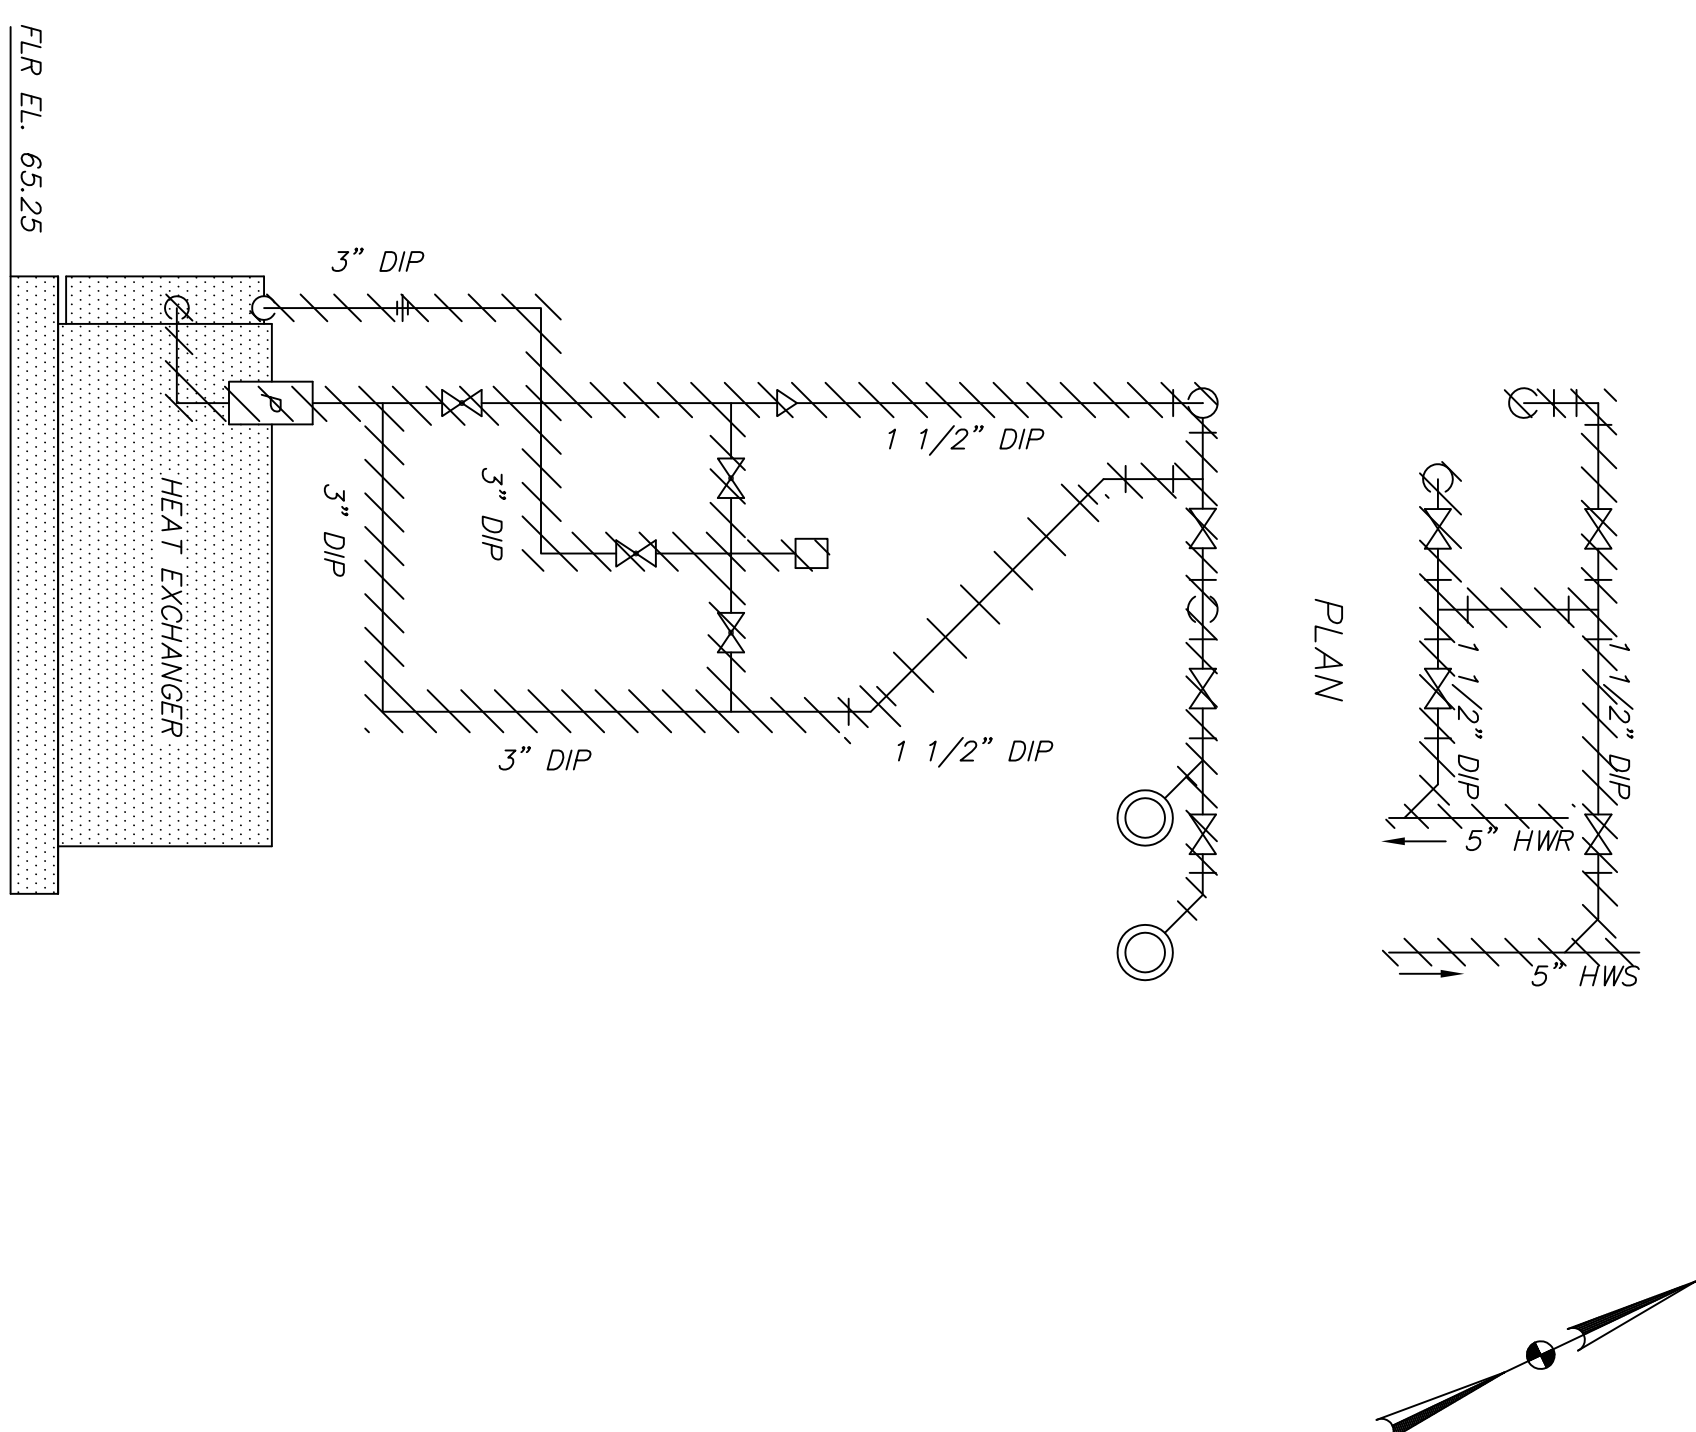

0.5 MBTU HEAT EXCHANGER – WATER PIPING DETAIL

SCALE : 1/2"=1'-0"

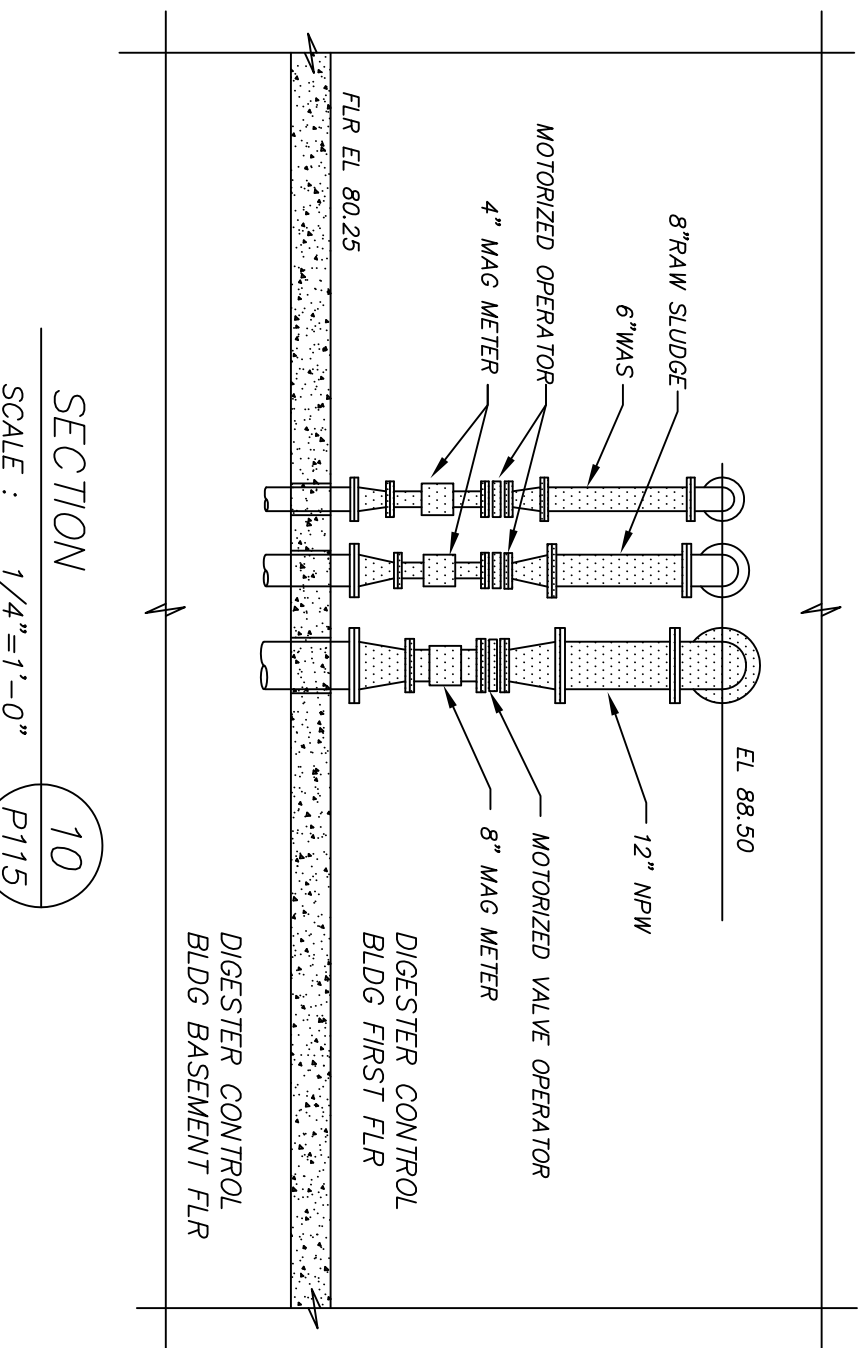

SECTION	10
SCALE : 1/4"=1'-0"	P115

ITEMS FOR DEMOLITION



THESE RECORD DOCUMENTS HAVE BEEN PREPARED BASED ON INFORMATION PROVIDED BY OTHERS. CH ENVIRONMENTAL HAS REVIEWED THE INFORMATION SUBMITTED AND BELIEVES IT REFLECTS THE WORK AS CONSTRUCTED. HOWEVER, ALL PERSONS SHALL VERIFY INFORMATION TAKEN FROM THIS DRAWING.

DESIGNED BY	REVISIONS				
PMK	NO.	DESCRIPTIONS	DATE	BY	APP'D
DRAWN BY	1	RECORD DRAWING	3/23	MGW	WAD
SAT/AJP					
CHECKED BY					
RWR					
APPROVED BY					
WAD					

THIS DRAWING IS AN INSTRUMENT OF SERVICE OWNED BY CTE ENVIRONMENTAL, INC. WHICH SHALL BE DEEMED THE AUTHOR AND WHICH SHALL RETAIN ALL STATUTORY AND COMMON LAW RIGHTS, INCLUDING COPYRIGHTS. THIS DRAWING SHALL NOT BE SCANNED, COPIED, OR REPRODUCED IN ANY FORM OR BY ANY MEANS FOR ANY OTHER PURPOSE OR PROJECT WITHOUT PRIOR WRITTEN CONSENT OF CTE ENVIRONMENTAL, INC. CTE ENVIRONMENTAL, INC. CANNOT GUARANTEE THAT ELECTRONIC COPIES OF THIS DRAWING ARE EXACT DUPLICATES OF THE SEALED ORIGINAL DRAWING. THE INTENT OF THIS CONTRACT BETWEEN CTE ELECTRONIC COPY AND THE SEALED ORIGINAL, OR SEALED ORIGINAL, SHALL GOVERN.