


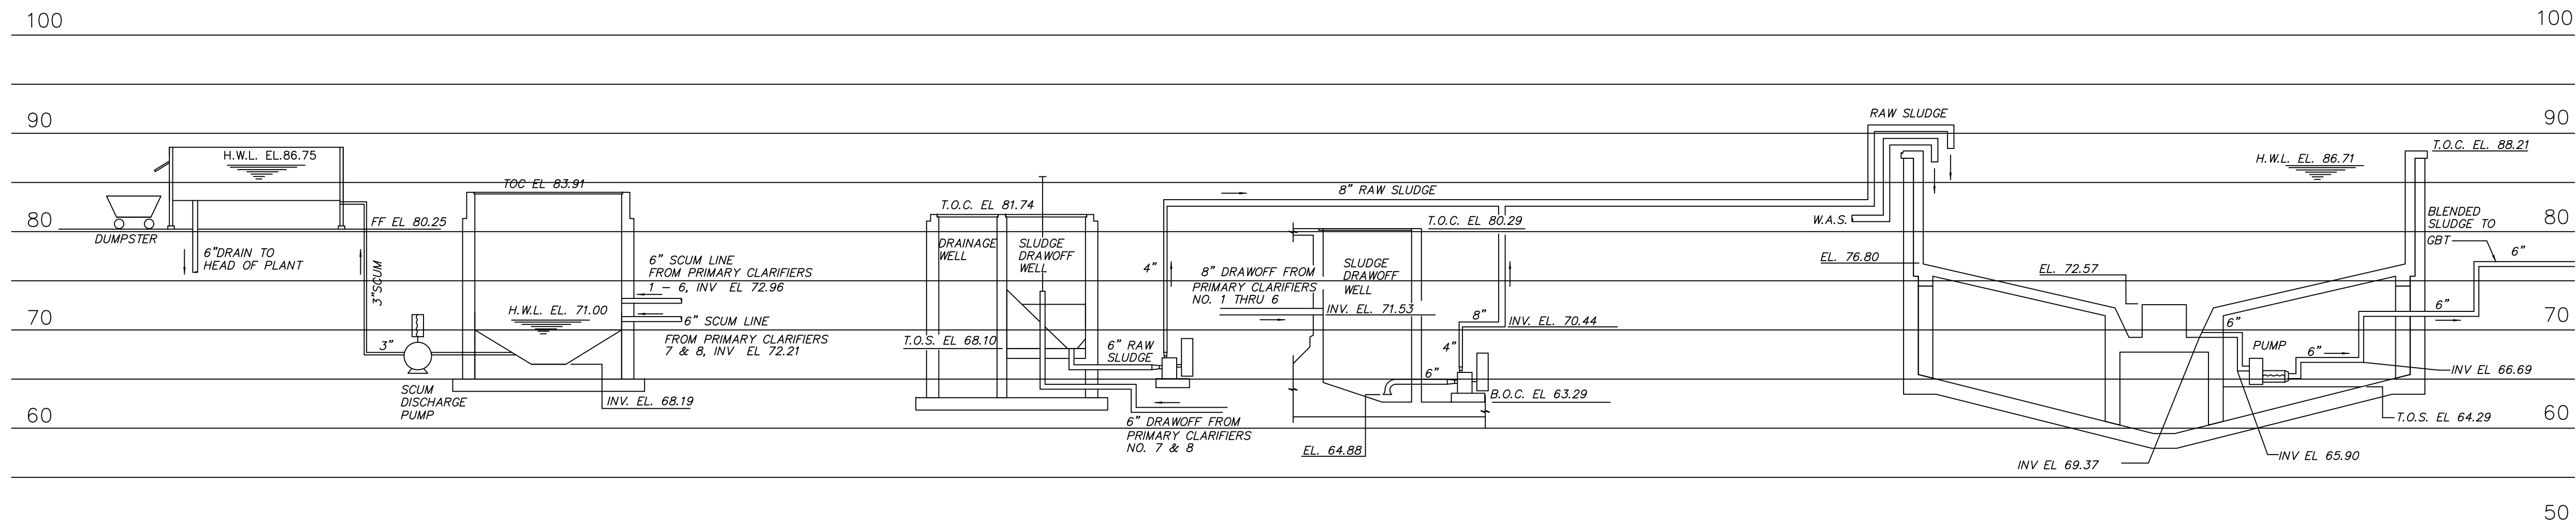

SCUM
CONCENTRATOR

SCUM WELL

PRIMARY SLUDGE
BUILDING NO. 2


PRIMARY SLUDGE
BUILDING NO. 1

SLUDGE BLENDING TANKS

LEGEND:

- B.F.P. BELT FILTER PRESS
EL. ELEVATION
F.F. FINISHED FLOOR
G.B.T. GRAVITY BELT THICKENER
H.W.L. HIGH WATER LEVEL
INV. INVERT
T.O.C. TOP OF CONCRETE
T.O.S. TOP OF SLAB
T.W. TOP OF WEIR

SCALE:
HORIZONTAL: NOT TO SCALE
VERTICAL: 1" = 10'

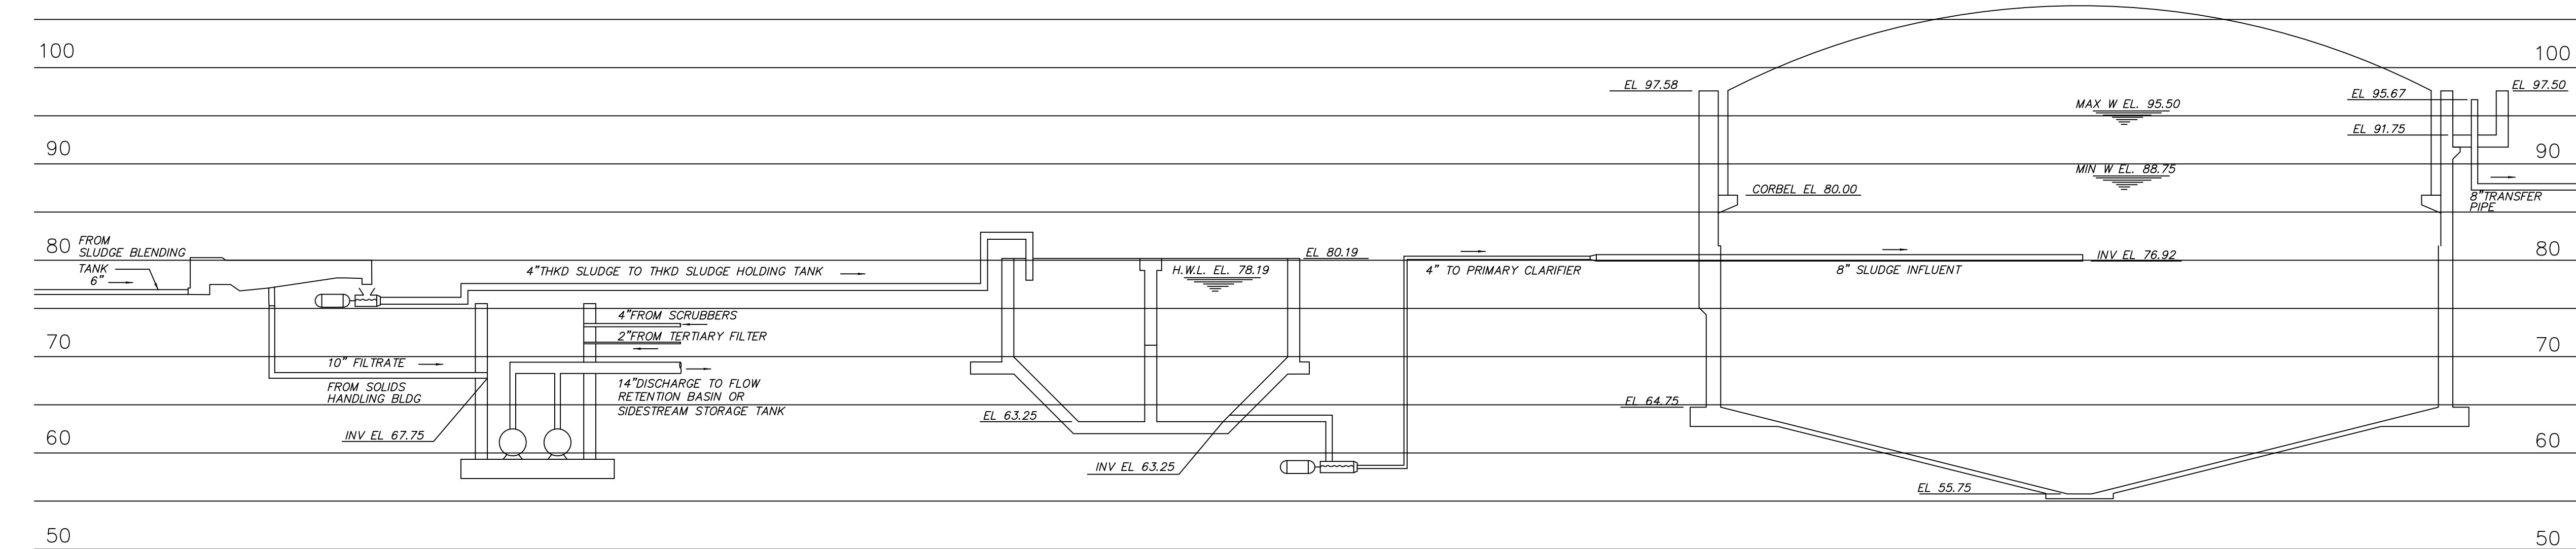


GRAVITY BELT THICKENER

BACKWASH AND FILTRATE
PUMP STATION

THICKENED
SLUDGE HOLDING TANK

PRIMARY ANAEROBIC DIGESTER

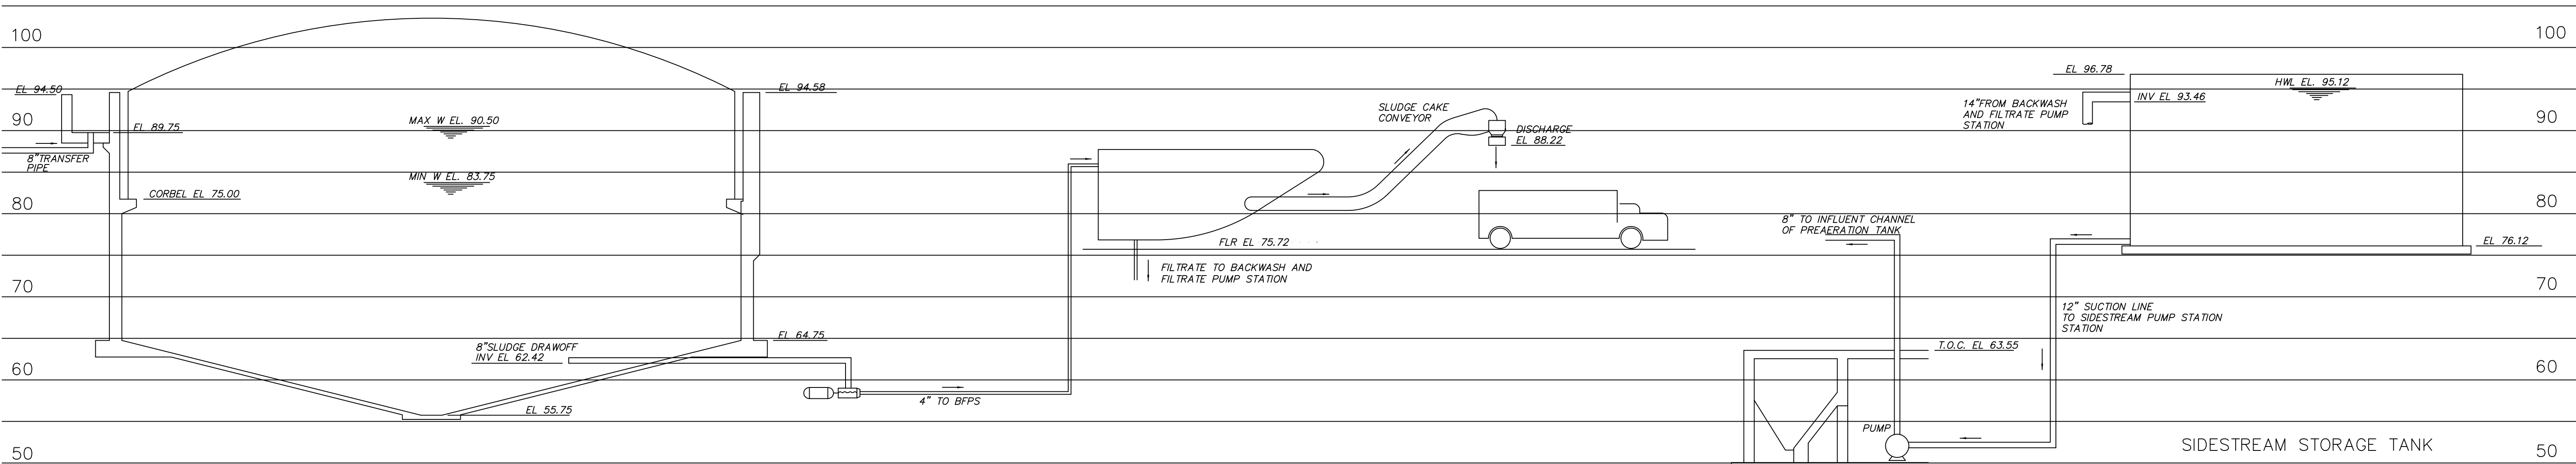

SECONDARY ANAEROBIC DIGESTER

BELT FILTER
PRESS

SIDESTREAM
PUMP STATION

SIDESTREAM STORAGE TANK

THESE RECORD DOCUMENTS HAVE BEEN PREPARED
BASED ON INFORMATION PROVIDED BY OTHERS. CTI
ENVIRONMENTAL HAS REVIEWED THE INFORMATION
SUBMITTED AND BELIEVES IT REFLECTS THE WORK AS
CONSTRUCTED. HOWEVER, ALL PERSONS SHALL
VERIFY INFORMATION TAKEN FROM THIS DRAWING.

THIS DRAWING IS AN INSTRUMENT OF SERVICE OWNED
BY CTI ENVIRONMENTAL, INC. WHICH SHALL BE DEEMED
THE AUTHOR AND WHICH SHALL RETAIN ALL STATUTORY
RIGHTS. THIS DRAWING SHALL NOT BE REPRODUCED, COPIED, OR
IN ANY MANNER FOR ANY OTHER PURPOSE OR PROJECT WITHOUT THE
WRITTEN CONSENT OF CTI ENVIRONMENTAL, INC. THAT
ELECTRONIC COPIES OF THIS DRAWING ARE EXACT
DUPLICATES OF THE SEALED ORIGINAL DRAWING. NO
COPY AND THE SEALED ORIGINAL SHALL GOVERN.

DESIGNED BY	RWR	DATE	BY	REVISIONS			
				NO.	DESCRIPTIONS	DATE	BY
1	AJP	4/05	RWR	1	ADDENDUM NO. 1	9/12	WAD
				2	RECORD DRAWING	4/05	WAD
CHECKED BY	RWR						
APPROVED BY	WAD						

ENVIRONMENTAL, INC.
ENGINEERS IN WATER AND EARTH SCIENCES
UNCINTOWN, OHIO

CITY OF MASSILLON, OHIO
WWTP UPGRADE 2000
SOLID - HYDRAULIC PROFILE

JOB NO. E9031
DATE 08/13/01
SCALE AS NOTED
SHEET P12