

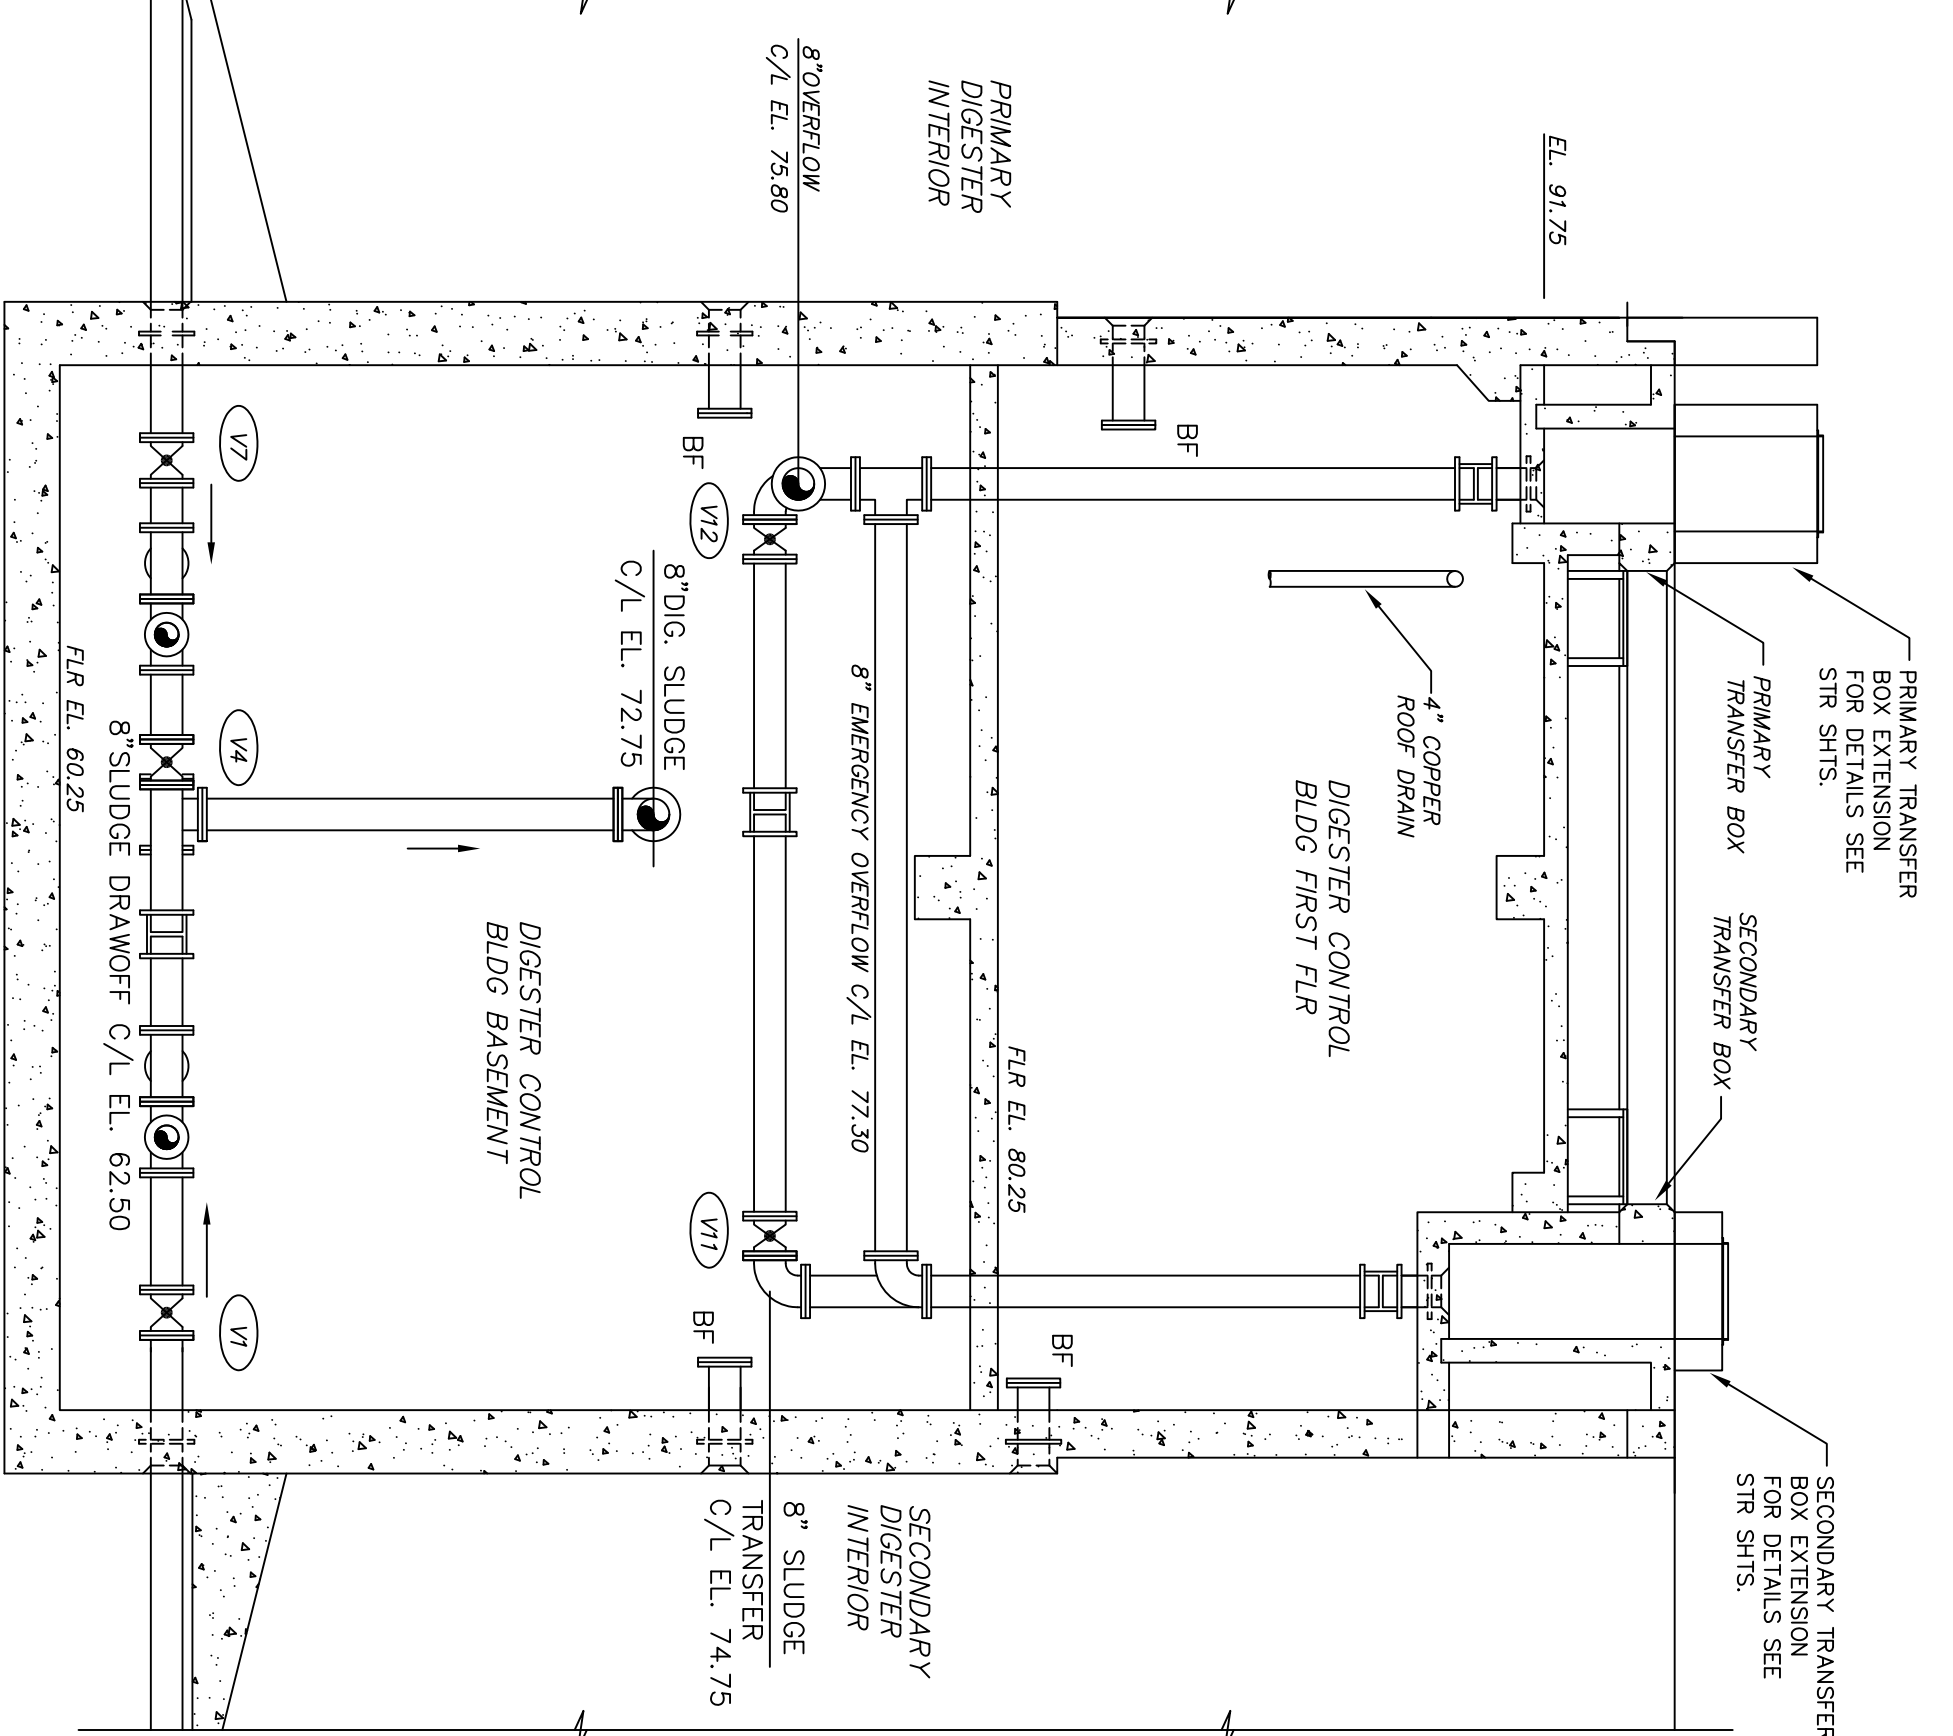
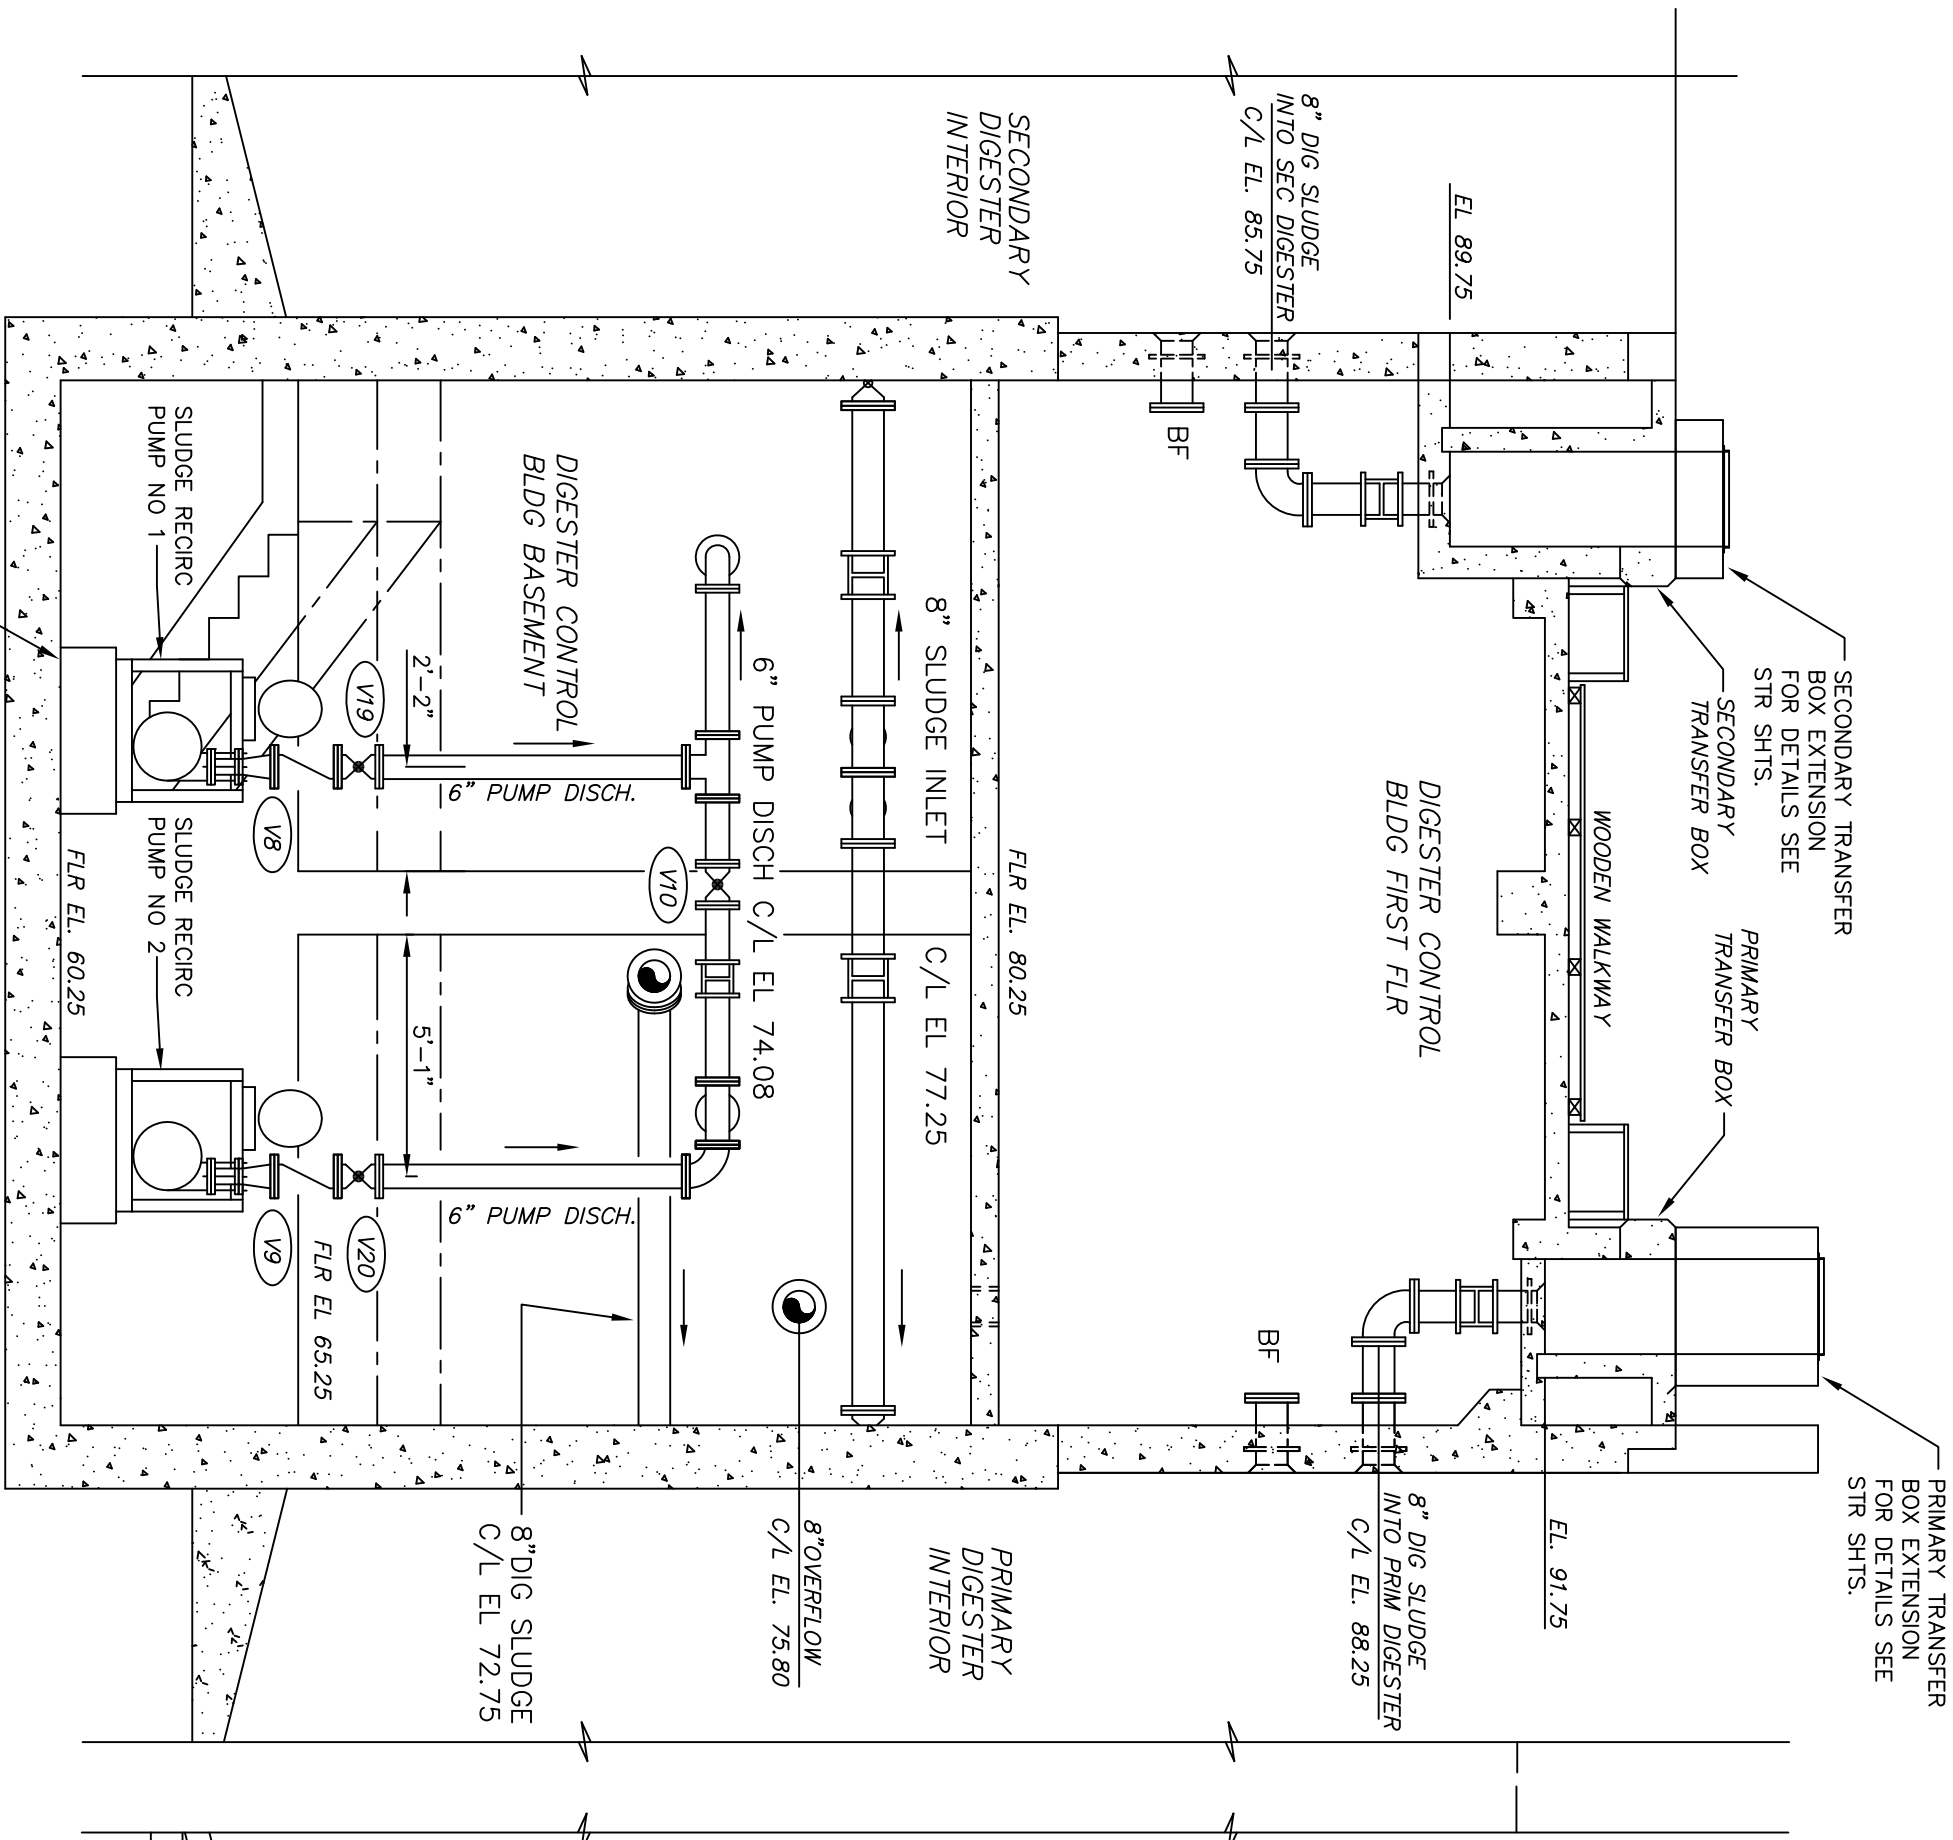
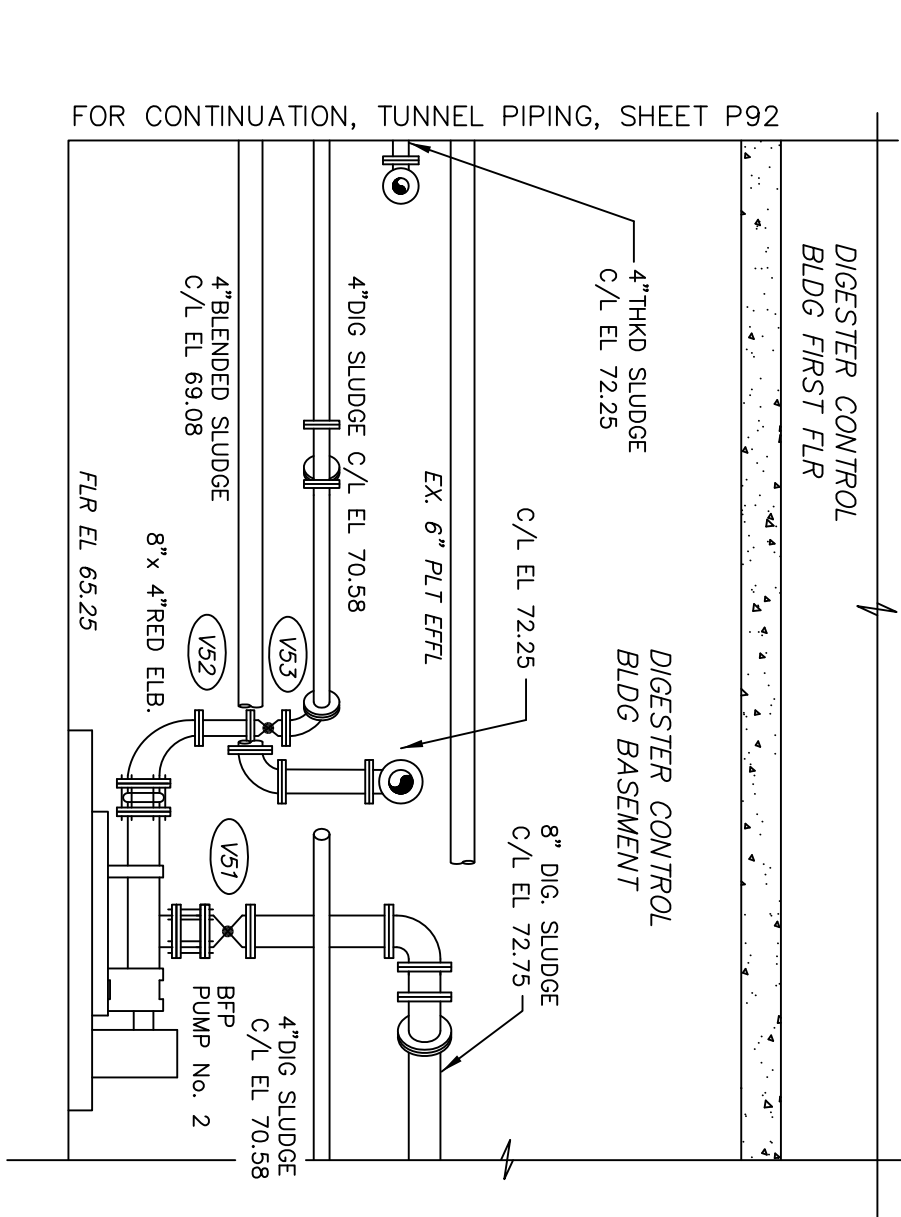
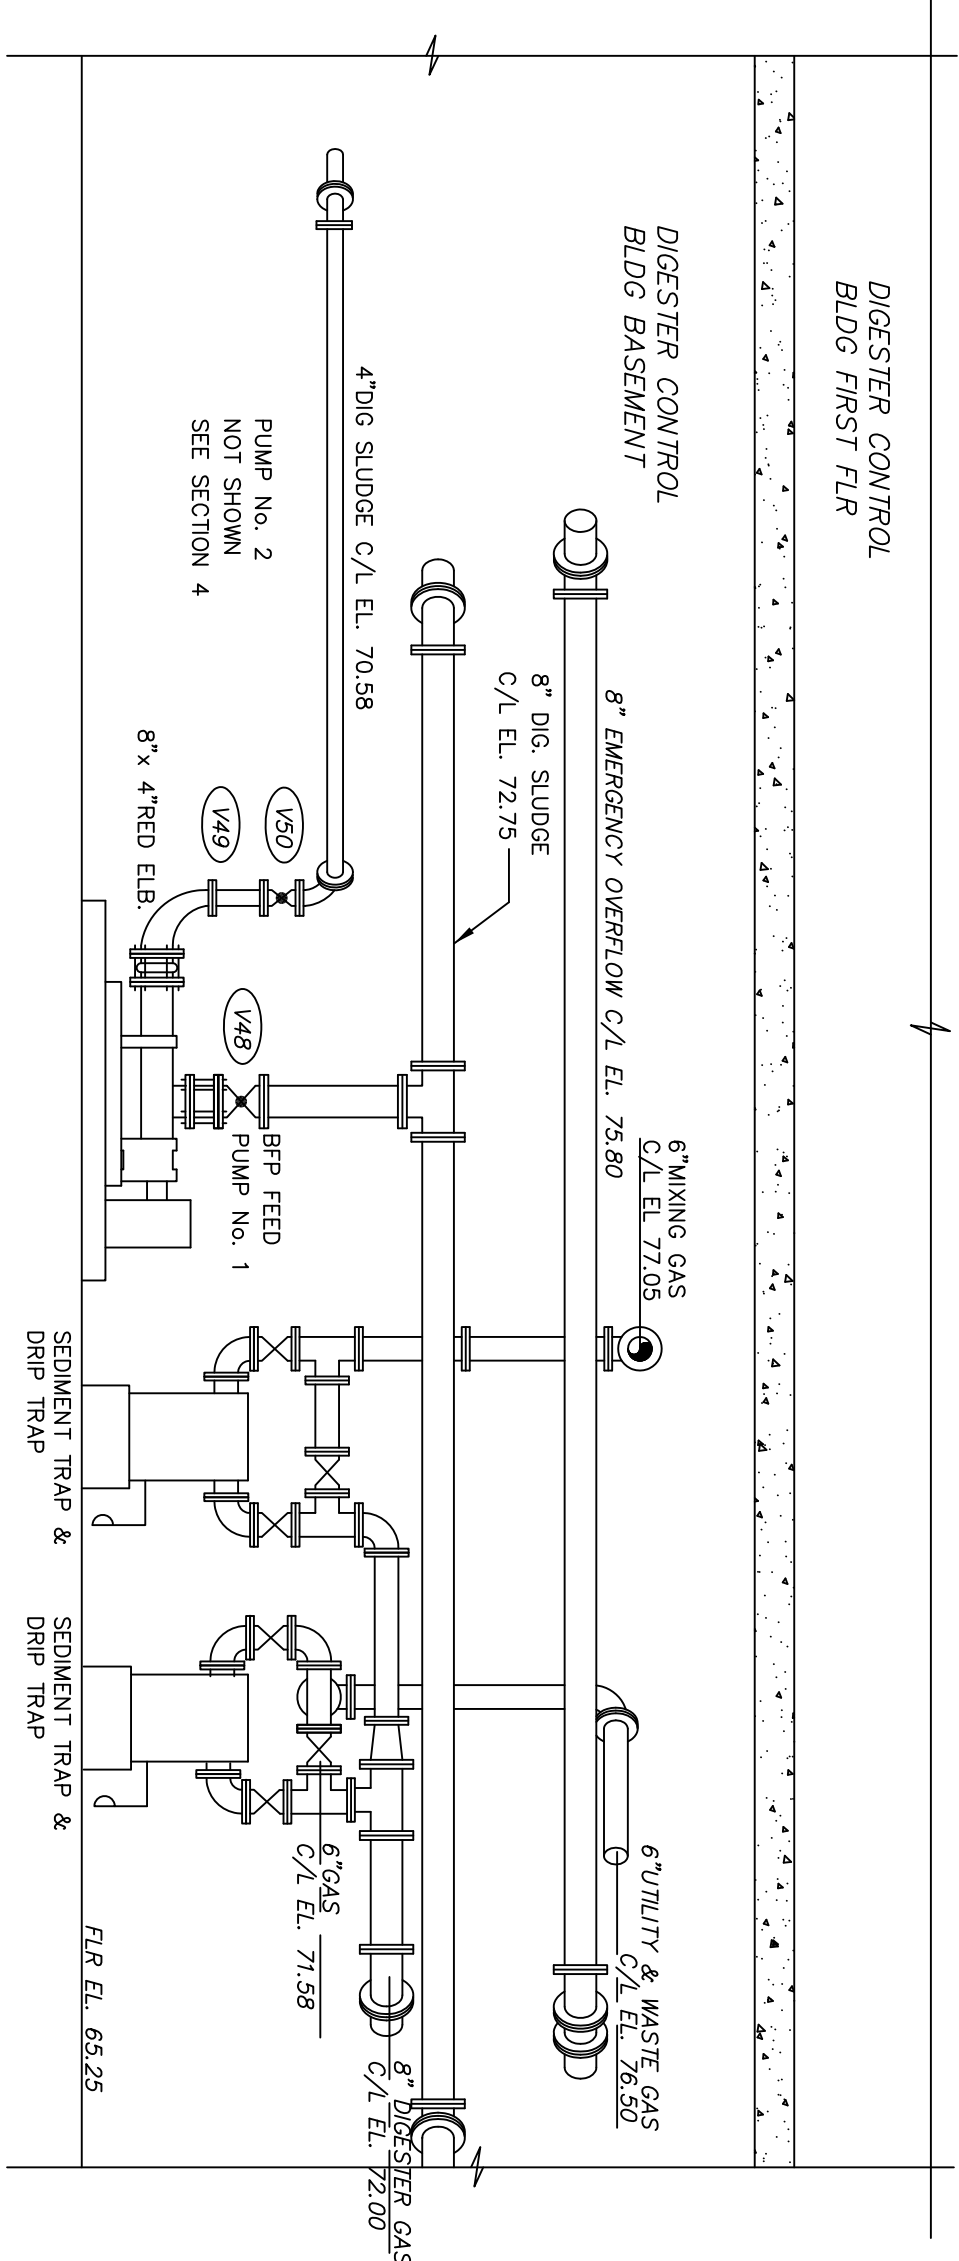


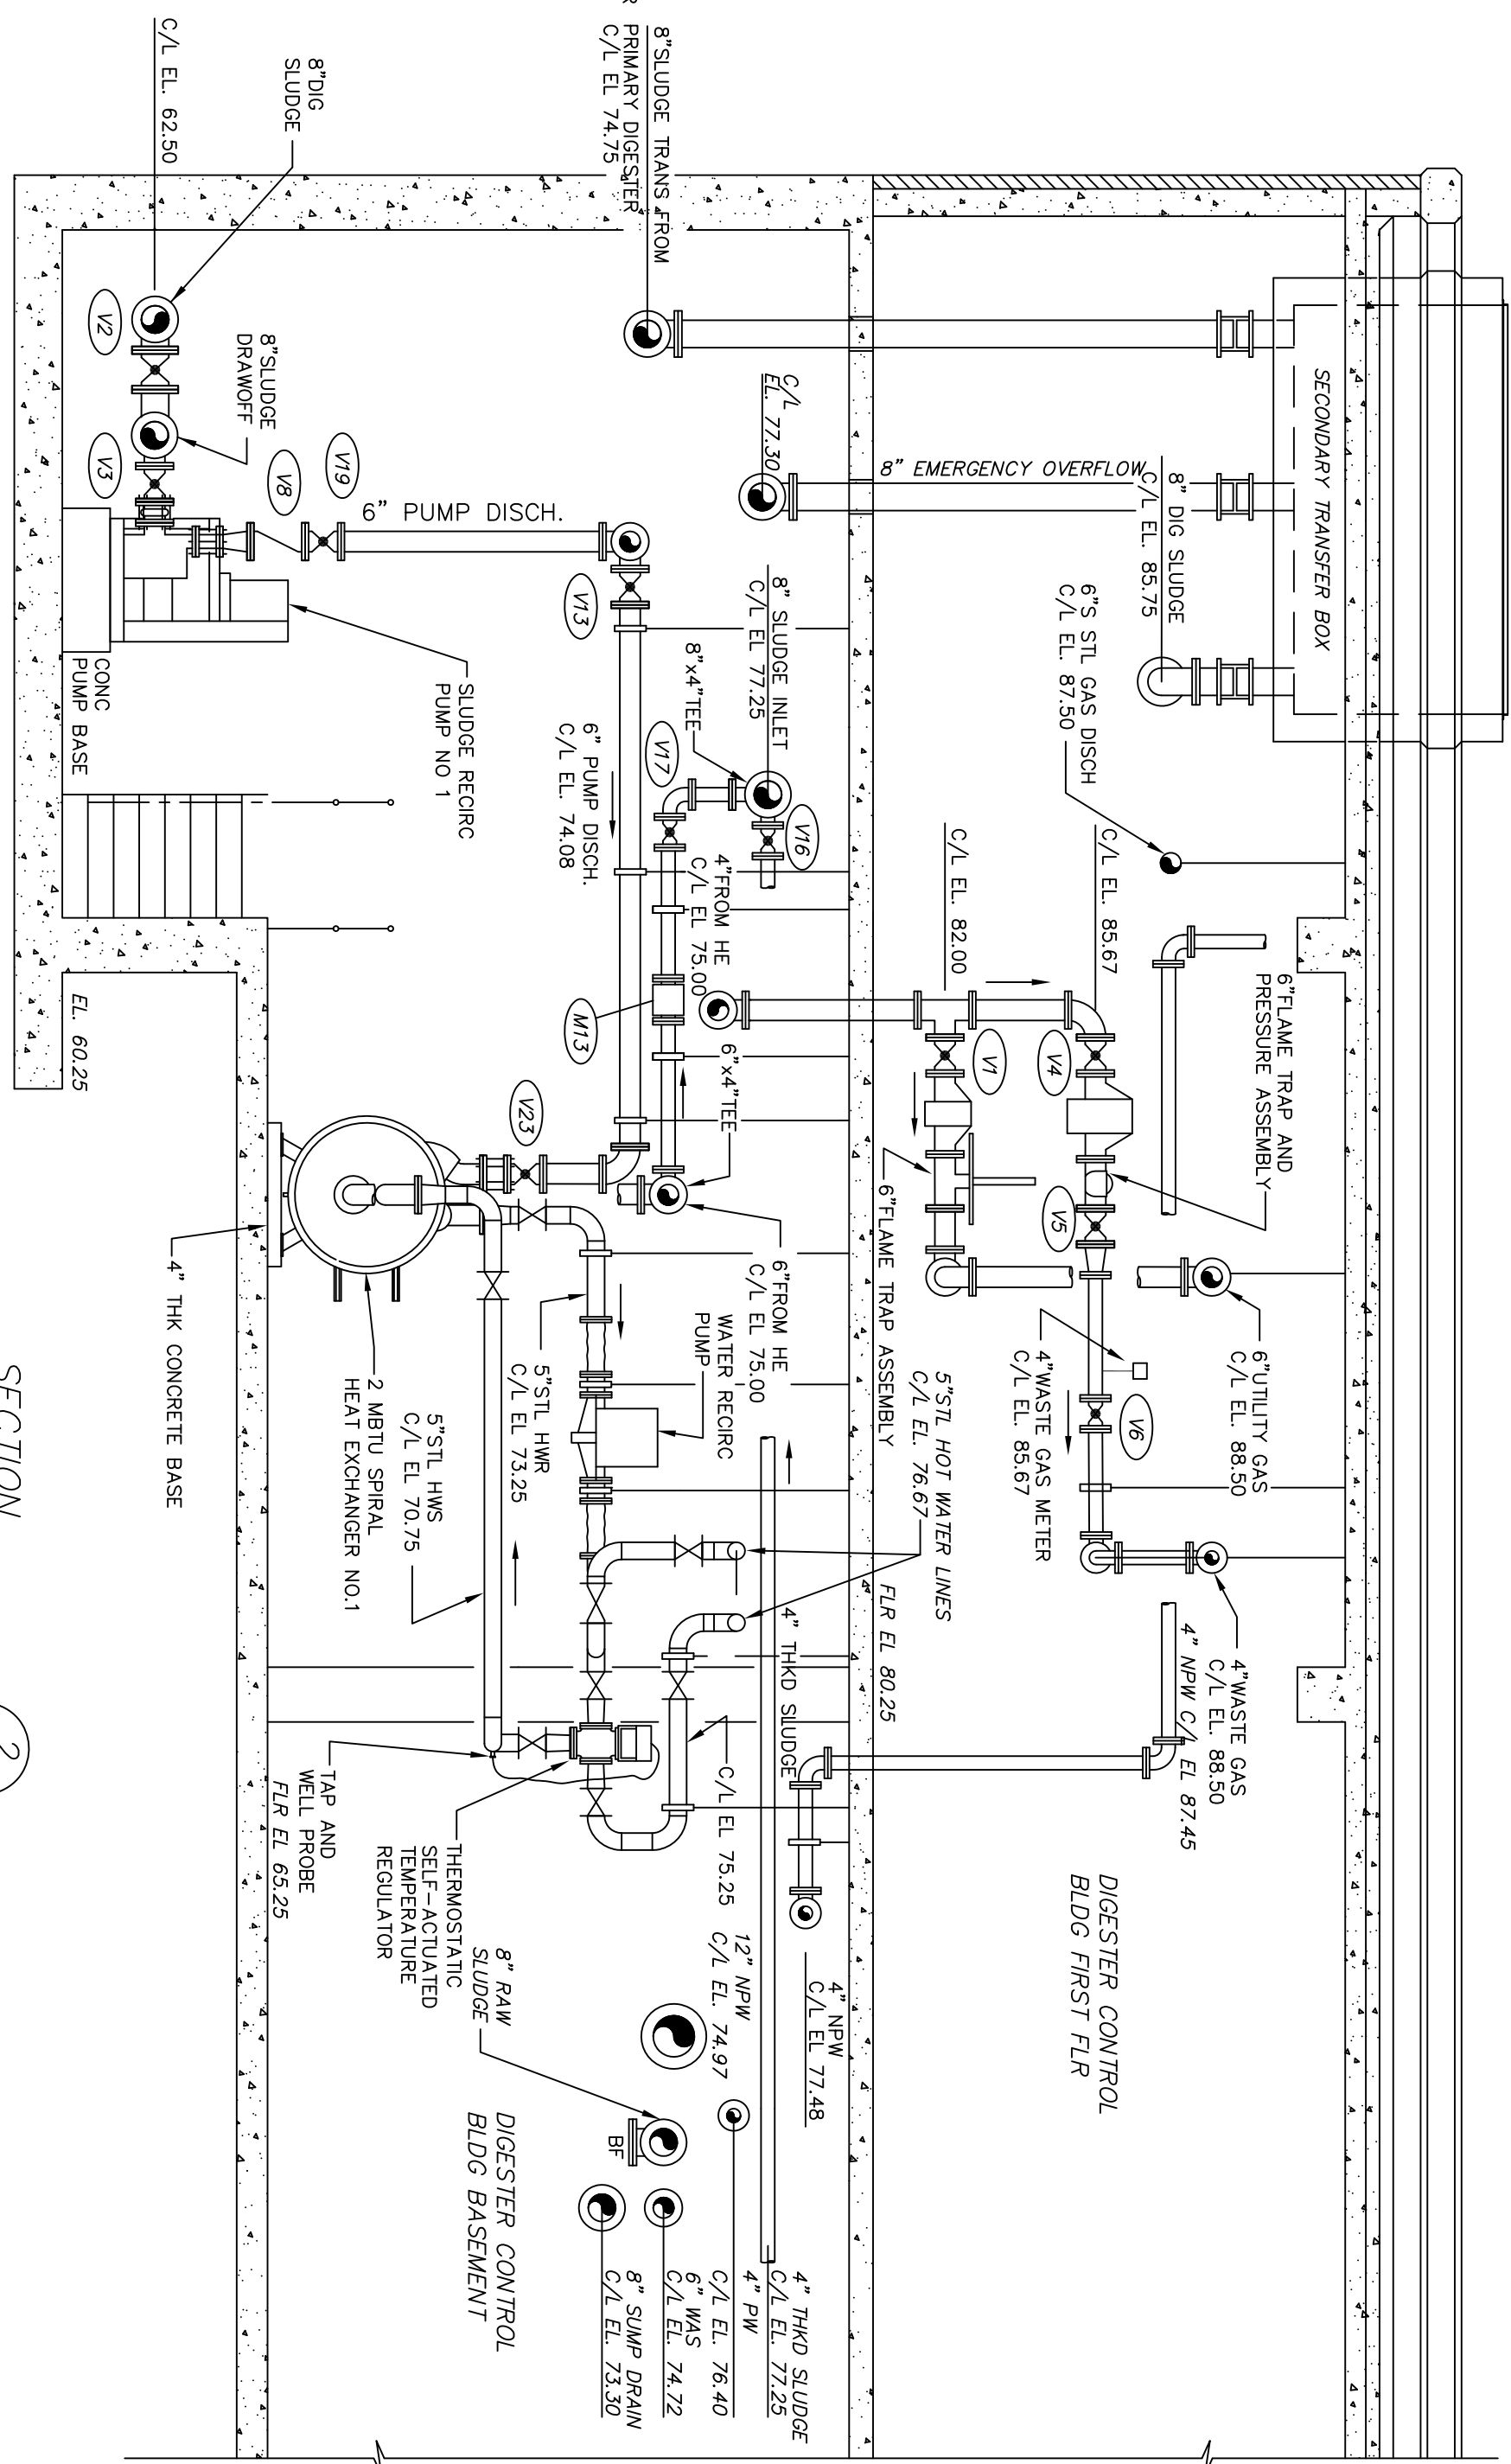

THIS DRAWING IS AN INSTRUMENT OF SERVICE OWNED BY CTE ENVIRONMENTAL, INC. WHICH SHALL BE DEEMED THE AUTHOR AND WHICH SHALL RETAIN ALL STATUTORY AND COMMON LAW RIGHTS, INCLUDING COPYRIGHTS. THIS DRAWING SHALL NOT BE SCANNED, COPIED, OR DISTRIBUTED TO OTHERS IN ANY FORM OR USED FOR ANY OTHER PURPOSES OR PROJECT WITHOUT PRIOR WRITTEN CONSENT OF CTE ENVIRONMENTAL, INC. CTE ENVIRONMENTAL, INC. CANNOT GUARANTEE THAT ELECTRONIC COPIES OF THIS DRAWING ARE EXACT DUPLICATES OF THE SEALED ORIGINAL DRAWING. IN THE EVENT OF A CONFLICT BETWEEN AN ELECTRONIC COPY AND THE SEALED ORIGINAL, THE SEALED ORIGINAL SHALL GOVERN.

REVISIONS					
NO.	DESCRIPTIONS	DATE	BY	APP'D	
1	ADDENDUM NO. 1	9/12	RWR	WAD	
2	RECORD DRAWING	6/05	MGW	WAD	
DESIGNED BY PMK/AJP					
DRAWN BY AJP					
CHECKED BY RWR					
APPROVED BY WAD					

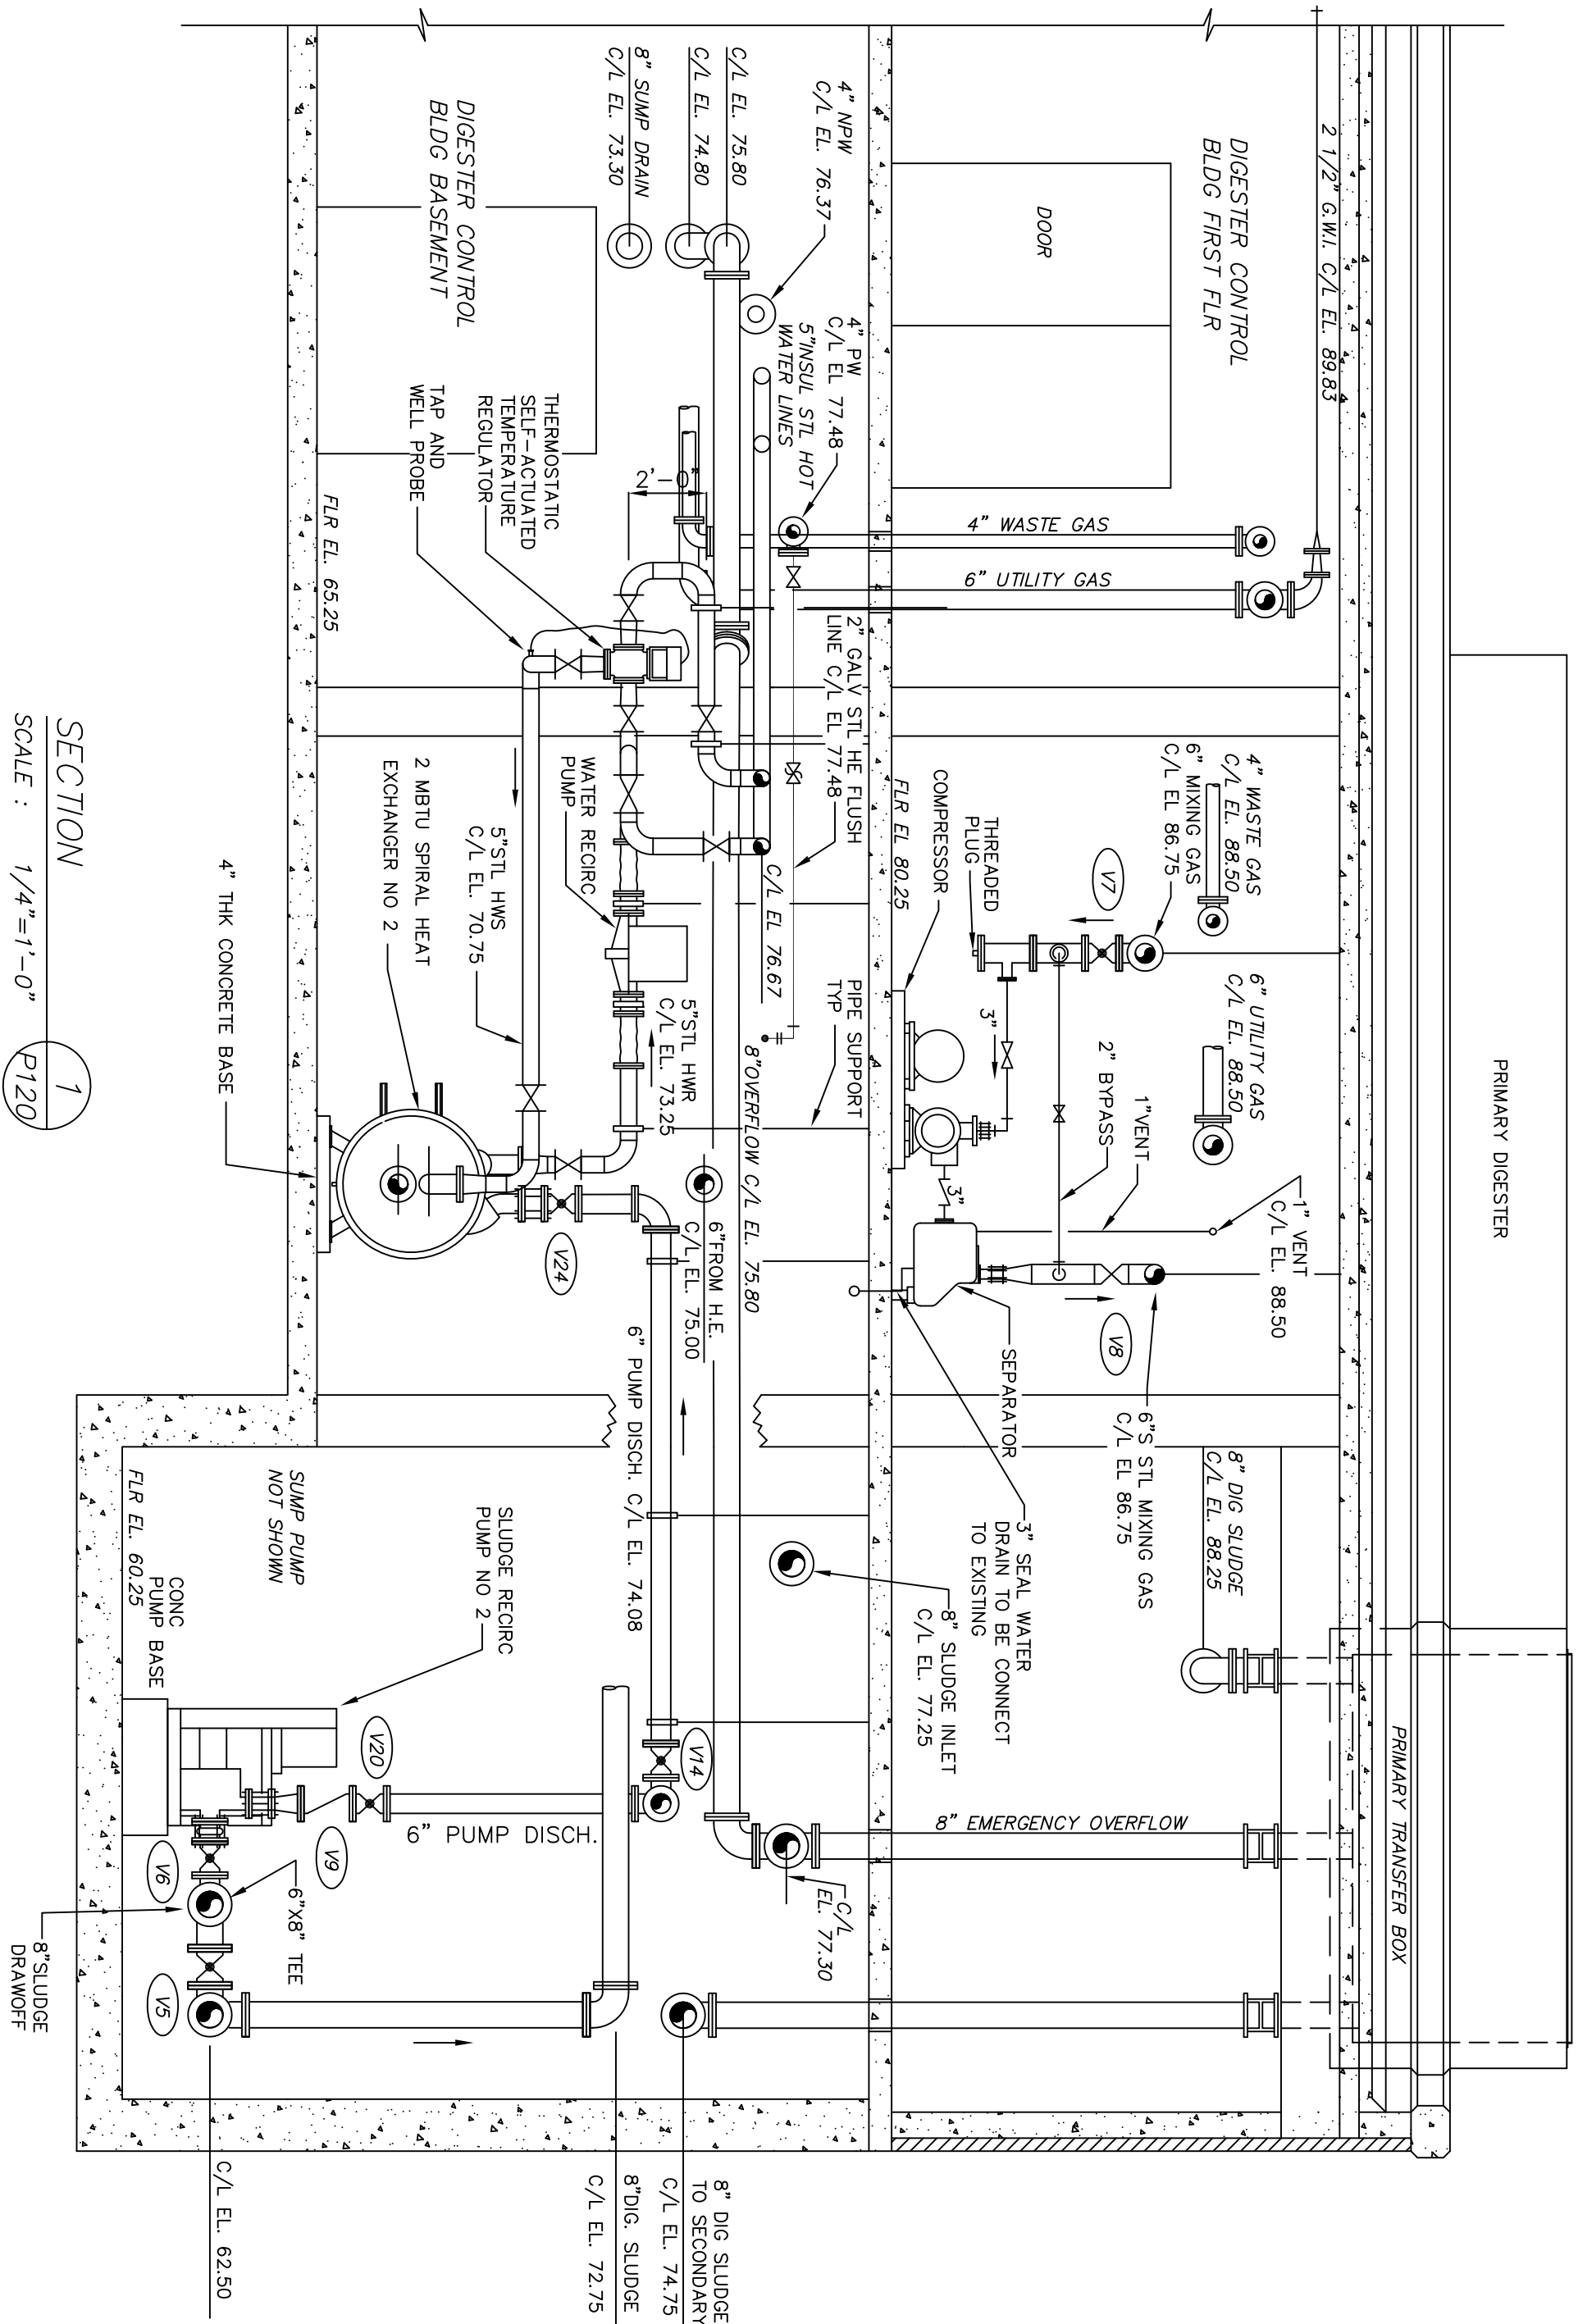

ENVIRONMENTAL, INC.
ENGINEERS IN WATER AND EARTH SCIENCES
UNIONTOWN, OHIO

CITY OF MASSILLON, OHIO
WWTP UPGRADE 2000
DIGESTER CONTROL BUILDING SECTIONS

JOB NO.	E9031
DATE	08/13/01
SCALE	AS NOTED
SHEET	P123

E:\E9031\9031DCB9.DWG