




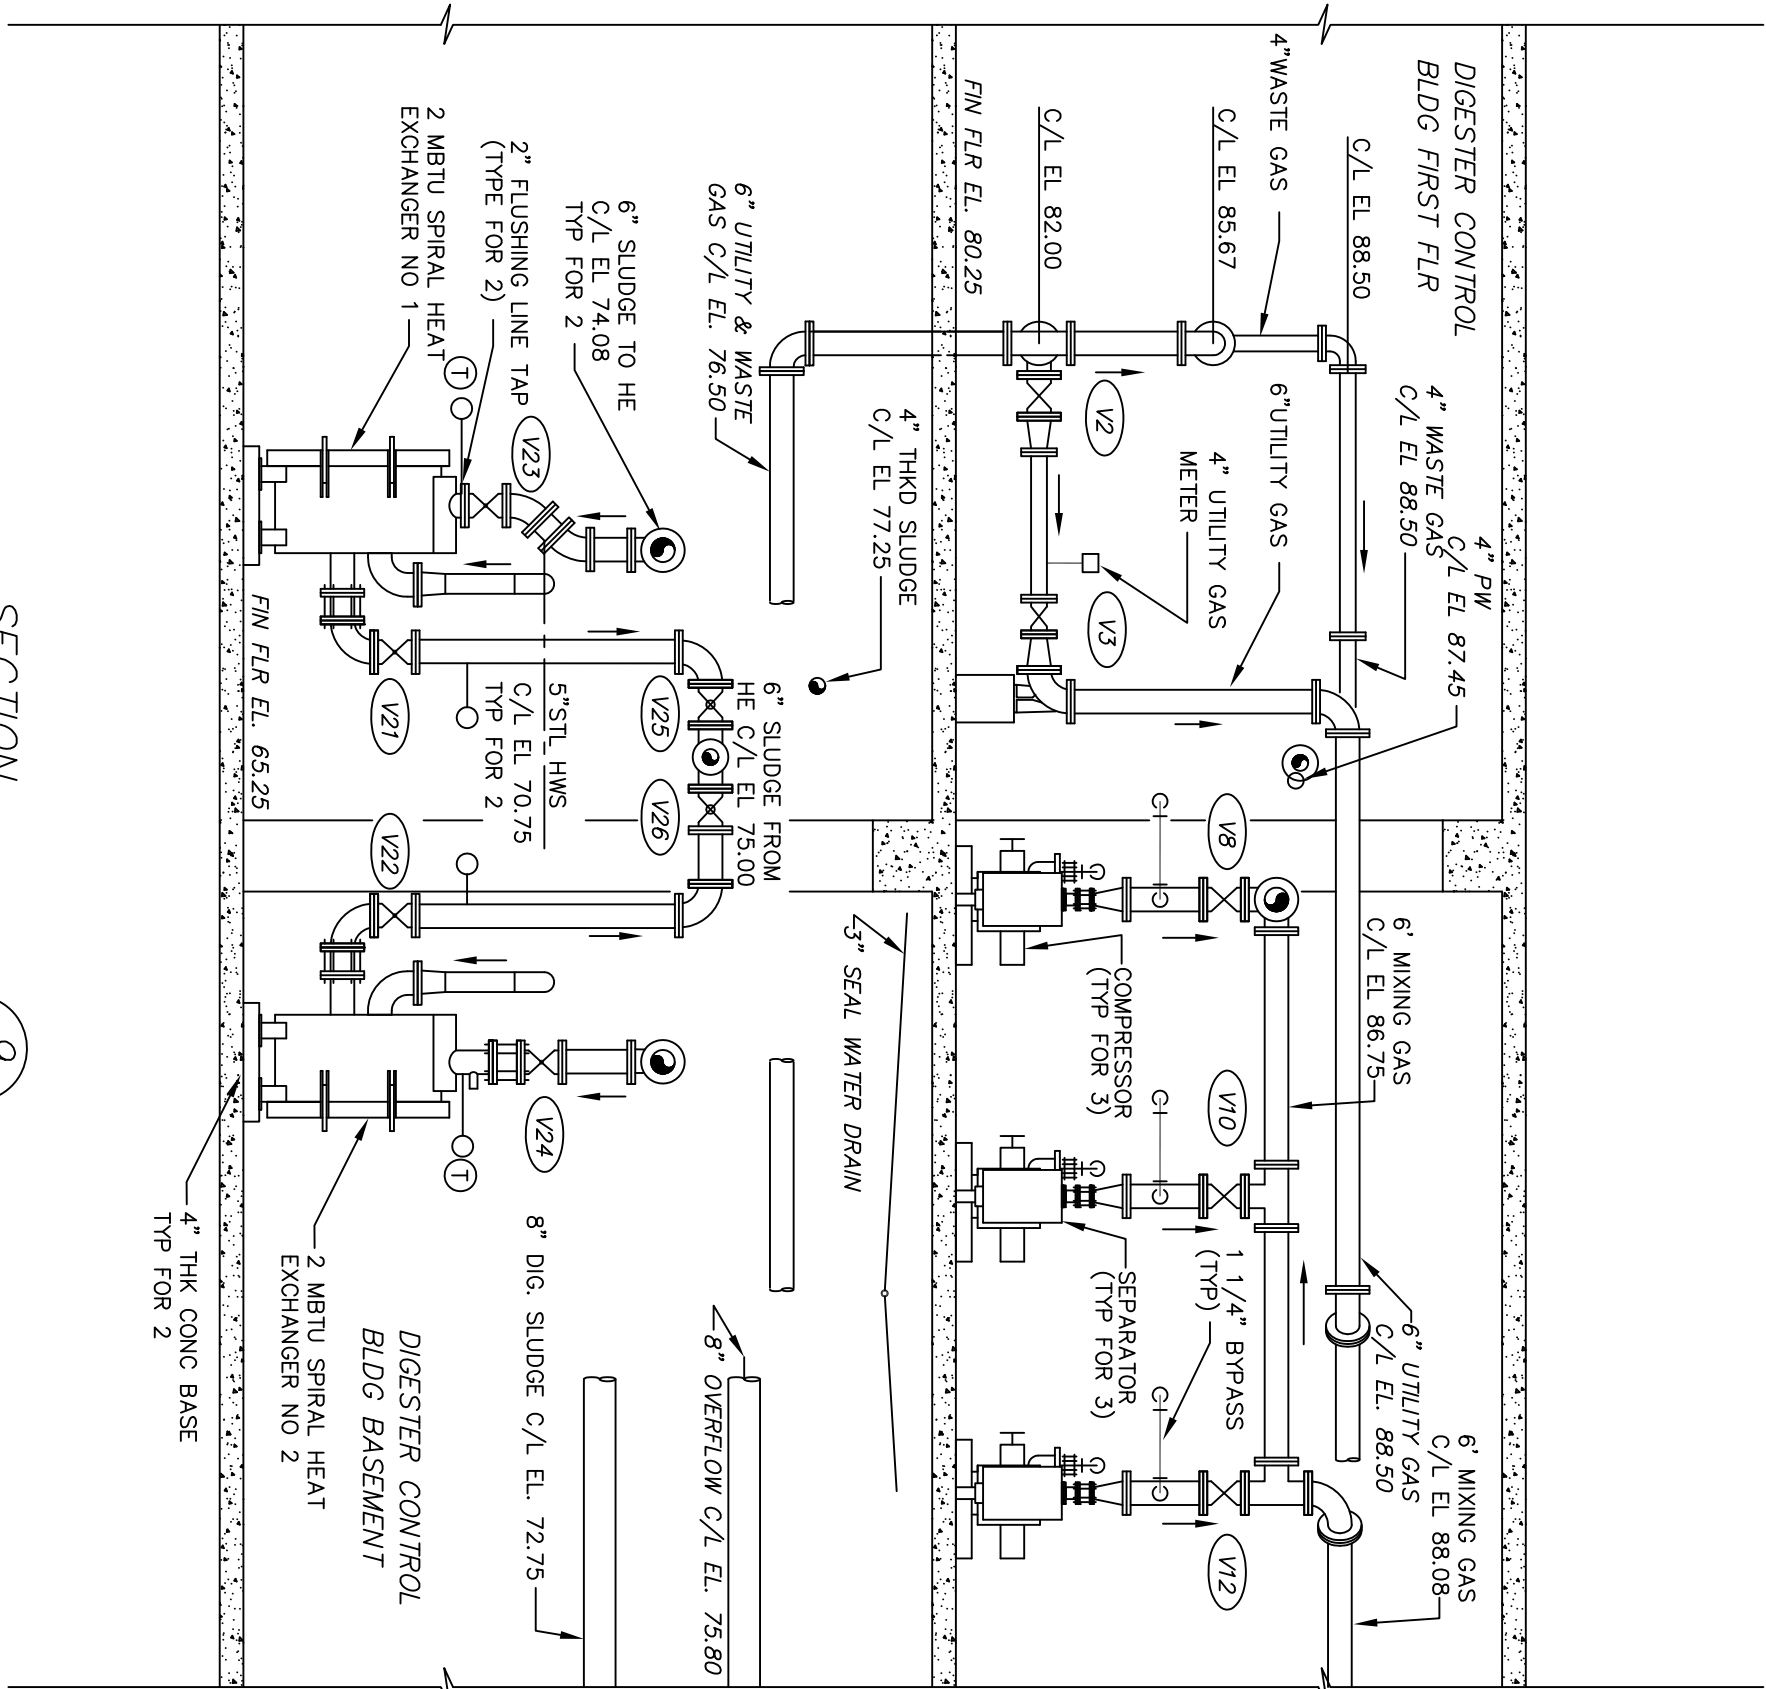


SECTION 9
SCALE : 1/4"=1'-0" P120

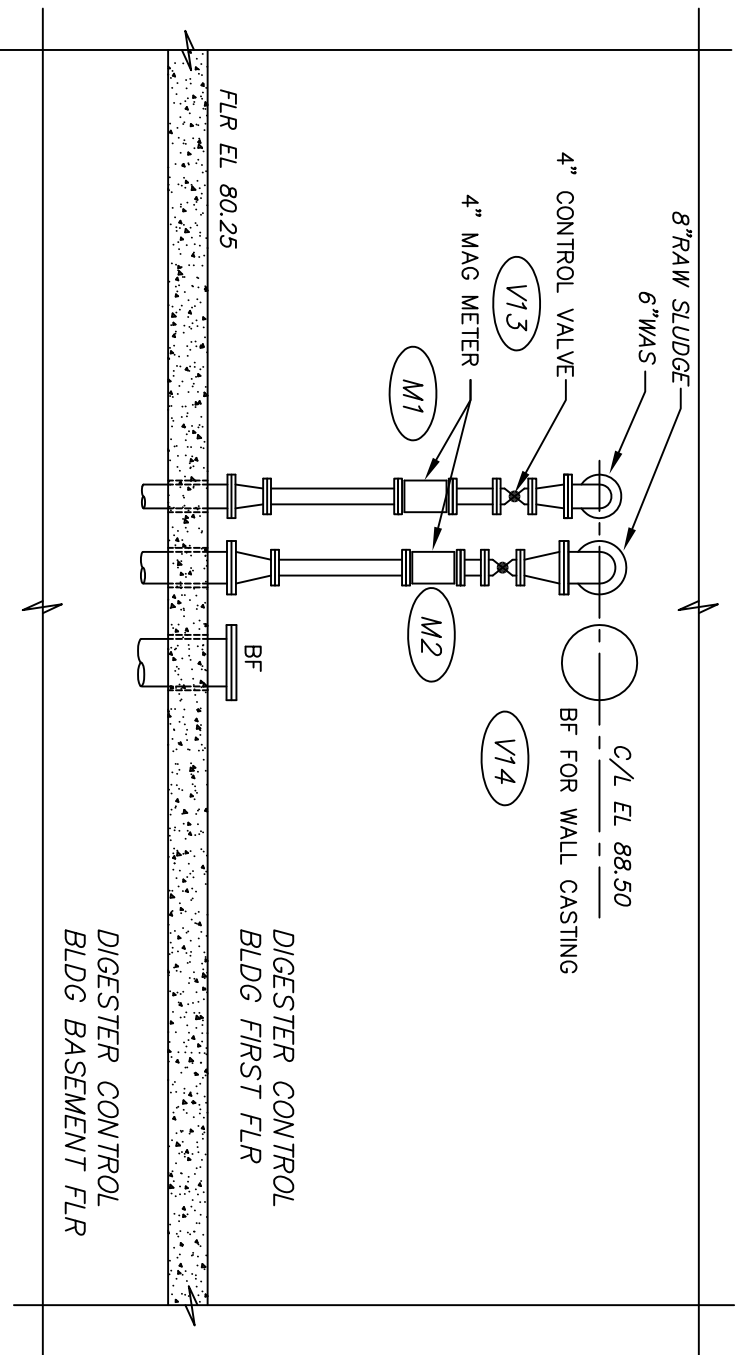

SECTION 10
SCALE : 1/4"=1'-0" P121

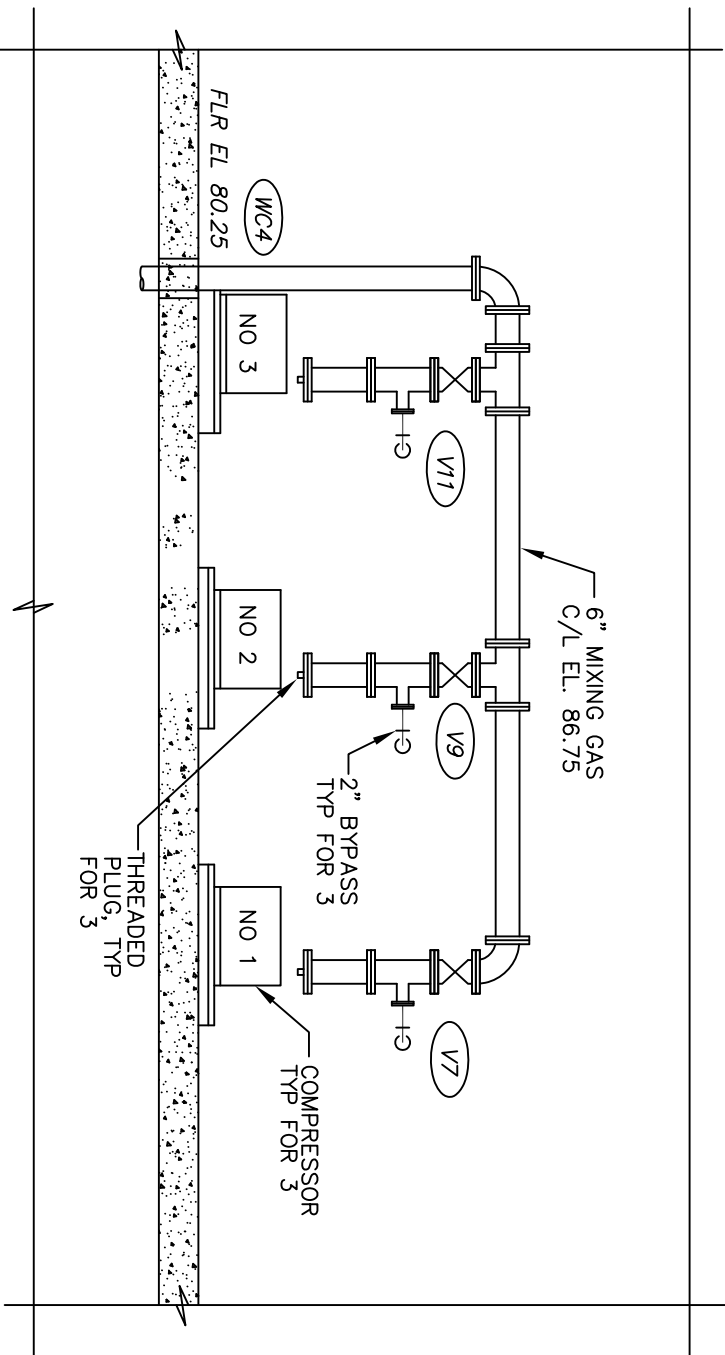

SECTION 11
SCALE : 1/4"=1'-0" P122

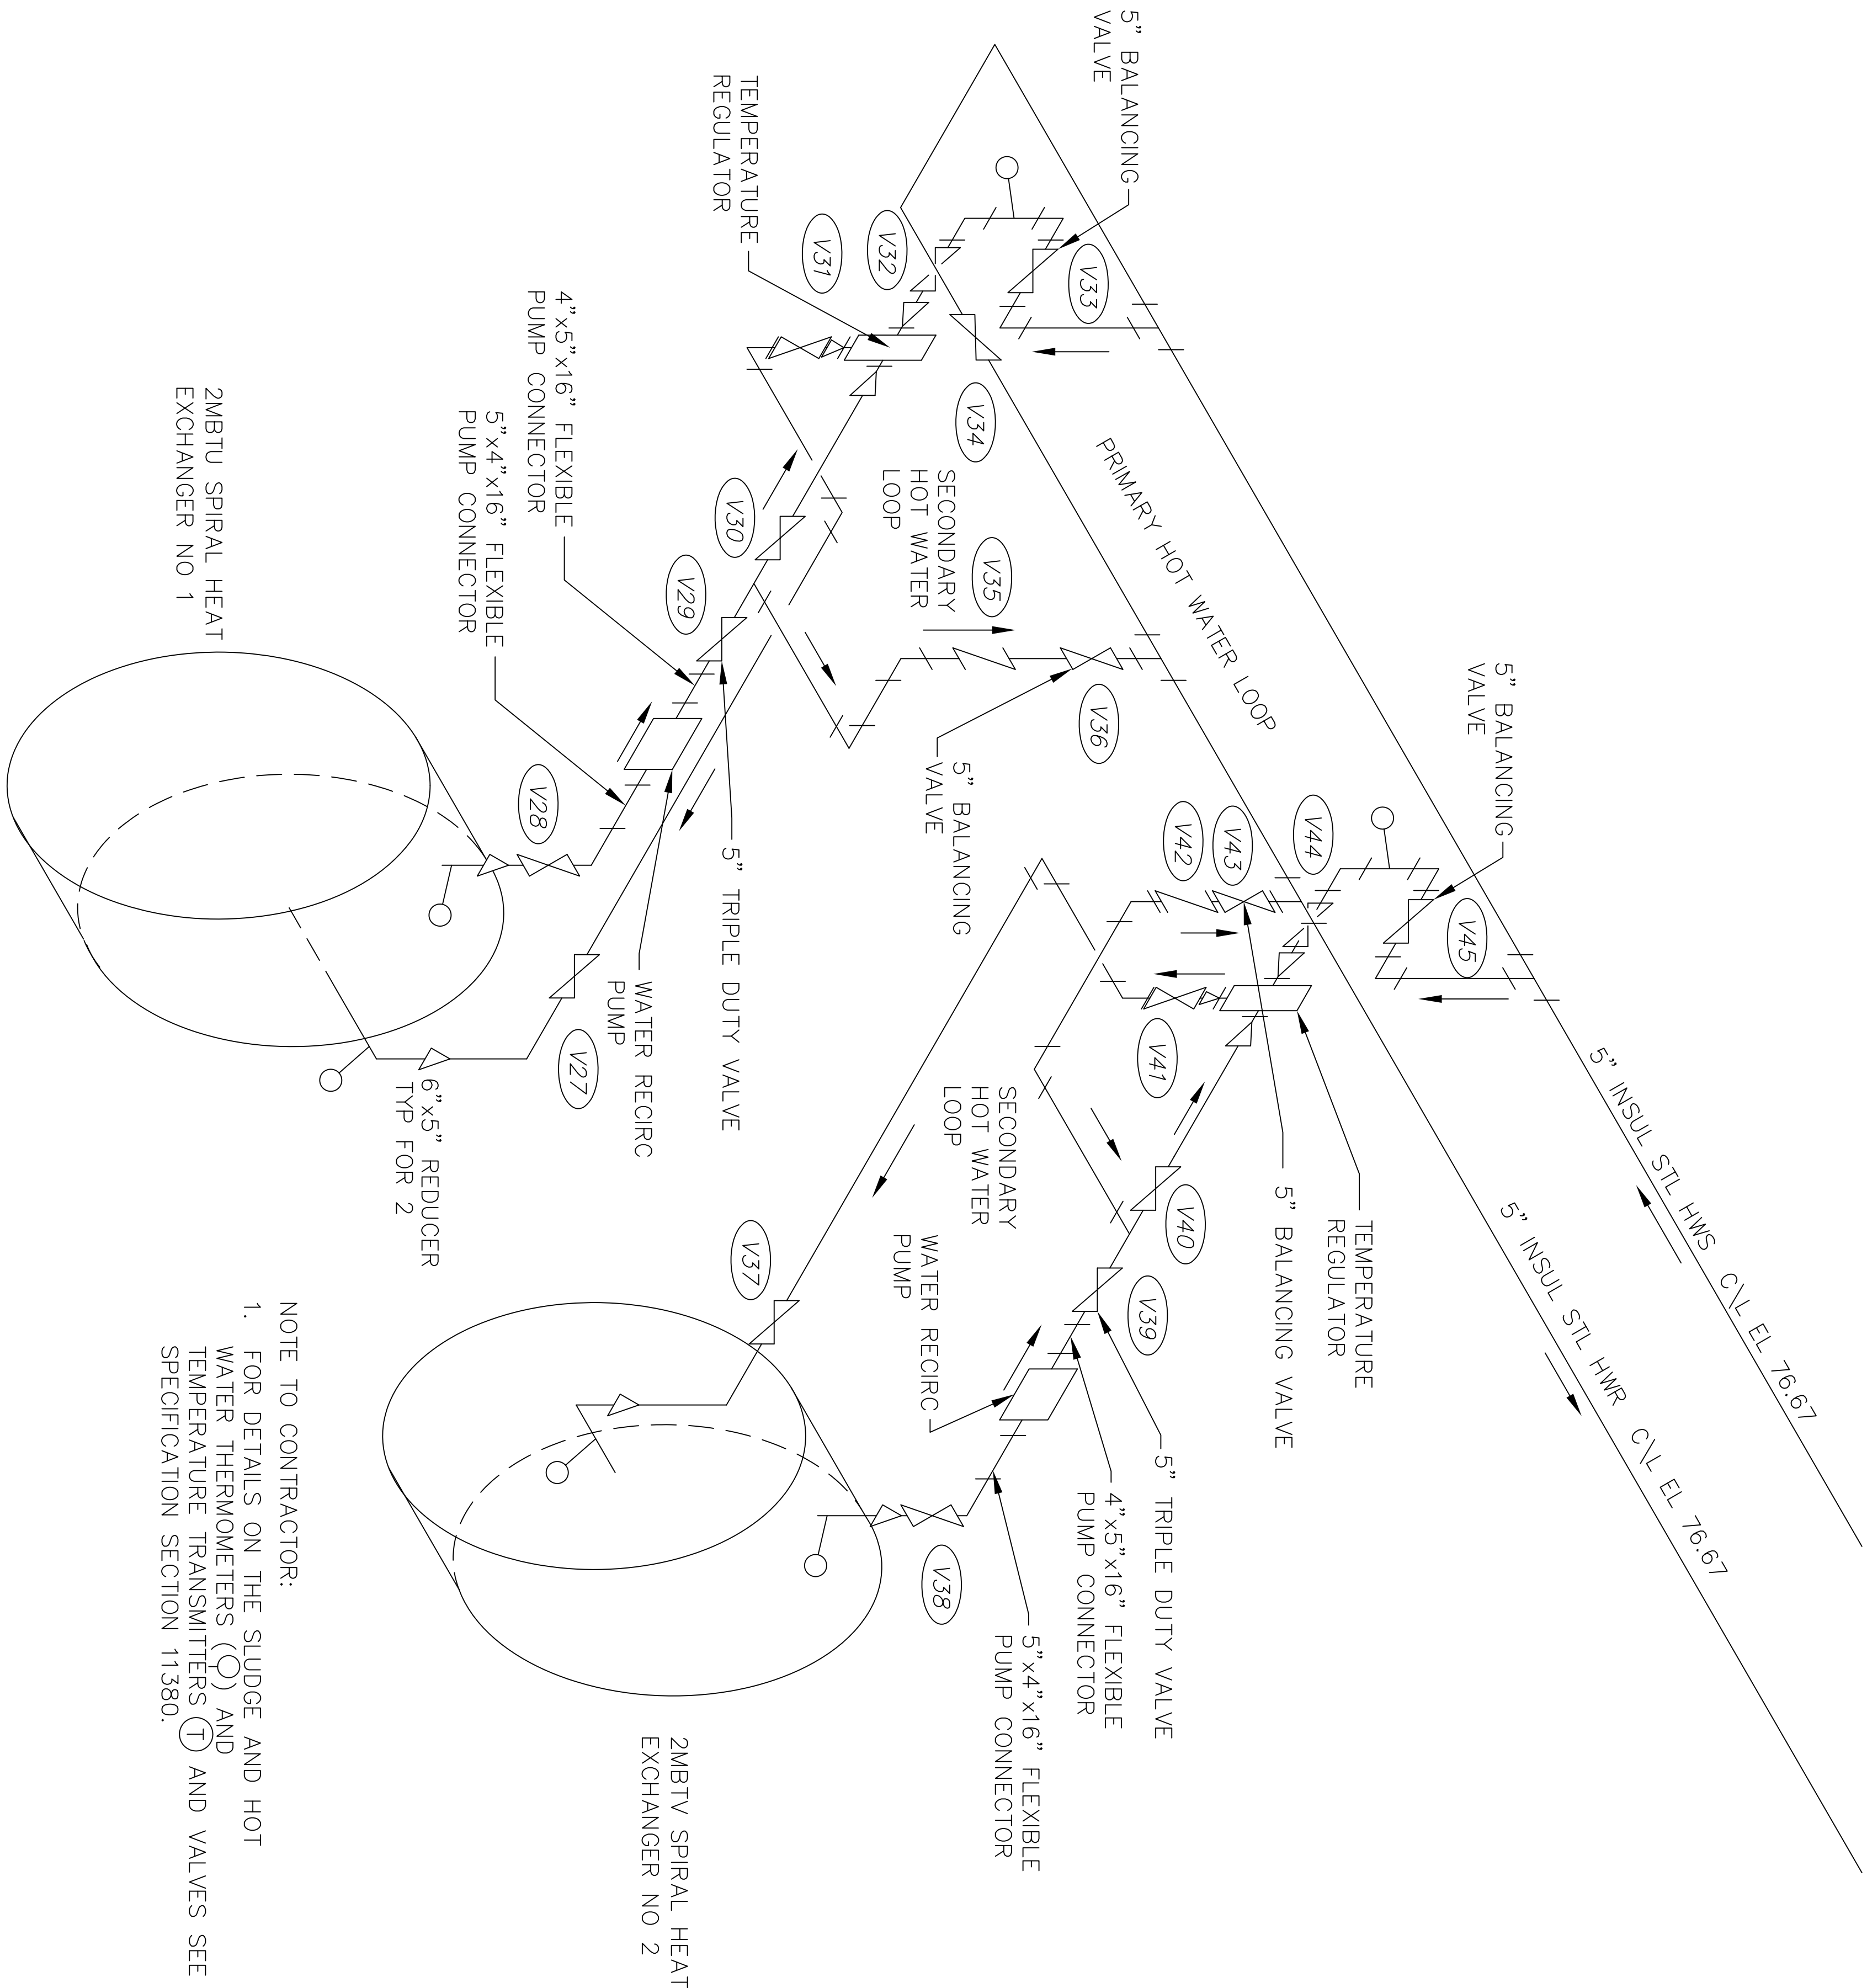

NOTE TO CONTRACTOR:
1. FOR DETAILS ON THE SLUDGE AND HOT WATER THERMOMETERS (O) AND TEMPERATURE TRANSMITTERS (T) AND VALVES SEE SPECIFICATION SECTION 11380.

HEAT EXCHANGER HOT WATER PIPING SCHEMATIC

NOT TO SCALE

THESE RECORD DOCUMENTS HAVE BEEN PREPARED BASED ON INFORMATION PROVIDED BY OTHERS. CITI ENVIRONMENTAL HAS REVIEWED THE INFORMATION SUBMITTED AND BELIEVES IT REFLECTS THE WORK AS CONSTRUCTED. HOWEVER, ALL PERSONS SHALL VERIFY INFORMATION TAKEN FROM THIS DRAWING.



ENVIRONMENTAL, INC.
ENGINEERS IN WATER AND EARTH SCIENCES
UNIONTOWN, OHIO

CITY OF MASSILLON, OHIO
WWTP UPGRADE 2000
DIGESTER BUILDING CONTROL SECTIONS

DESIGNED BY RWR/AJP	REVISIONS				
	NO.	DESCRIPTIONS	DATE	BY	APP'D
DRAWN BY AJP	1	ADDENDUM NO. 1	9/12	RWR	WAD
	2	RECORD DRAWING	6/05	MGW	WAD
CHECKED BY RWR					
APPROVED BY WAD					

THIS DRAWING IS AN INSTRUMENT OF SERVICE OWNED BY CITI ENVIRONMENTAL, INC. WHICH SHALL BE DEEMED THE AUTHOR AND WHICH SHALL RETAIN ALL STATUTORY AND COMMON LAW RIGHTS, INCLUDING COPYRIGHTS. THIS DRAWING SHALL NOT BE SCANNED, COPIED, OR DISTRIBUTED TO OTHERS IN ANY FORM OR USED FOR ANY OTHER PURPOSE OR PROJECT WITHOUT PRIOR WRITTEN CONSENT OF CITI ENVIRONMENTAL, INC. CITI ENVIRONMENTAL, INC. CANNOT GUARANTEE THAT ELECTRONIC COPIES OF THIS DRAWING ARE EXACT DUPLICATES OF THE SEALED ORIGINAL DRAWING. IN THE EVENT OF A CONFLICT BETWEEN AN ELECTRONIC COPY AND THE SEALED ORIGINAL, THE SEALED ORIGINAL SHALL GOVERN.

JOB NO. E9031	DATE 08/13/01
SCALE AS NOTED	SHEET P124