

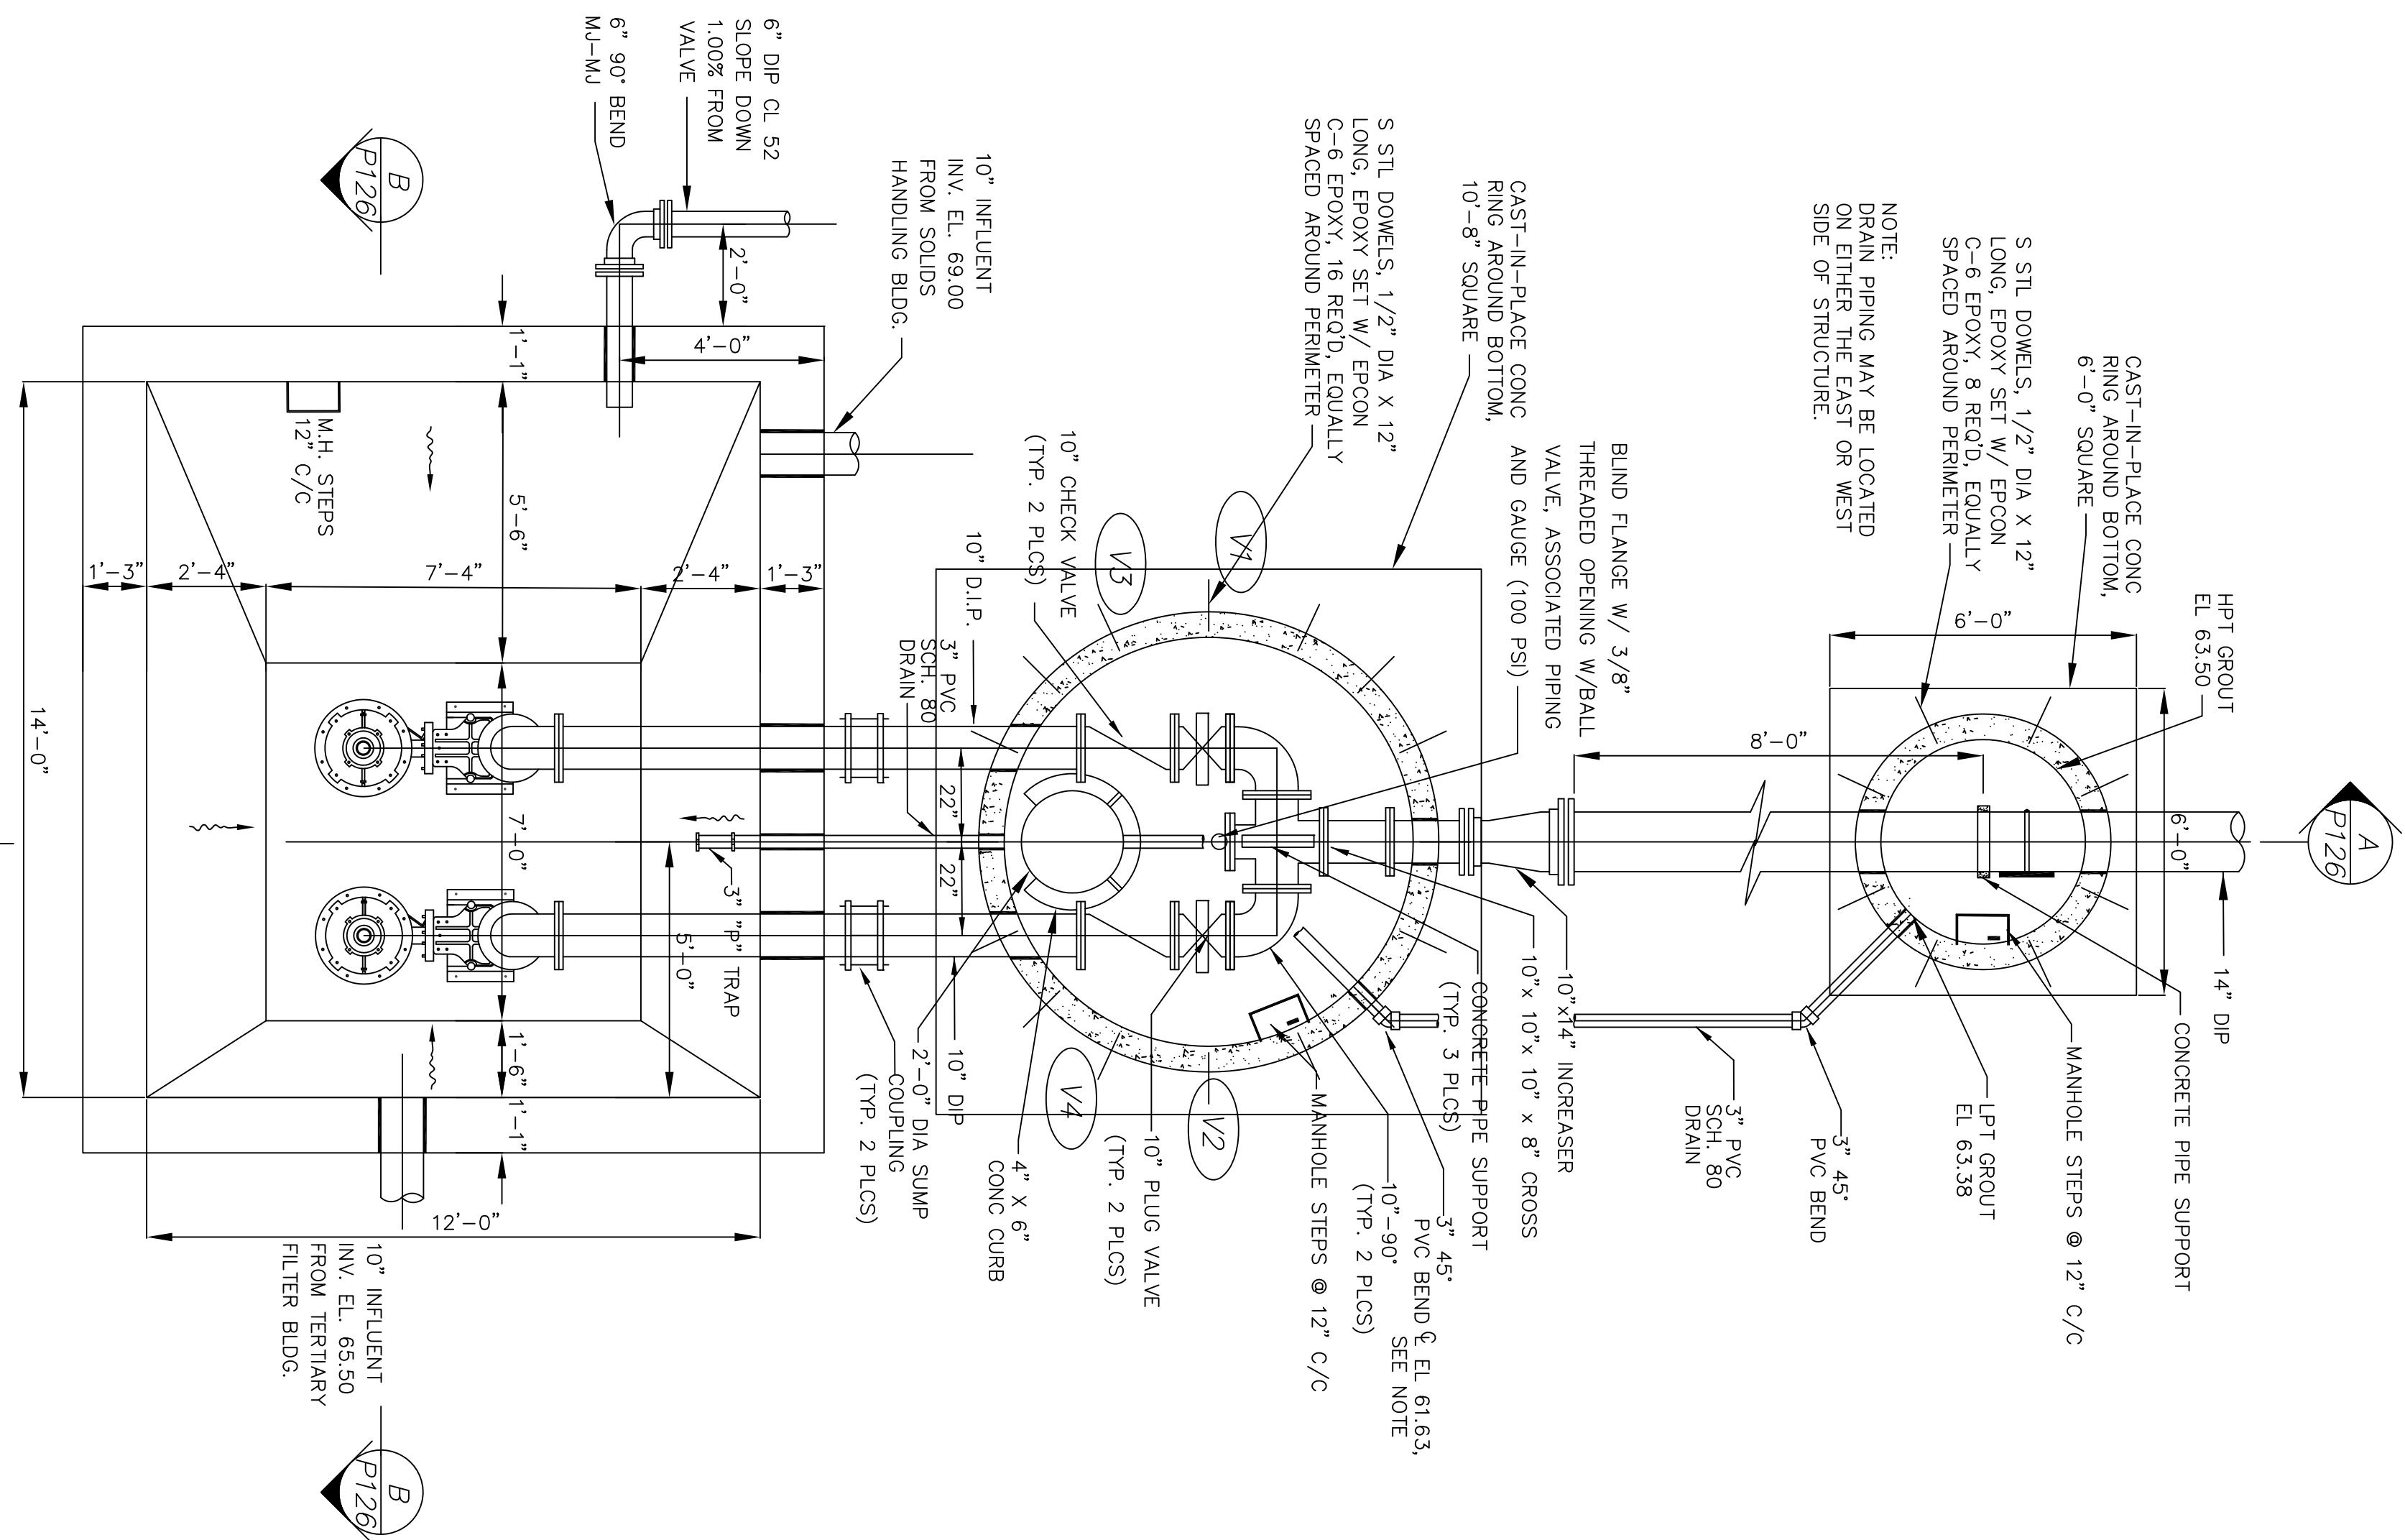


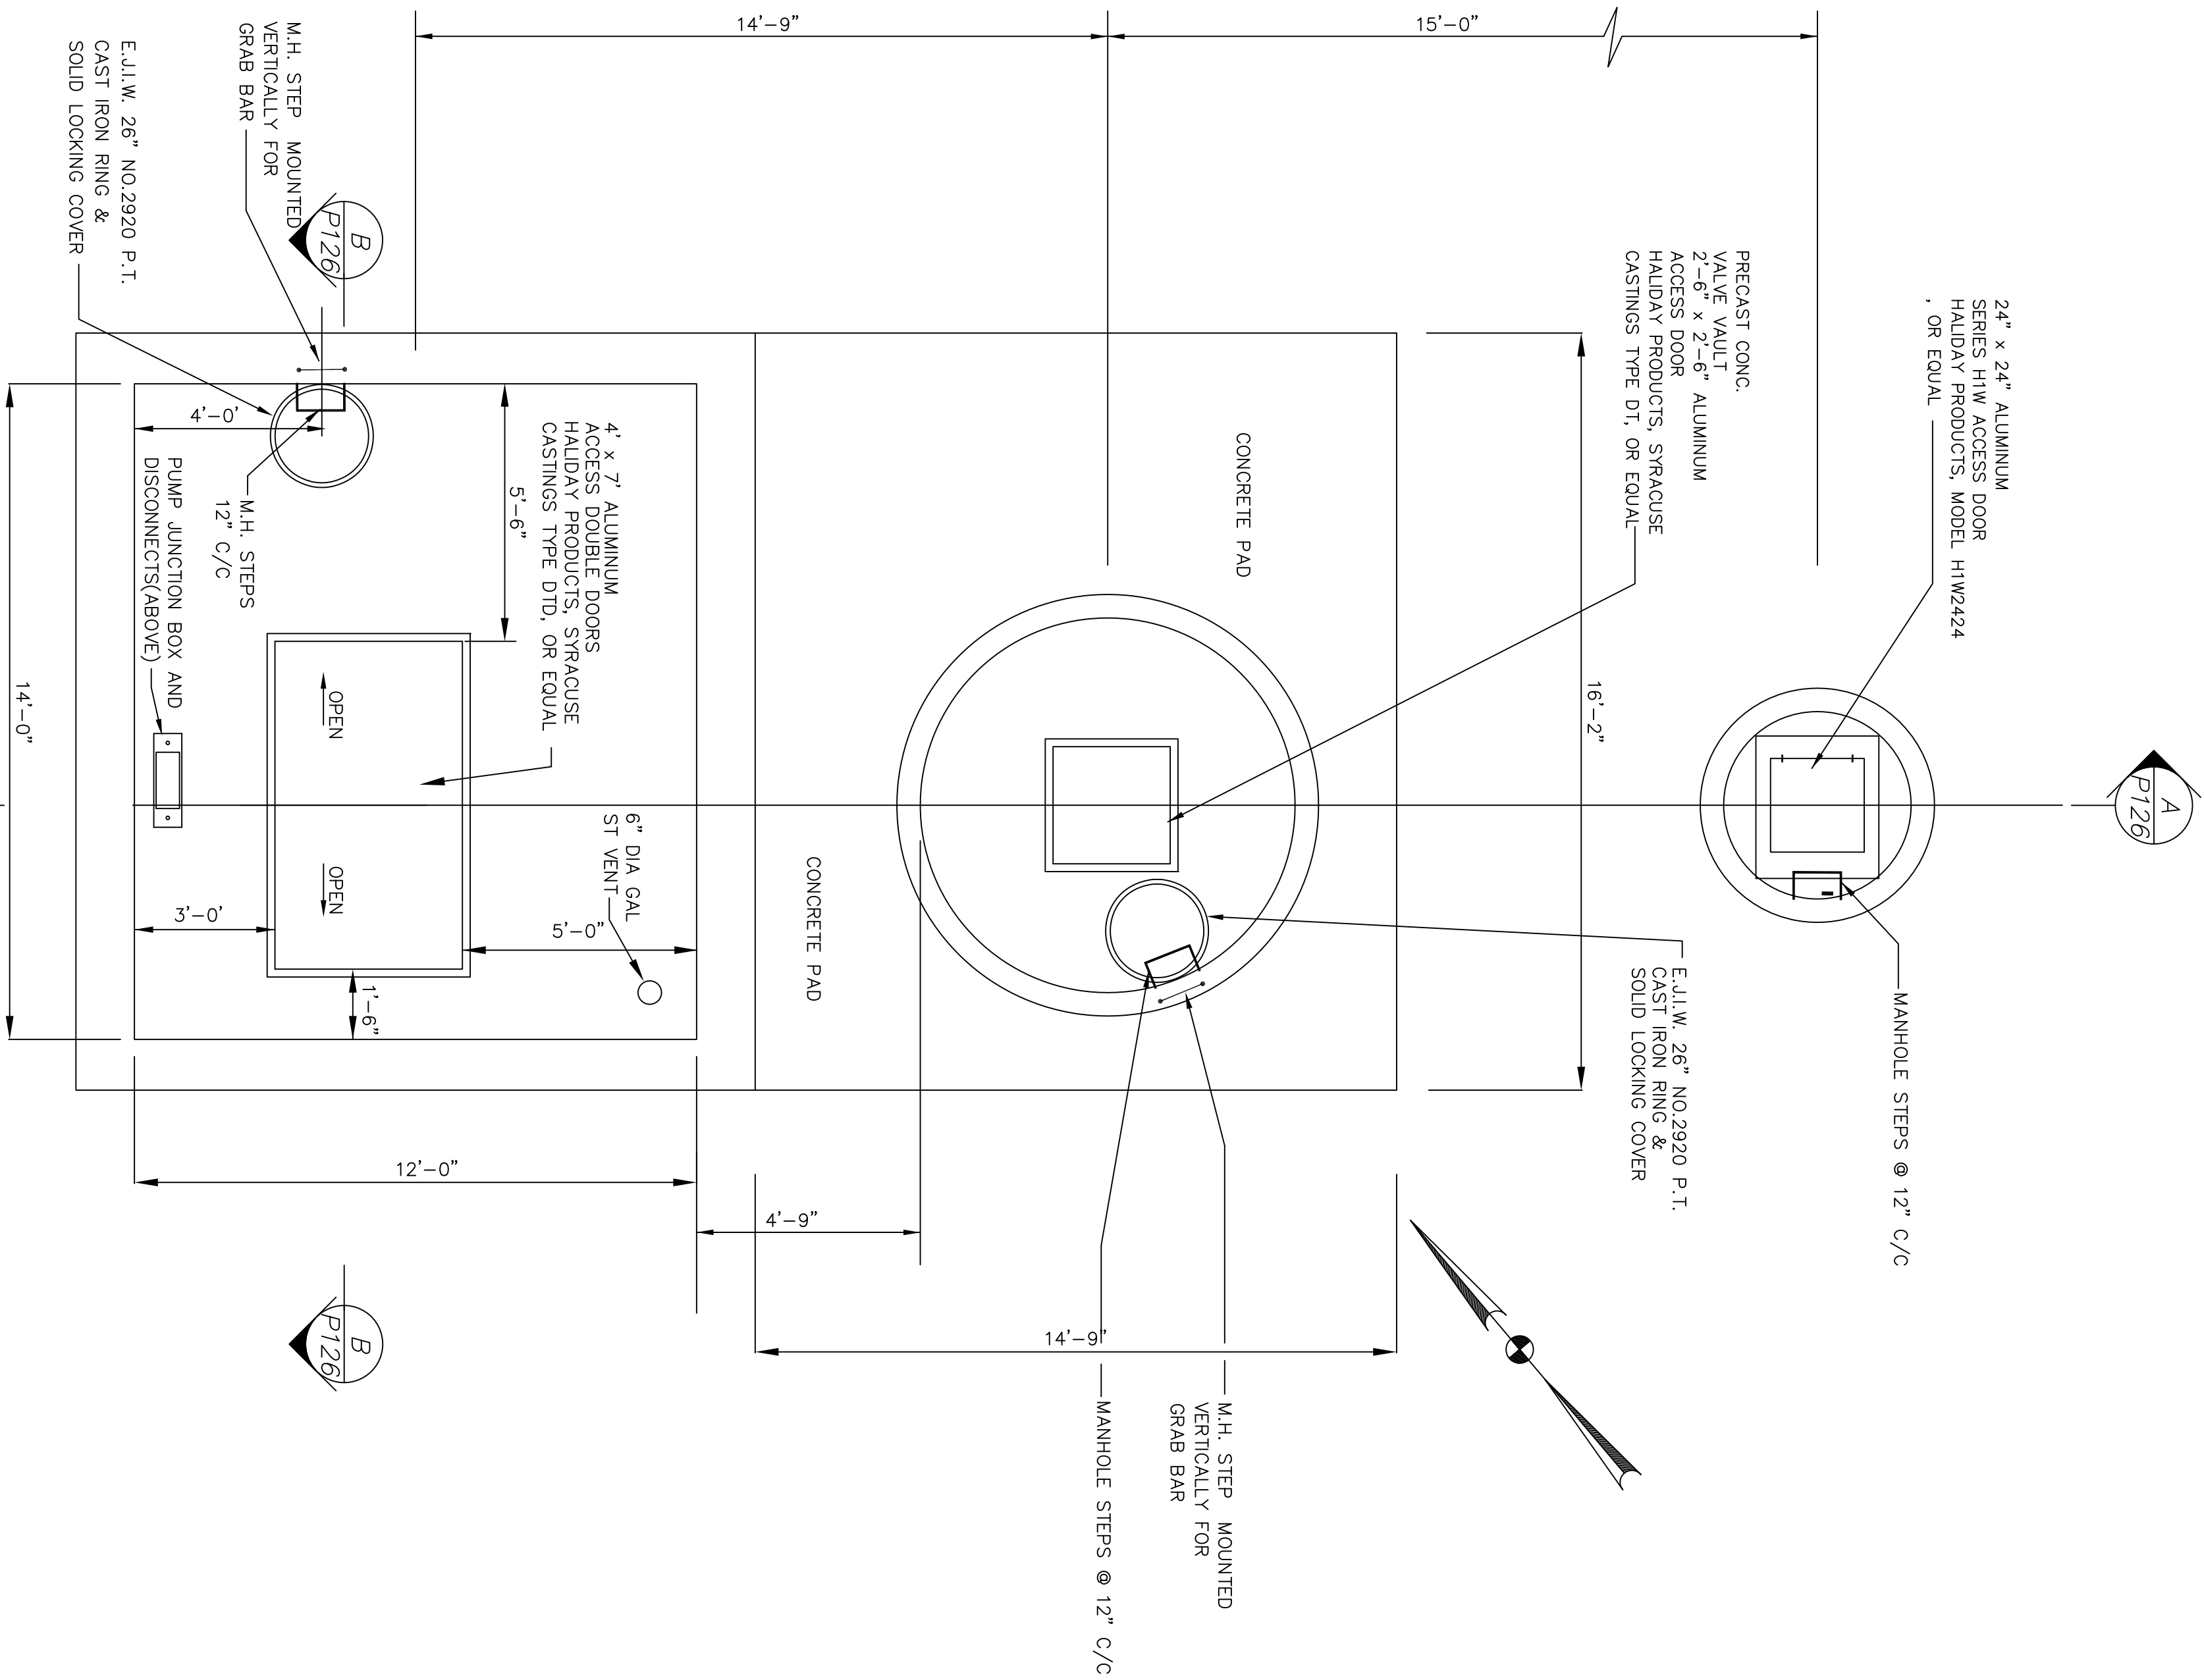

- NOTES:
1. CONTRACTOR TO VERIFY INCREASER SIZE BASED ON PUMP MANUFACTURER SELECTED
 2. ALL PIPE PENETRATIONS THROUGH WALLS SHALL BE CORE DRILLED WITH LINK SEAL TYPE SEAL.

THESE RECORD DOCUMENTS HAVE BEEN PREPARED BASED ON INFORMATION PROVIDED BY OTHERS. CTI ENVIRONMENTAL HAS REVIEWED THE INFORMATION SUBMITTED AND BELIEVES IT REFLECTS THE WORK CONSTRUCTED. HOWEVER, ALL PERSONS SHALL VERIFY INFORMATION TAKEN FROM THIS DRAWING.

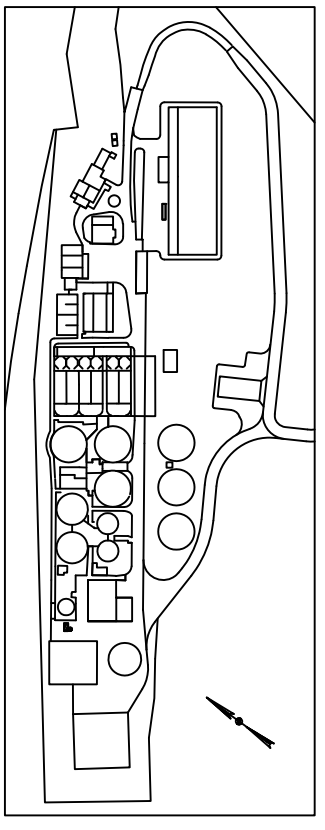

DES. NO.	E9031
DATE	08/13/01
SCALE	3/8"=1'-0"
SHEET	P125



ENVIRONMENTAL, INC.
ENGINEERS IN WATER AND EARTH SCIENCES
UNIONTOWN, OHIO

CITY OF MASSILLON , OHIO

WWTP UPGRADE 2000

FILTRATE PUMP STATION PLAN

DESIGNED BY	REVISIONS				
	NO.	DESCRIPTIONS	DATE	BY	APP'D
DRAWN BY	1	SEE REVISION CLOUDS	7/02	ELR	TMK
	2	REVISIONS	9/23/02	RWR	WAD
CHECKED BY	3	RECORD DRAWING	6/05	MGW	WAD
APPROVED BY					

THIS DRAWING IS AN INSTRUMENT OF SERVICE OWNED BY CTI ENVIRONMENTAL, INC. WHICH SHALL BE DEEMED THE AUTHOR AND TO WHOM ALL STATUTORY AND COMMON LAW RIGHTS, INCLUDING COPYRIGHTS, SHALL BE RESERVED. THIS DRAWING SHALL NOT BE REPRODUCED, COPIED, OR DISTRIBUTED TO OTHERS IN ANY FORM OR USED FOR ANY OTHER PURPOSE OR PROJECT WITHOUT PRIOR WRITTEN CONSENT OF CTI ENVIRONMENTAL, INC. CTI ENVIRONMENTAL, INC. CANNOT GUARANTEE THAT ELECTRONIC COPIES OF THIS DRAWING ARE EXACT DUPLICATES OF THE SEALED ORIGINAL DRAWING. IN THE EVENT OF A CONFLICT BETWEEN AN ELECTRONIC COPY AND THE SEALED ORIGINAL, THE SEALED ORIGINAL SHALL GOVERN.