
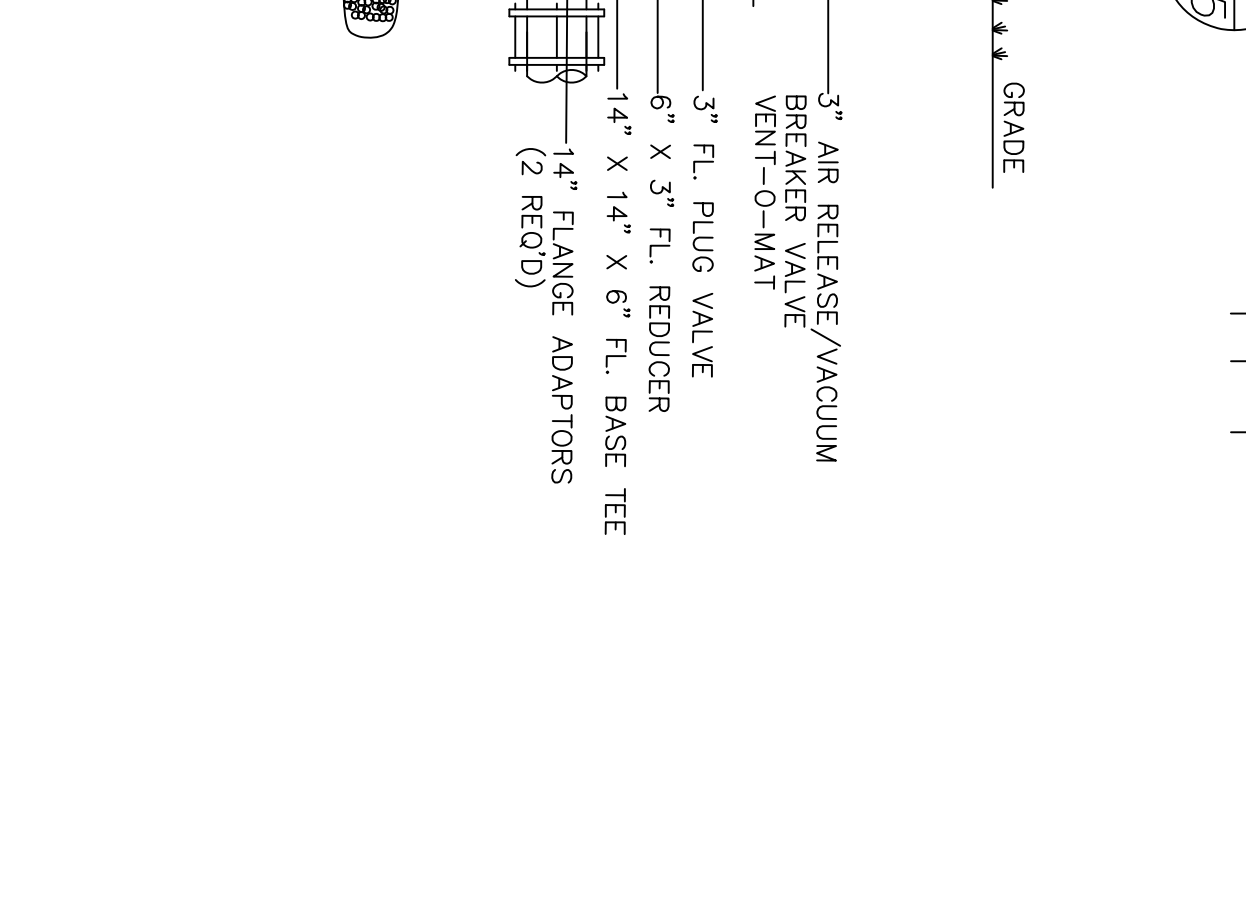
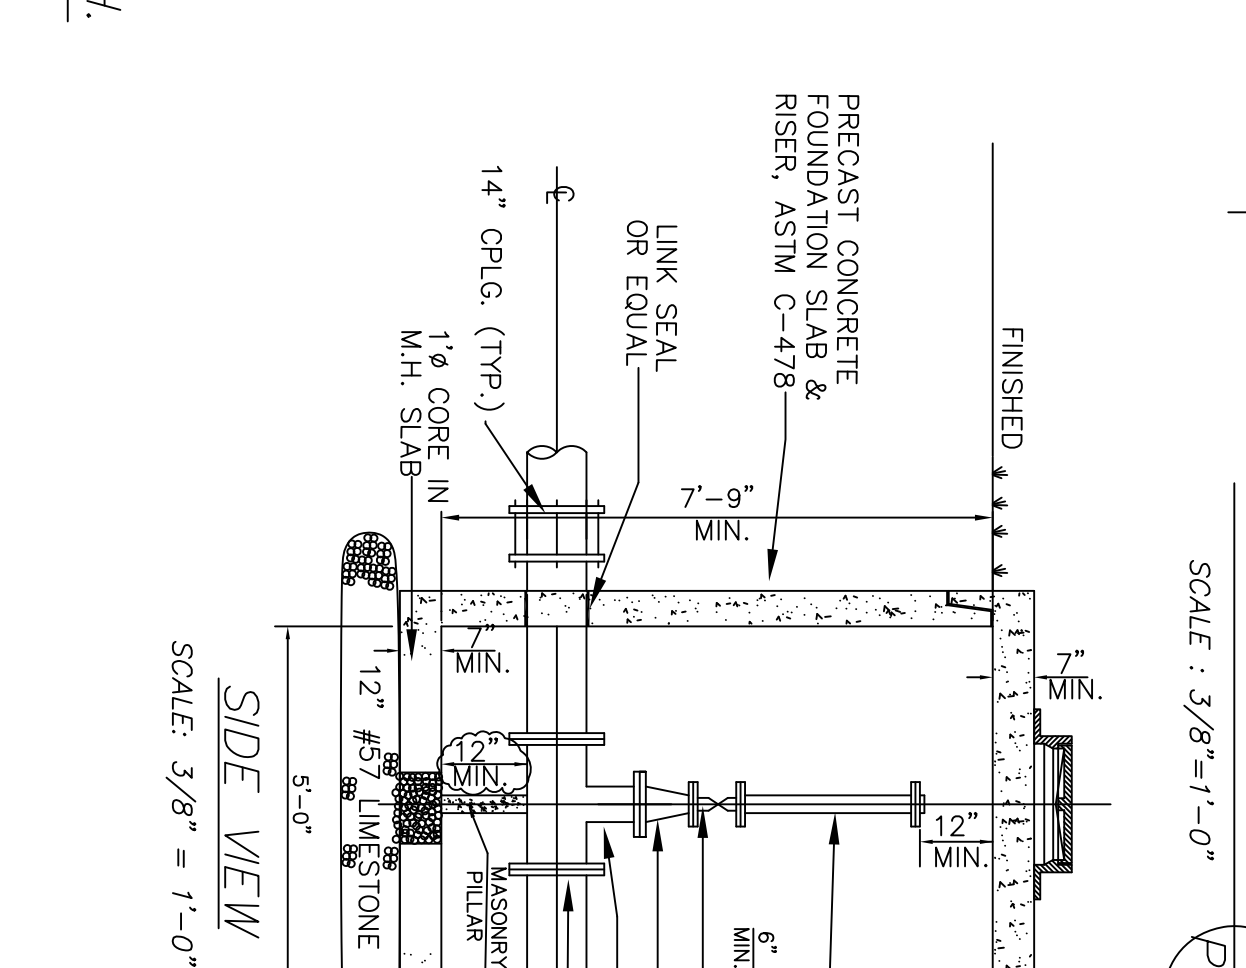
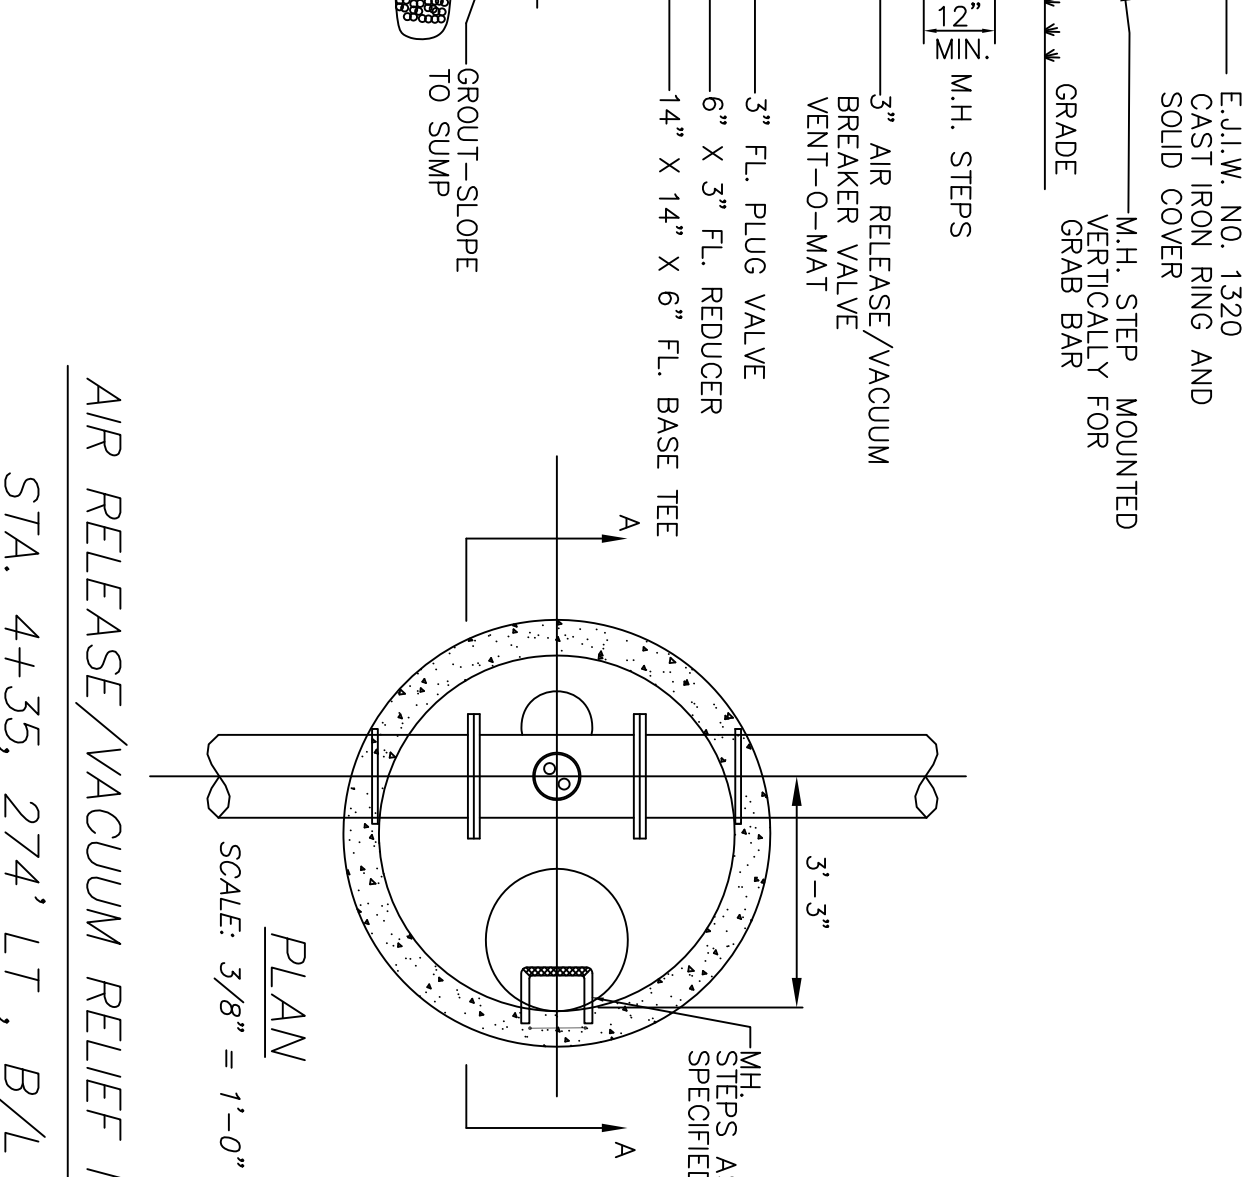
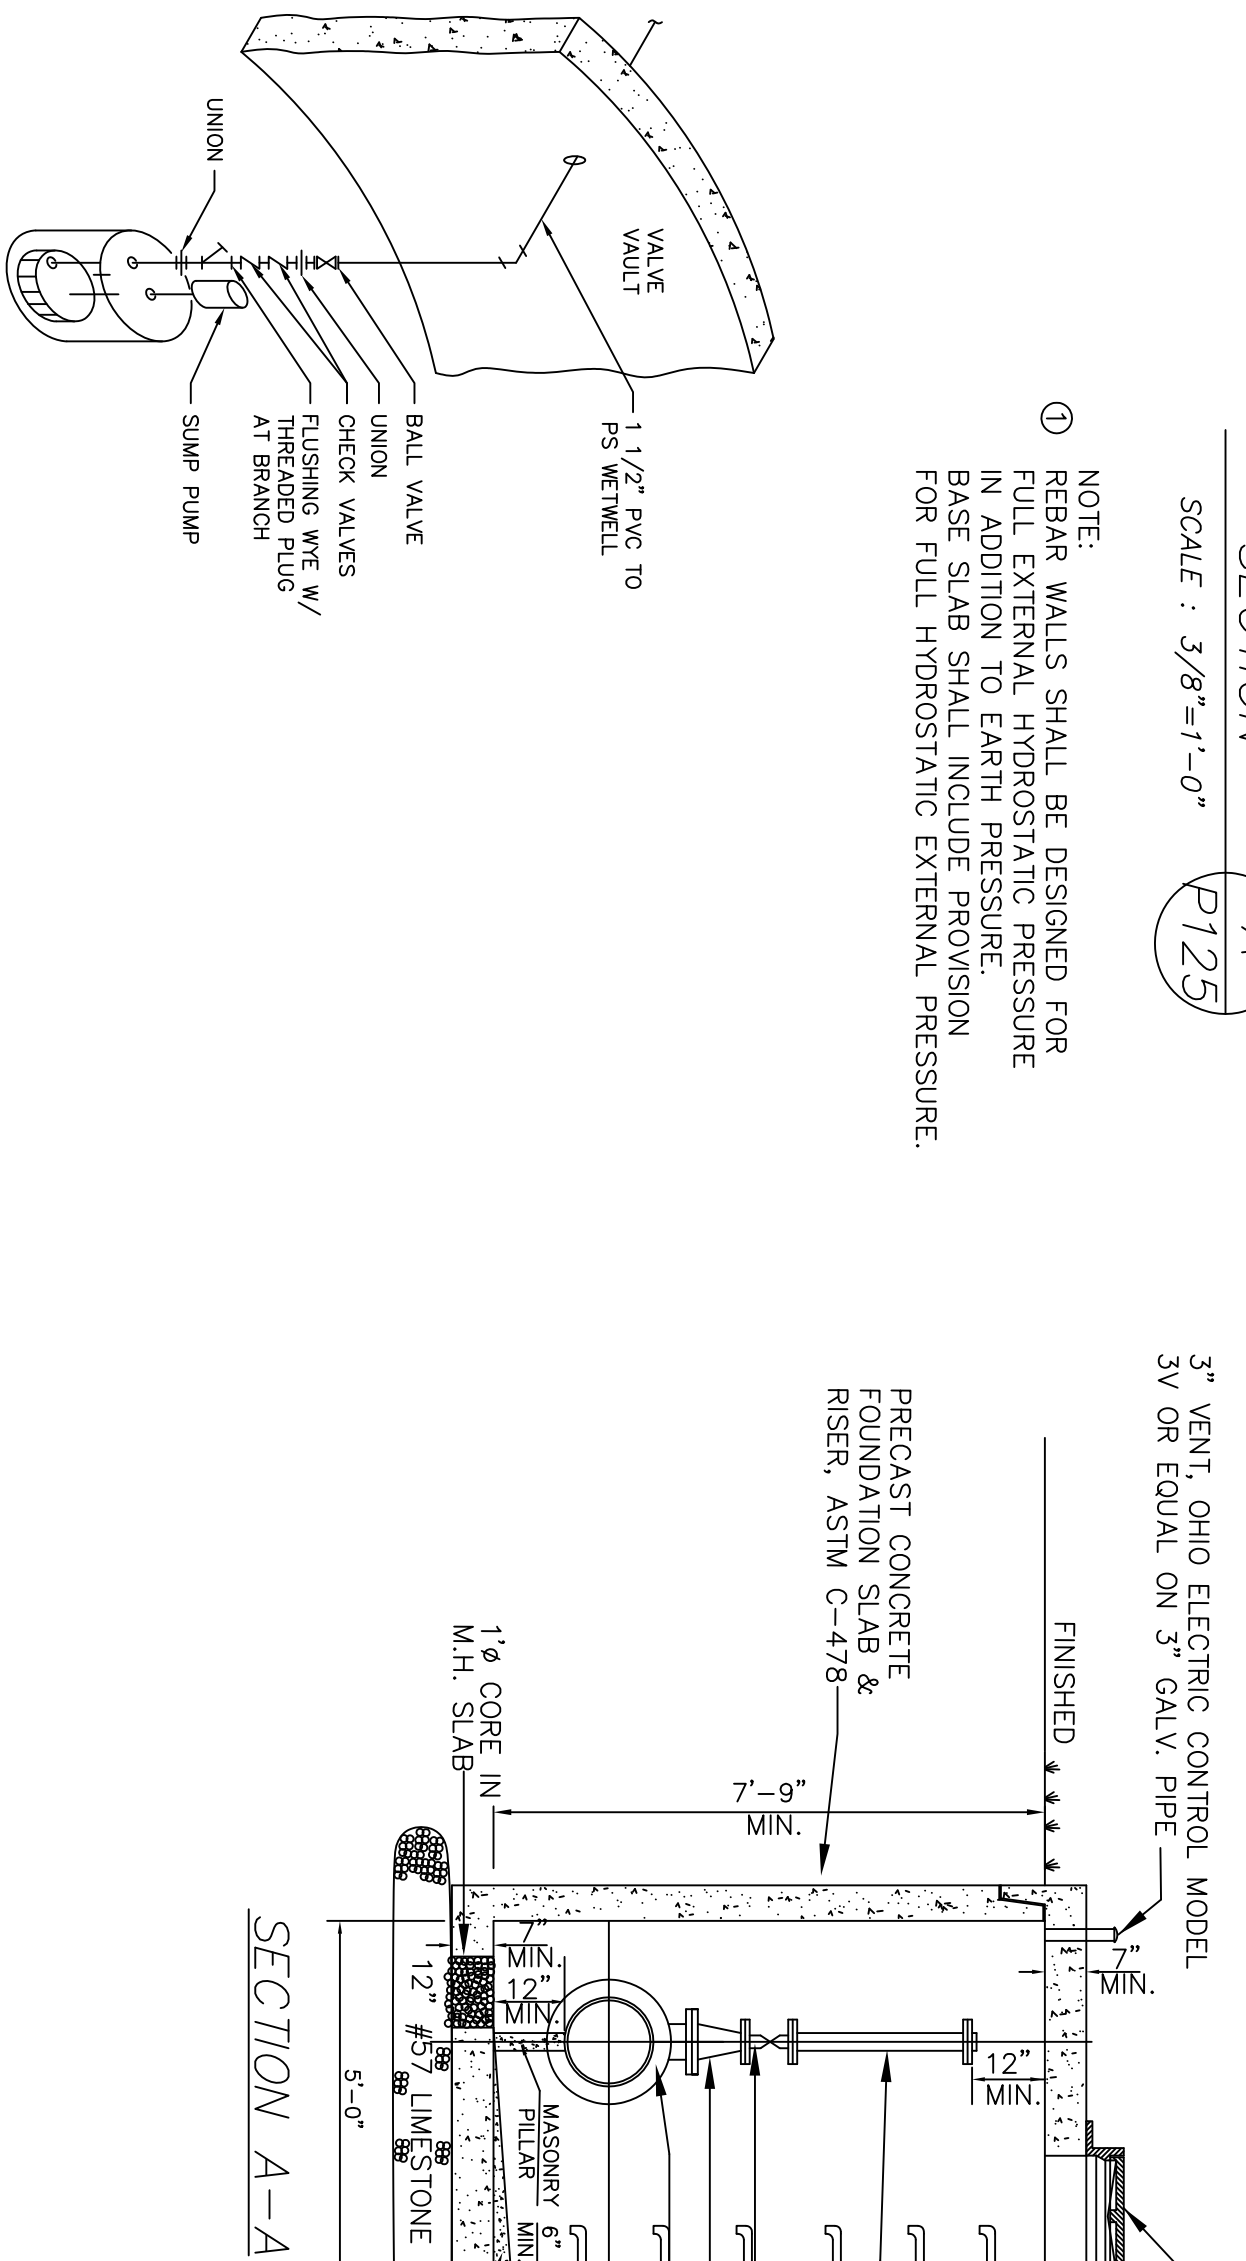
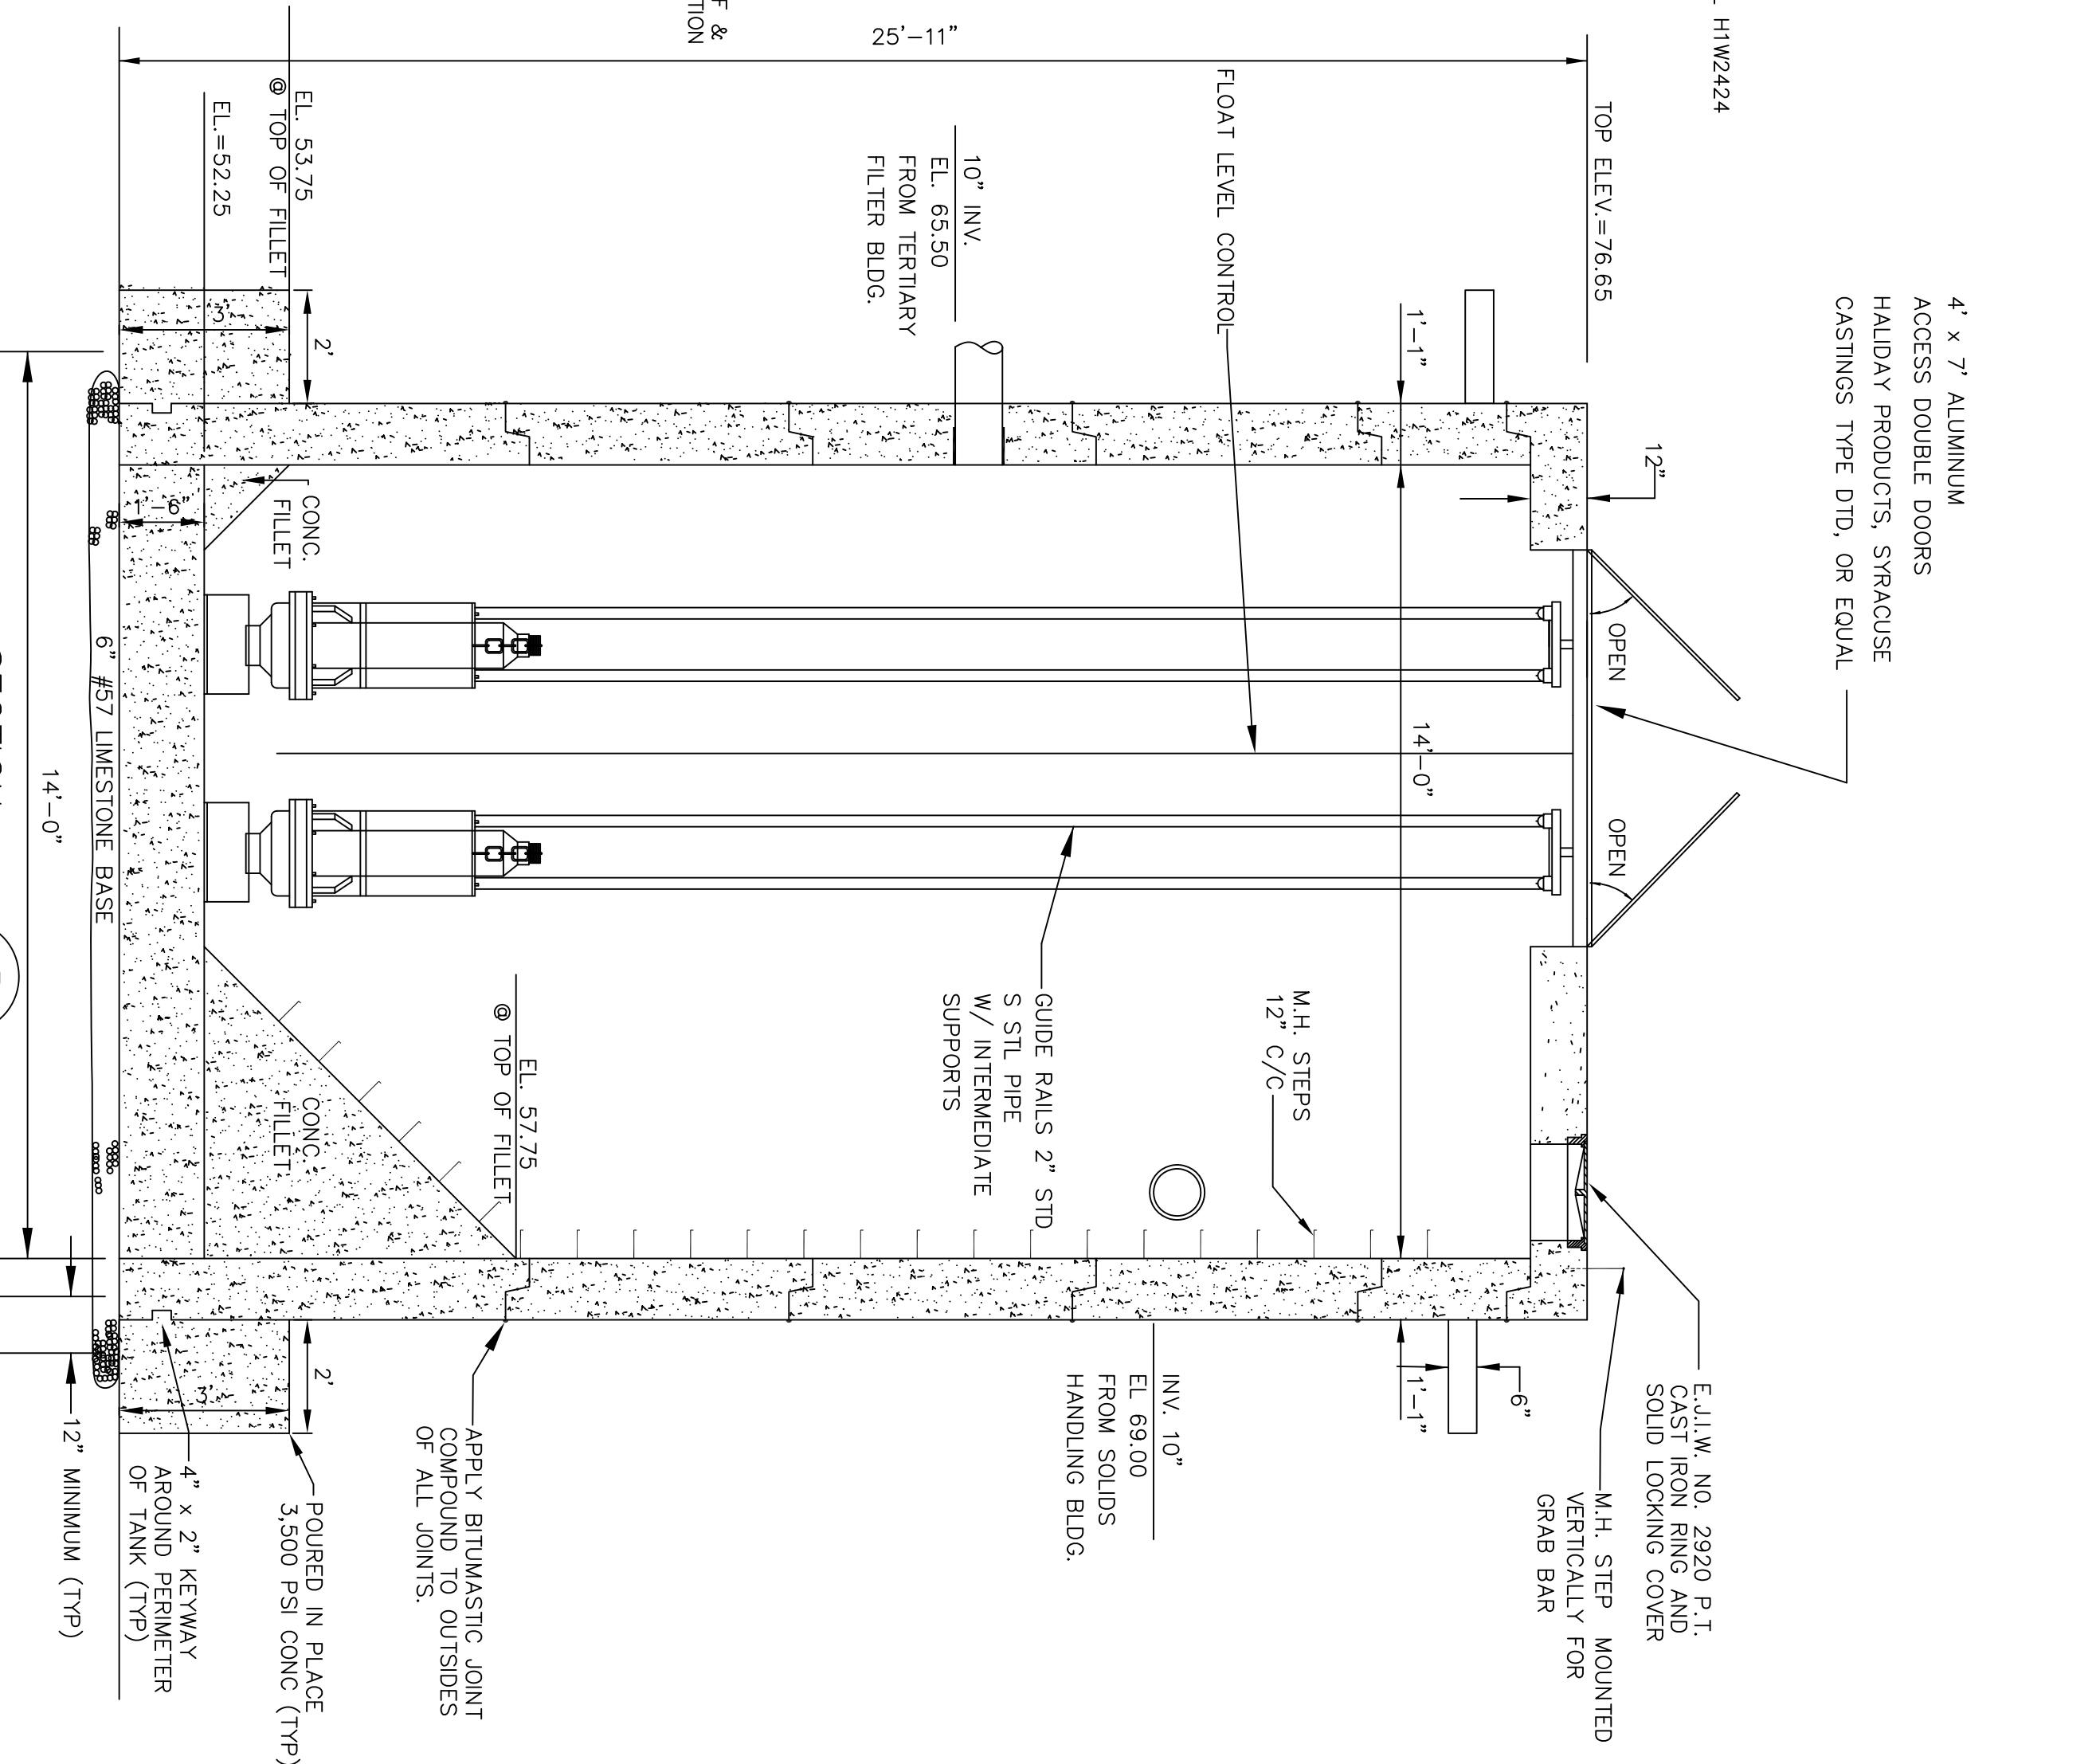


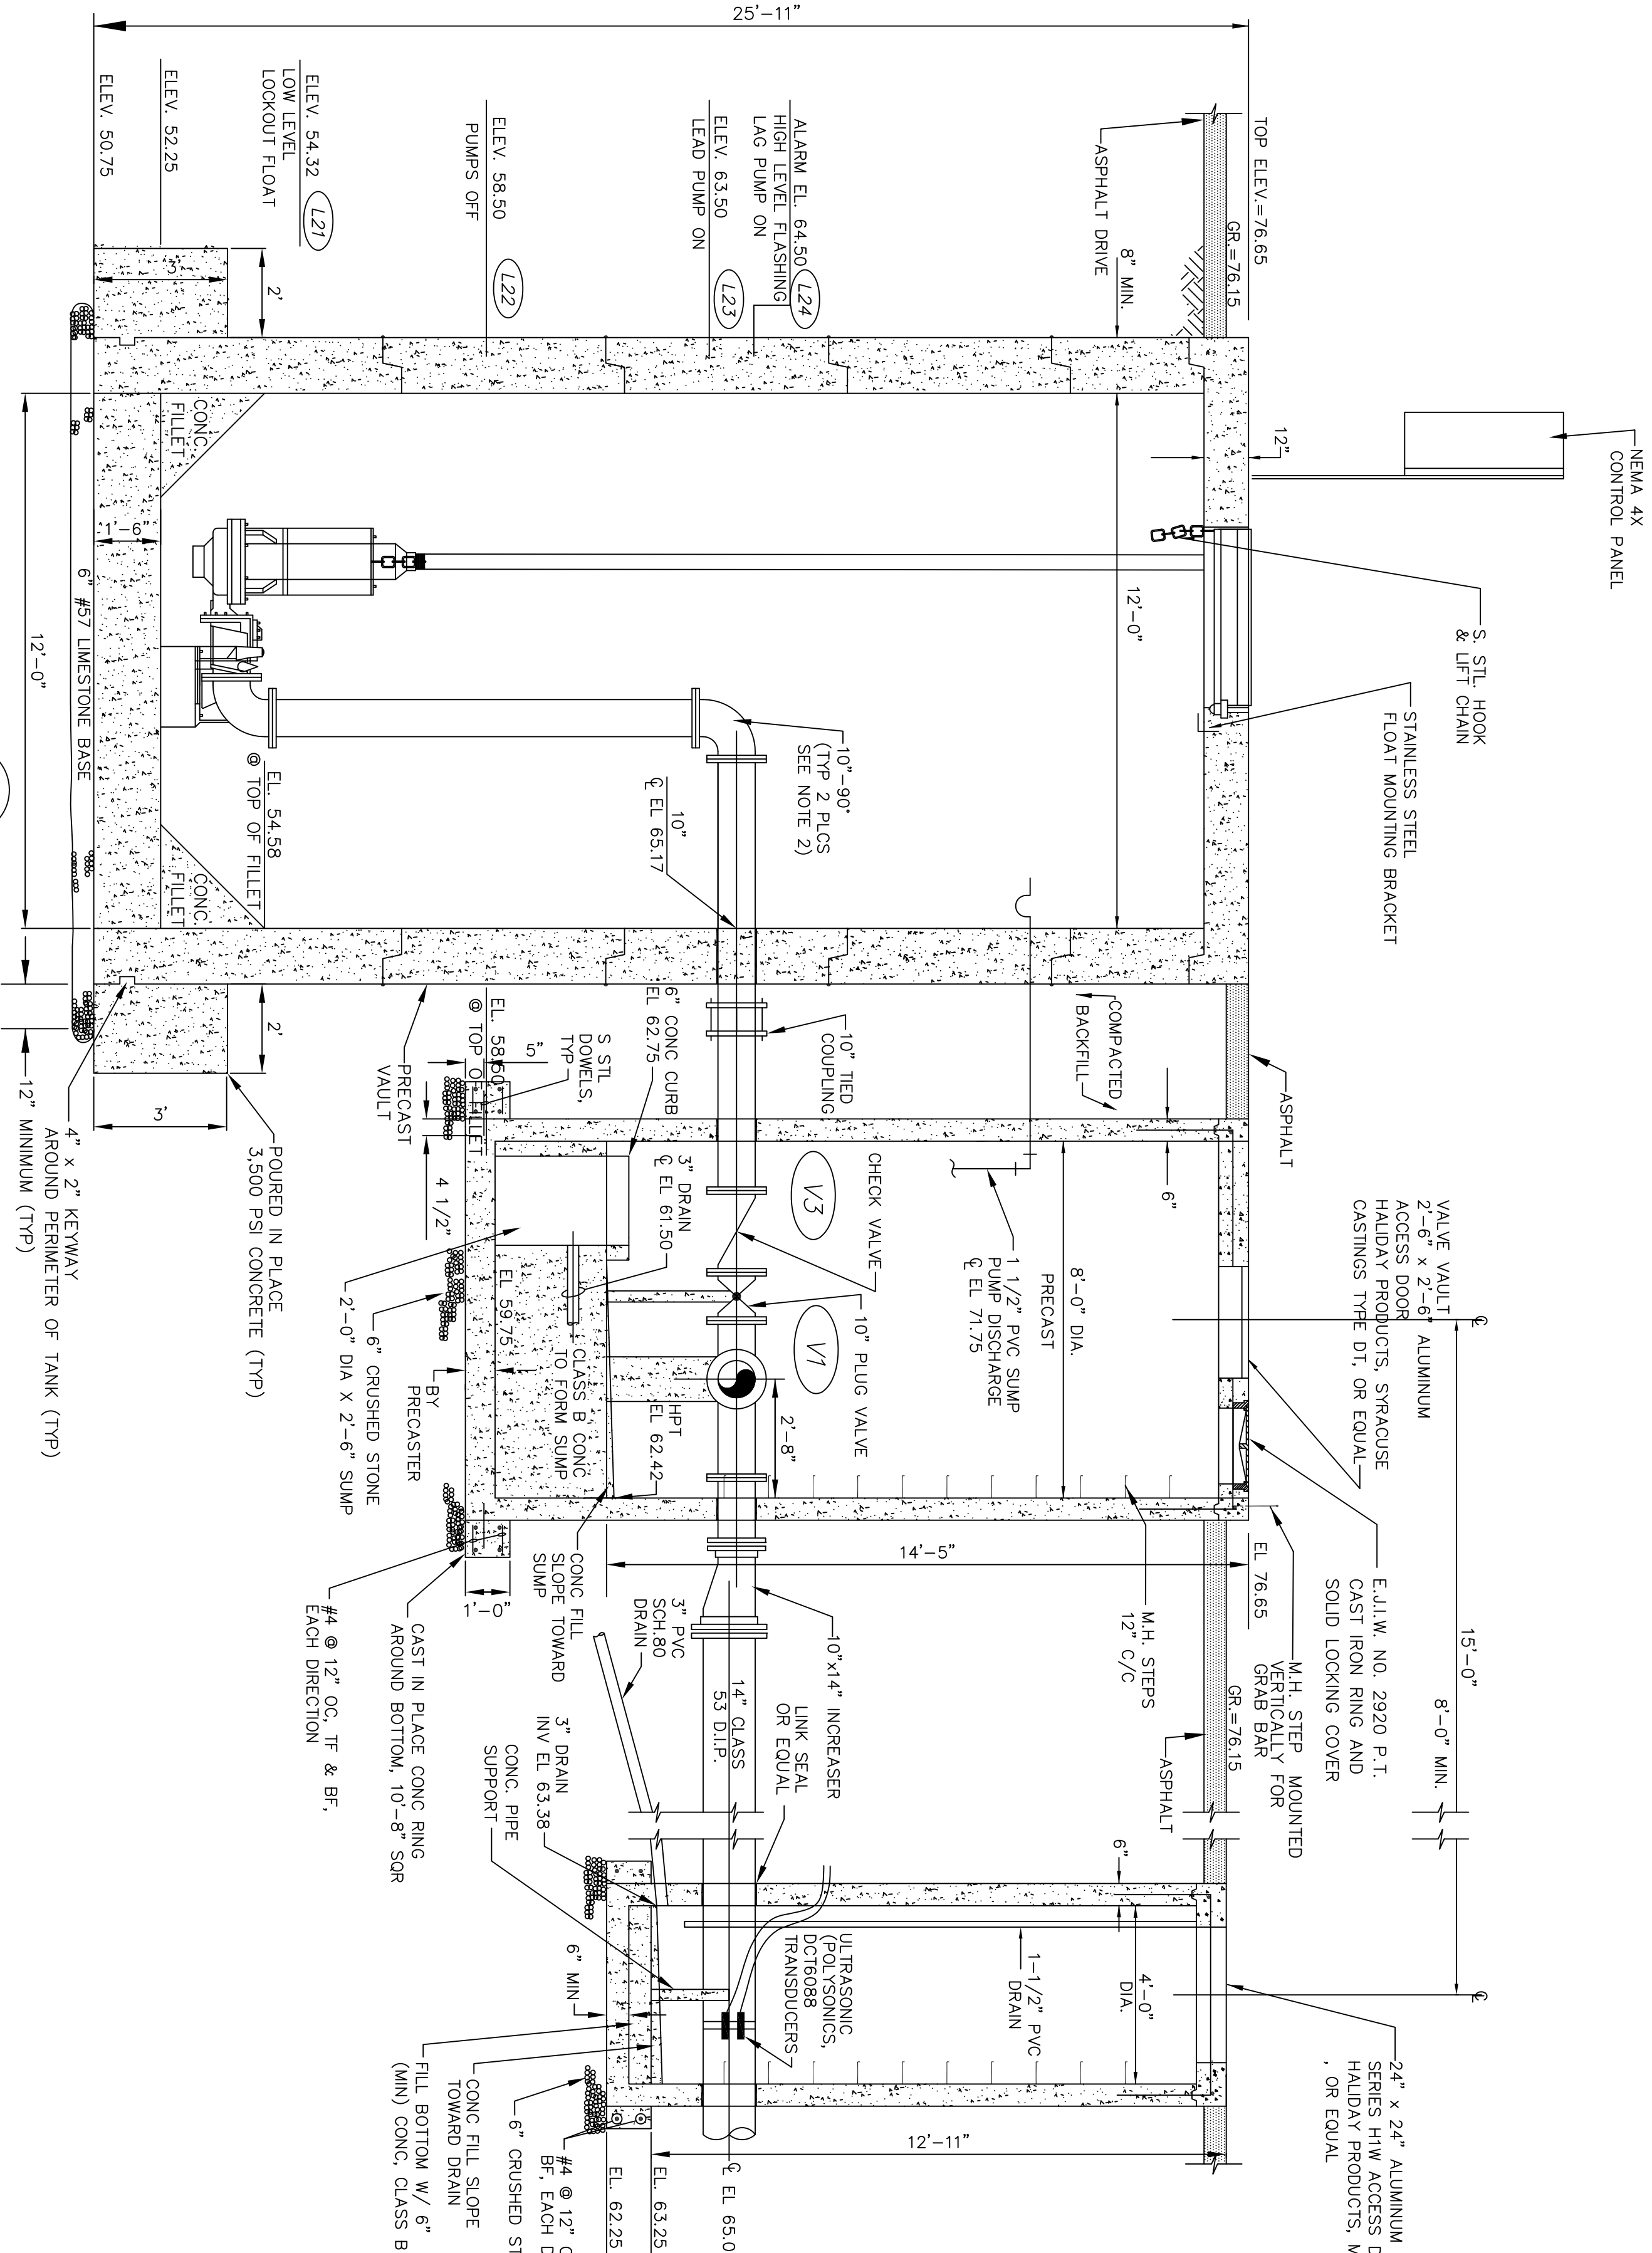

DESIGNED BY
TMK

DRAWN BY
ELR

CHECKED BY
RWR

APPROVED BY
WAD

NO. 1
2
3

DESCRIPTIONS
SEE REVISION CLOUDS
REVISIONS
RECORD DRAWING

DATE
7/02
9/23/02
6/05

BY
ELR
RWR
MGW

APP'D
TMK
WAD
WAD

THIS DRAWING IS AN INSTRUMENT OF SERVICE OWNED BY CTE ENVIRONMENTAL, INC. WHICH SHALL BE DEEMED THE AUTHOR AND WHICH SHALL RETAIN ALL STATUTORY AND COMMON LAW RIGHTS, INCLUDING COPYRIGHTS. THIS DRAWING SHALL NOT BE SCANNED, COPIED, OR DISTRIBUTED TO OTHERS IN ANY FORM OR USED FOR ANY OTHER PURPOSE OR PROJECT WITHOUT PRIOR WRITTEN CONSENT OF CTE ENVIRONMENTAL, INC. CTE ENVIRONMENTAL, INC. CANNOT GUARANTEE THAT ELECTRONIC COPIES OF THIS DRAWING ARE EXACT DUPLICATES OF THE SEALED ORIGINAL DRAWING. IN THE EVENT OF A CONFLICT BETWEEN AN ELECTRONIC COPY AND THE SEALED ORIGINAL, THE SEALED ORIGINAL SHALL GOVERN.

CITY OF MASSILLON , OHIO
WWTP UPGRADE 2000
FILTRATE PUMP STATION SECTIONS AND DETAILS