




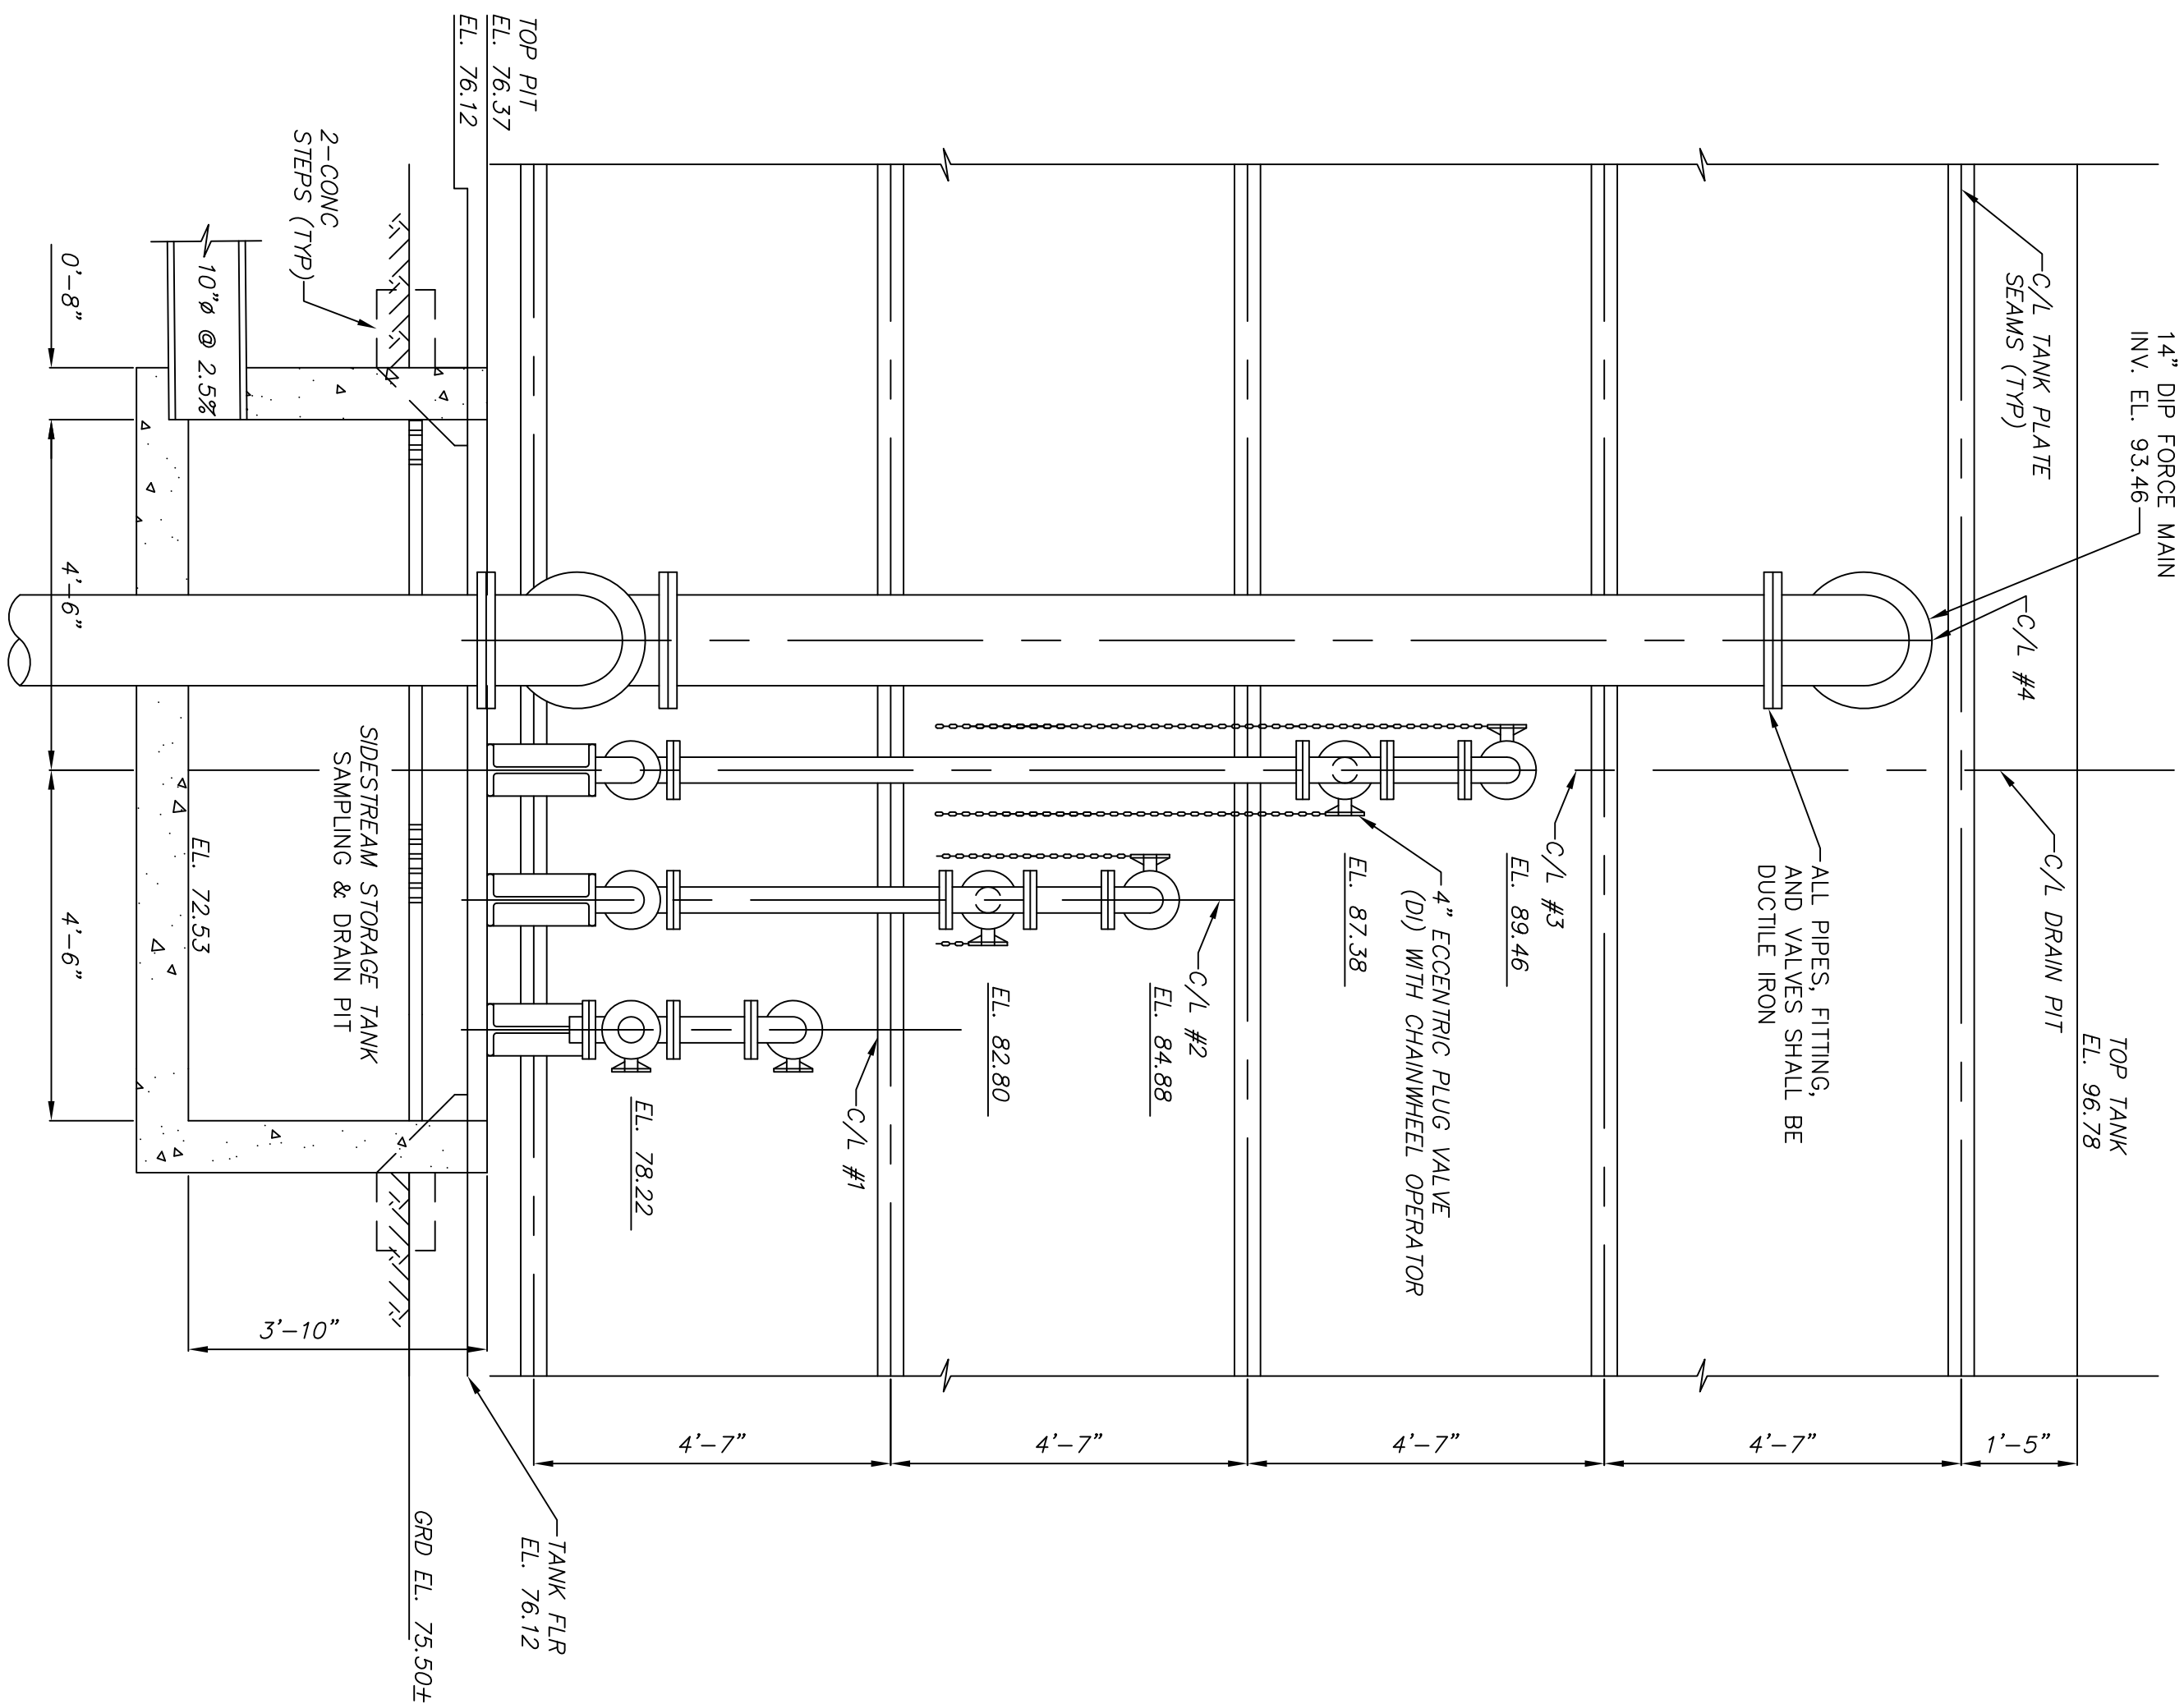

SECTION A-X
SCALE : 1/2"=1'-0"

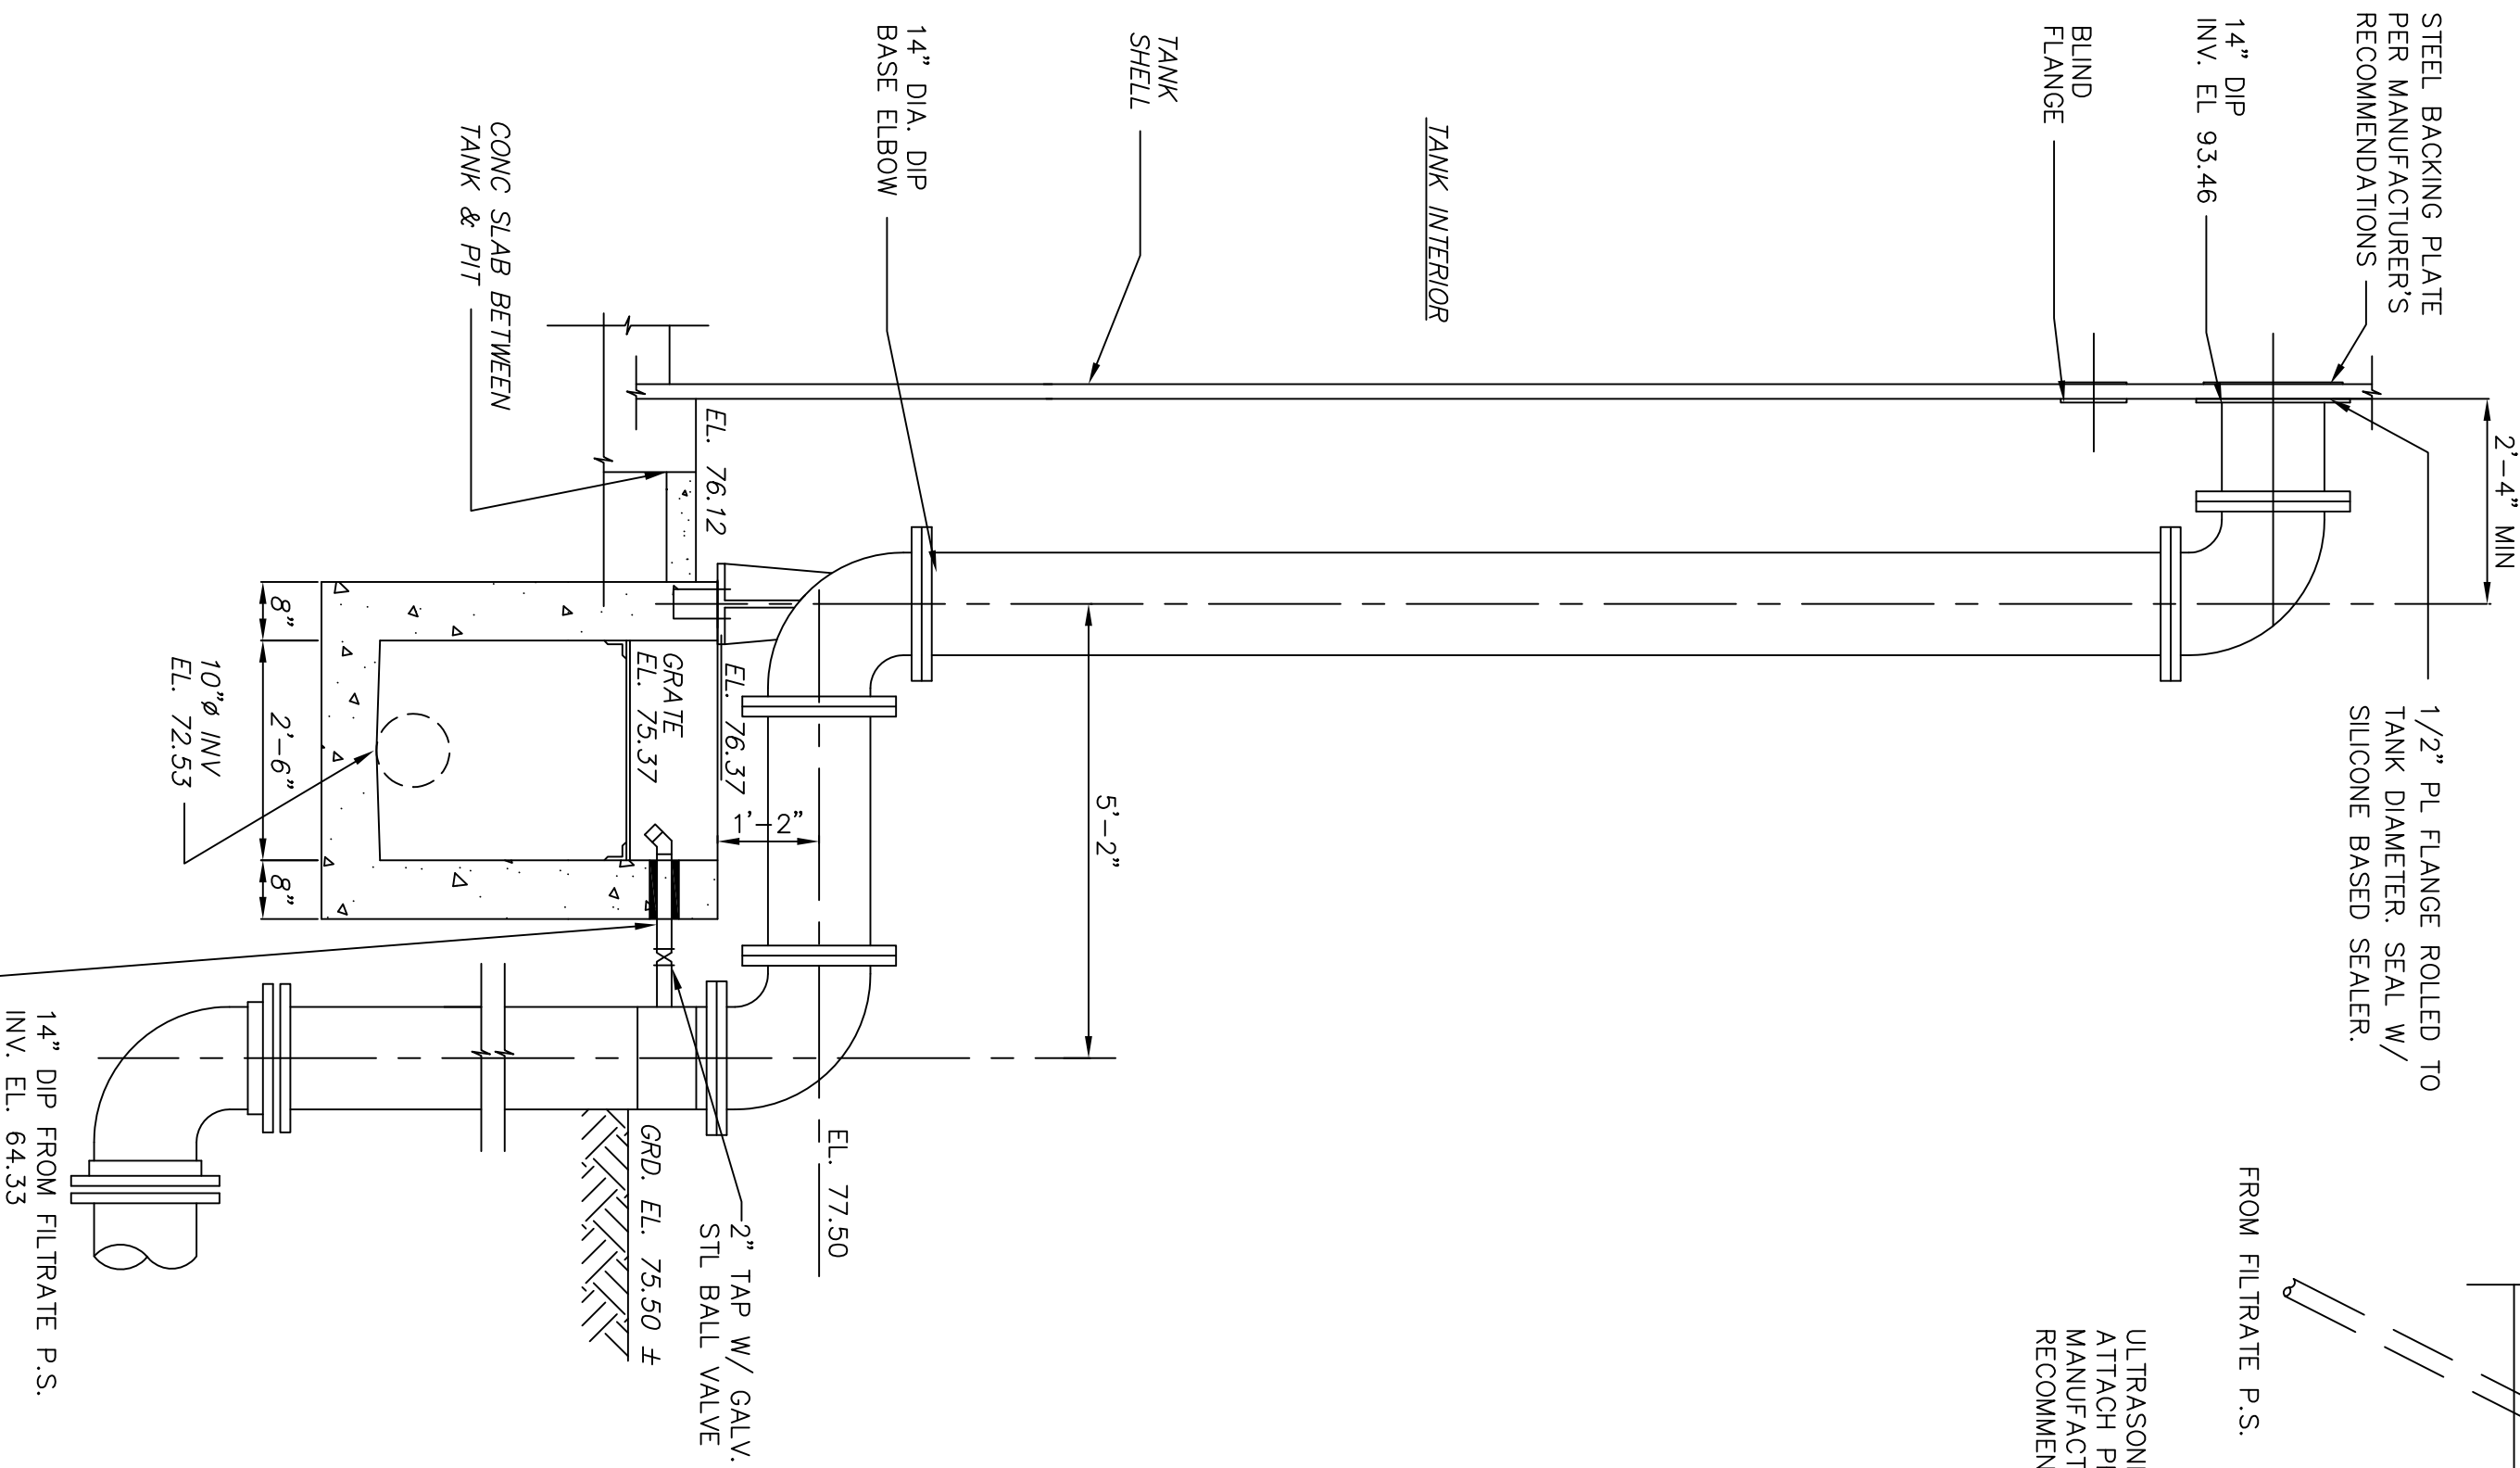

SECTION 1-X
SCALE : 1/2"=1'-0"

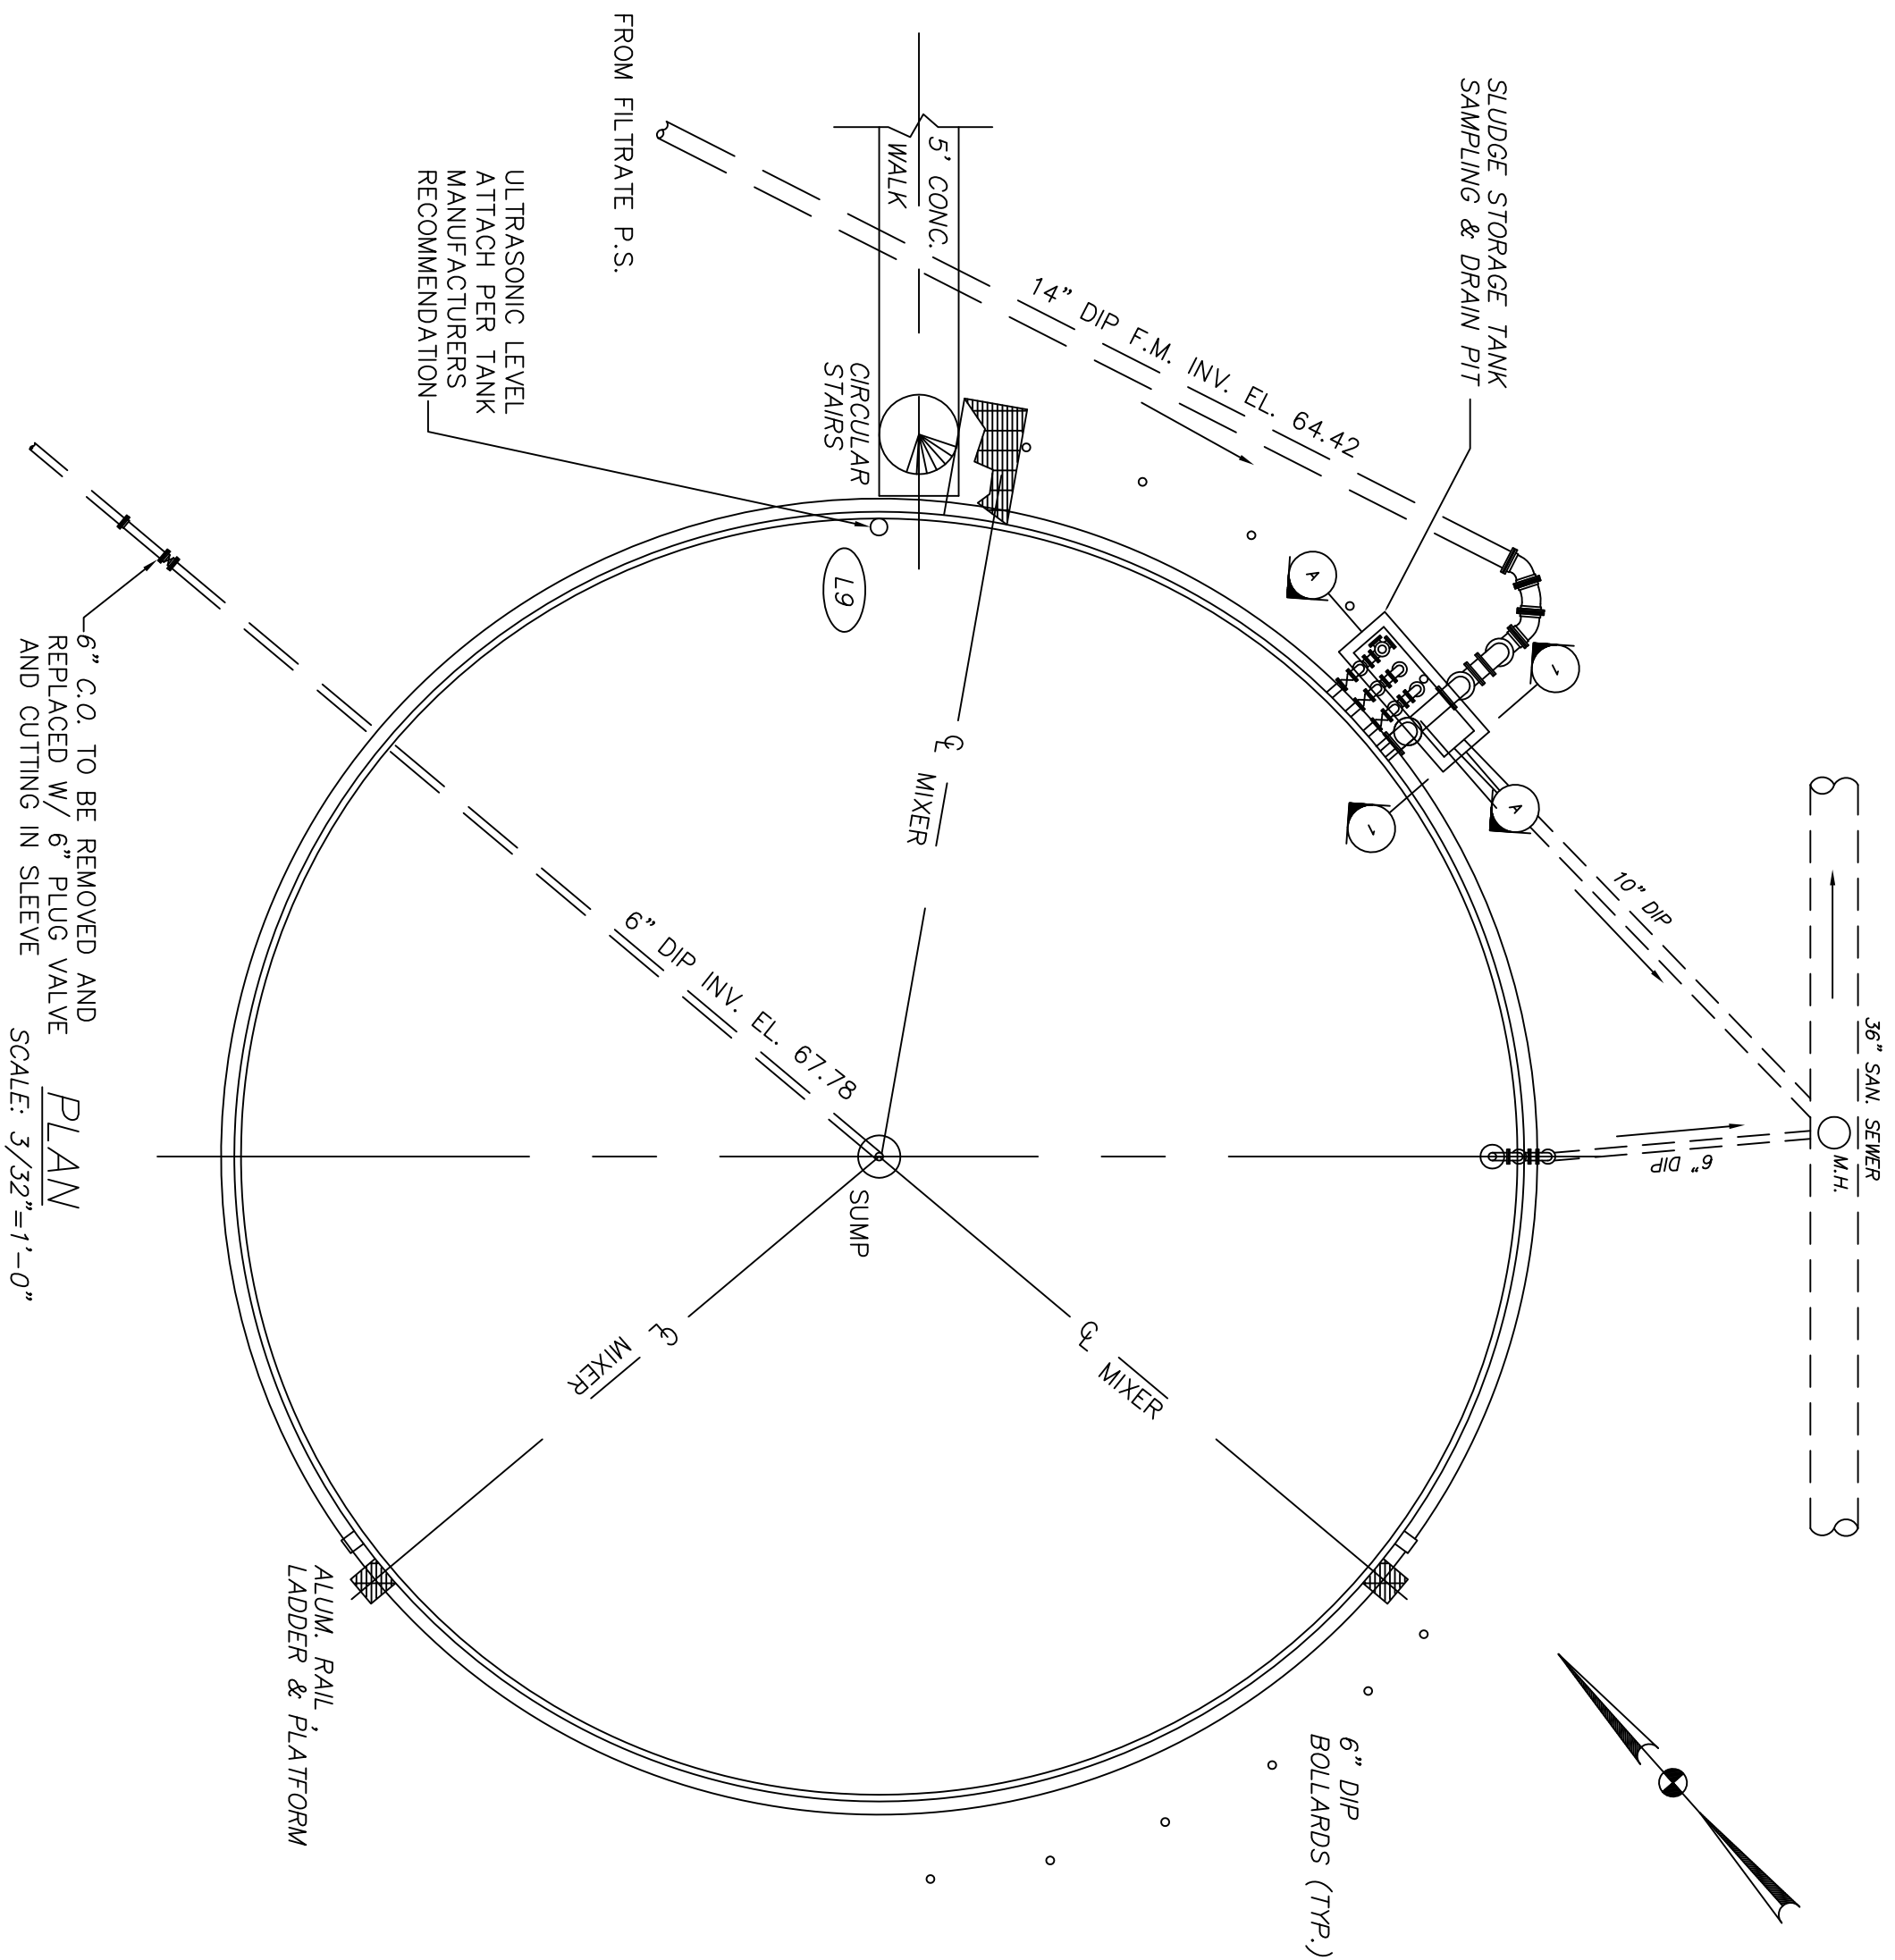

PLAN
SCALE: 3/32"=1'-0"

- NOTES:
1. PUMP OFF EL. 76.62
 2. PUMP ON EL. 77.12

- NOTES TO CONTRACTOR
1. HEAT TRACE AND INSULATE ABOVE GRADE SECTIONS OF THE PROPOSED FORCE MAIN.



ENVIRONMENTAL, INC.
ENGINEERS IN WATER AND EARTH SCIENCES
UNIONTOWN, OHIO

CITY OF MASSILLON , OHIO
WWTP UPGRADE 2000
SIDESTREAM STORAGE TANK PLAN AND SECTIONS

DESIGNED BY	REVISIONS				
	NO.	DESCRIPTIONS	DATE	BY	APP'D
DRAWN BY	1	ADDENDUM NO. 1	9/14	RWR	WAD
	2	RECORD DRAWING	6/05	MGW	WAD
CHECKED BY					
APPROVED BY					

THIS DRAWING IS AN INSTRUMENT OF SERVICE OWNED BY CTI ENVIRONMENTAL, INC. WHICH SHALL BE DEEMED THE AUTHOR AND WHICH SHALL RETAIN ALL STATUTORY AND COMMON LAW RIGHTS, INCLUDING COPYRIGHTS. THIS DRAWING SHALL NOT BE SCANNED, COPIED, OR DISTRIBUTED TO OTHERS IN ANY FORM OR USED FOR ANY OTHER PURPOSE OR PROJECT WITHOUT PRIOR WRITTEN CONSENT OF CTI ENVIRONMENTAL, INC. CTI ENVIRONMENTAL, INC. CANNOT GUARANTEE THAT ELECTRONIC COPIES OF THIS DRAWING ARE EXACT DUPLICATES OF THE SEALED ORIGINAL DRAWING. IN THE EVENT OF A CONFLICT BETWEEN AN ELECTRONIC COPY AND THE SEALED ORIGINAL, THE SEALED ORIGINAL SHALL GOVERN.

THESE RECORD DOCUMENTS HAVE BEEN PREPARED BASED ON INFORMATION PROVIDED BY OTHERS. CTI ENVIRONMENTAL HAS REVIEWED THE INFORMATION SUBMITTED AND BELIEVES IT REFLECTS THE WORK AS CONSTRUCTED HOWEVER, ALL PERSONS SHALL VERIFY INFORMATION TAKEN FROM THIS DRAWING.

DES. NO.	E9031
DATE	08/13/01
SCALE	AS NOTED
SHEET	P128