

THIS DRAWING IS AN INSTRUMENT OF SERVICE OWNED BY CTI ENVIRONMENTAL, INC. WHICH SHALL BE DEEMED THE AUTHOR AND WHICH SHALL RETAIN ALL STATUTORY AND COMMON LAW RIGHTS, INCLUDING COPYRIGHTS. THIS DRAWING SHALL NOT BE SCANNED, COPIED, OR DISTRIBUTED TO OTHERS IN ANY FORM OR USED FOR ANY OTHER PURPOSE OR PROJECT WITHOUT PRIOR WRITTEN CONSENT OF CTI ENVIRONMENTAL, INC. CTI ENVIRONMENTAL, INC. CANNOT GUARANTEE THAT ELECTRONIC COPIES OF THIS DRAWING ARE EXACT DUPLICATES OF THE SEALED ORIGINAL DRAWING. IN THE EVENT OF A CONFLICT BETWEEN AN ELECTRONIC COPY AND THE SEALED ORIGINAL, THE SEALED ORIGINAL SHALL GOVERN.

| DESIGNED BY | REVISIONS |                |      |     |       |
|-------------|-----------|----------------|------|-----|-------|
|             | NO.       | DESCRIPTIONS   | DATE | BY  | APP'D |
| TMK         | 1         | ADDENDUM NO. 1 | 9/14 | RWR | WAD   |
|             | 2         | ADD HEAT TRACE | 8/05 | WAD | WAD   |
| CHECKED BY  | 3         | RECORD DRAWING | 8/05 | RWR | WAD   |
| APPROVED BY |           |                |      |     |       |
|             | WAD       |                |      |     |       |


**CTI** ENVIRONMENTAL, INC.  
ENGINEERS IN WATER AND EARTH SCIENCES  
UNIONTOWN, OHIO

CITY OF MASSILLON , OHIO  
WWTP UPGRADE 2000  
SIDESTREAM STORAGE TANK PLAN AND SECTIONS.


- NOTES:
1. PUMP OFF EL. 76.62
  2. PUMP ON EL. 77.12

NOTES TO CONTRACTOR

1. HEAT TRACE AND INSULATE ABOVE GRADE SECTIONS OF THE PROPOSED FORCE MAIN.

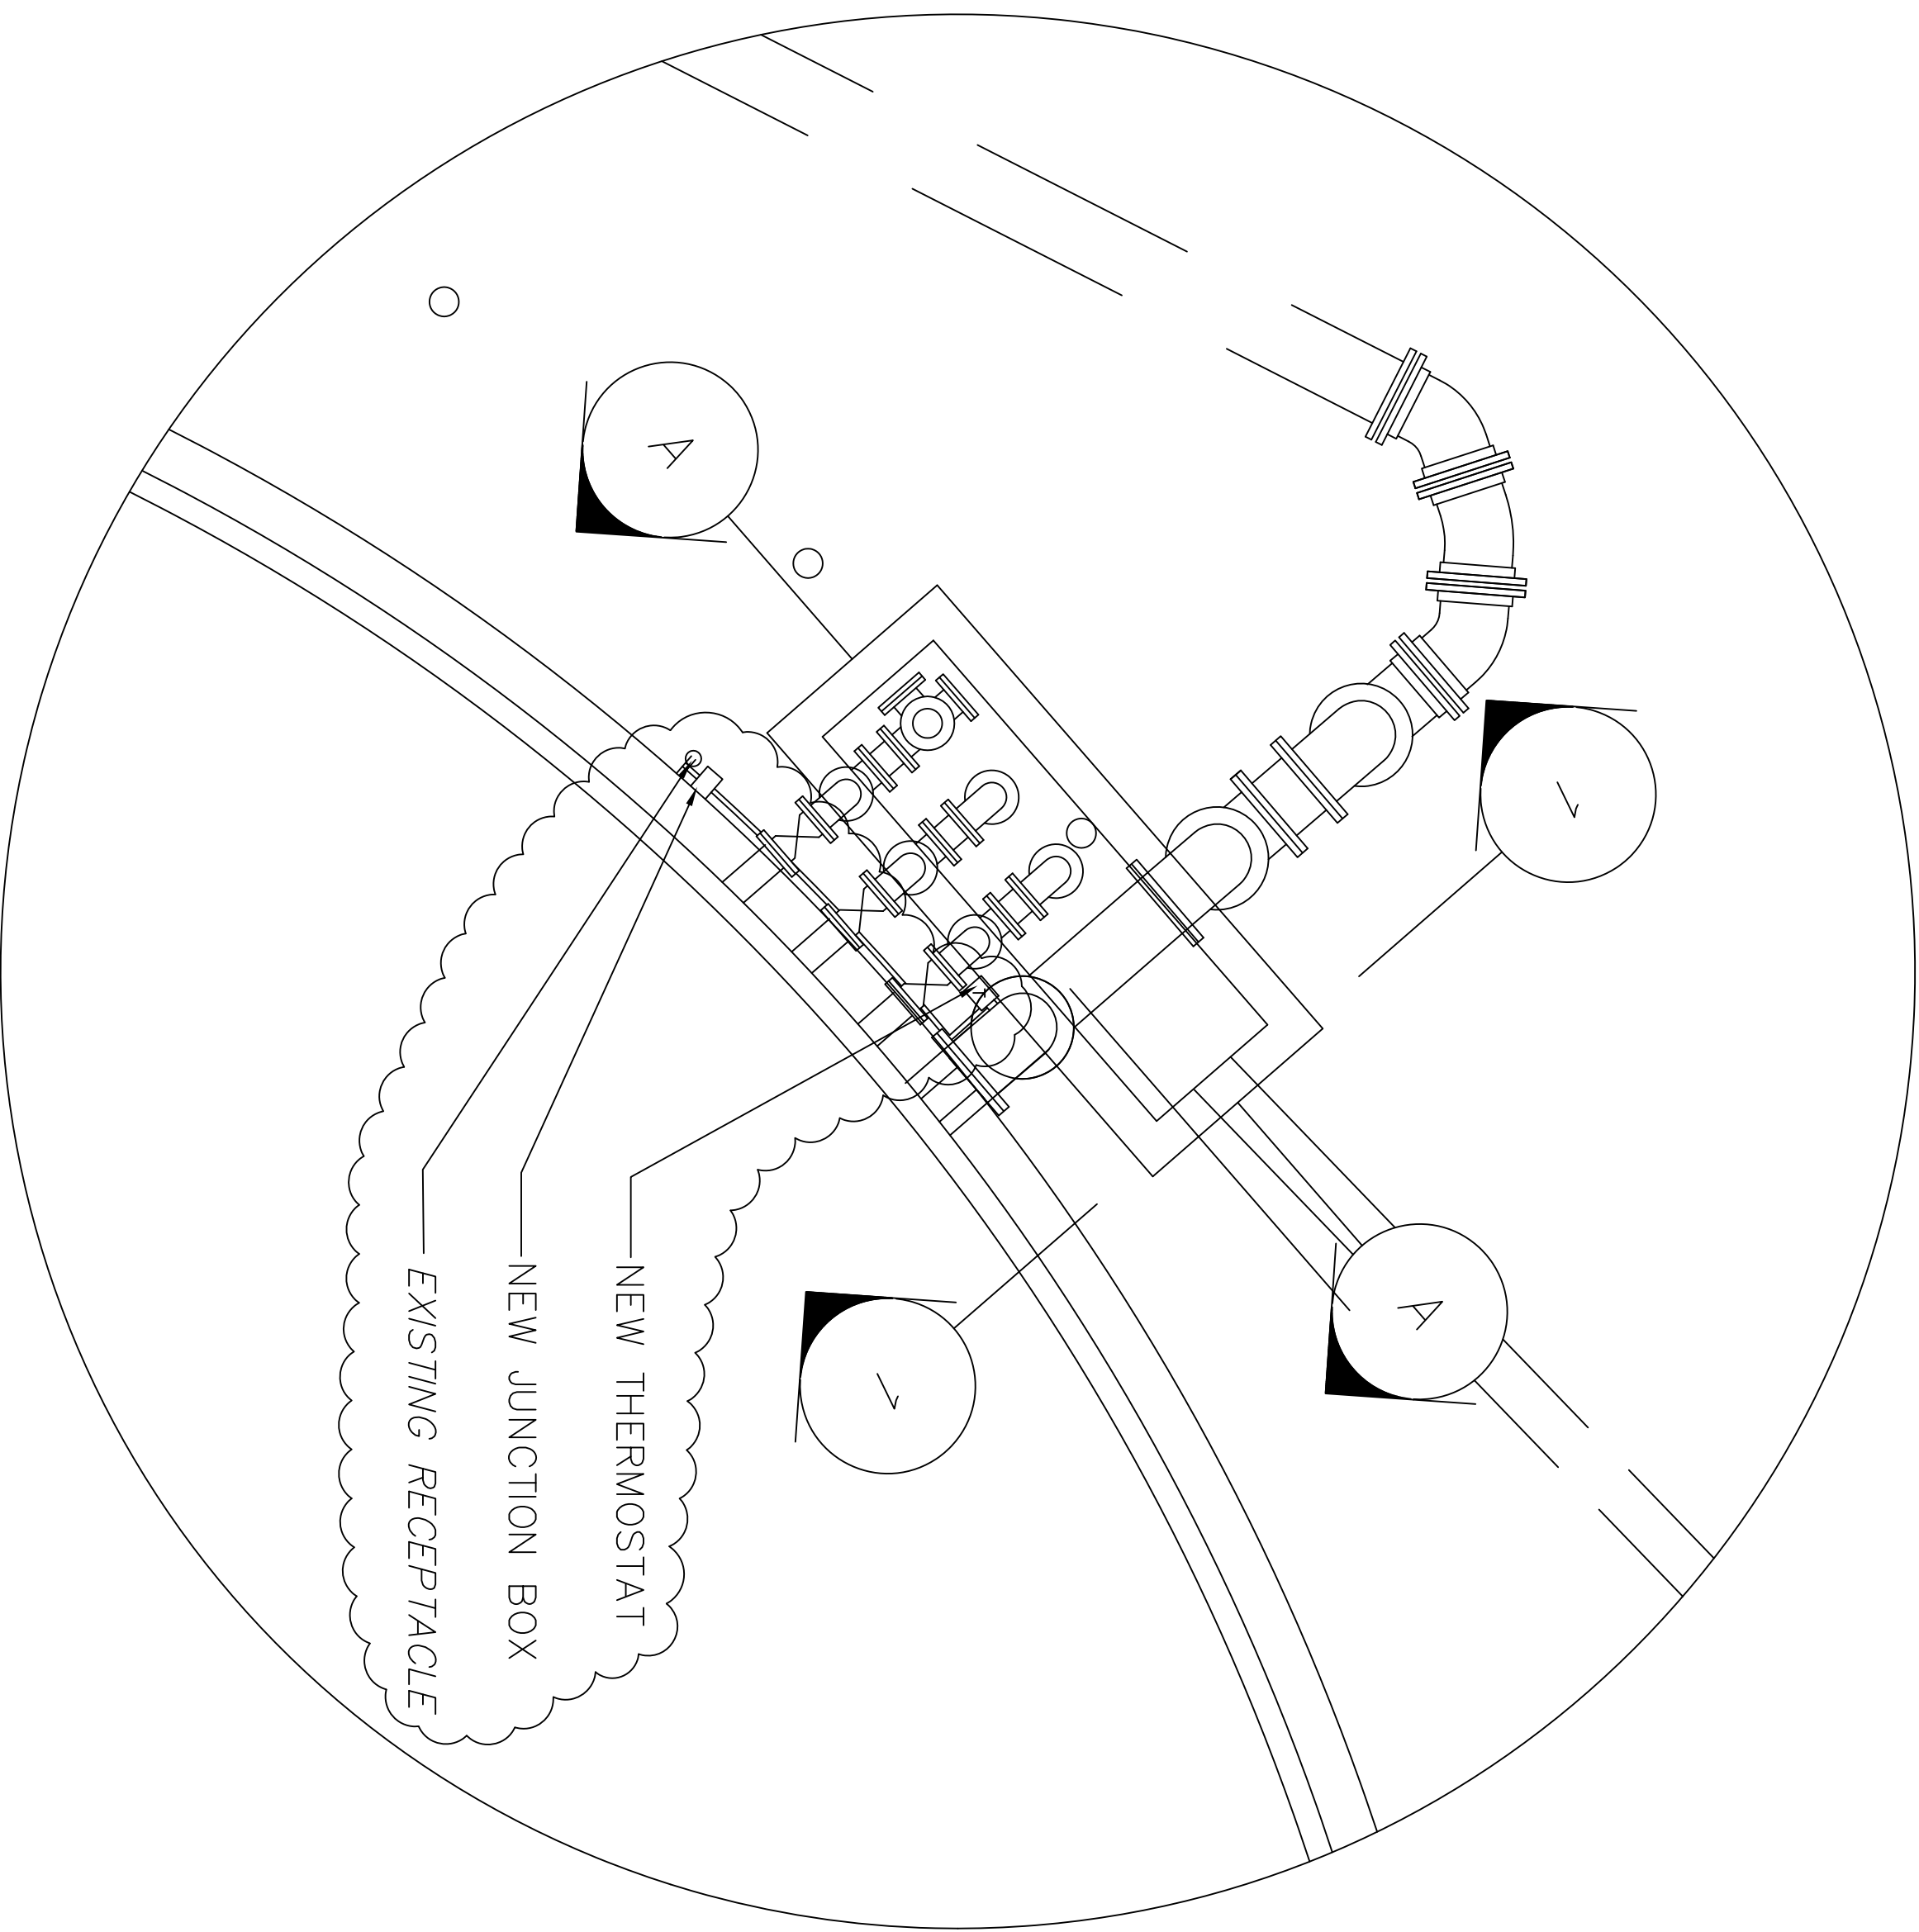

DETAIL 1  
SCALE: 3/8"=1'-0"

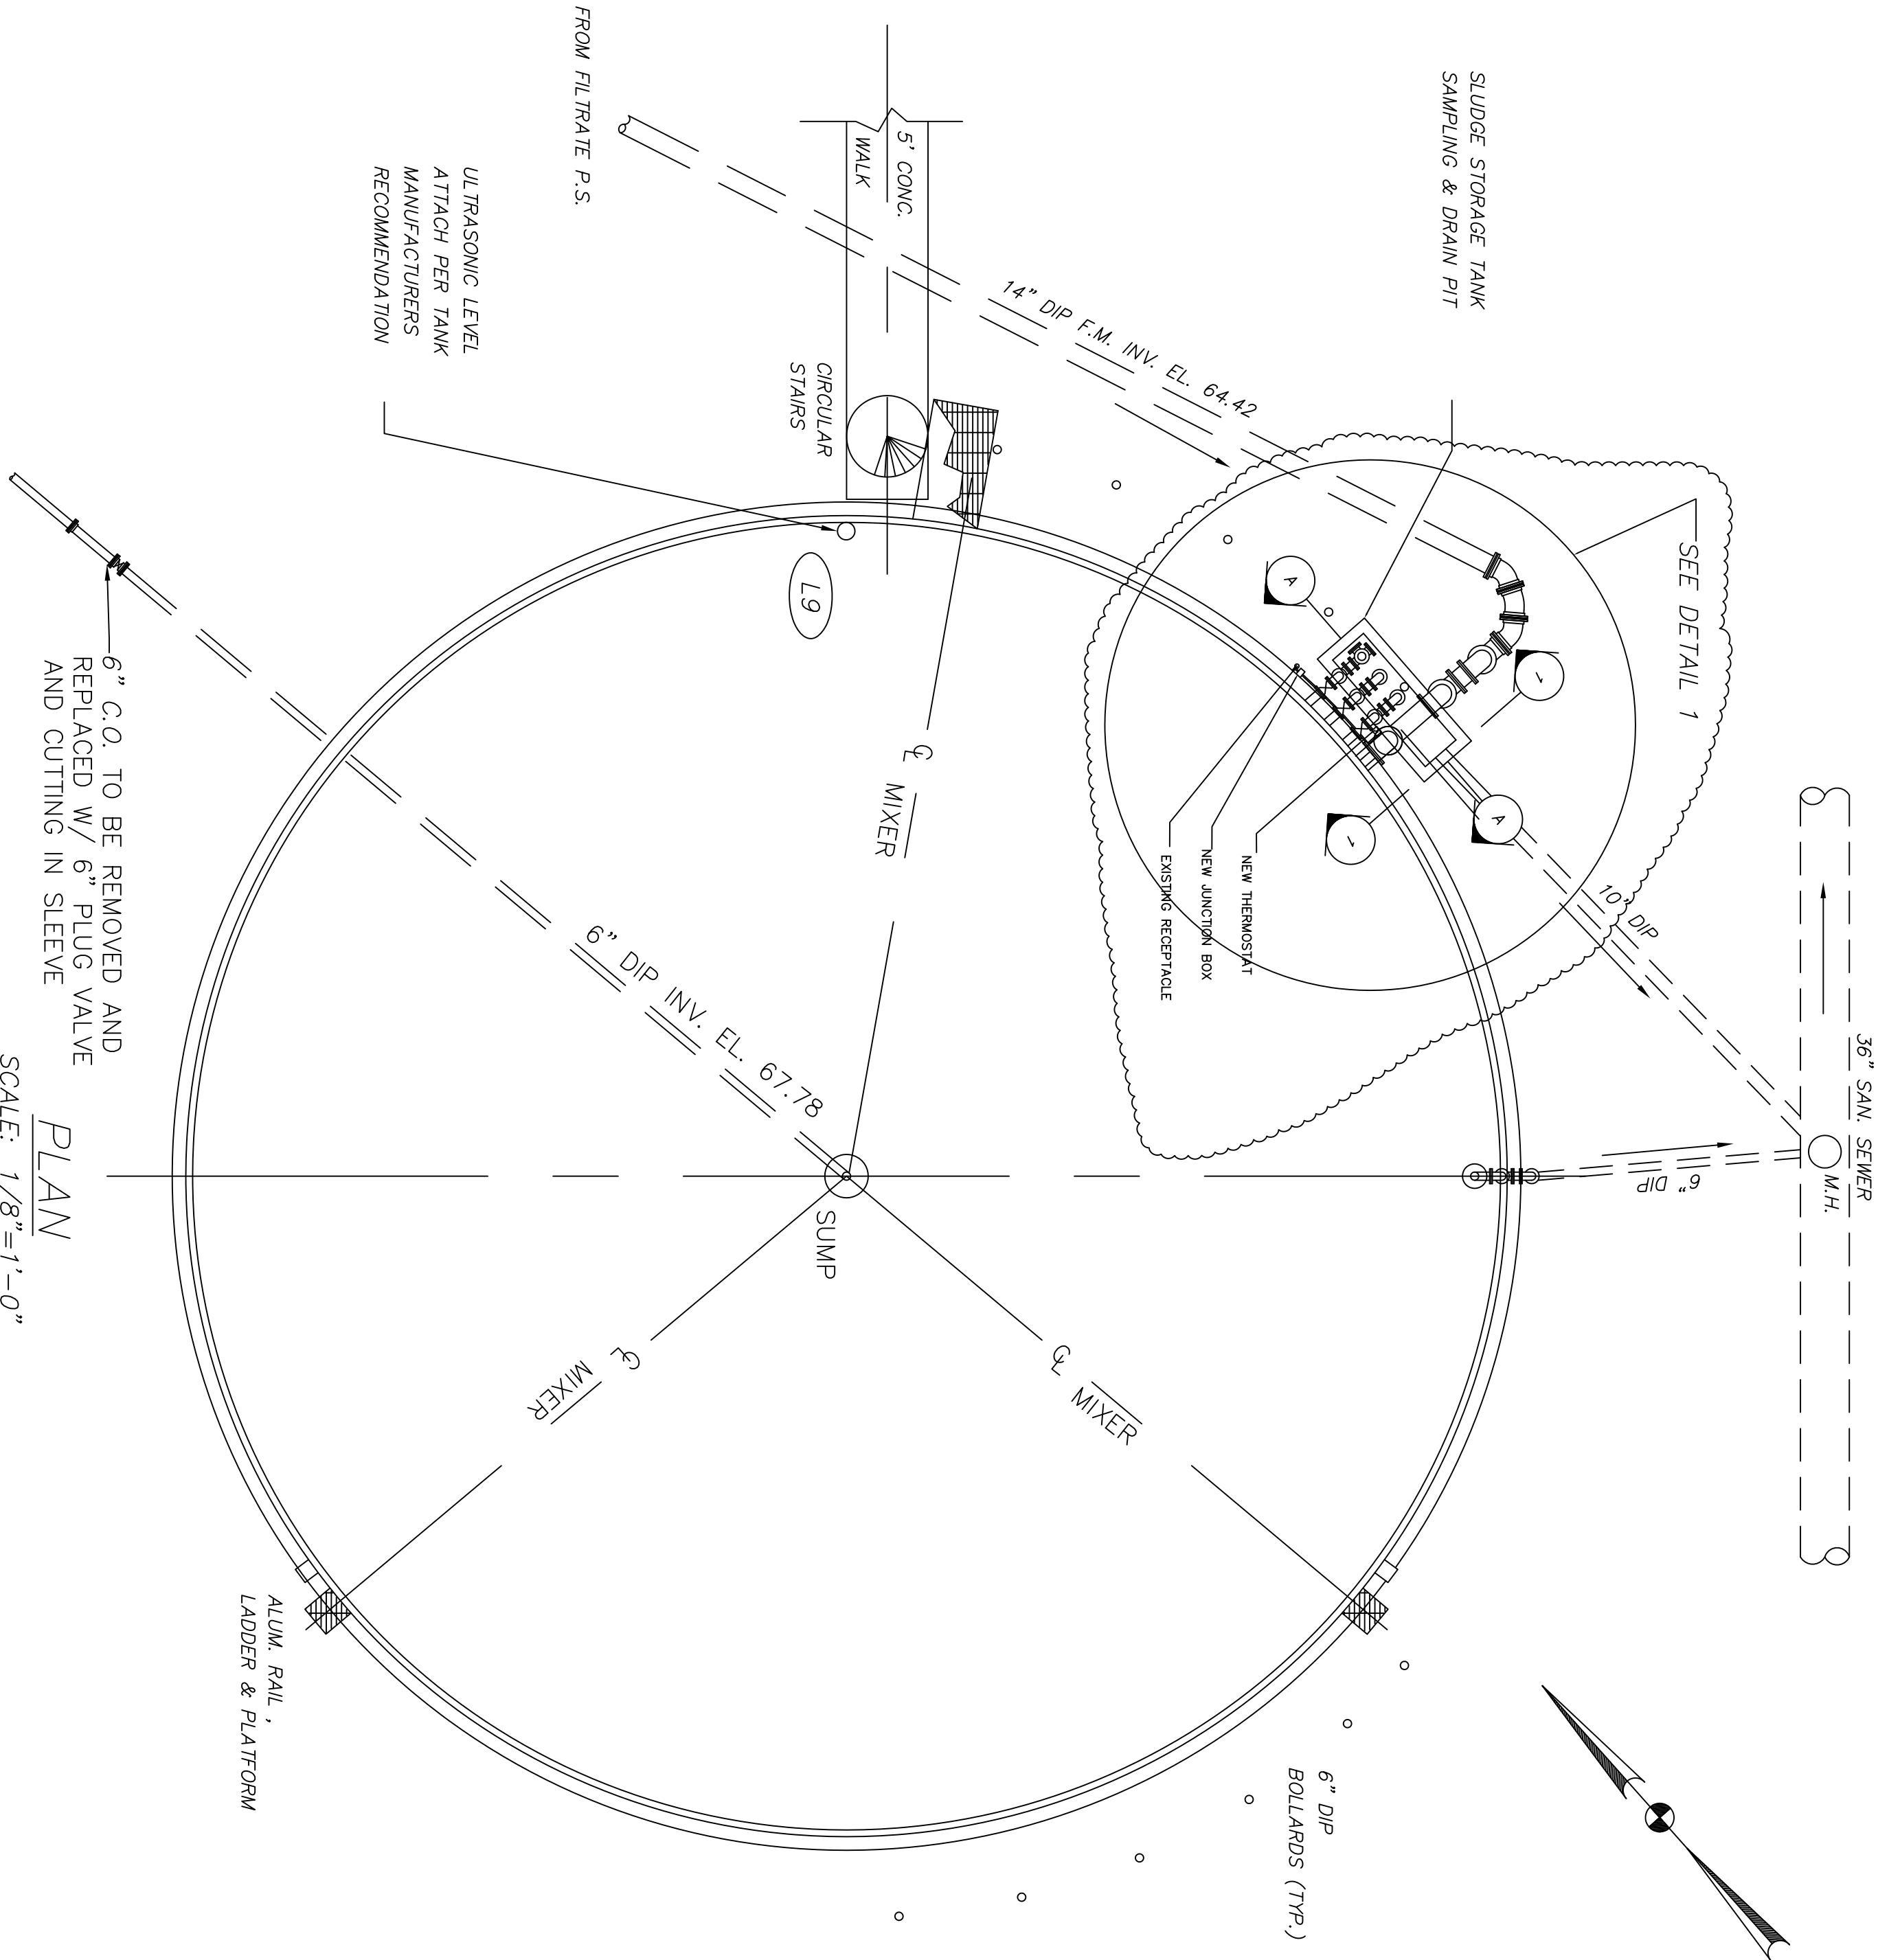

THESE RECORD DOCUMENTS HAVE BEEN PREPARED BASED ON INFORMATION PROVIDED BY OTHERS. CTI ENVIRONMENTAL HAS REVIEWED THE INFORMATION SUBMITTED AND BELIEVES IT REFLECTS THE WORK AS CONSTRUCTED. HOWEVER, ALL PERSONS SHALL VERIFY INFORMATION TAKEN FROM THIS DRAWING.

|          |          |
|----------|----------|
| FIG. NO. | E9031    |
| DATE     | 08/13/01 |
| SCALE    | AS NOTED |
| SHEET    | P128     |