



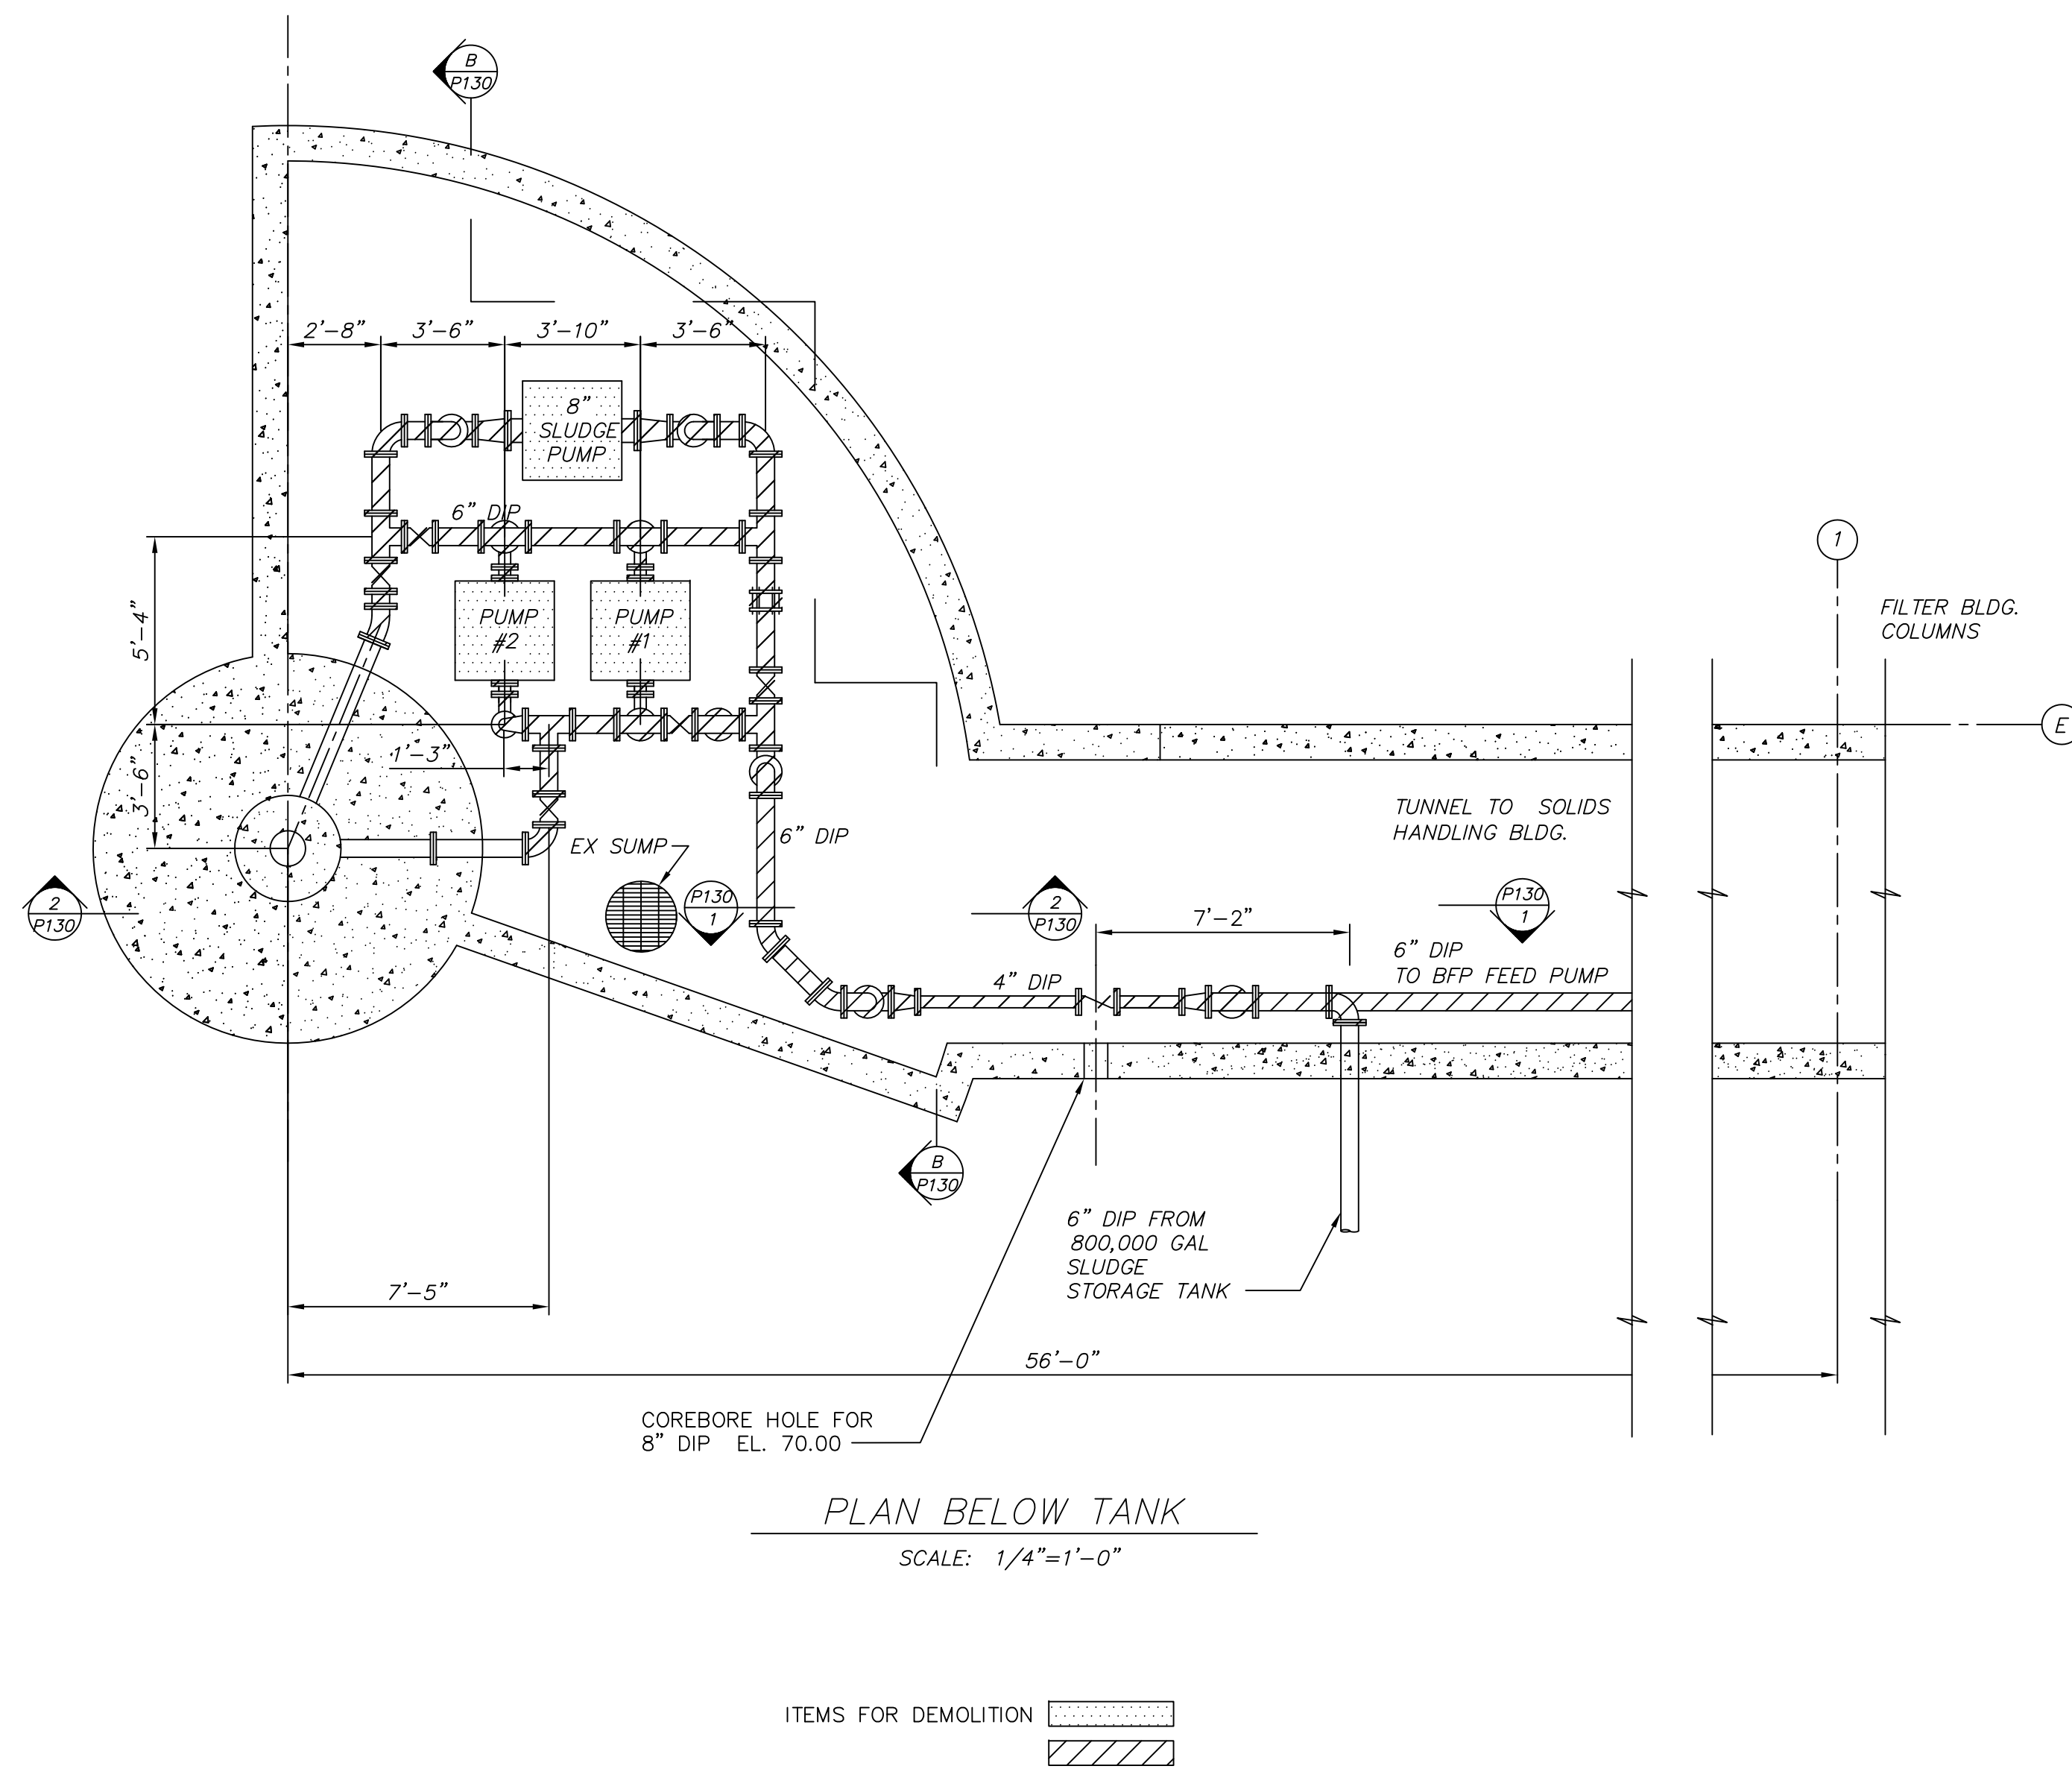

THESE RECORD DOCUMENTS HAVE BEEN PREPARED  
BASED ON INFORMATION PROVIDED BY OTHERS. CTI  
ENVIRONMENTAL HAS REVIEWED THE INFORMATION  
SUBMITTED AND BELIEVES IT REFLECTS THE WORK AS  
CONSTRUCTED. HOWEVER, ALL PERSONS SHALL  
VERIFY INFORMATION TAKEN FROM THIS DRAWING.

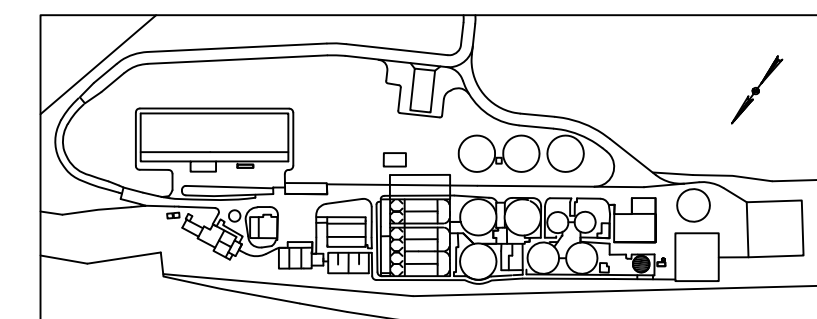

THIS DRAWING IS AN INSTRUMENT OF SERVICE OWNED BY CITI ENVIRONMENTAL, INC. WHICH SHALL BE DEMYED TO THE AUTHOR AND WHICH SHALL RETAIN ALL STATUTORY RIGHTS OF CITI ENVIRONMENTAL, INC. IN THIS DRAWING. THIS DRAWING IS NOT TO BE REPRODUCED, COPIED, OR DISTRIBUTED TO OTHERS IN ANY FORM OR BY ANY OTHER PURPOSE OR PROJECT WITHOUT PRIOR WRITTEN PERMISSION OF CITI ENVIRONMENTAL, INC. CANNOT GUARANTEE THAT ELECTRONIC COPIES OF THIS DRAWING ARE EXACT REPRODUCTIONS OF THE ORIGINAL. IN THE EVENT OF A CONFLICT BETWEEN AN ELECTRONIC COPY AND THE SEALED ORIGINAL, THE SEALED ORIGINAL SHALL GOVERN.

| DESIGNED BY |                | REVISIONS |     |       |  |
|-------------|----------------|-----------|-----|-------|--|
| NO.         | DESCRIPTIONS   | DATE      | BY  | APP'D |  |
| DRAWN BY    | RECORD DRAWING | 6/05      | MCW | WAD   |  |
| SAT         |                |           |     |       |  |
| CHECKED BY  |                |           |     |       |  |
| MCW         |                |           |     |       |  |
| APPROVED BY |                |           |     |       |  |
| WAD         |                |           |     |       |  |

ENVIRONMENTAL, INC.  
ENGINEERS IN WATER AND EARTH SCIENCES  
UNIONTOWN, OHIO

CITY OF MASSILLON, OHIO  
WWTP UPGRADE 2000  
OXIDIZED SLUDGE THICKENER PLAN-D

|            |
|------------|
| JOB NO.    |
| E9031      |
| DATE       |
| 08/13/01   |
| SCALE      |
| 1/4"=1'-0" |
| SHEET      |
| P129       |