



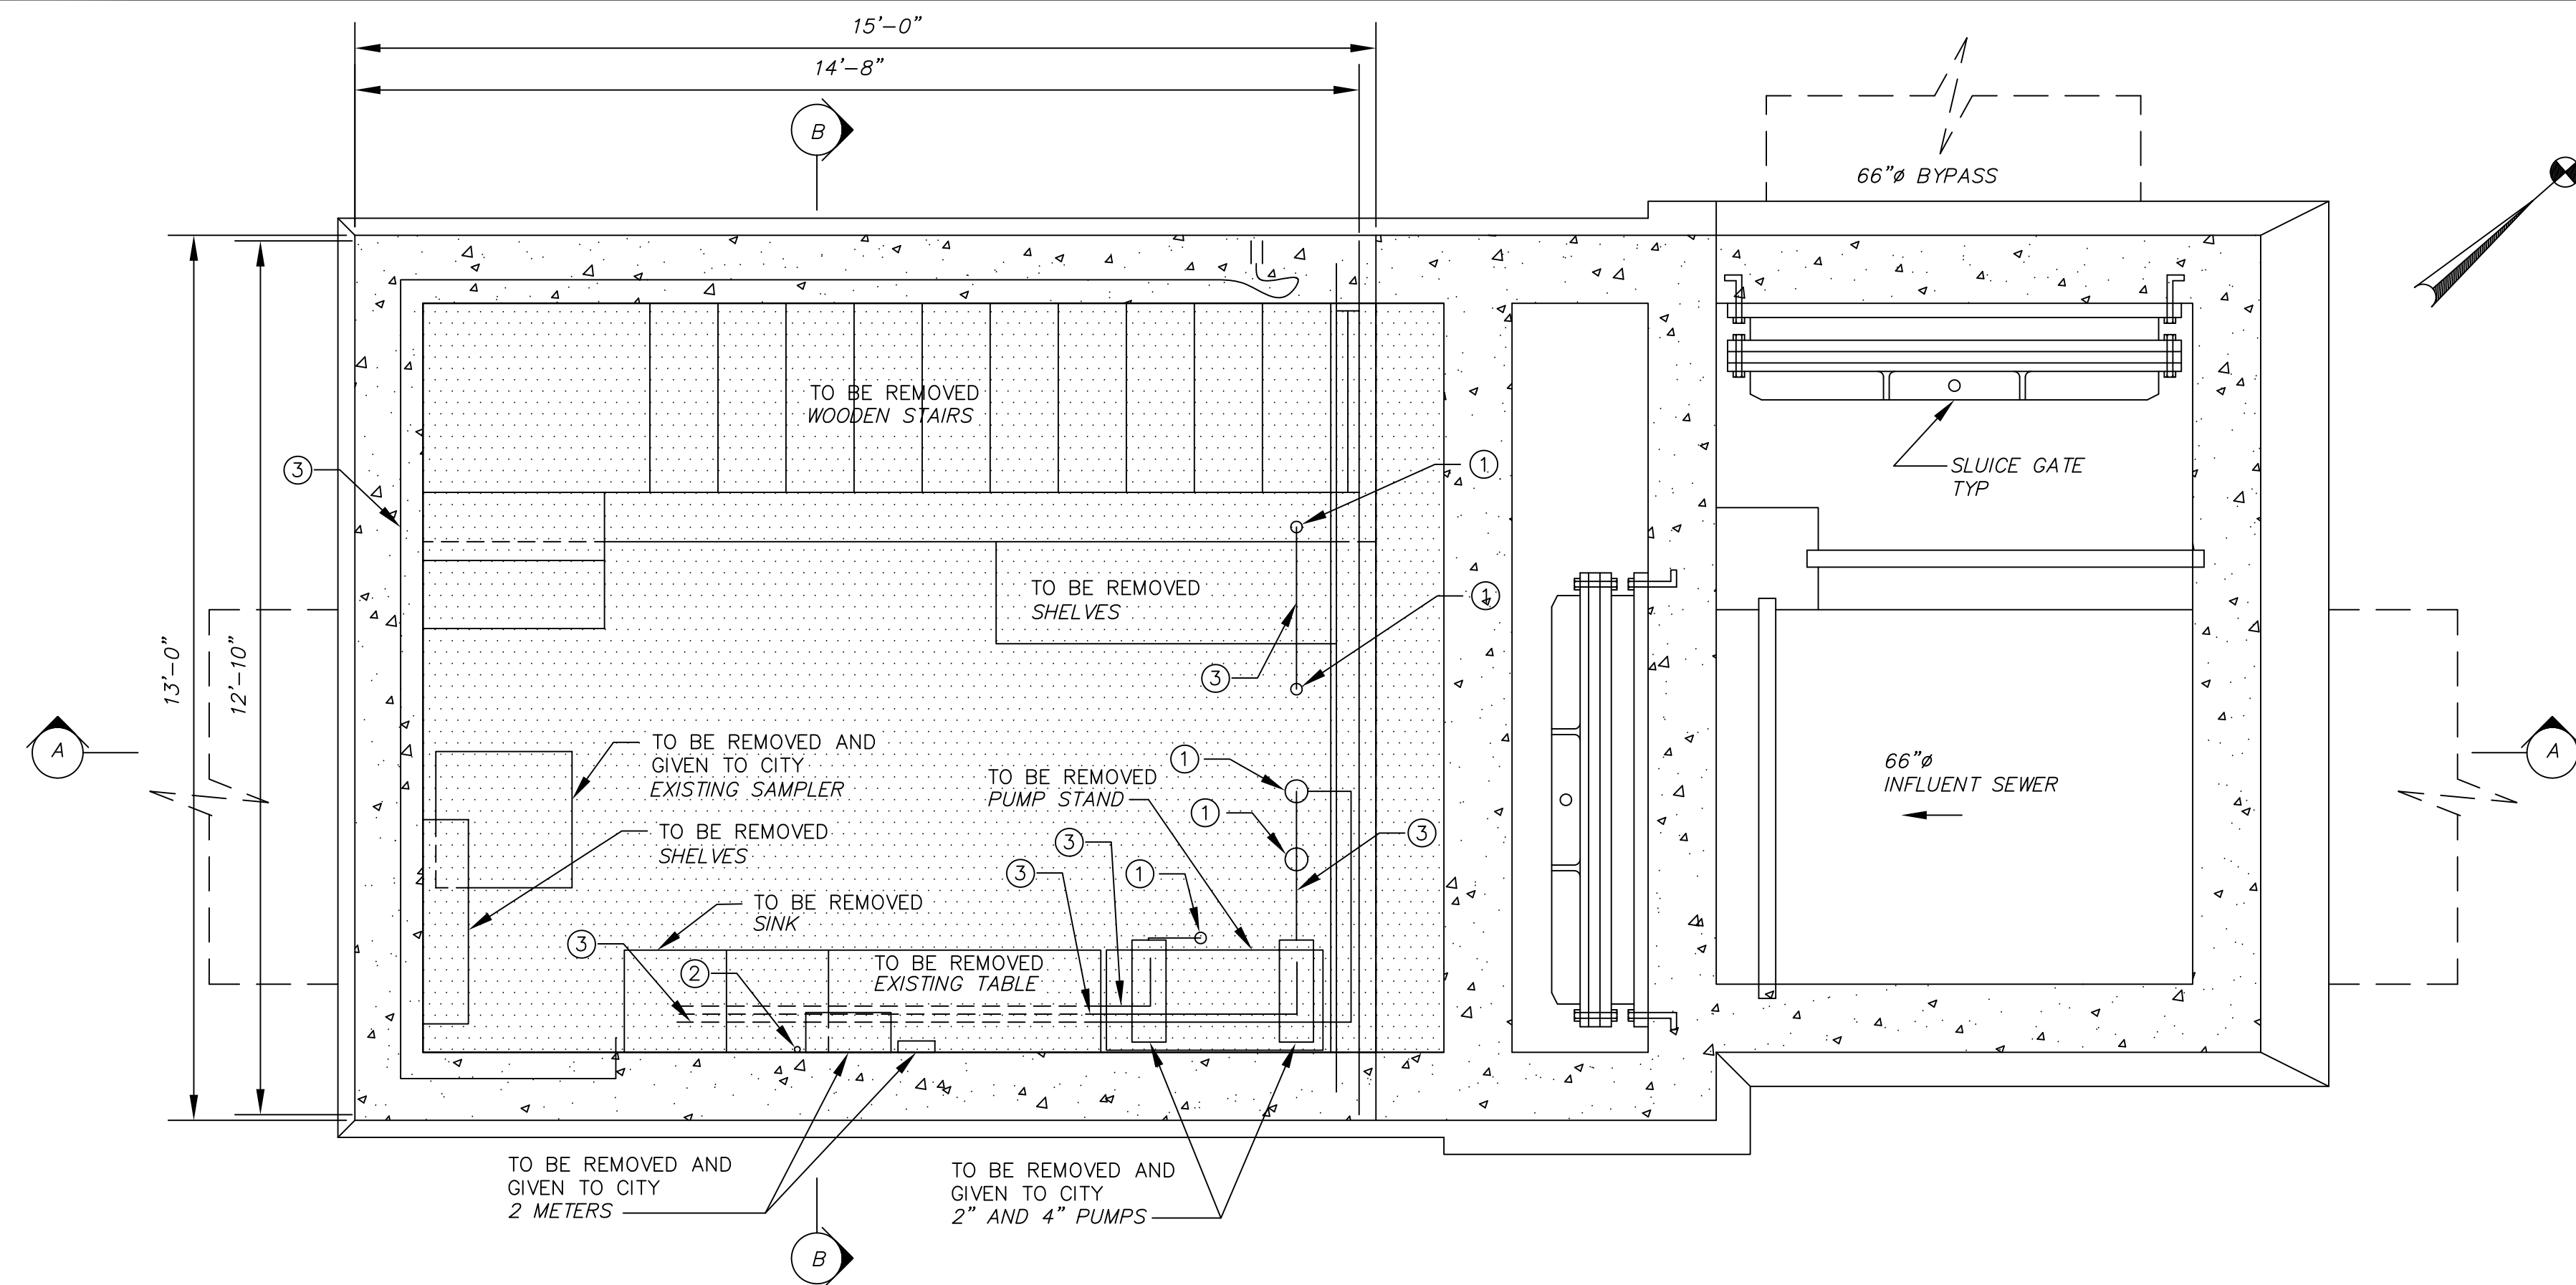


PLAN AT EL 81.00
SCALE 1/2" = 1'

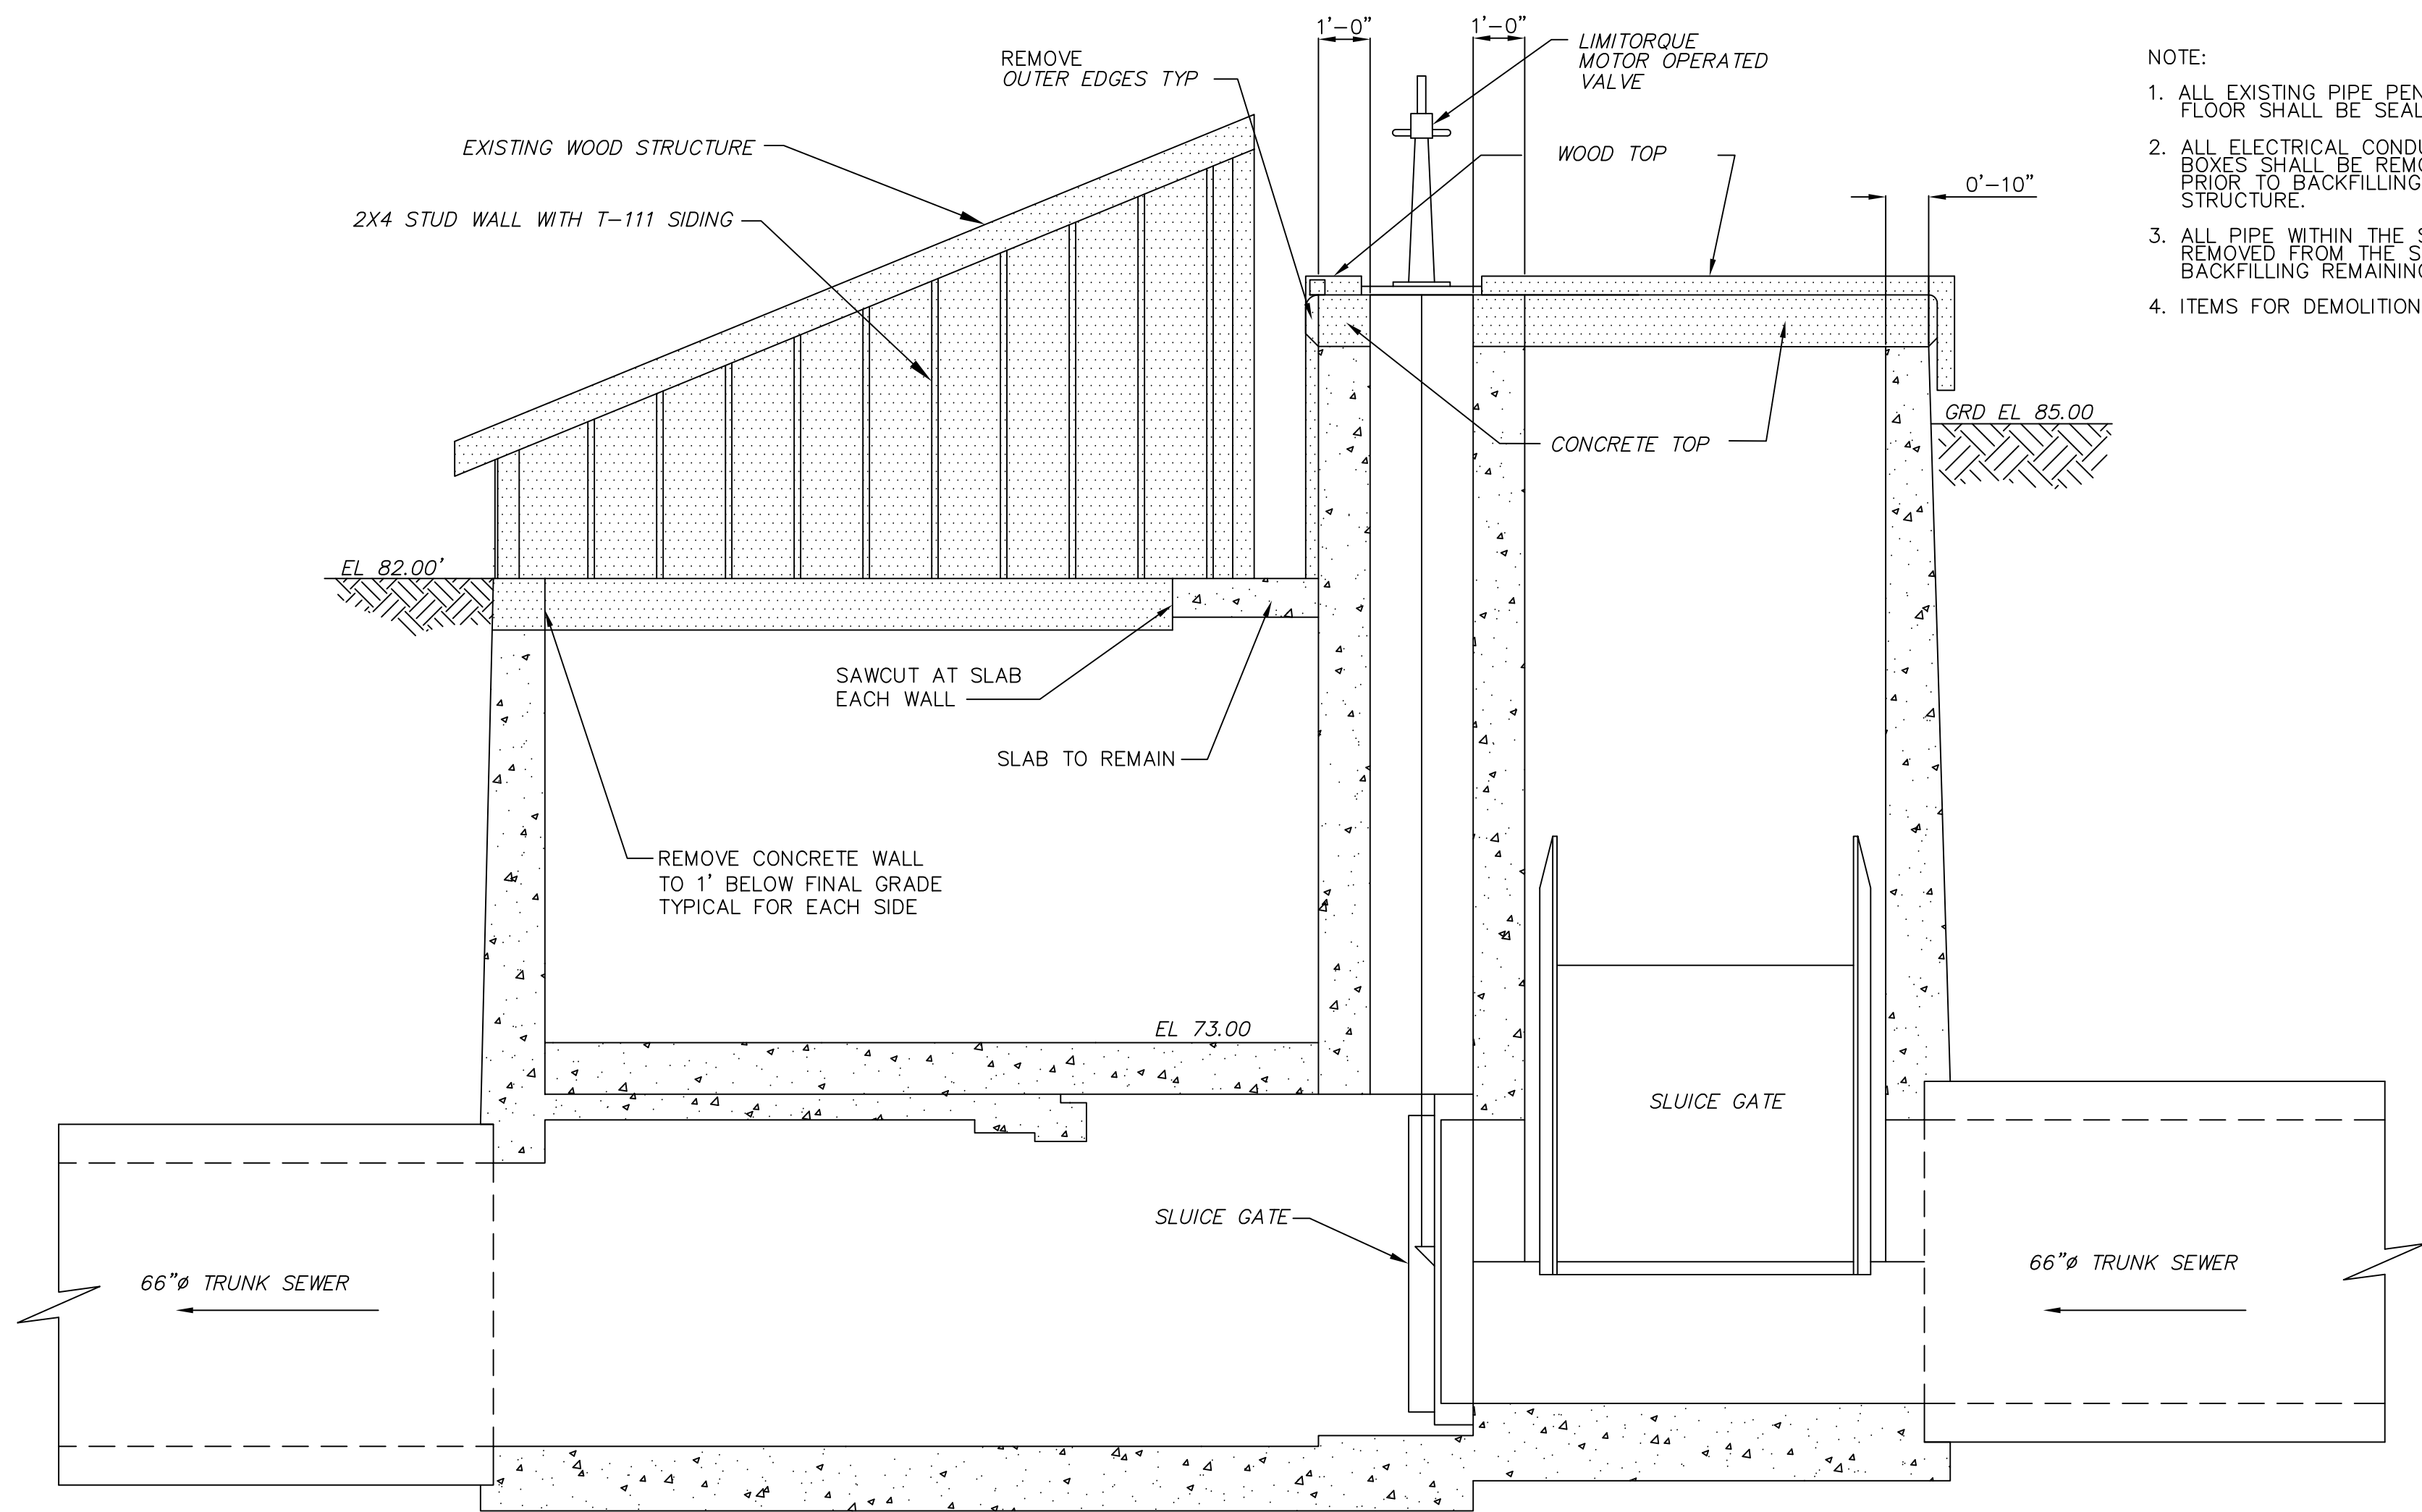


SECTION A
SCALE : 3/8" = 1'-0"

- NOTE:
1. ALL EXISTING PIPE PENETRATIONS THROUGH FLOOR SHALL BE SEALED WITH NON-SHRINK GROUT
 2. ALL ELECTRICAL CONDUIT AND BREAKER BOXES SHALL BE REMOVED FROM STRUCTURE PRIOR TO BACKFILLING REMAINING CONCRETE STRUCTURE.
 3. ALL PIPE WITHIN THE STRUCTURE SHALL BE REMOVED FROM THE STRUCTURE PRIOR TO BACKFILLING REMAINING CONCRETE STRUCTURE.
 4. ITEMS FOR DEMOLITION

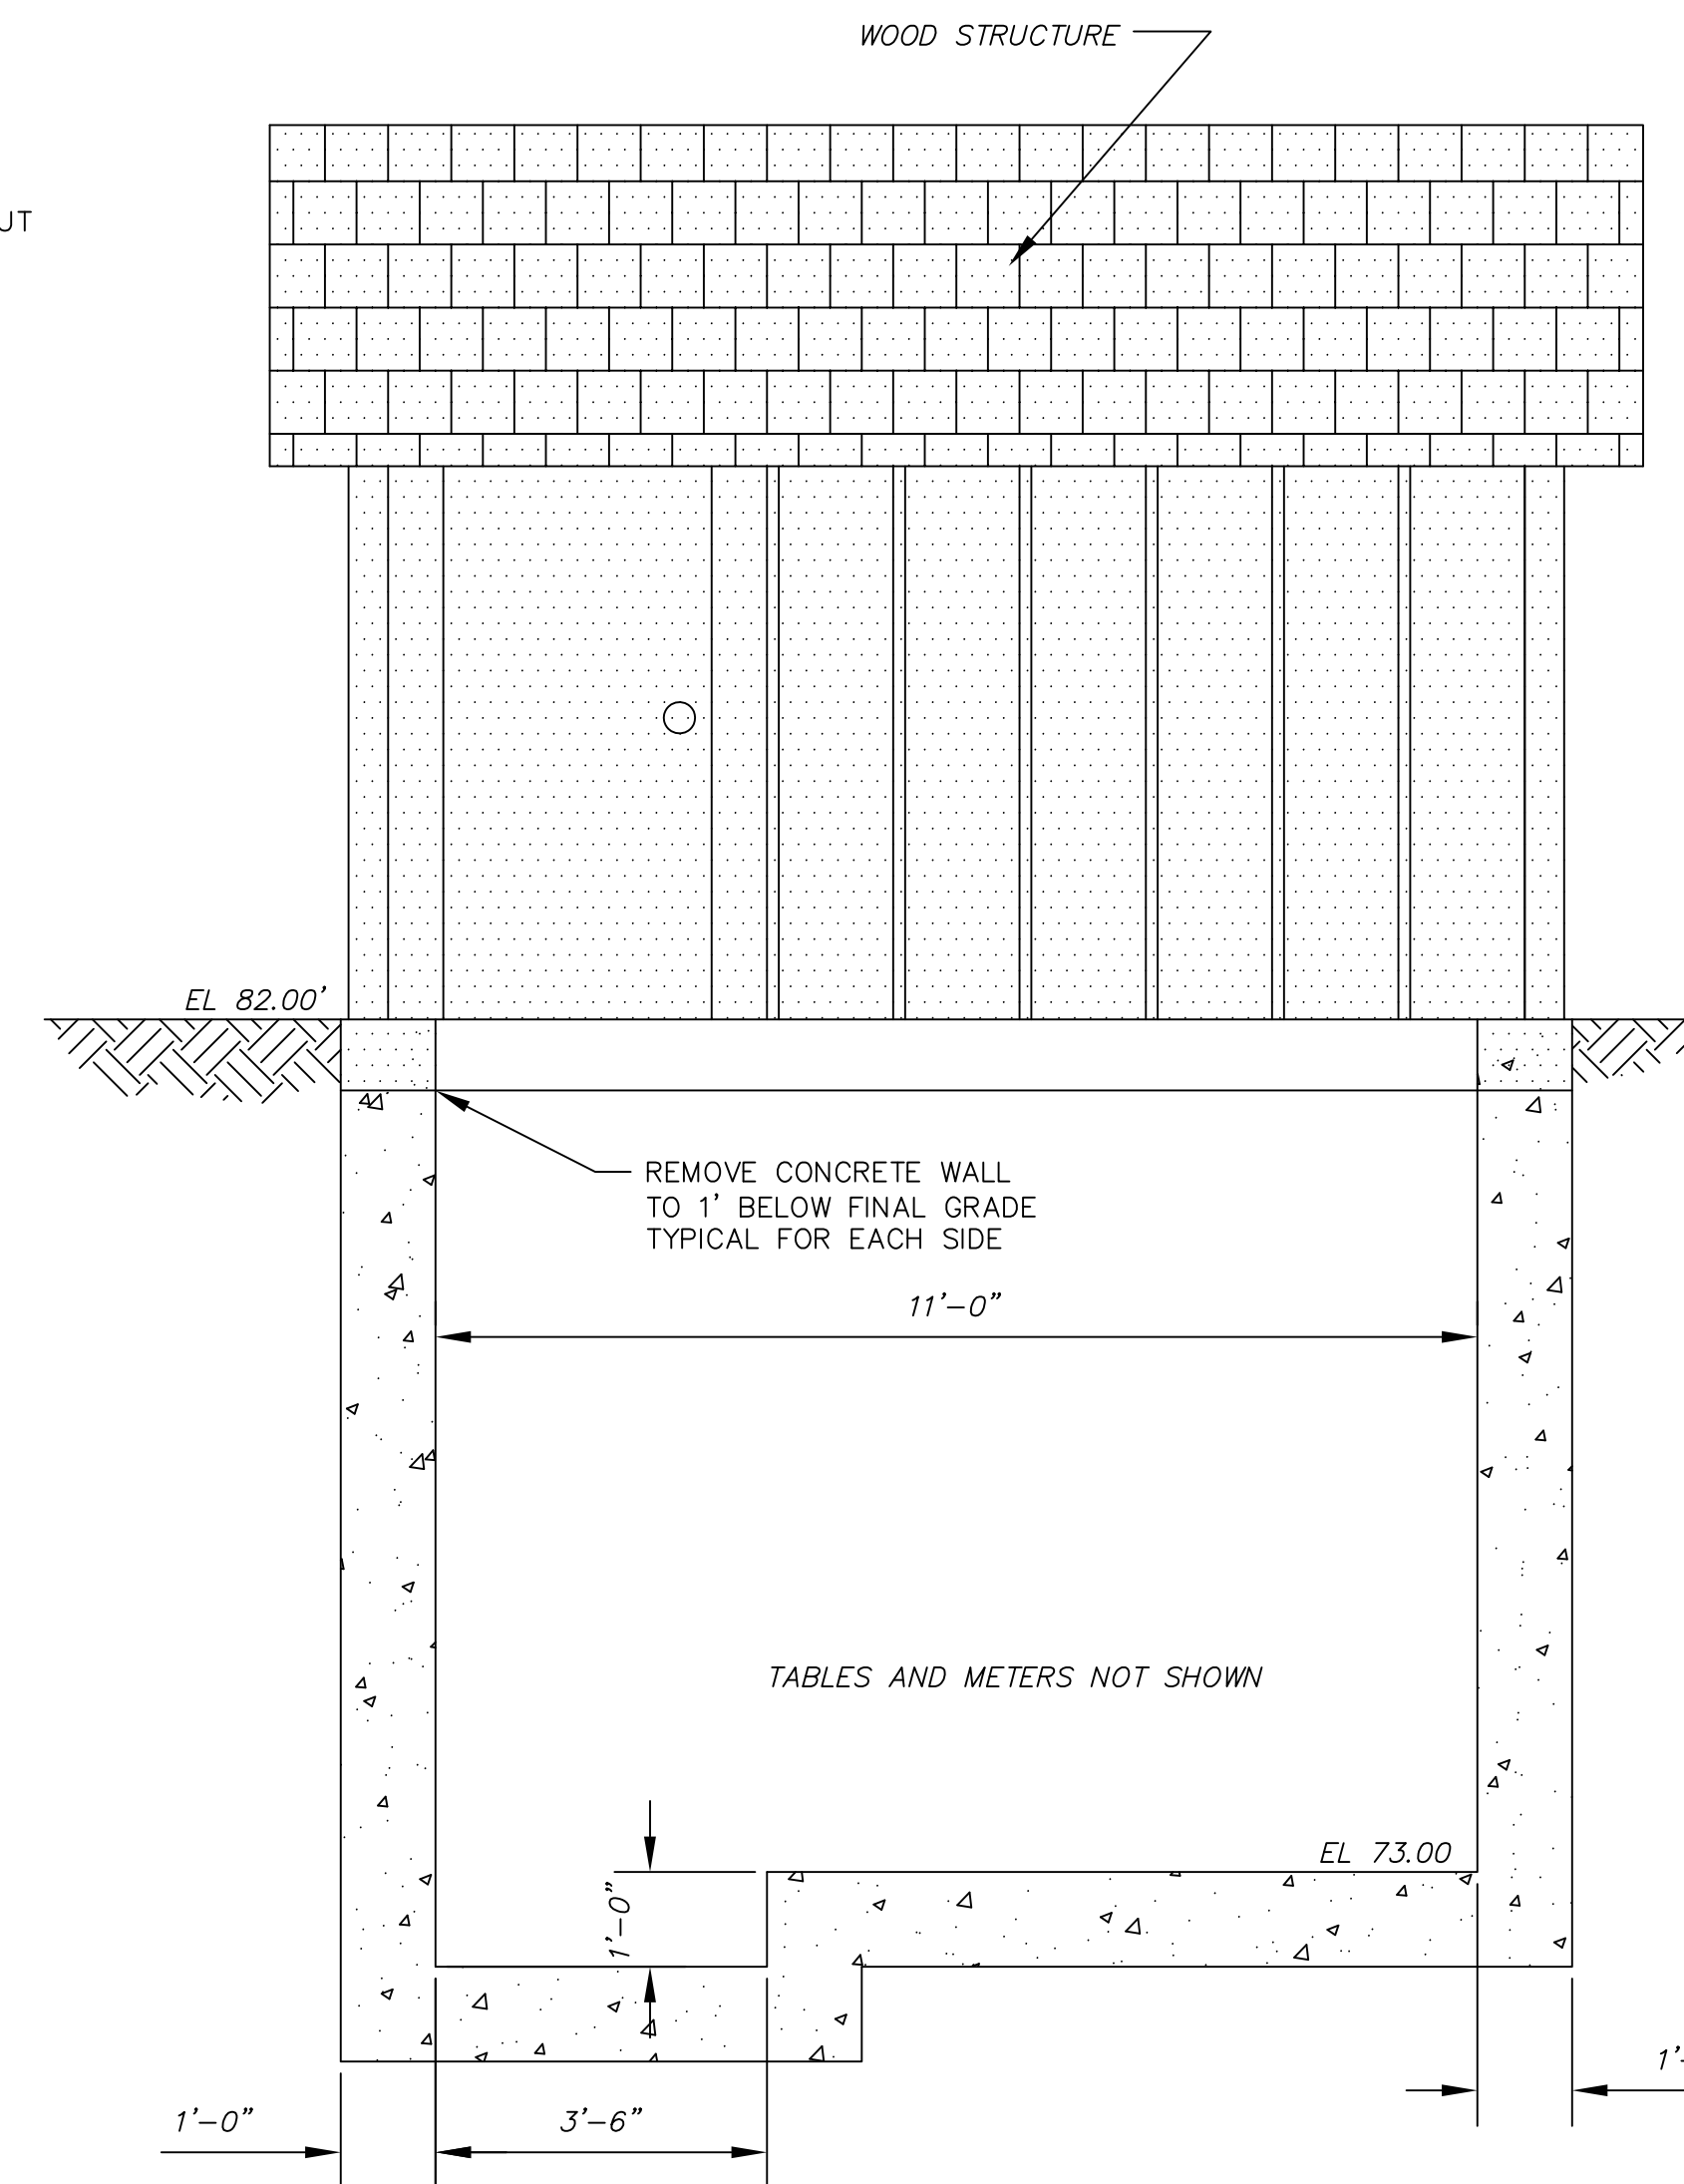

SECTION B
SCALE : 1/2" = 1'

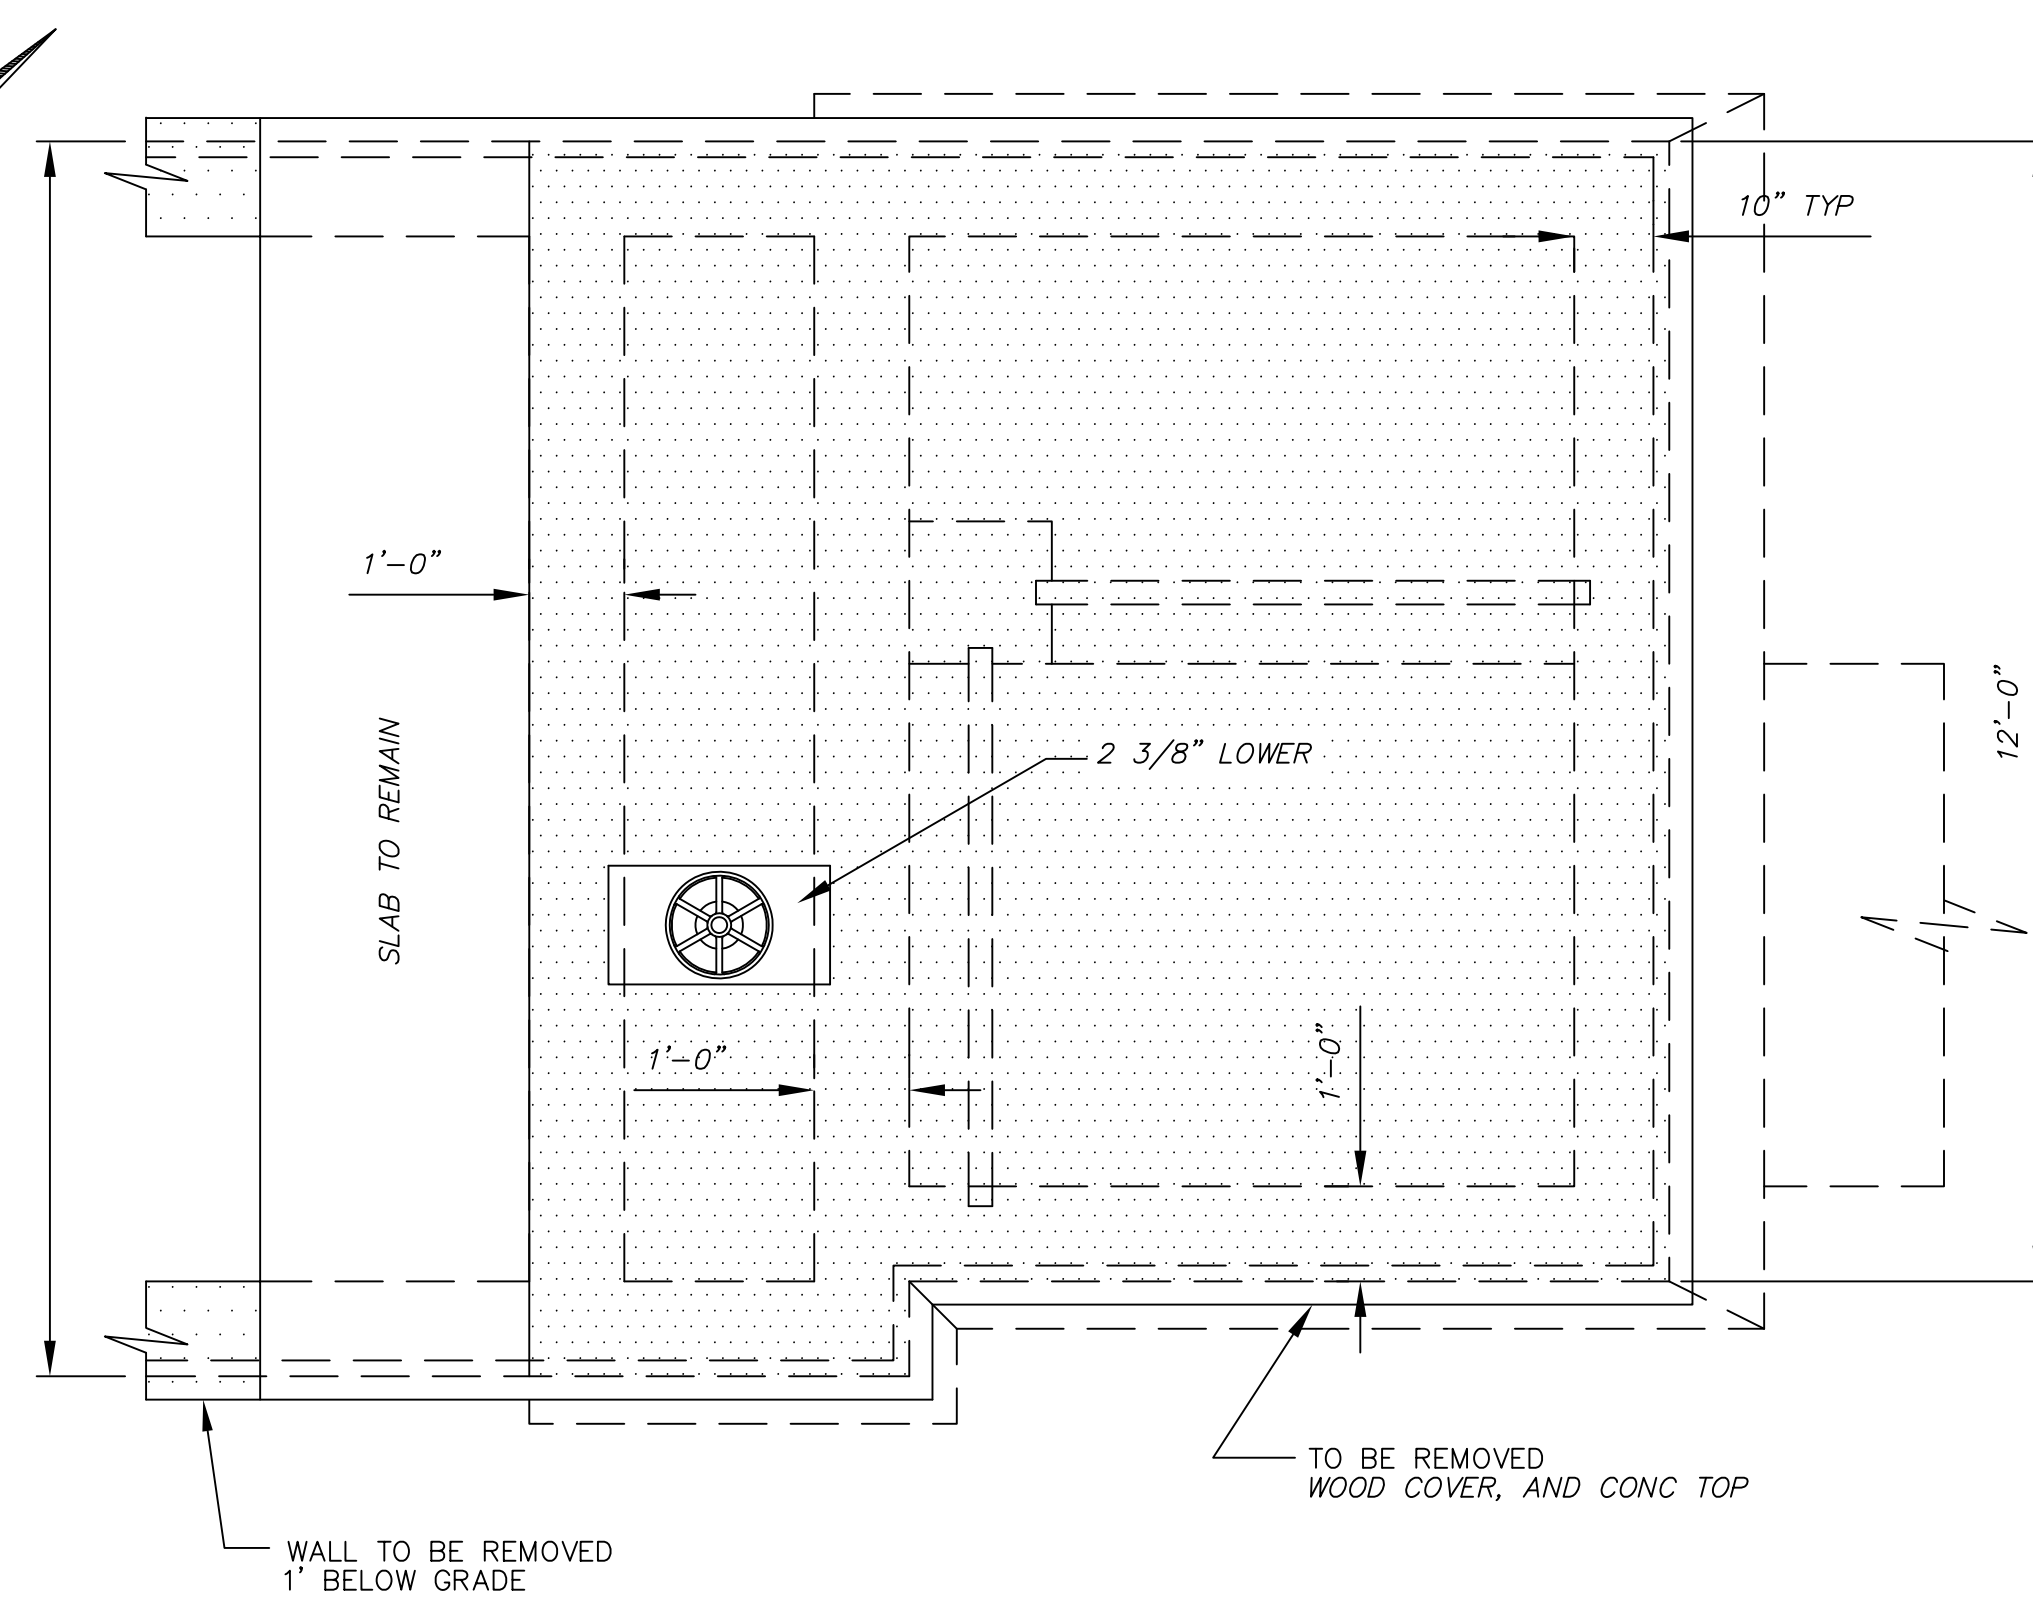

ROOF PLAN
SCALE 1/2" = 1'

THIS DRAWING IS AN INSTRUMENT OF SERVICE OWNED BY CTI ENVIRONMENTAL, INC. WHICH SHALL BE DEEMED THE AUTHOR AND WHICH SHALL RETAIN ALL STATUTORY AND COMMON LAW RIGHTS. THIS DRAWING SHALL NOT BE REPRODUCED, COPIED, OR ANY OTHER PURPOSE OR PROJECT WITHOUT THE WRITTEN CONSENT OF CTI ENVIRONMENTAL, INC. THAT ELECTRONIC COPIES OF THIS DRAWING ARE EXACT DUPLICATES OF THE SEALED ORIGINAL DRAWING. NO COPY AND THE SEALED ORIGINAL SHALL GOVERN.

DESIGNED BY	REVISIONS	DATE	BY	APP'D
RLP (RWR)	DESCRIPTIONS	4/05	MGW	WAD
DRAWN BY	RECORD DRAWING			
AMF				
CHECKED BY				
RWR				
APPROVED BY				
WAD				

ENVIRONMENTAL, INC.
ENGINEERS IN WATER AND EARTH SCIENCES
UNIONTOWN, OHIO



CITY OF MASSILLON, OHIO
WWTP UPGRADE 2000
INFLUENT STRUCTURE PLAN AND SECTION DEMOLITION

JOB NO.
E9031
DATE
08/13/01
SCALE
AS NOTED
SHEET
P13

THESE RECORD DOCUMENTS HAVE BEEN PREPARED BASED ON INFORMATION PROVIDED BY OTHERS. CTI ENVIRONMENTAL HAS REVIEWED THE INFORMATION SUBMITTED AND BELIEVES IT REFLECTS THE WORK AS CONSTRUCTED. HOWEVER, ALL PERSONS SHALL VERIFY INFORMATION TAKEN FROM THIS DRAWING.