




THESE RECORD DOCUMENTS HAVE BEEN PREPARED BASED ON INFORMATION PROVIDED BY OTHERS. CTH ENVIRONMENTAL HAS REVIEWED THE INFORMATION SUBMITTED AND BELIEVES IT REFLECTS THE WORK AS CONSTRUCTED. HOWEVER, ALL PERSONS SHALL VERIFY INFORMATION TAKEN FROM THIS DRAWING.

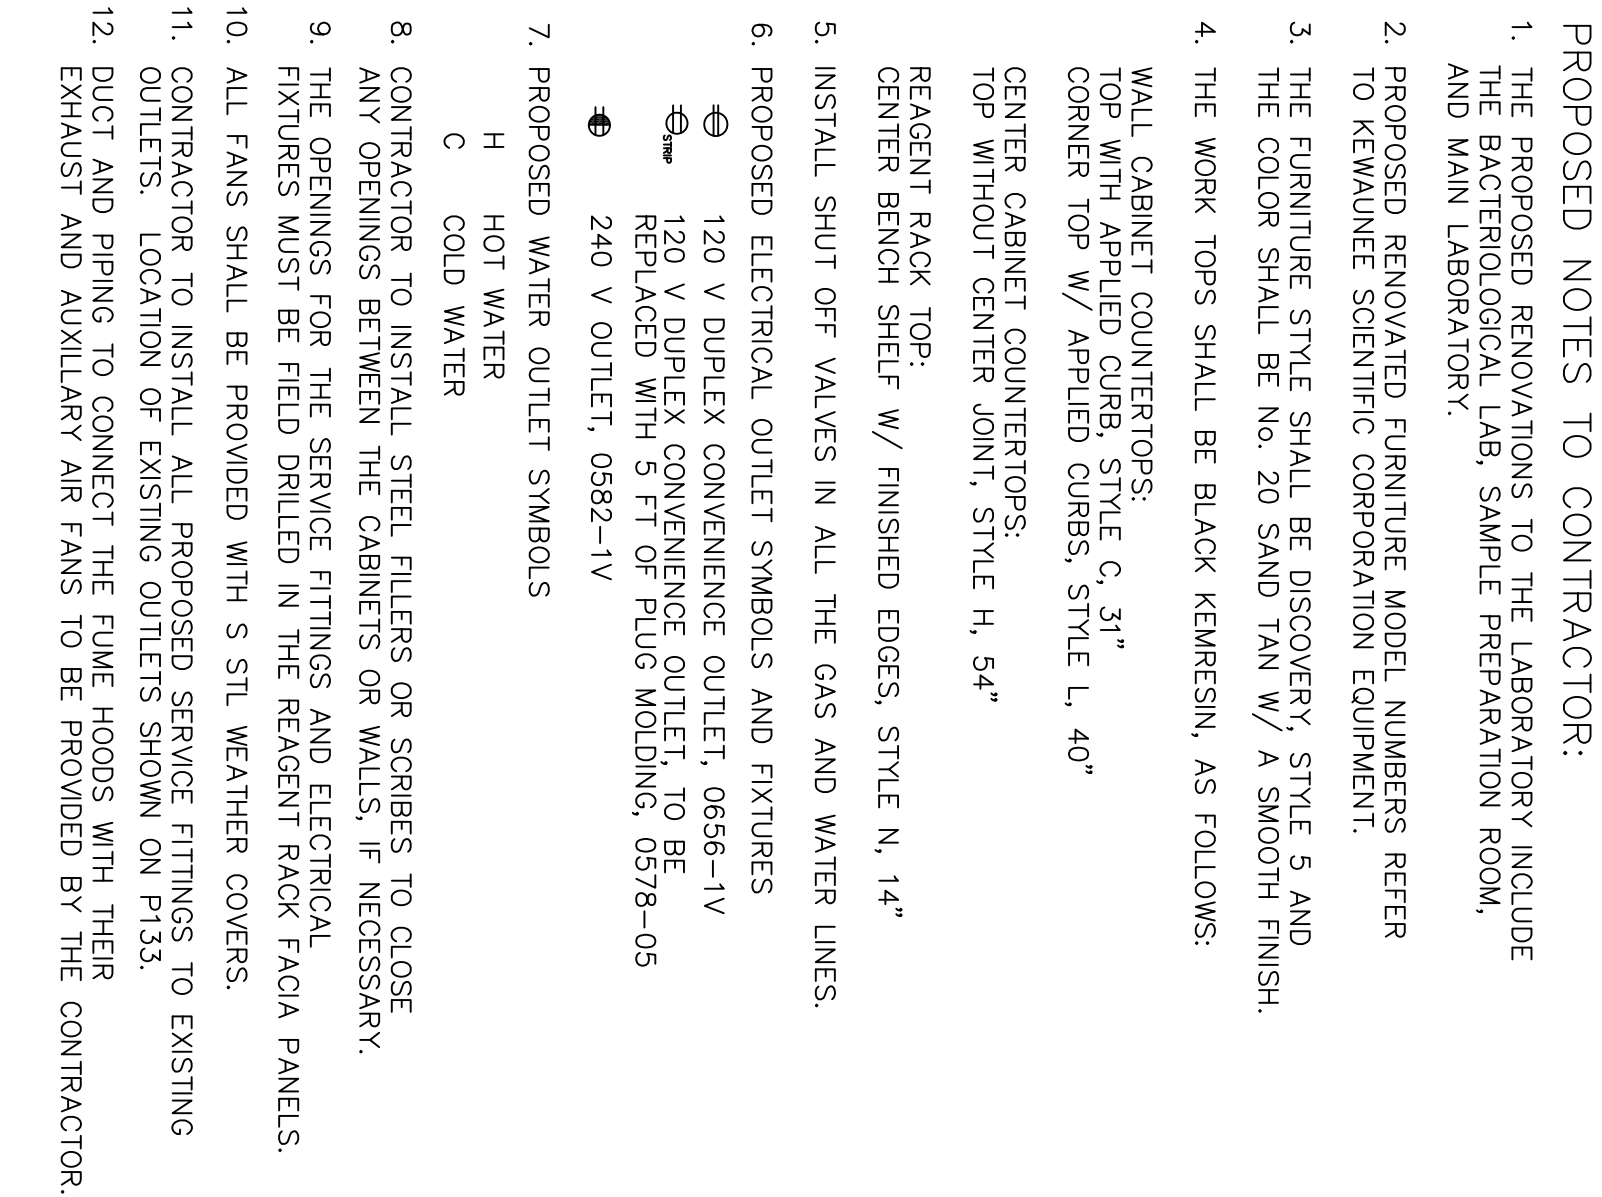

THIS DRAWING IS AN INSTRUMENT OF SERVICE OWNED BY CITI ENVIRONMENTAL, INC. WHICH SHALL BE DEEMED THE AUTHOR AND WHICH SHALL RETAIN ALL STATUTORY AND COMMON LAW RIGHTS INCLUDING COPYRIGHTS. NO PART OF THIS DRAWING SHALL BE SCANNED, COPIED, OR DISTRIBUTED TO OTHERS IN ANY FORM OR USED FOR ANY OTHER PURPOSE OR PROJECT WITHOUT PRIOR WRITTEN CONSENT OF CITI ENVIRONMENTAL, INC. CITI ENVIRONMENTAL, INC. CANNOT GUARANTEE THAT ANY ELECTRONIC REPRODUCTION OF THIS DRAWING IS A TRUE DUPLICATE OF THE SEALED ORIGINAL DRAWING. IN THE EVENT OF A CONFLICT BETWEEN AN ELECTRONIC COPY AND THE SEALED ORIGINAL THE SEALED ORIGINAL SHALL GOVERN.

CITY OF MASSILLON, OHIO
WWTP UPGRADE 2000
LABORATORY RENOVATIONS

JOB NO.	E9031
DATE	08/13/01
SCALE	1/4"=1'-0"
SHEET	P134