



SEAL WATER FLUSH SYSTEM FOR SLUDGE PUMPS
NTS

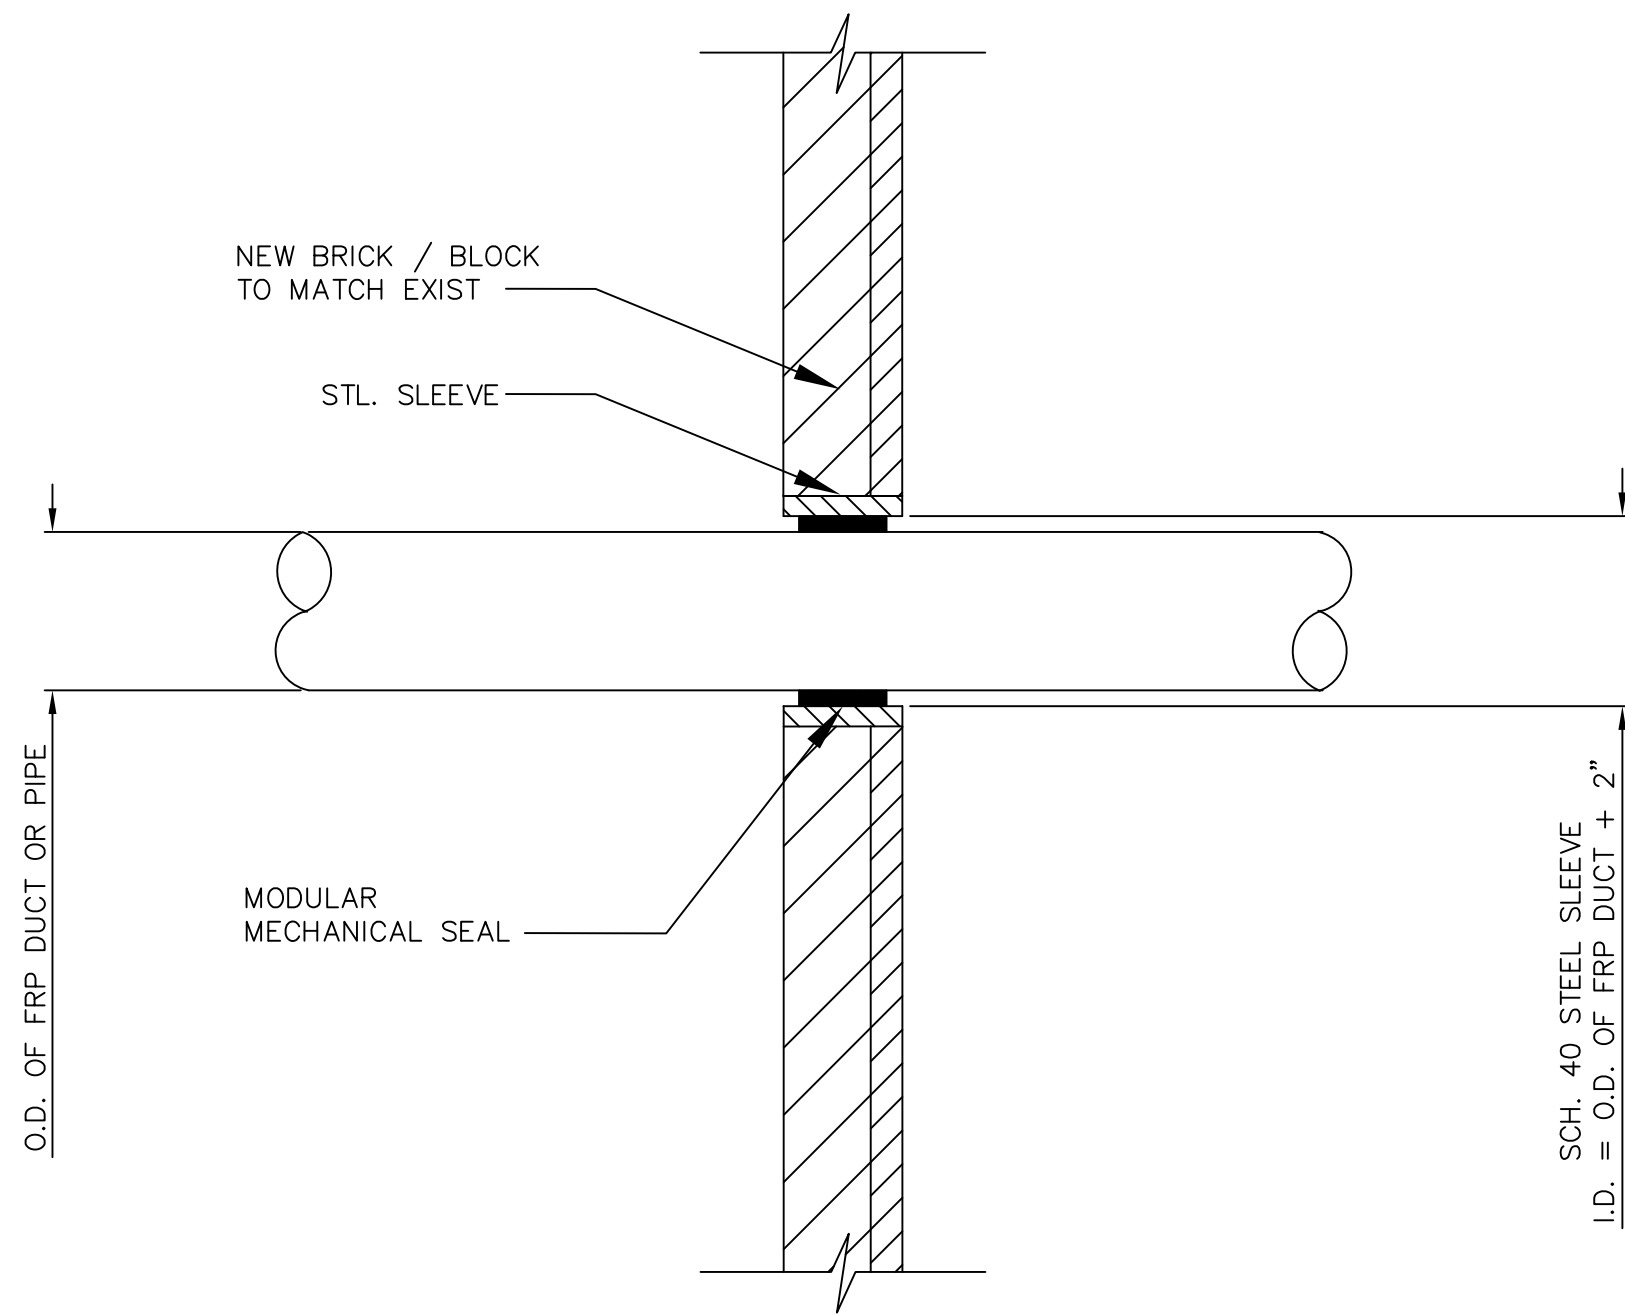


WINDOW PENETRATION DETAIL
SCALE: NTS

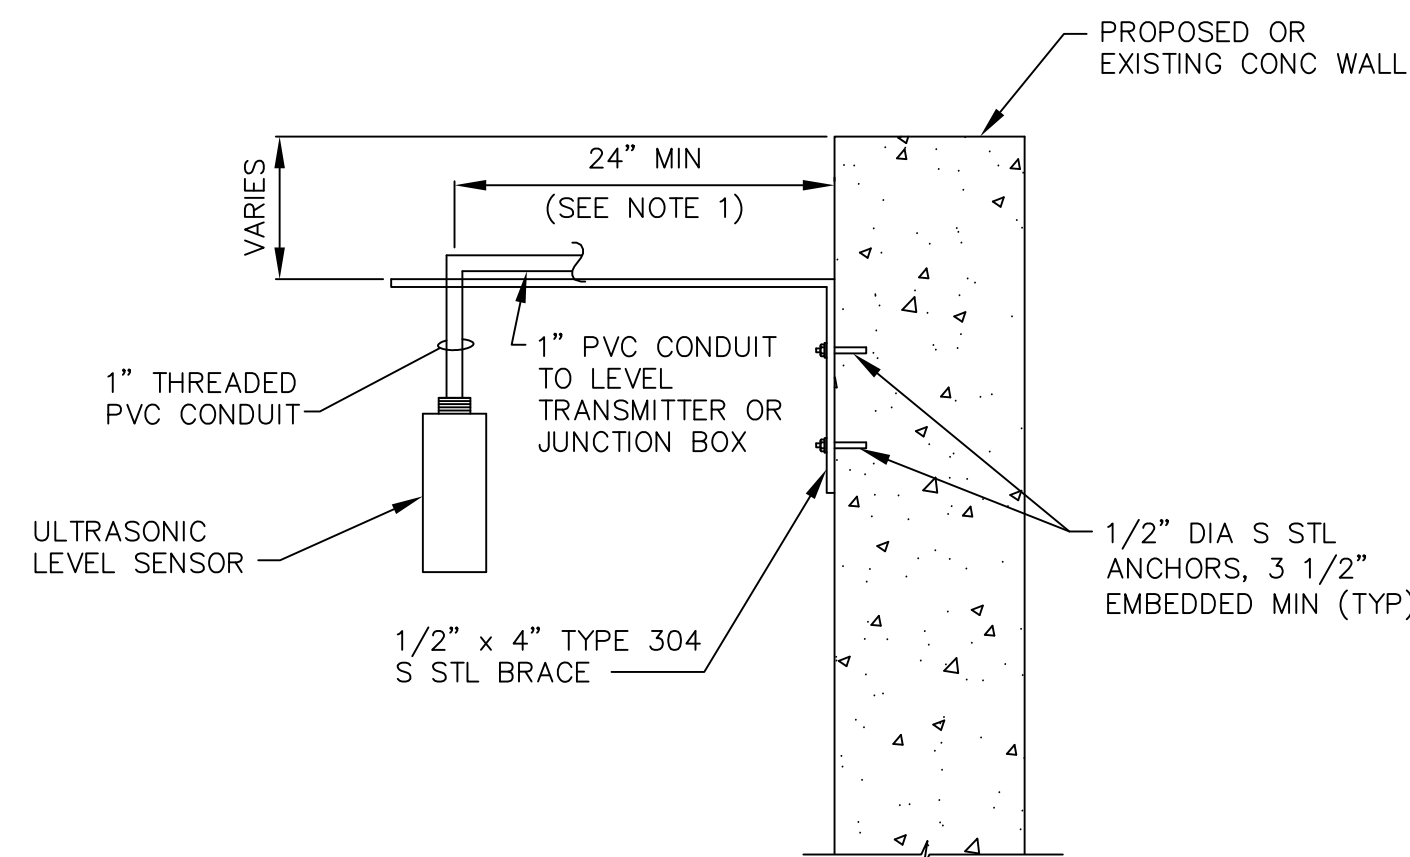


- NOTES:
1. ULTRASONIC LEVEL SENSOR SHALL BE LOCATED 24" MIN FROM ADJACENT WALLS AND EQUIPMENT OR AS OTHERWISE REQUIRED BY MANUFACTURER.
 2. PROVIDE SUFFICIENT LENGTH OF CABLE AND WIRE FOR SENSOR TO BE REMOVED WITHOUT DISCONNECTING CABLES.

WALL MOUNTED ULTRASONIC OR RADAR
LEVEL SENSORS
SCALE: NTS

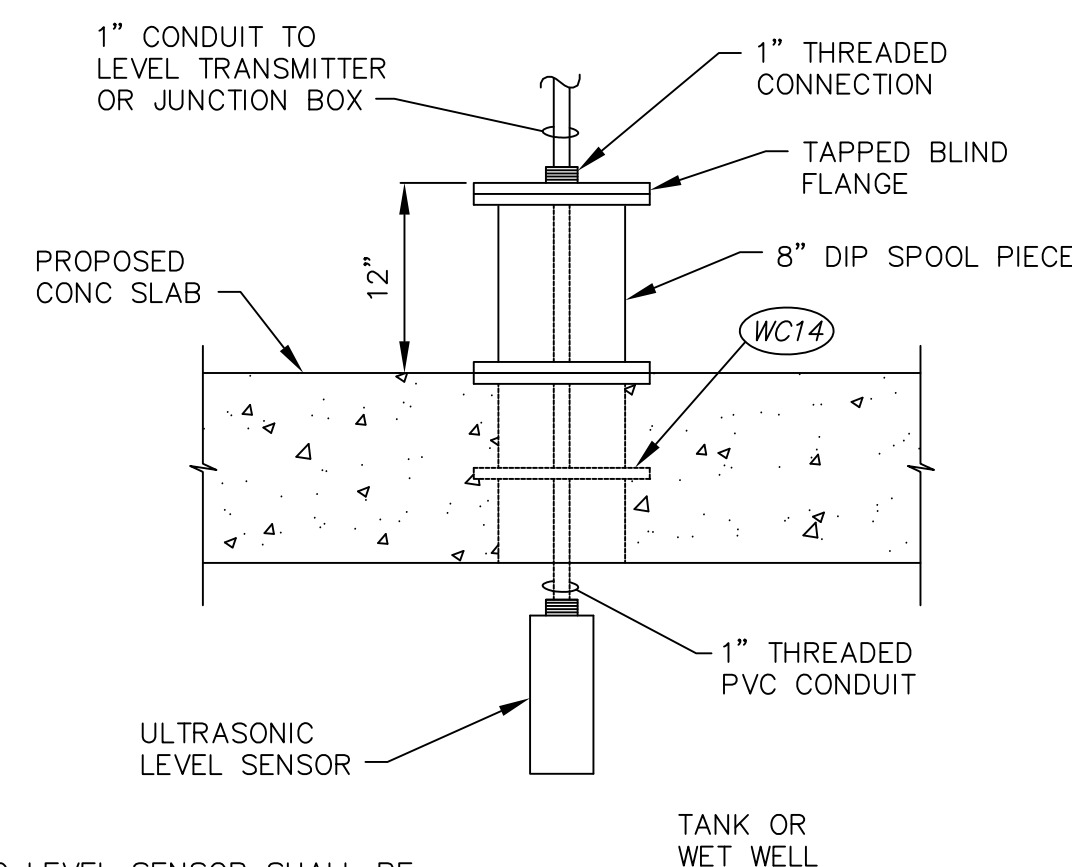


- NOTES:
1. ULTRASONIC LEVEL SENSOR SHALL BE LOCATED 24" MIN FROM ADJACENT WALLS AND EQUIPMENT OR AS OTHERWISE REQUIRED BY MANUFACTURER.
 2. PROVIDE SUFFICIENT LENGTH OF CABLE AND WIRE FOR SENSOR TO BE REMOVED WITHOUT DISCONNECTING CABLES.

SLAB MOUNTED ULTRASONIC
LEVEL SENSORS
SCALE: NTS

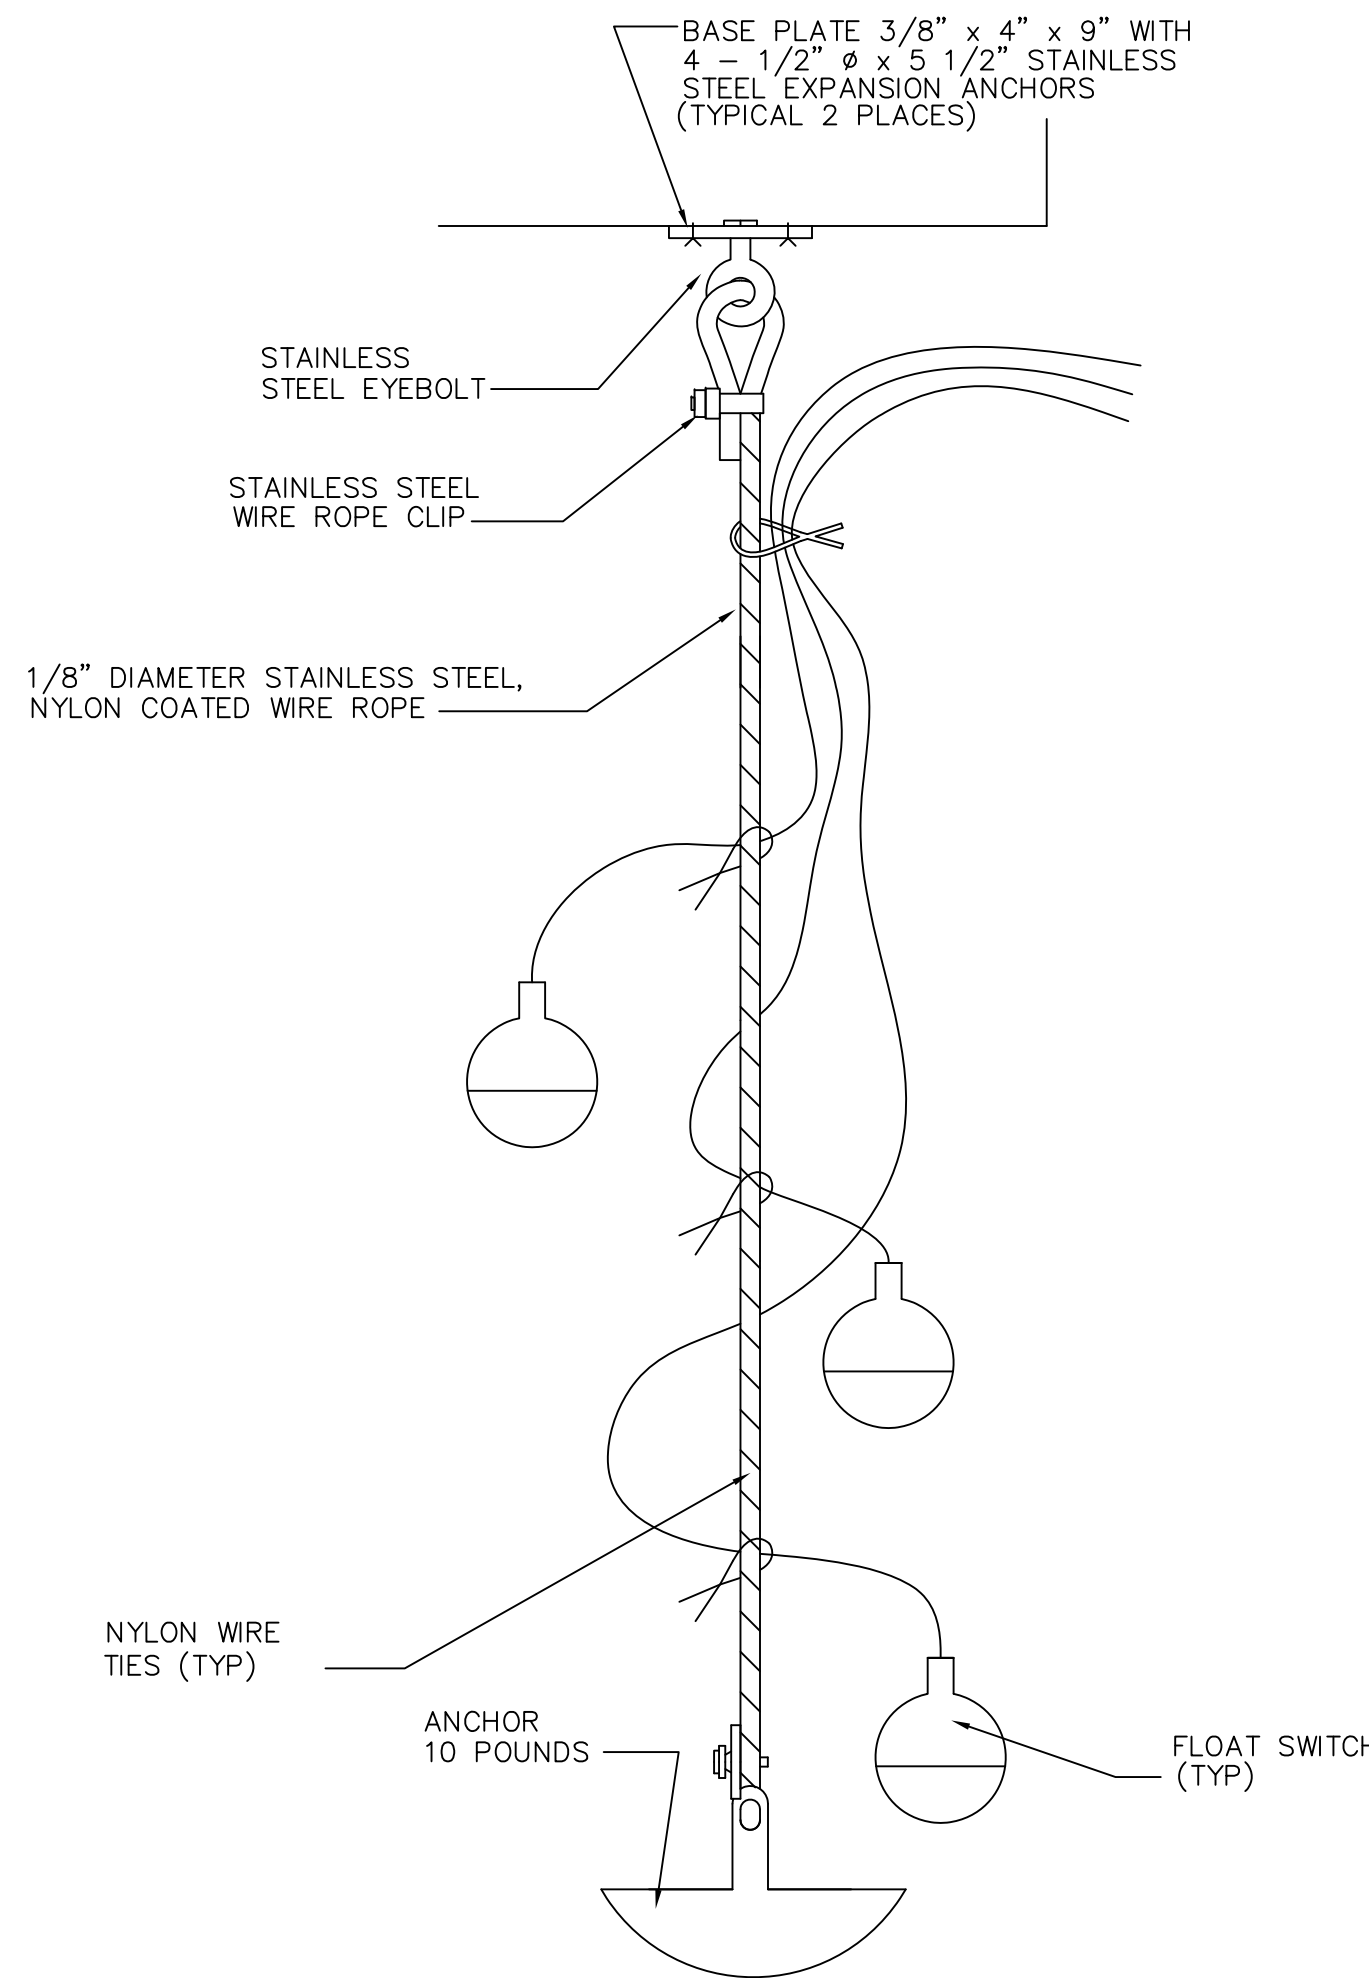

FLOAT SWITCH DETAIL
NTS

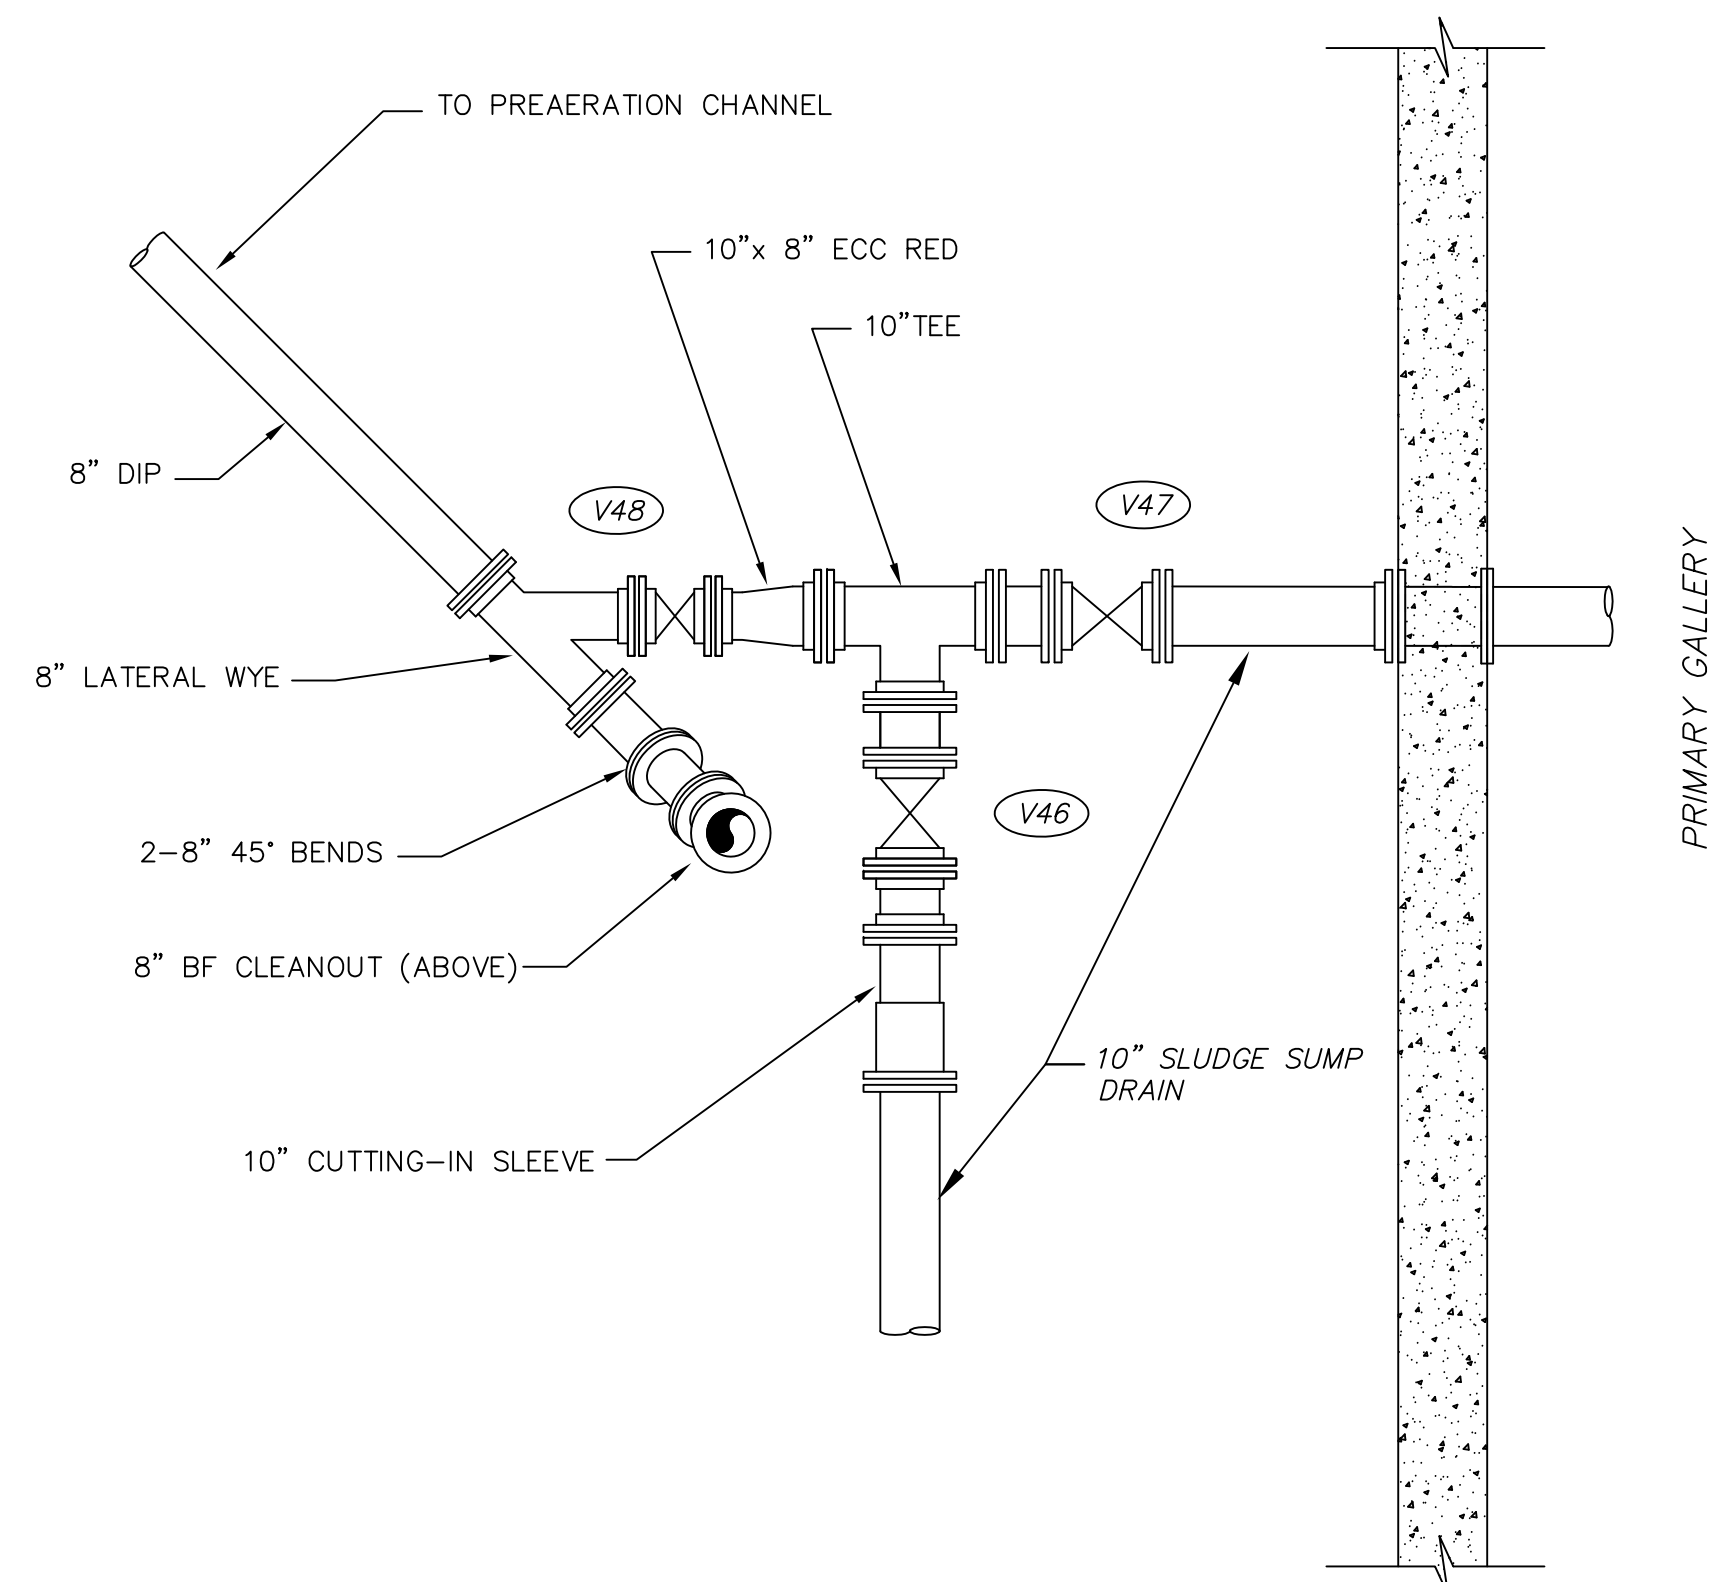

DETAIL
SCALE : 3/8"=1'-0" (4) P36

THESE RECORD DOCUMENTS HAVE BEEN PREPARED
BASED ON INFORMATION PROVIDED BY OTHERS. CTI
ENVIRONMENTAL HAS REVIEWED THE INFORMATION
SUBMITTED AND BELIEVES IT REFLECTS THE WORK AS
CONSTRUCTED. HOWEVER, ALL PERSONS SHALL
VERIFY INFORMATION TAKEN FROM THIS DRAWING.

THIS DRAWING IS AN INSTRUMENT OF SERVICE OWNED
BY CTI ENVIRONMENTAL, INC. WHICH SHALL BE DEEMED
THE AUTHOR AND WHICH SHALL RETAIN ALL STATUTORY
RIGHTS. THIS DRAWING SHALL NOT BE REPRODUCED, COPIED, OR
IN ANY MANNER FOR ANY OTHER PURPOSE OR PROJECT WITHOUT THE
WRITTEN CONSENT OF CTI ENVIRONMENTAL, INC. THAT
ELECTRONIC COPIES OF THIS DRAWING ARE EXACT
DUPLICATES OF THE SEALED ORIGINAL DRAWING.
ANY REVISIONS TO THIS DRAWING SHALL BE MADE TO THE
COPY AND THE SEALED ORIGINAL THE SEALED ORIGINAL
SHALL GOVERN.

DESIGNED BY	MGW	DATE	BY	APP'D
DRAWN BY	SAT	1/27	MGW	WAD
CHECKED BY	MGW			
APPROVED BY	WAD			

ENVIRONMENTAL, INC.
ENGINEERS IN WATER AND EARTH SCIENCES
UNIONTOWN, OHIO

CITY OF MASSILLON, OHIO
WWTP UPGRADE 2000
DETAILS

JOB NO.	E9031
DATE	4/08/04
SCALE	AS NOTED
SHEET	P135