




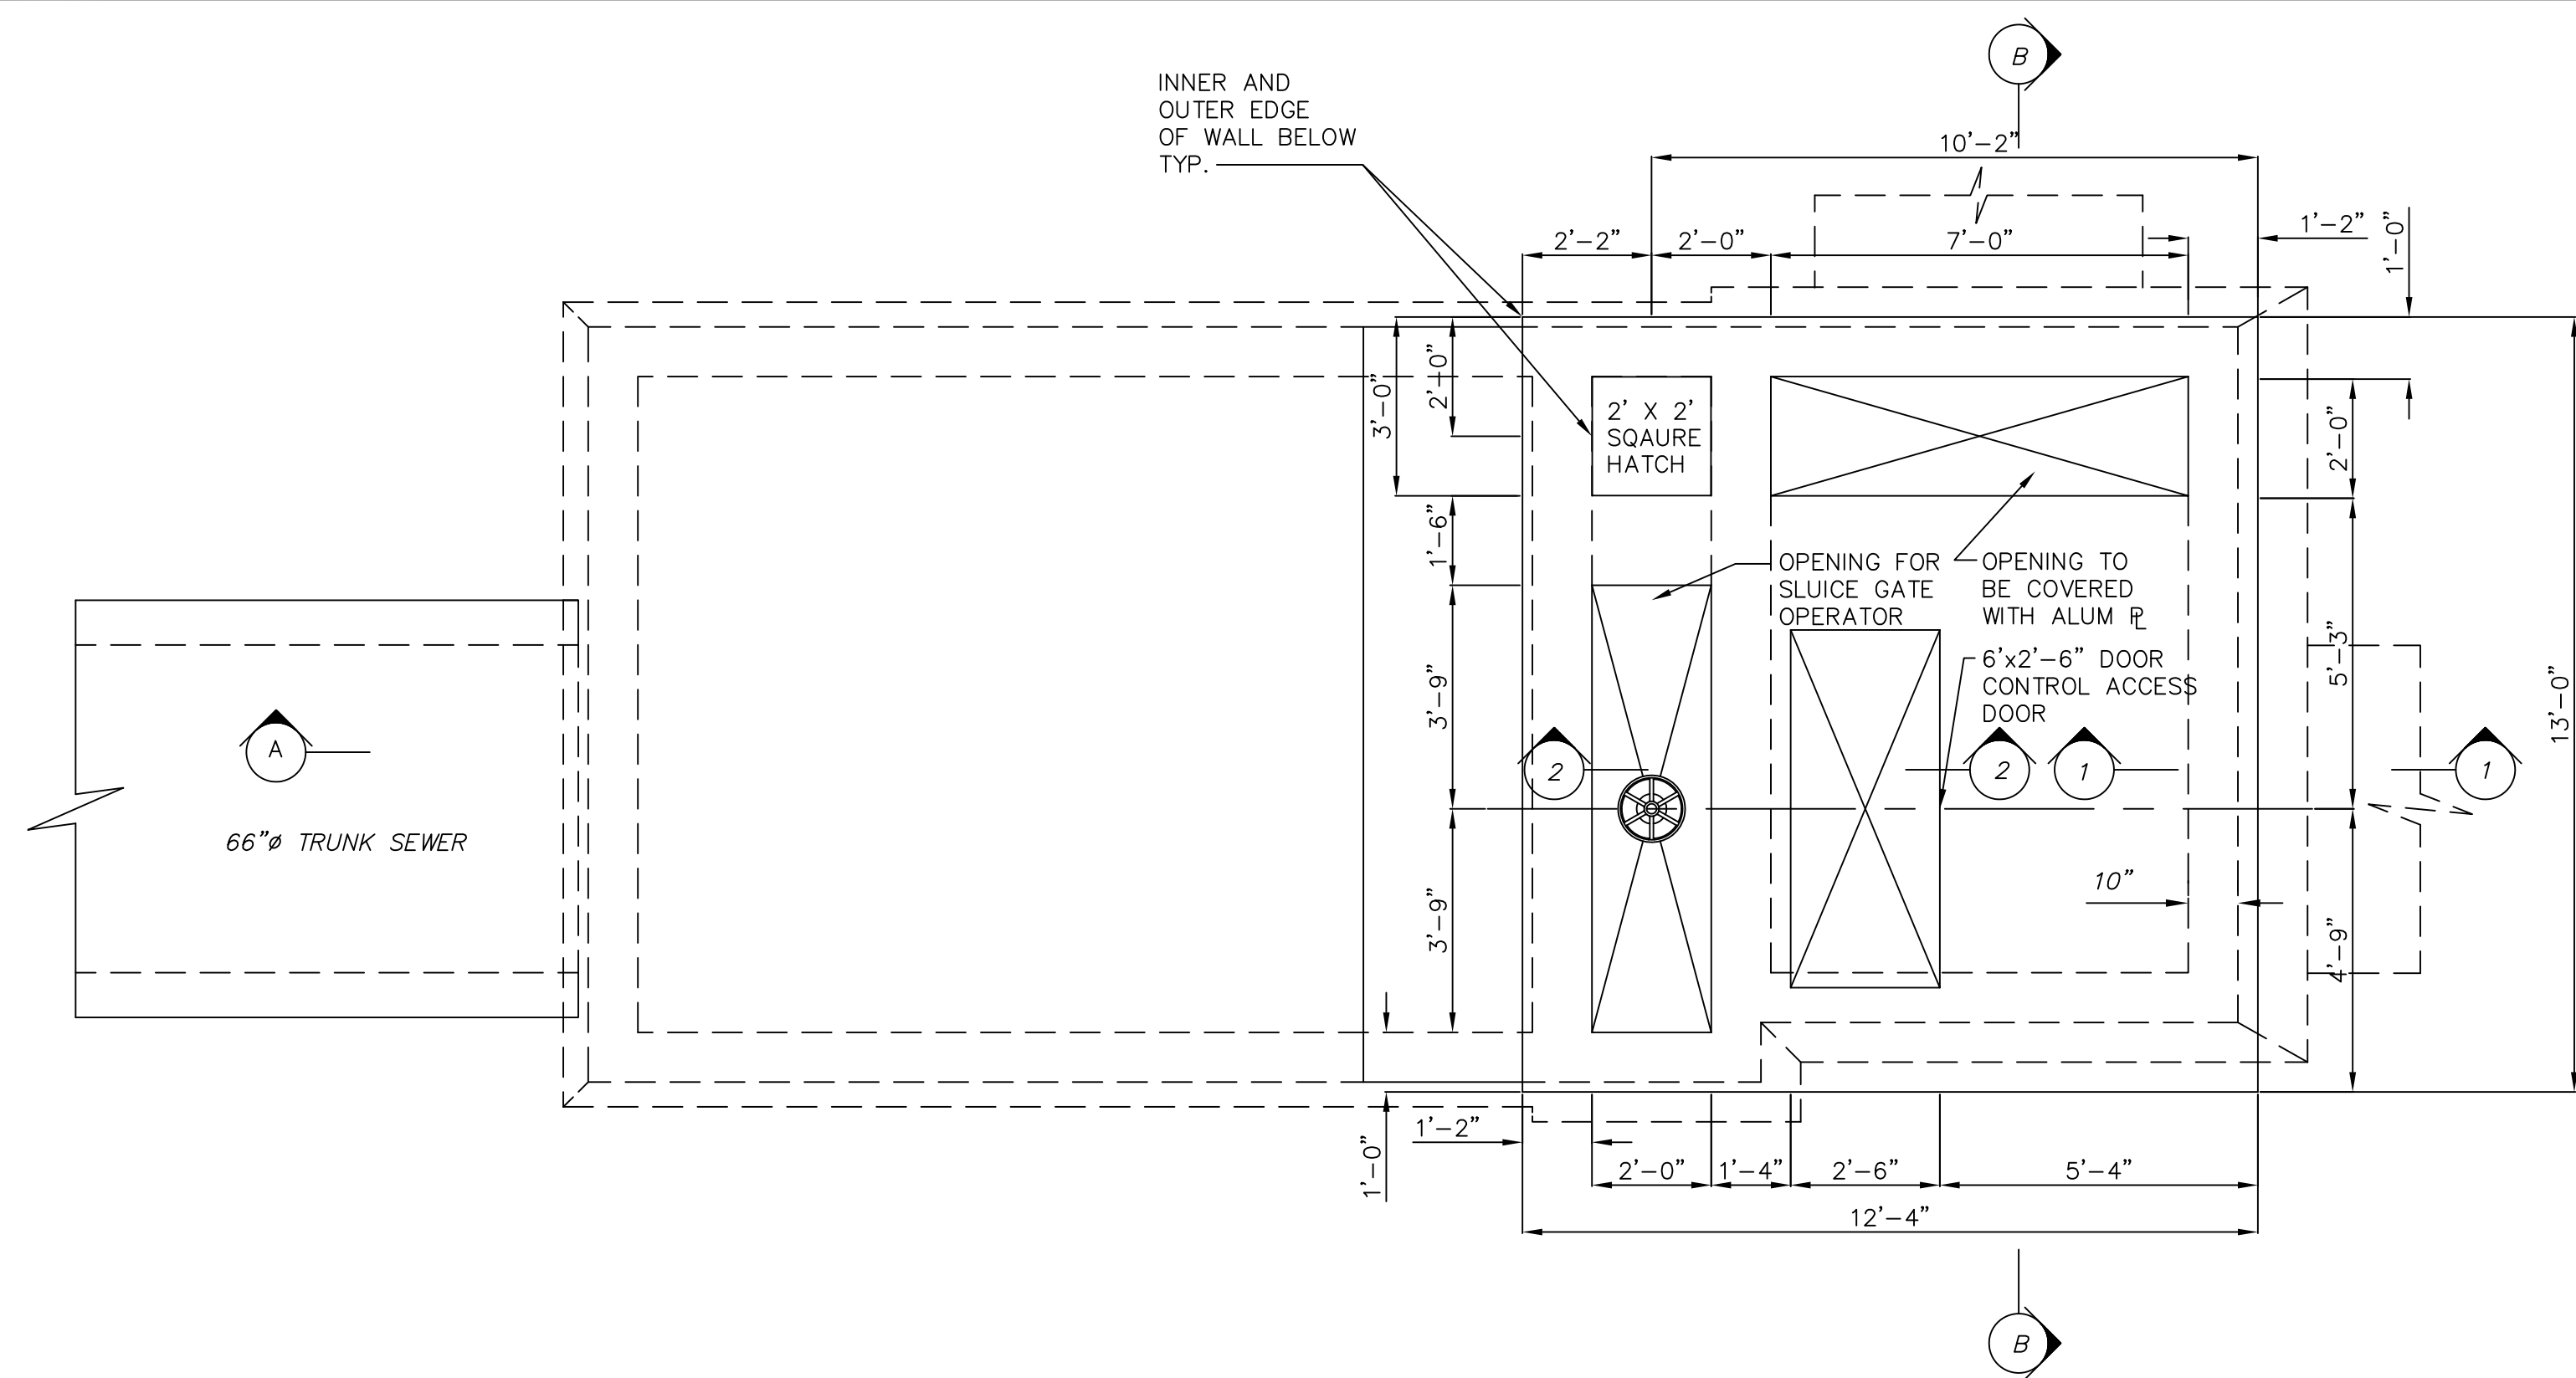

PLAN
SCALE : 3/8" = 1'-0"

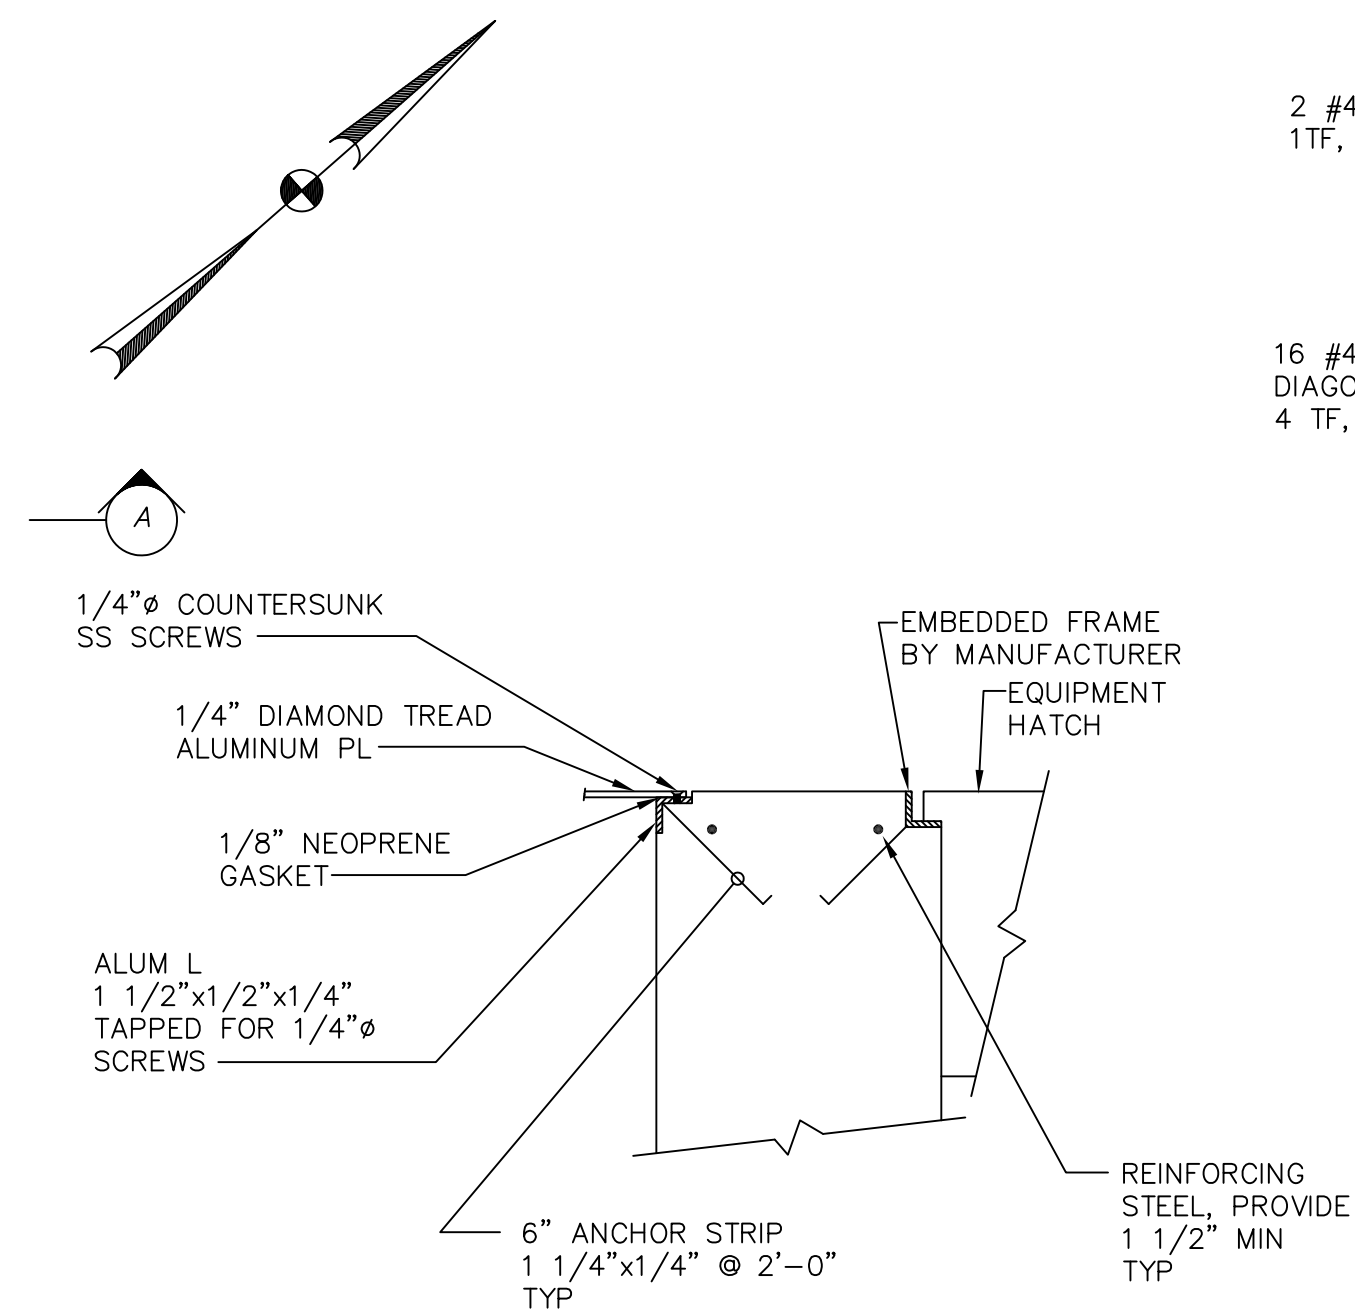


SECTION
SCALE : 1 1/2" = 1'-0" 2

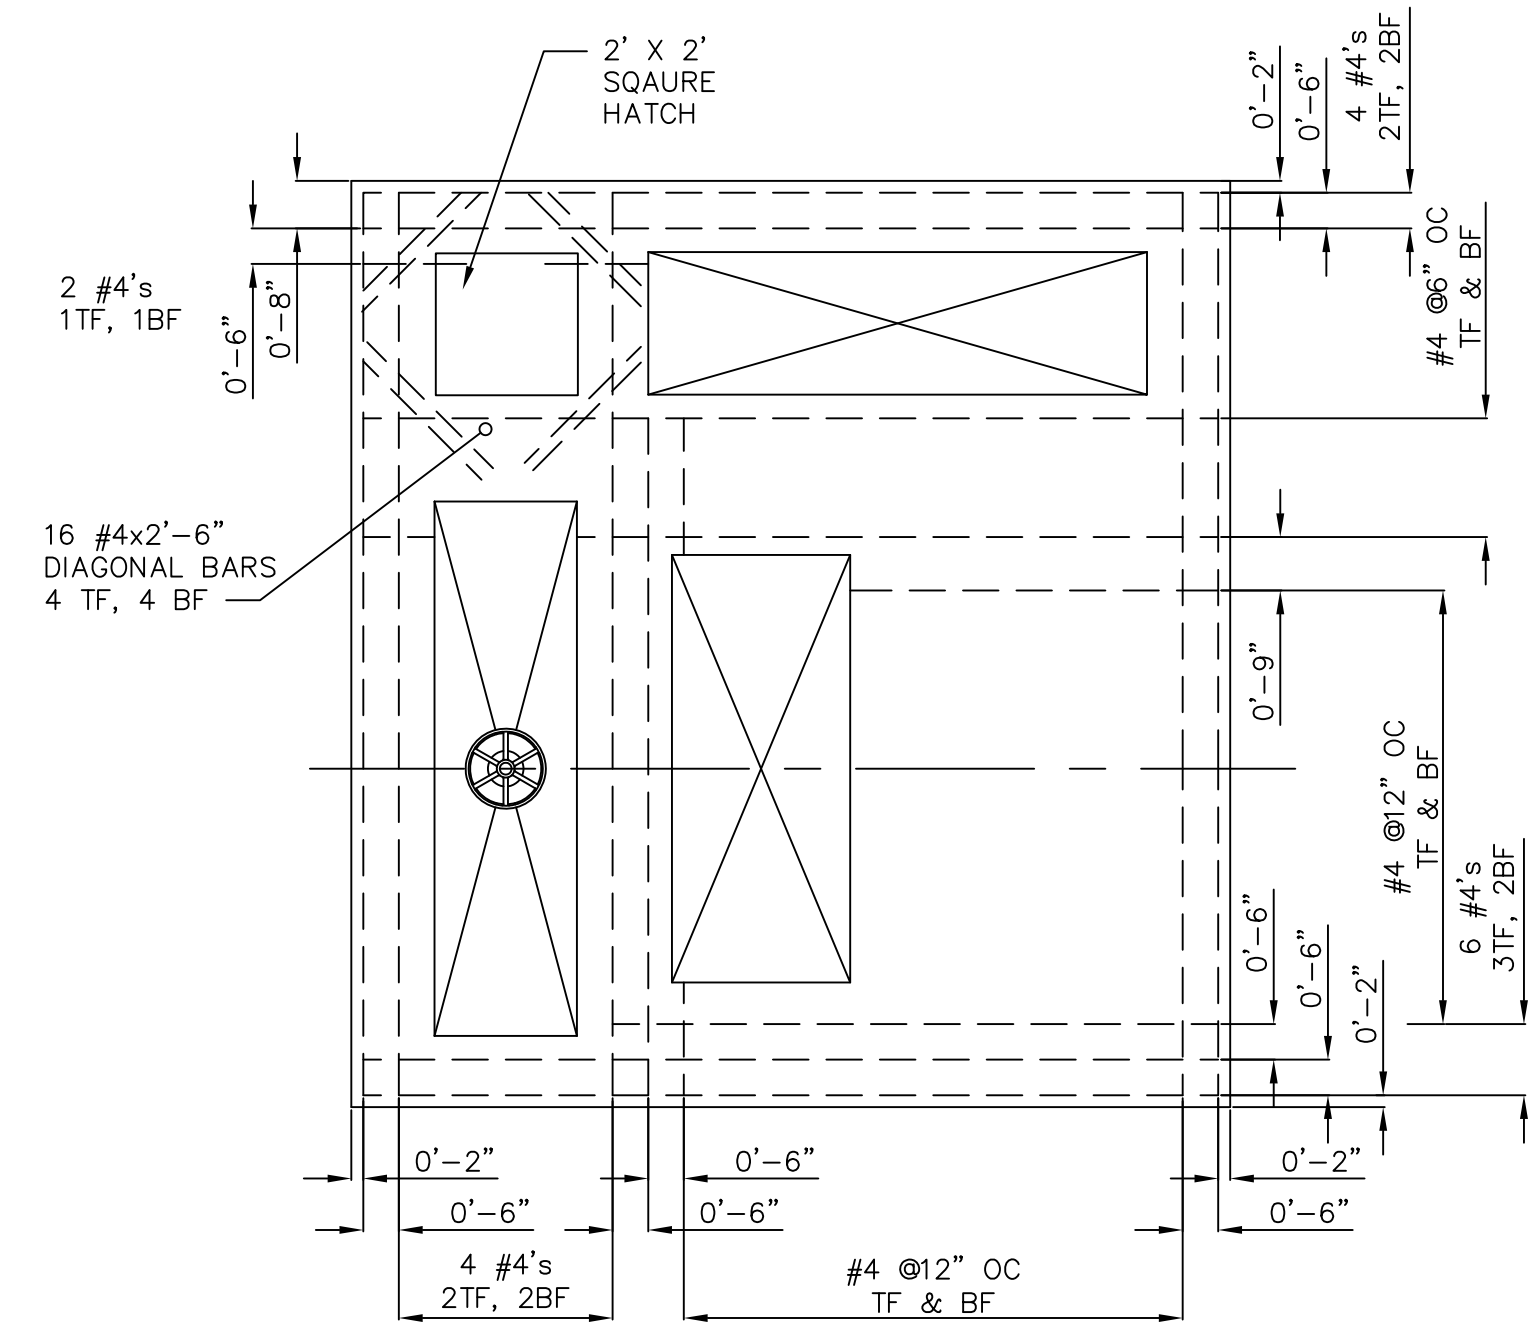


PLAN-REINFORCEMENT
SCALE : 3/8" = 1'-0"


NOTE:
1. WOOD STRUCTURE MAY NOT BE USED AS FILL IN THE REMAINING CONCRETE STRUCTURE. HOWEVER, ONCE AT LEAST 2 FEET OF EARTH HAS BEEN PLACED WITHIN THE REMAINING CONCRETE STRUCTURE, CONCRETE FROM WALLS MAY BE USED AS FILL. 6 INCHES BELOW FINAL GRADE MUST BE TOPSOIL.

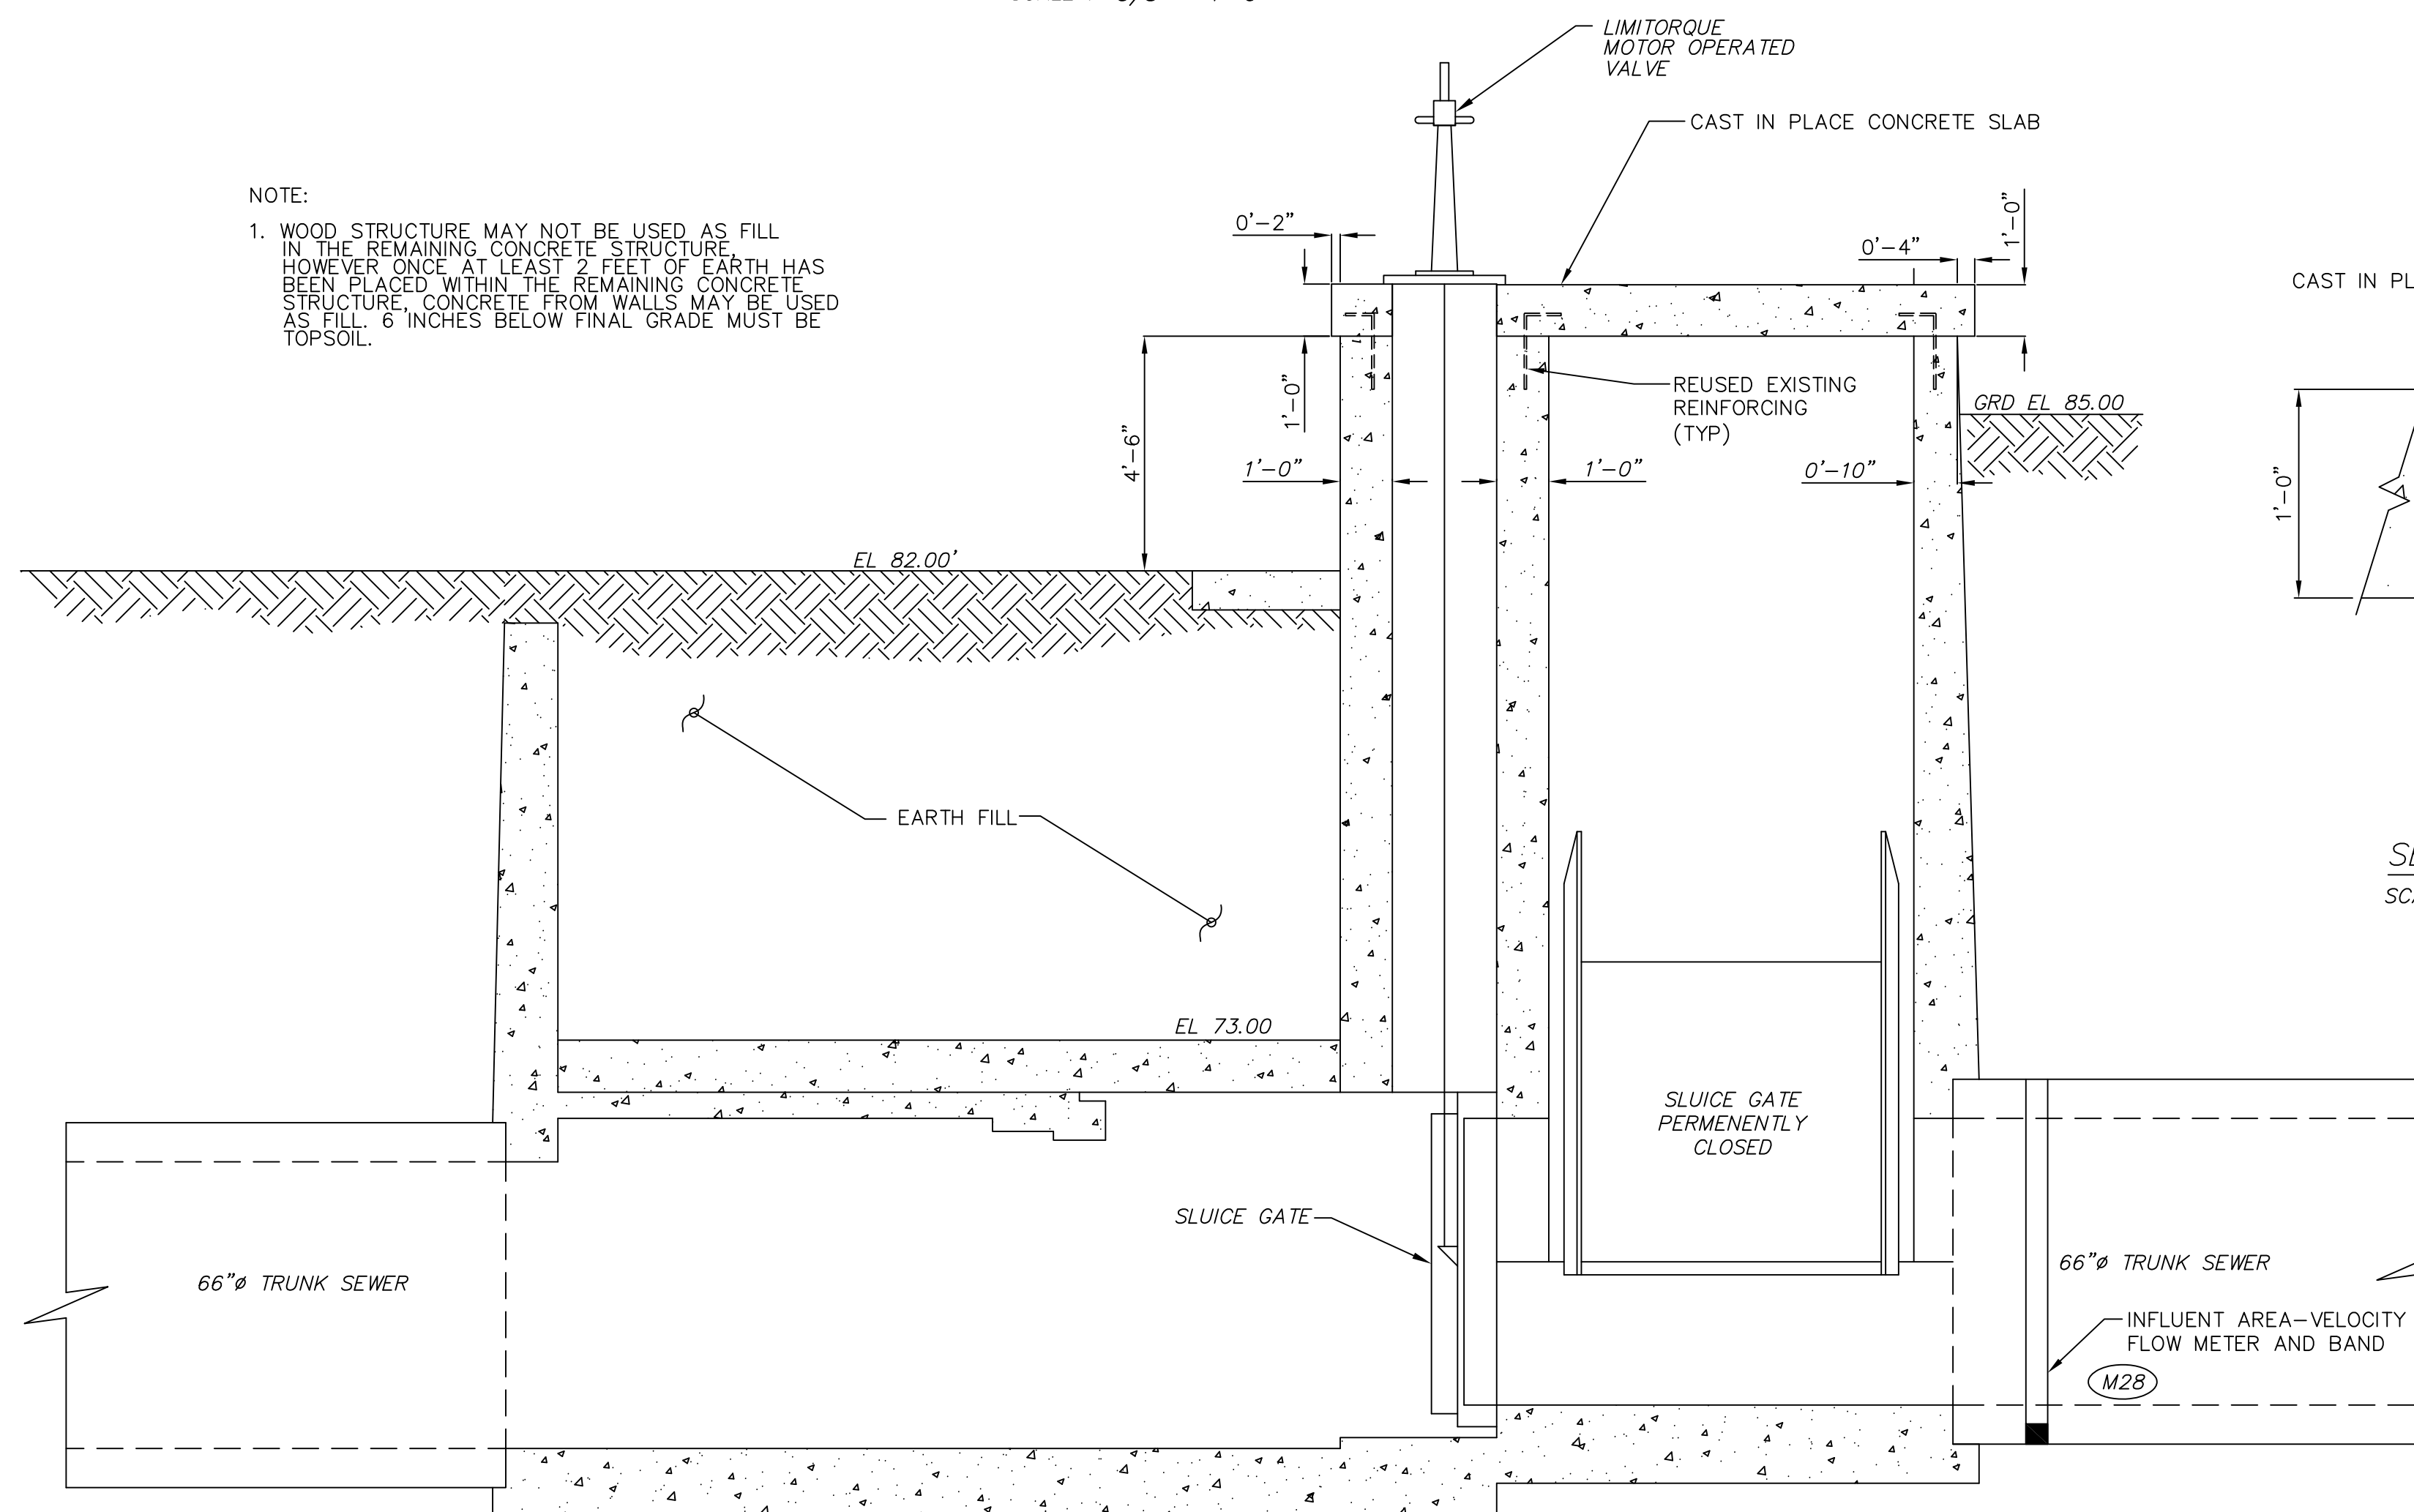

SECTION
SCALE : 3/8" = 1'-0" A

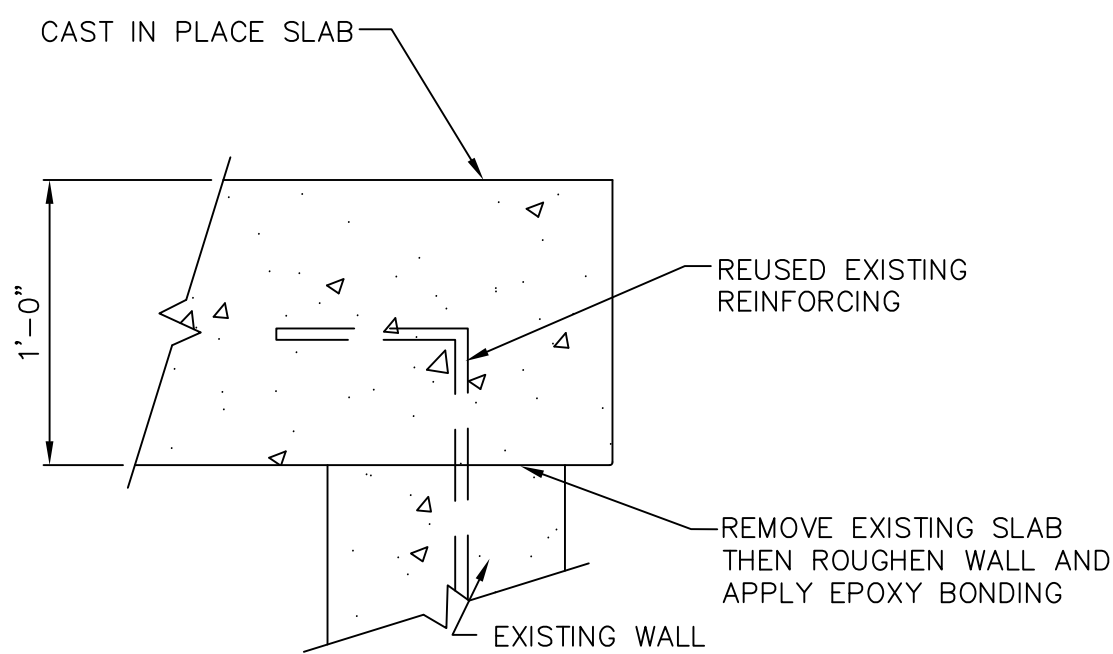

SECTION
SCALE : 1 1/2" = 1'-0" 1

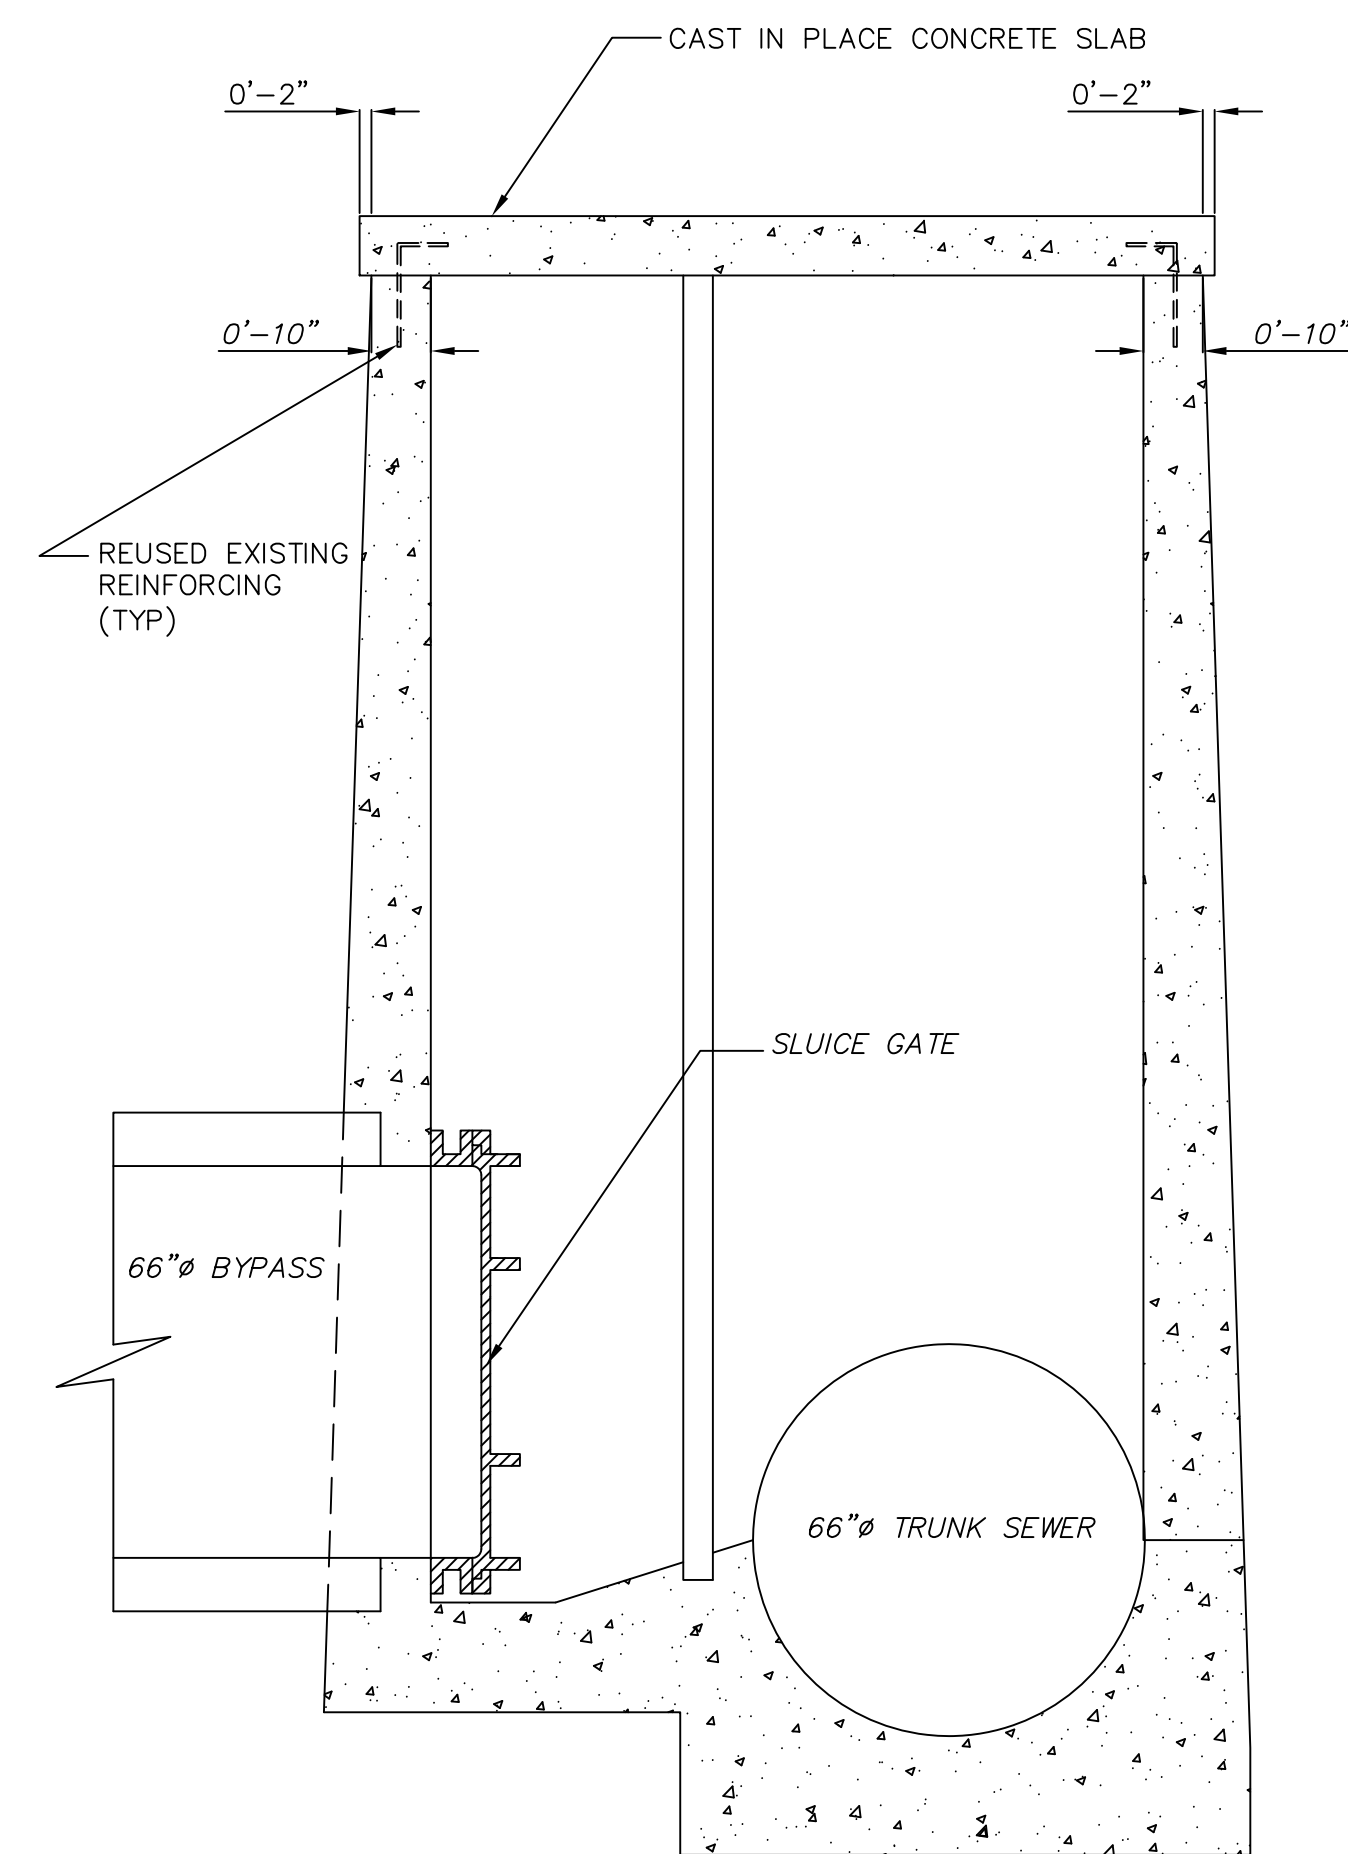

SECTION
SCALE : 3/8" = 1'-0" B

THESE RECORD DOCUMENTS HAVE BEEN PREPARED BASED ON INFORMATION PROVIDED BY OTHERS. CTI ENVIRONMENTAL HAS REVIEWED THE INFORMATION SUBMITTED AND BELIEVES IT REFLECTS THE WORK AS CONSTRUCTED. HOWEVER, ALL PERSONS SHALL VERIFY INFORMATION TAKEN FROM THIS DRAWING.

THIS DRAWING IS AN INSTRUMENT OF SERVICE OWNED BY CTI ENVIRONMENTAL, INC. WHICH SHALL BE DEEMED THE AUTHOR AND WHICH SHALL RETAIN ALL STATUTORY AND COMMON LAW RIGHTS. THIS DRAWING SHALL NOT BE REPRODUCED, COPIED, OR ANY OTHER PURPOSE OR PROJECT WITHOUT THE WRITTEN CONSENT OF CTI ENVIRONMENTAL, INC. THAT ELECTRONIC COPIES OF THIS DRAWING ARE EXACT DUPLICATES OF THE SEALED ORIGINAL DRAWING. ANY COPIES OF THIS DRAWING THAT ARE NOT ELECTRONIC COPIES OF THE SEALED ORIGINAL SHALL BE CONSIDERED UNRELIABLE AND THE SEALED ORIGINAL SHALL GOVERN.

DESIGNED BY		REVISIONS				
RLP \ RWR		NO.	DESCRIPTIONS	DATE	BY	APP'D
DRAWN BY		1	RECORD DRAWING	4/05	MGW	WAD
AMF						
CHECKED BY						
RWR						
APPROVED BY						
WAD						

ENVIRONMENTAL, INC.
ENGINEERS IN WATER AND EARTH SCIENCES
UNIONTOWN, OHIO

CTI

CITY OF MASSILLON, OHIO
WWTP UPGRADE 2000

INFLUENT STRUCTURE PLAN AND SECTION DEMOLITION

JOB NO. E9031
DATE 08/13/01
SCALE AS NOTED
SHEET P14